


01 External Work
Scale: 1:200




02 External Work
Scale: 1:200

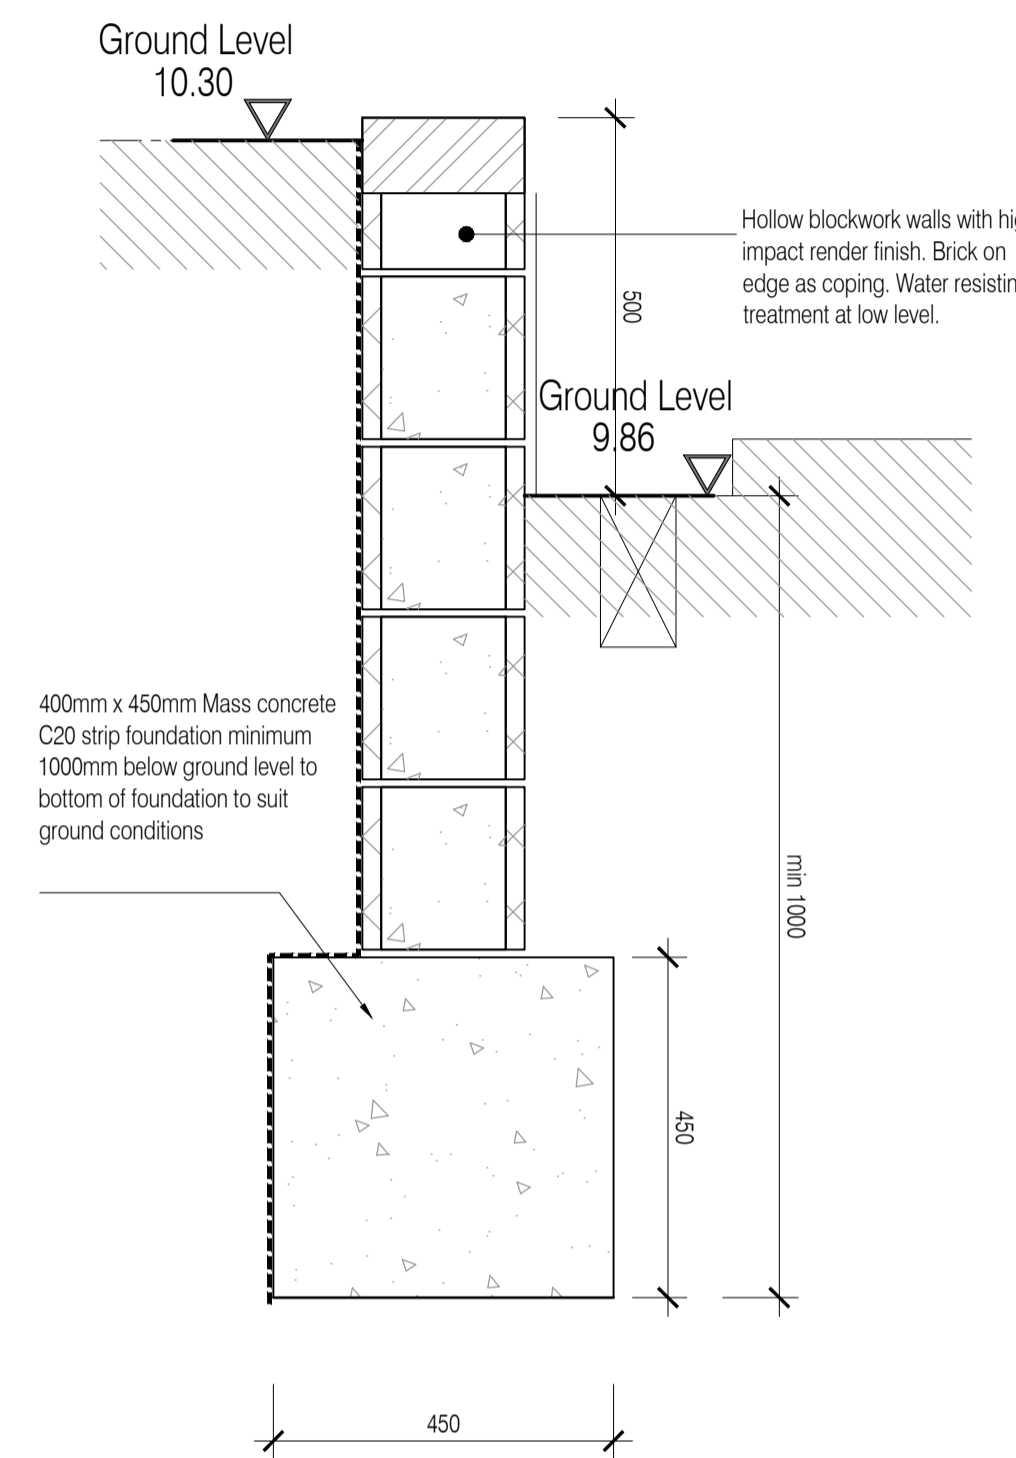


03 Retaining wall detail
Scale: 1:10

NOTES: Do not scale this drawing. All dimensions to be checked on site prior to commencement or manufacture.

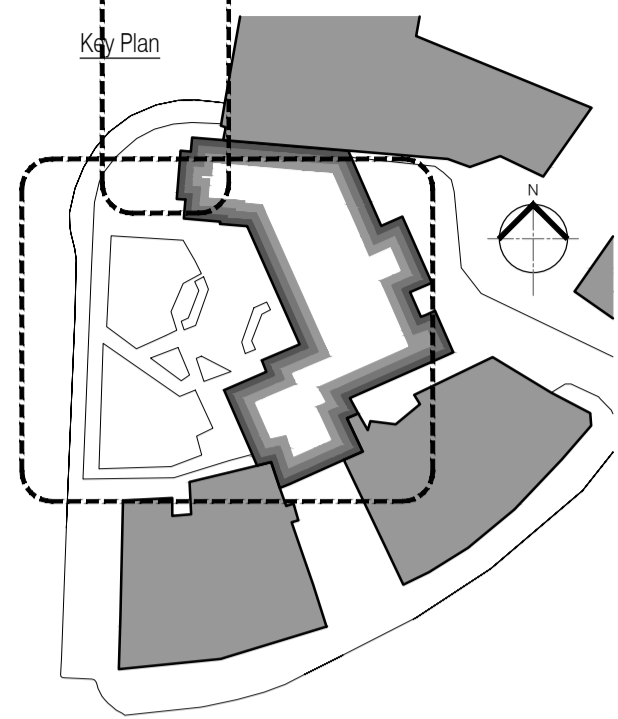

- Site Legend**
- Denotes new brick pavers
 - Denotes grass
 - Denotes highways paving slabs
 - Denotes tarmac footpath
 - Denotes new car park surfacing
 - Denotes Electrical car charging points. See Electrical Engineers specification
 - Denotes tactile paving at vehicle crossing points
 - Denotes gravel with terram underlay
 - Denotes Electrical Car charging point
 - Denotes lampost car park lighting

- Boundaries Legend**
- Denotes Site Ownership Boundary
 - Denotes New Building Works Boundary

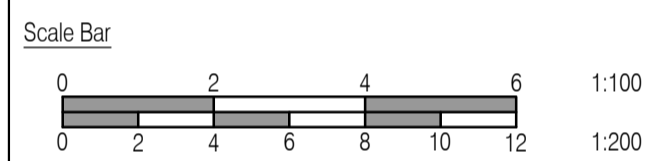

ISSUED FOR AS-BUILT

Rev	Date	By	Chk	Comment
AB	30.09.14	CH	AC	Issued for AS-BUILT



FRANKHAM

Frankham Consultancy Group Limited
21 Perryman Road
Haywards Heath RH16 3TP
t 01444 444900 f 01444 455642
enquire@frankham.com
www.frankham.com

Client

Project Title

Dominion Arts Centre
Southall
London

Drawing Title

Proposed
External Works Plan

Drawn by: RKC	Scale: 1:200@A1	Date: 17.12.12
------------------	--------------------	-------------------

Designed by: FCG	Checked by: -	Approved by: -
---------------------	------------------	-------------------

File Ref.: 224970-A-005

Drawing No. 224970-A-005	Rev. AB
-----------------------------	------------