


NOTES: Do not scale this drawing. All dimensions to be checked on site prior to commencement or manufacture.

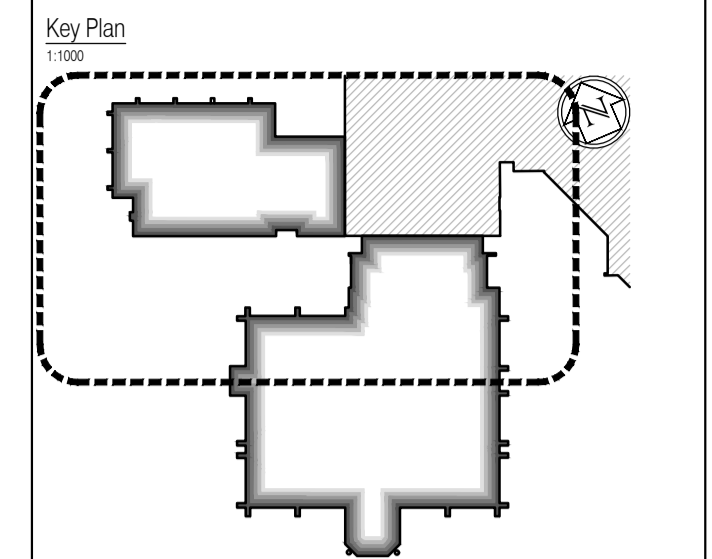

- Fixed Furniture & Equipment Legend**
- FH Denotes Tambou unit 4N' shelves - 470mm deep x 1000mm wide x 1968mm high (Department Storage)
 - LL Denotes Tambou unit 2N' shelves - 470mm deep x 1000mm wide x 1016mm high (Department Storage)
 - BCL Denotes Book case 3N' shelves - 434mm deep x 1000mm wide x 1155mm high (Department Storage)
 - BCH Denotes Book case 5N' shelves - 434mm deep x 1000mm wide x 1887mm high (Department Storage)
 - L Denotes Staff locker - 457mm deep x 305mm wide x 1703mm high
 - FHC Denotes full height cupboards TBC (Department Storage)
 - S Denotes Chubb Europlanet 150 safe - 756mm deep x 536mm wide x 326mm high
 - LLPS Denotes Tambou unit 2N' shelves - 470mm deep x 1000mm wide x 1016mm high (Personal Storage)
 - FHPS/DS Denotes Tambou unit 4N' shelves - 475mm deep x 1000mm wide x 1968mm high (Shared Department/Personal Storage)
 - FC Filing Cabinet
 - PC Plan Chest
 - F Fridge
 - FF Lockable Fridge Freezer
 - FL Lockable Fridge Freezer
 - LC Lockable Cupboard
 - LLDS Denotes Tambou unit 2N' shelves - 470mm deep x 1000mm wide x 1016mm high (Personal Storage)
 - FHLS Denotes Tambou unit 4N' shelves - 470mm deep x 1000mm wide x 1968mm high (Legal Library Storage)

AS BUILT
DRAWING

NB: - Solid gray hatch denotes existing building fabric.

Rev	Date	By	Chk	Comment

BRINGING IDEAS TO LIFE

FRANKHAM


Frankham Consultancy Group Limited
 21 Perryman Road
 Hayward Heath RH16 3TP
 t 01444 444900 f 01444 455642
 enquiry@frankham.com
 www.frankham.com

Client <p>WILLMOTT DIXON CONSTRUCTION</p>
Project Title Wealden District Council Hailsham Head Quarters Refurbishments and Alterations
Drawing Title Proposed Ground Floor Plan Community Hall Building Choir Stage Layout Arrangement

Drawn by: RKC	Scale: 1:50@A1	Date: 18.07.11
Designed by: FCG	Checked by: JAS	Approved by: AC

File Ref.: X:\FRANKHAM\2011\18\WALDEN\20ARCH\10_18_LOCATION_PLAN_RFC.DWG 20/06/11 16:04:55

Drawing No. 521185-A-126	Rev. -
------------------------------------	-----------

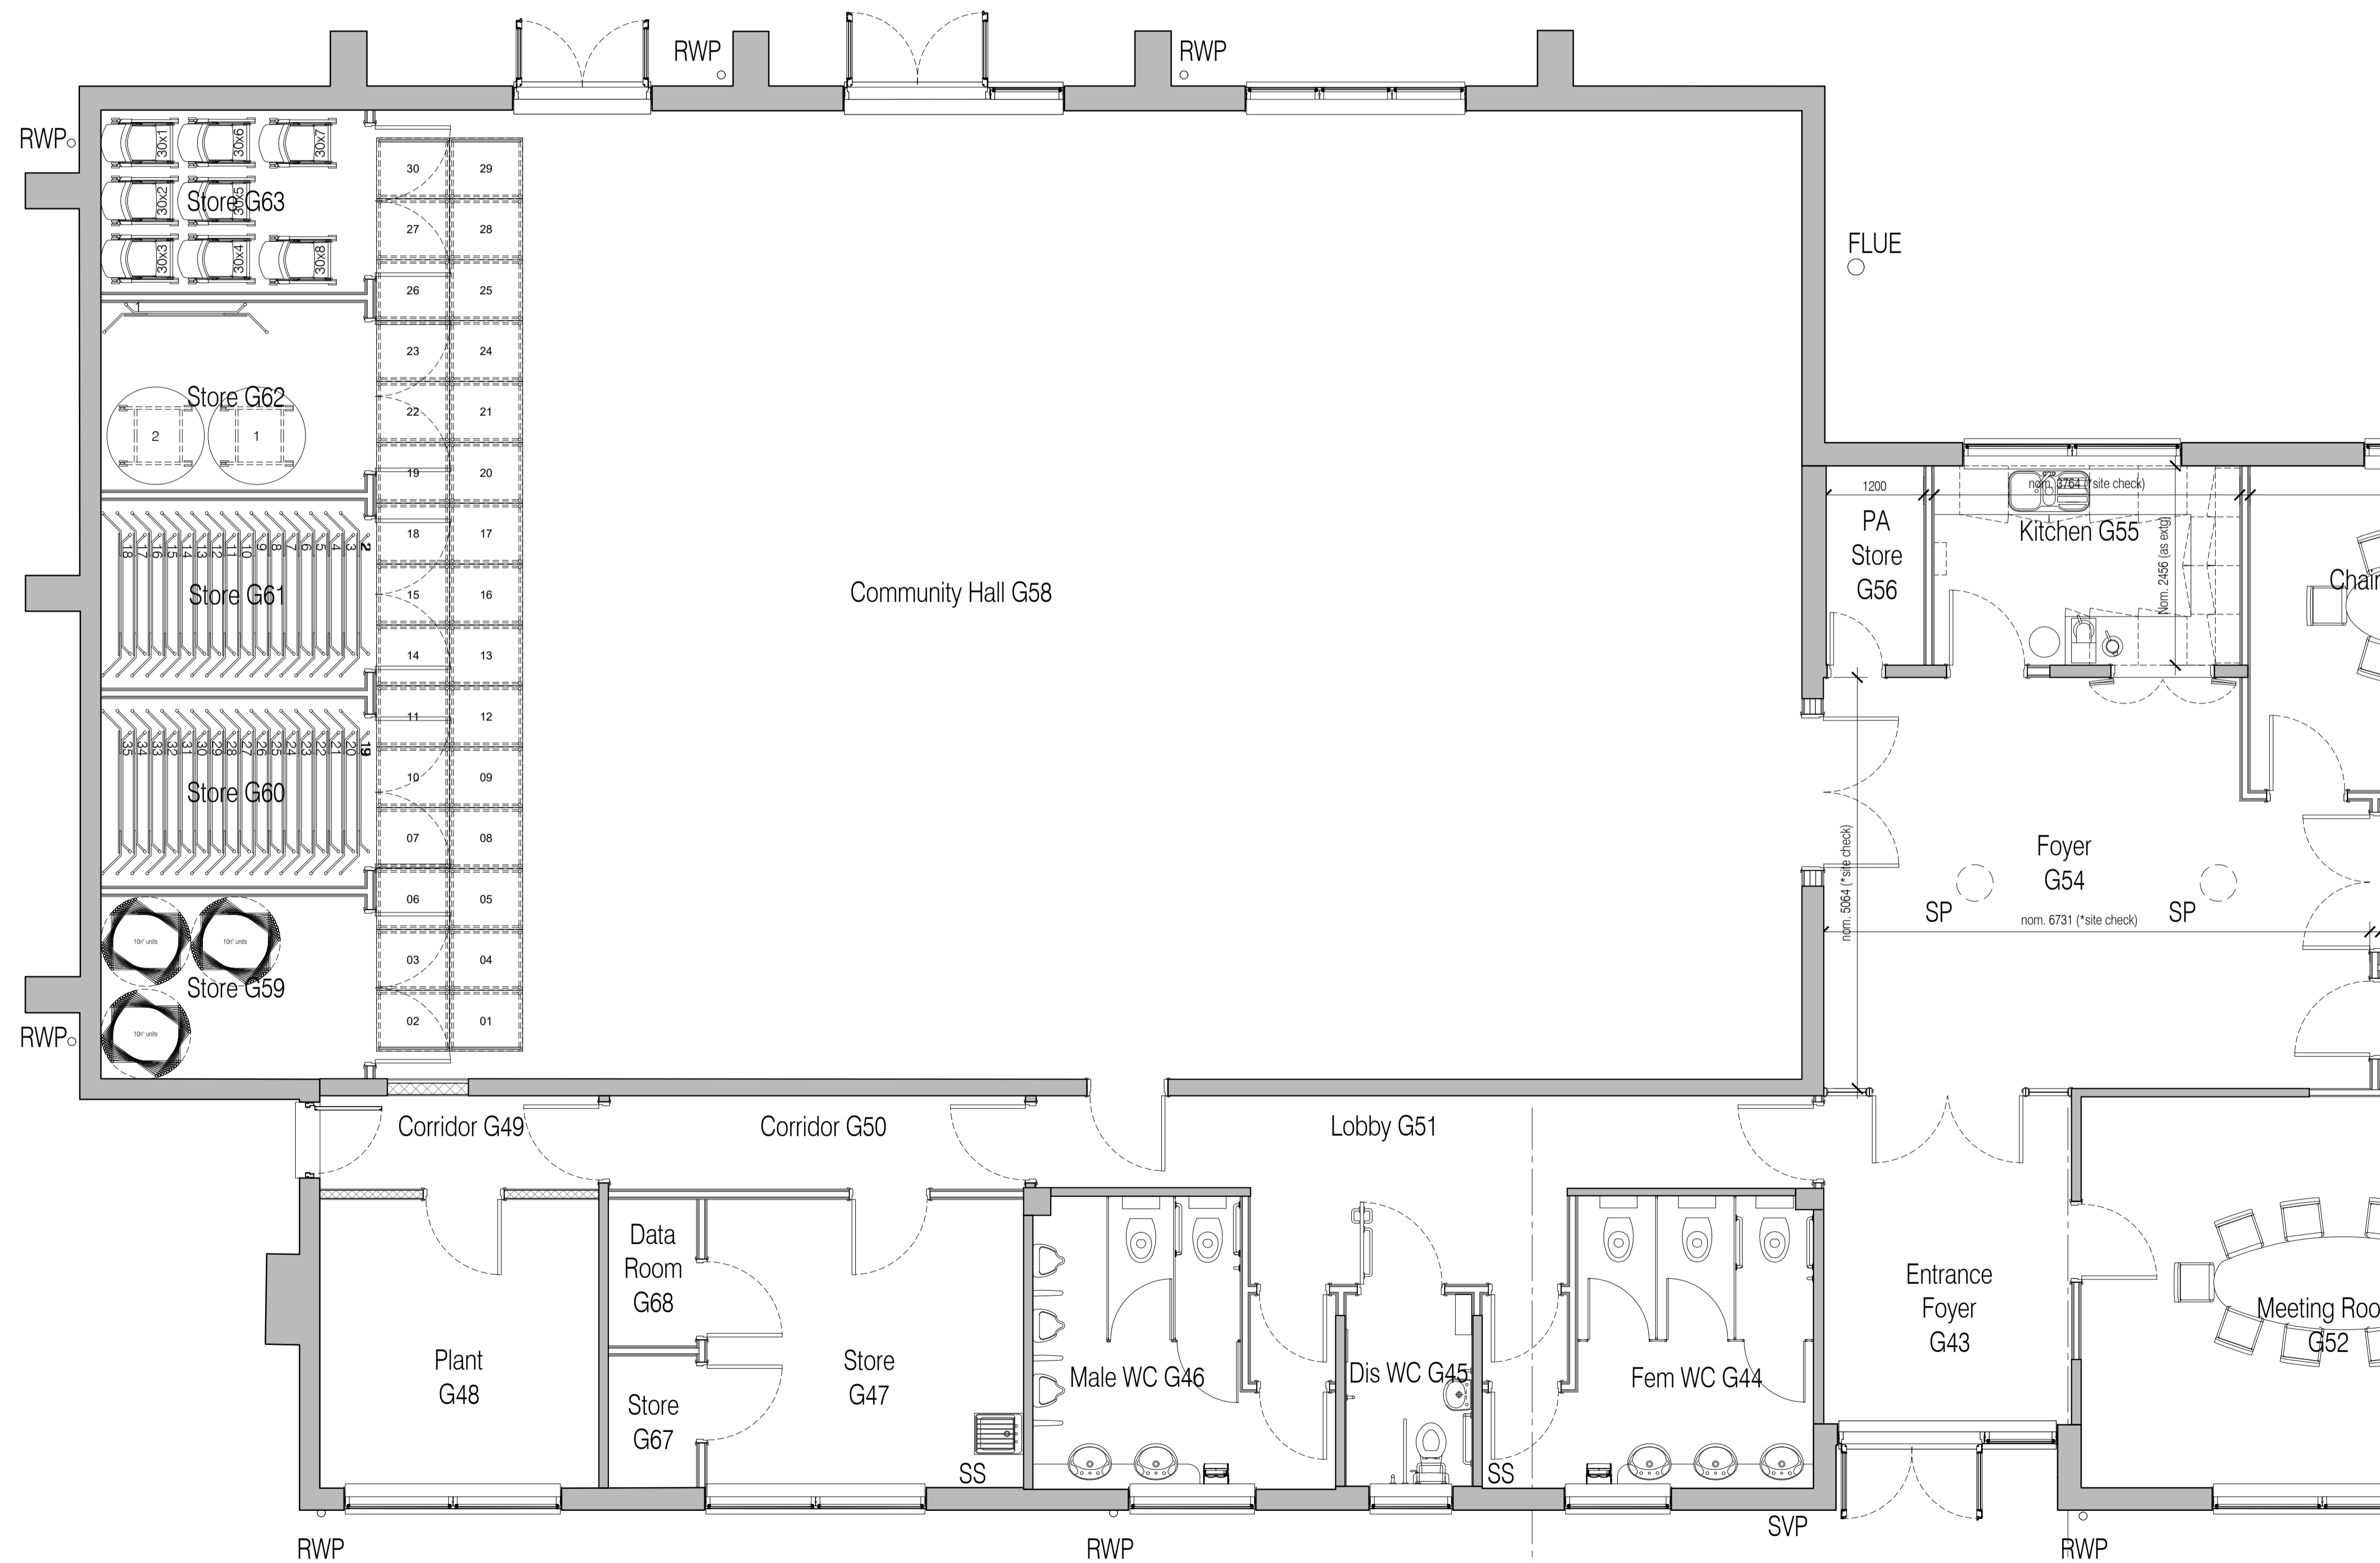

11

800

NB: All information based on supplied third party survey information. All discrepancies to be reported to FCG immediately upon discovery.

For continuation, please refer to dwg: 521185-A-120

All Mechanical & Electrical and Structural information shown indicative only. Please refer to Mechanical & Electrical and Structural documentation.