
These drawings have been edited in accordance with Willmott Dixon's instructions. All material, product, volume, dimension and performance information is indicative only. FCG repudiate any and all liability for failure or non performance of any or the afore mentioned items as indicated on this or any other FCG documentation.

NOTES: Do not scale this drawing. All dimensions to be checked on site prior to commencement or manufacture. Key Plan ______

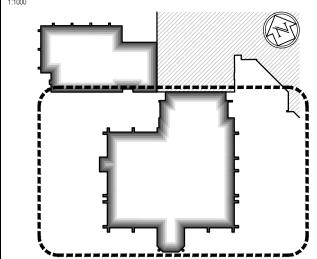

Reflected Ceiling Plan Legend
All colours to be confirmed. All unhatched areas are exposed concrete soffits to be made good and painted.

sound absorption

Plasterboard bulkhead with downlighters

Suspended Armstrong Diploma E24 suspended 600x600 grid - meeting rooms + general areas Suspended Armstrong BioGuard Acoustic E24 suspended 600x600 grid - hygienic areas

Plasterboard ceiling Rockfon Alaska D Acoustic Suspended 600 x 600 grid - High

Existing ceiling made good and painted white Underside of concrete slab made good and painted white

Phase change plasterboard bulkhead

Exposed waffle slab made good and painted. Colour TBC.

Exposed beam and pot floor made good and painted. . Colour TBC. Exposed pre-cast slab made good and painted. Colour

Phased change F.E.S. board ceiling material (for thermal

1hr Fire Ceiling: 2n° layers of 12.5mm Fireline plasterboard in accordance with Manufacturer's design and instructions

AS BUILT

NB: - Solid gray hatch denotes existing building fabric.

FRANKHAM

Frankham Consultancy Group Limited 21 Perrymount Road Haywards Heath RH16 3TP t 01444 444900 f 01444 455642 enquire@frankham.com www.frankham.com



Wealden District Council Hailsham Head Quarters Refurbishments and Alterations

Proposed Ground Floor Plan Council Offices Building Reflected Ceiling Plan

1:100@A1 22.11.10 Designed by: Checked by: Approved by: FCG AC

File Ref.: X:\FRANKHAM:Z-JOBS\521185-WEALDEN-DC\ARCH\100_199_L\
521185-A-140.DWG - 200611160547 20:06:11:16:05:48

Drawing No. 521185-A-140