



01 Section 02  
Scale: 1:100

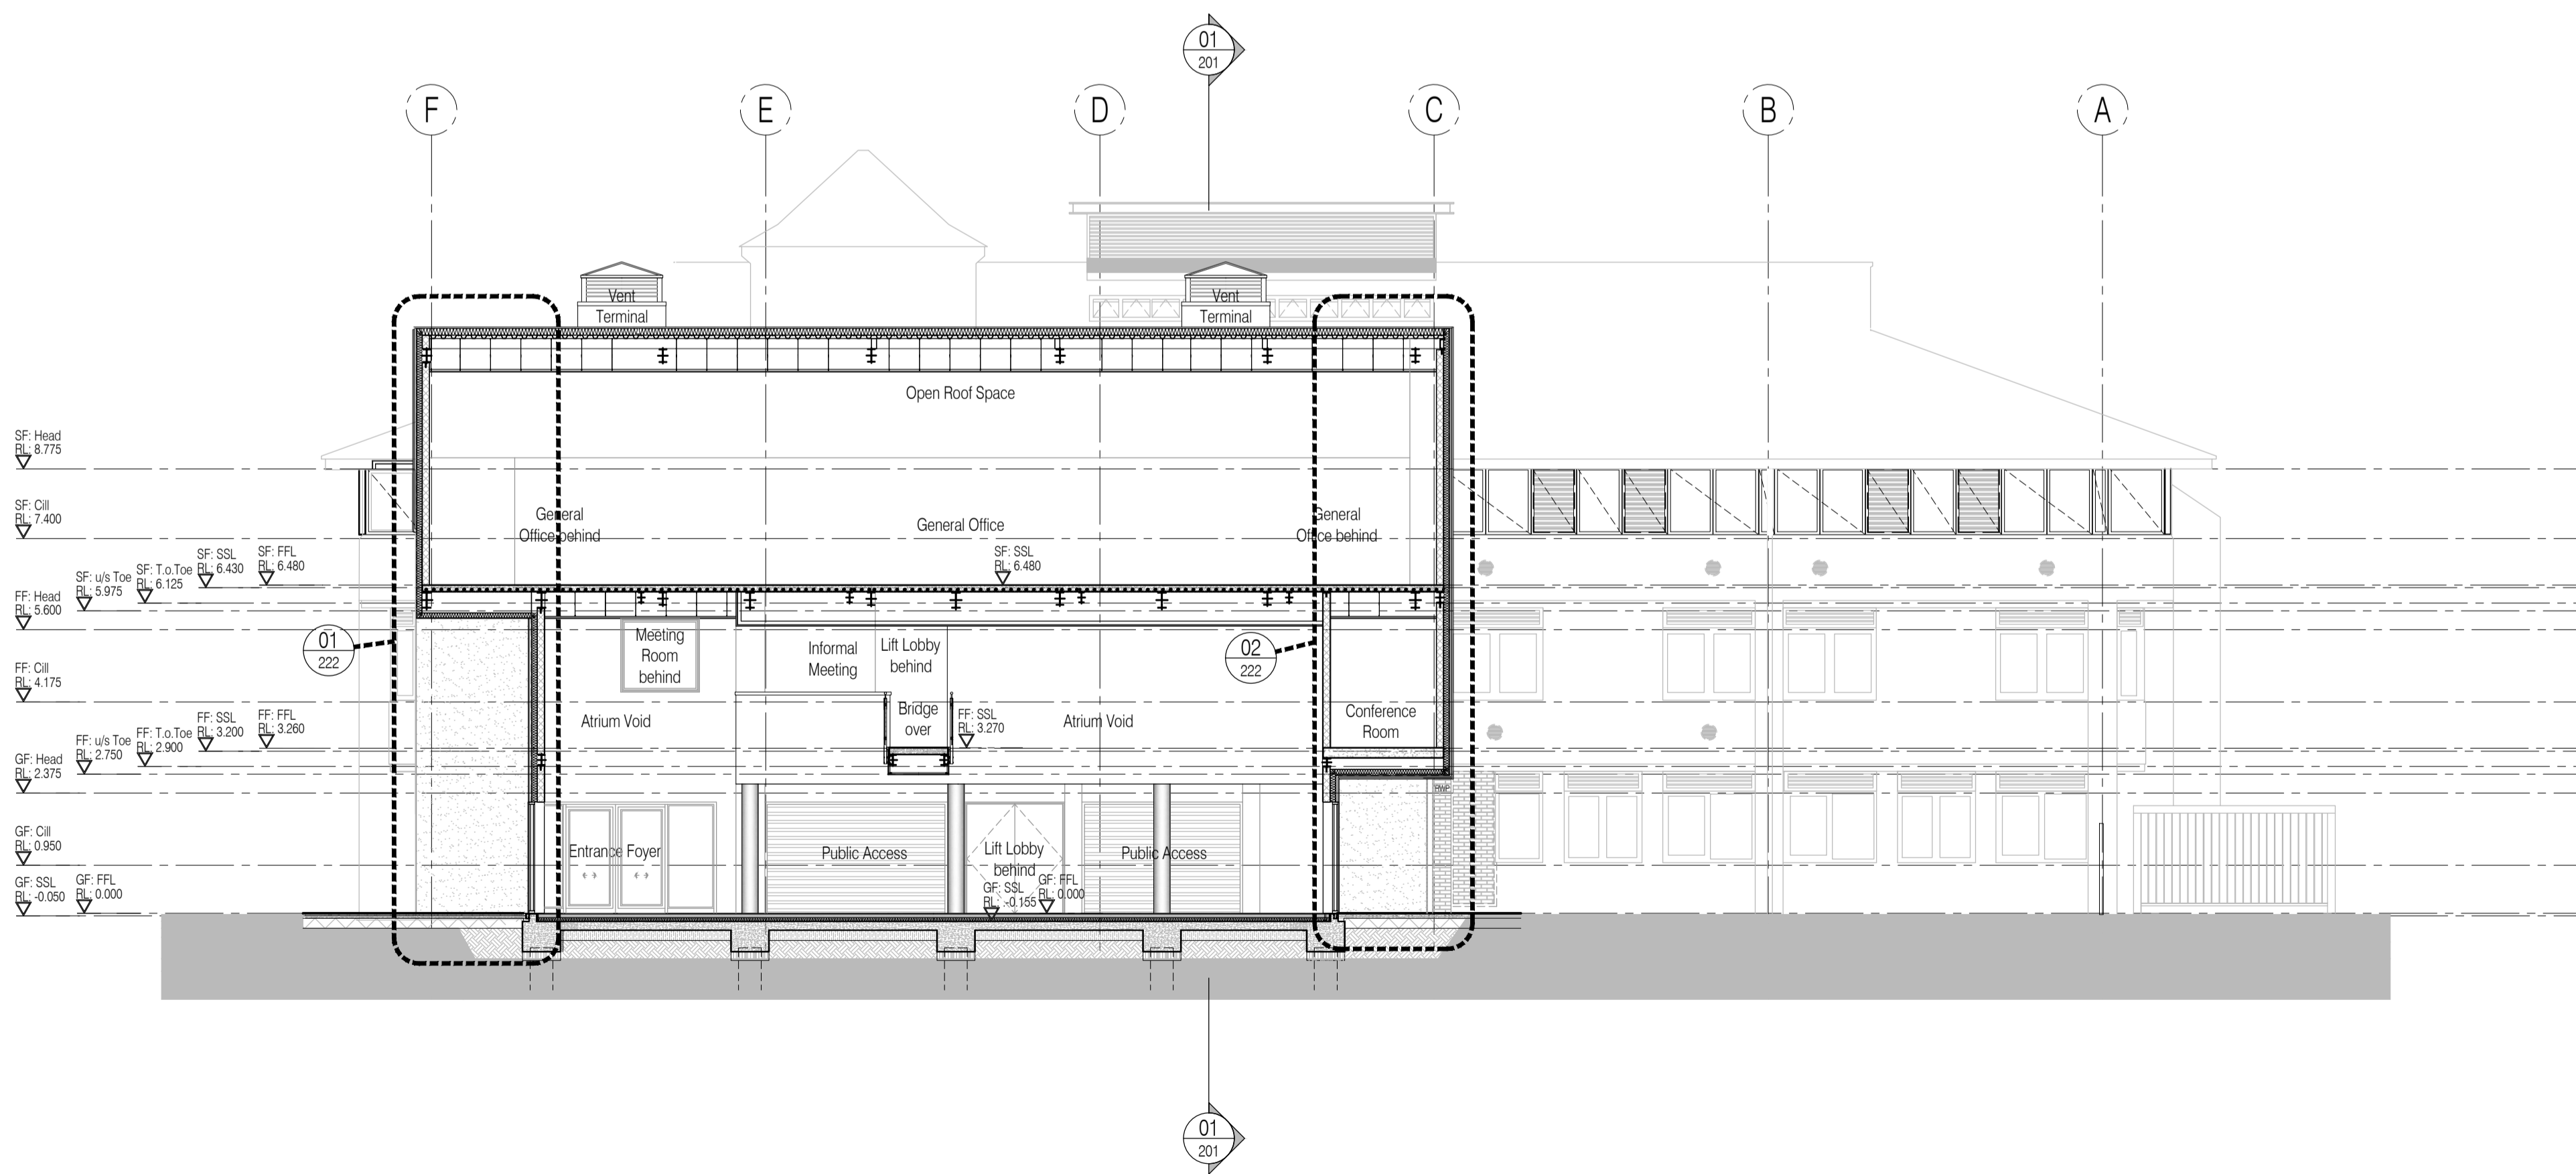

02 Section 04  
Scale: 1:100

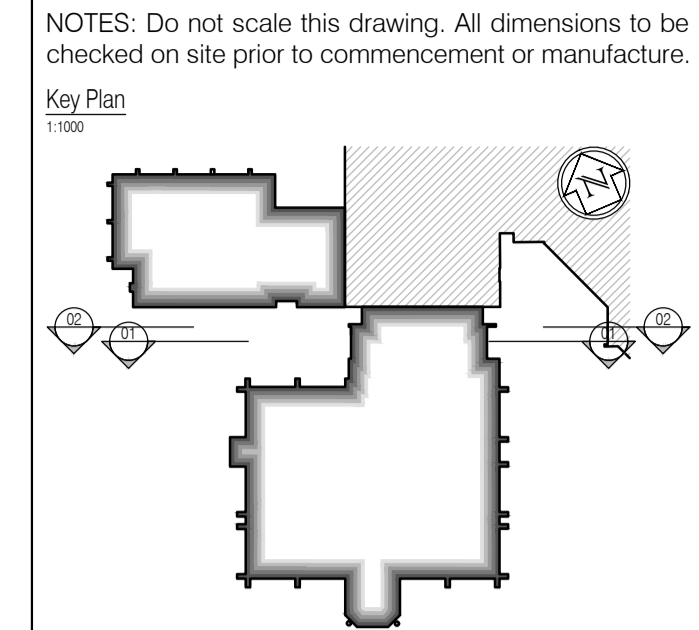

NOTES: Do not scale this drawing. All dimensions to be checked on site prior to commencement or manufacture.


Key Plan  
1:1000

AS BUILT  
DRAWING

NB: - Solid gray hatch denotes existing building fabric.

Rev	Date	By	Clk	Comment

BRINGING IDEAS TO LIFE



**FRANKHAM**

Frankham Consultancy Group Limited  
21 Perryman Road  
Haywards Heath RH16 3TP  
t 01444 444900 f 01444 455642  
enquire@frankham.com  
www.frankham.com

Client



**WILLMOTT DIXON  
CONSTRUCTION**

Project Title

Wealden District Council  
Hailsham Head Quarters  
Refurbishments and Alterations

Drawing Title

Proposed Sections  
Sections 02 & 04

Drawn by: RKC	Scale: 1:100@A1	Date: 22.11.10
Designed by: FCG	Checked by: JAS	Approved by: AC

File Ref.: X:\FRANKHAM\022185\HAILSHAM HEAD QUARTERS\02\_SECTION02.dwg 20/06/11 16:10:41

Drawing No. 521185-A-202	Rev. -
-----------------------------	-----------

NB: All information based on supplied third party survey information. All discrepancies to be reported to FCG immediately upon discovery.

All Mechanical & Electrical and Structural information shown indicative only. Please refer to Mechanical & Electrical and Structural documentation.