




01 Section 07 Proposed Community Hall
Scale:1:100

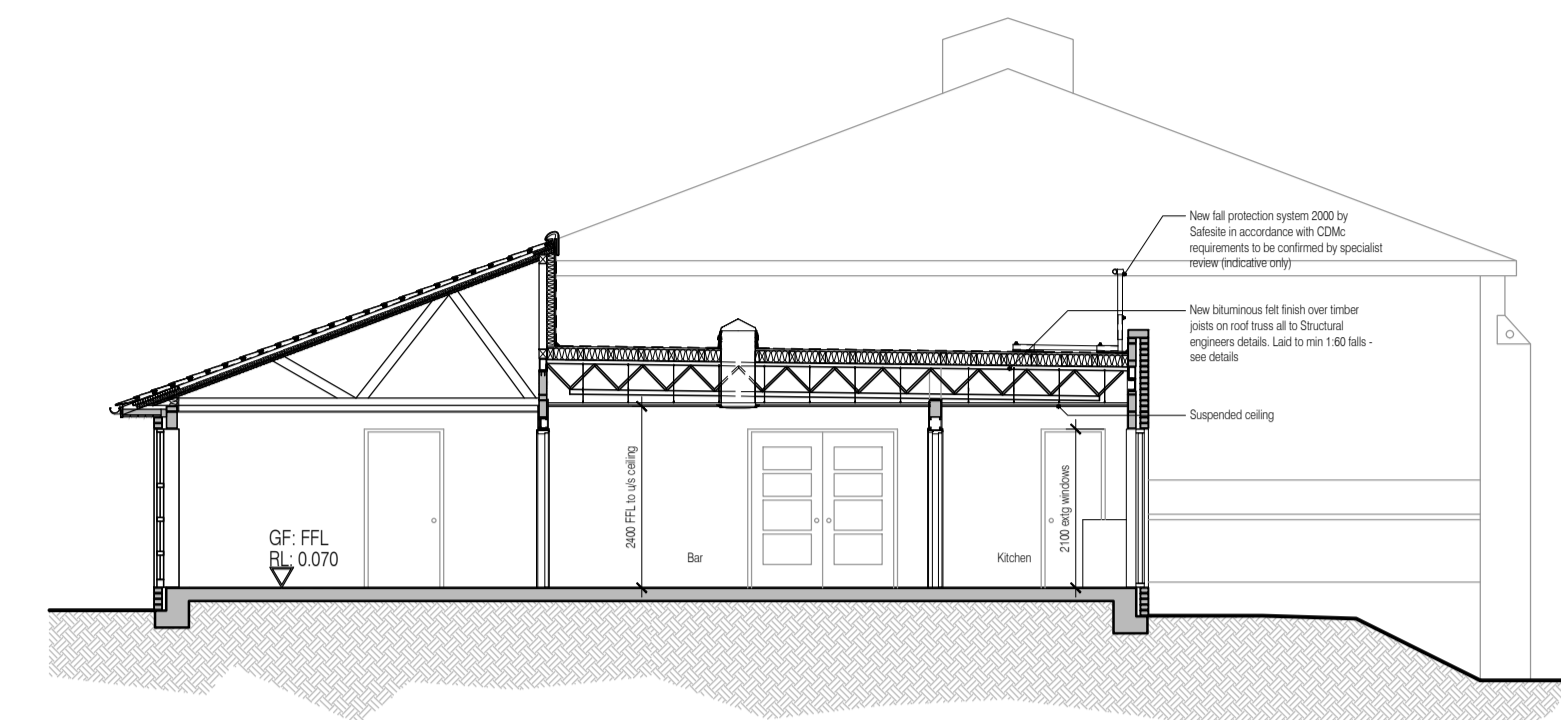


02 Section 08 Proposed Community Hall through Entrance
Scale:1:100

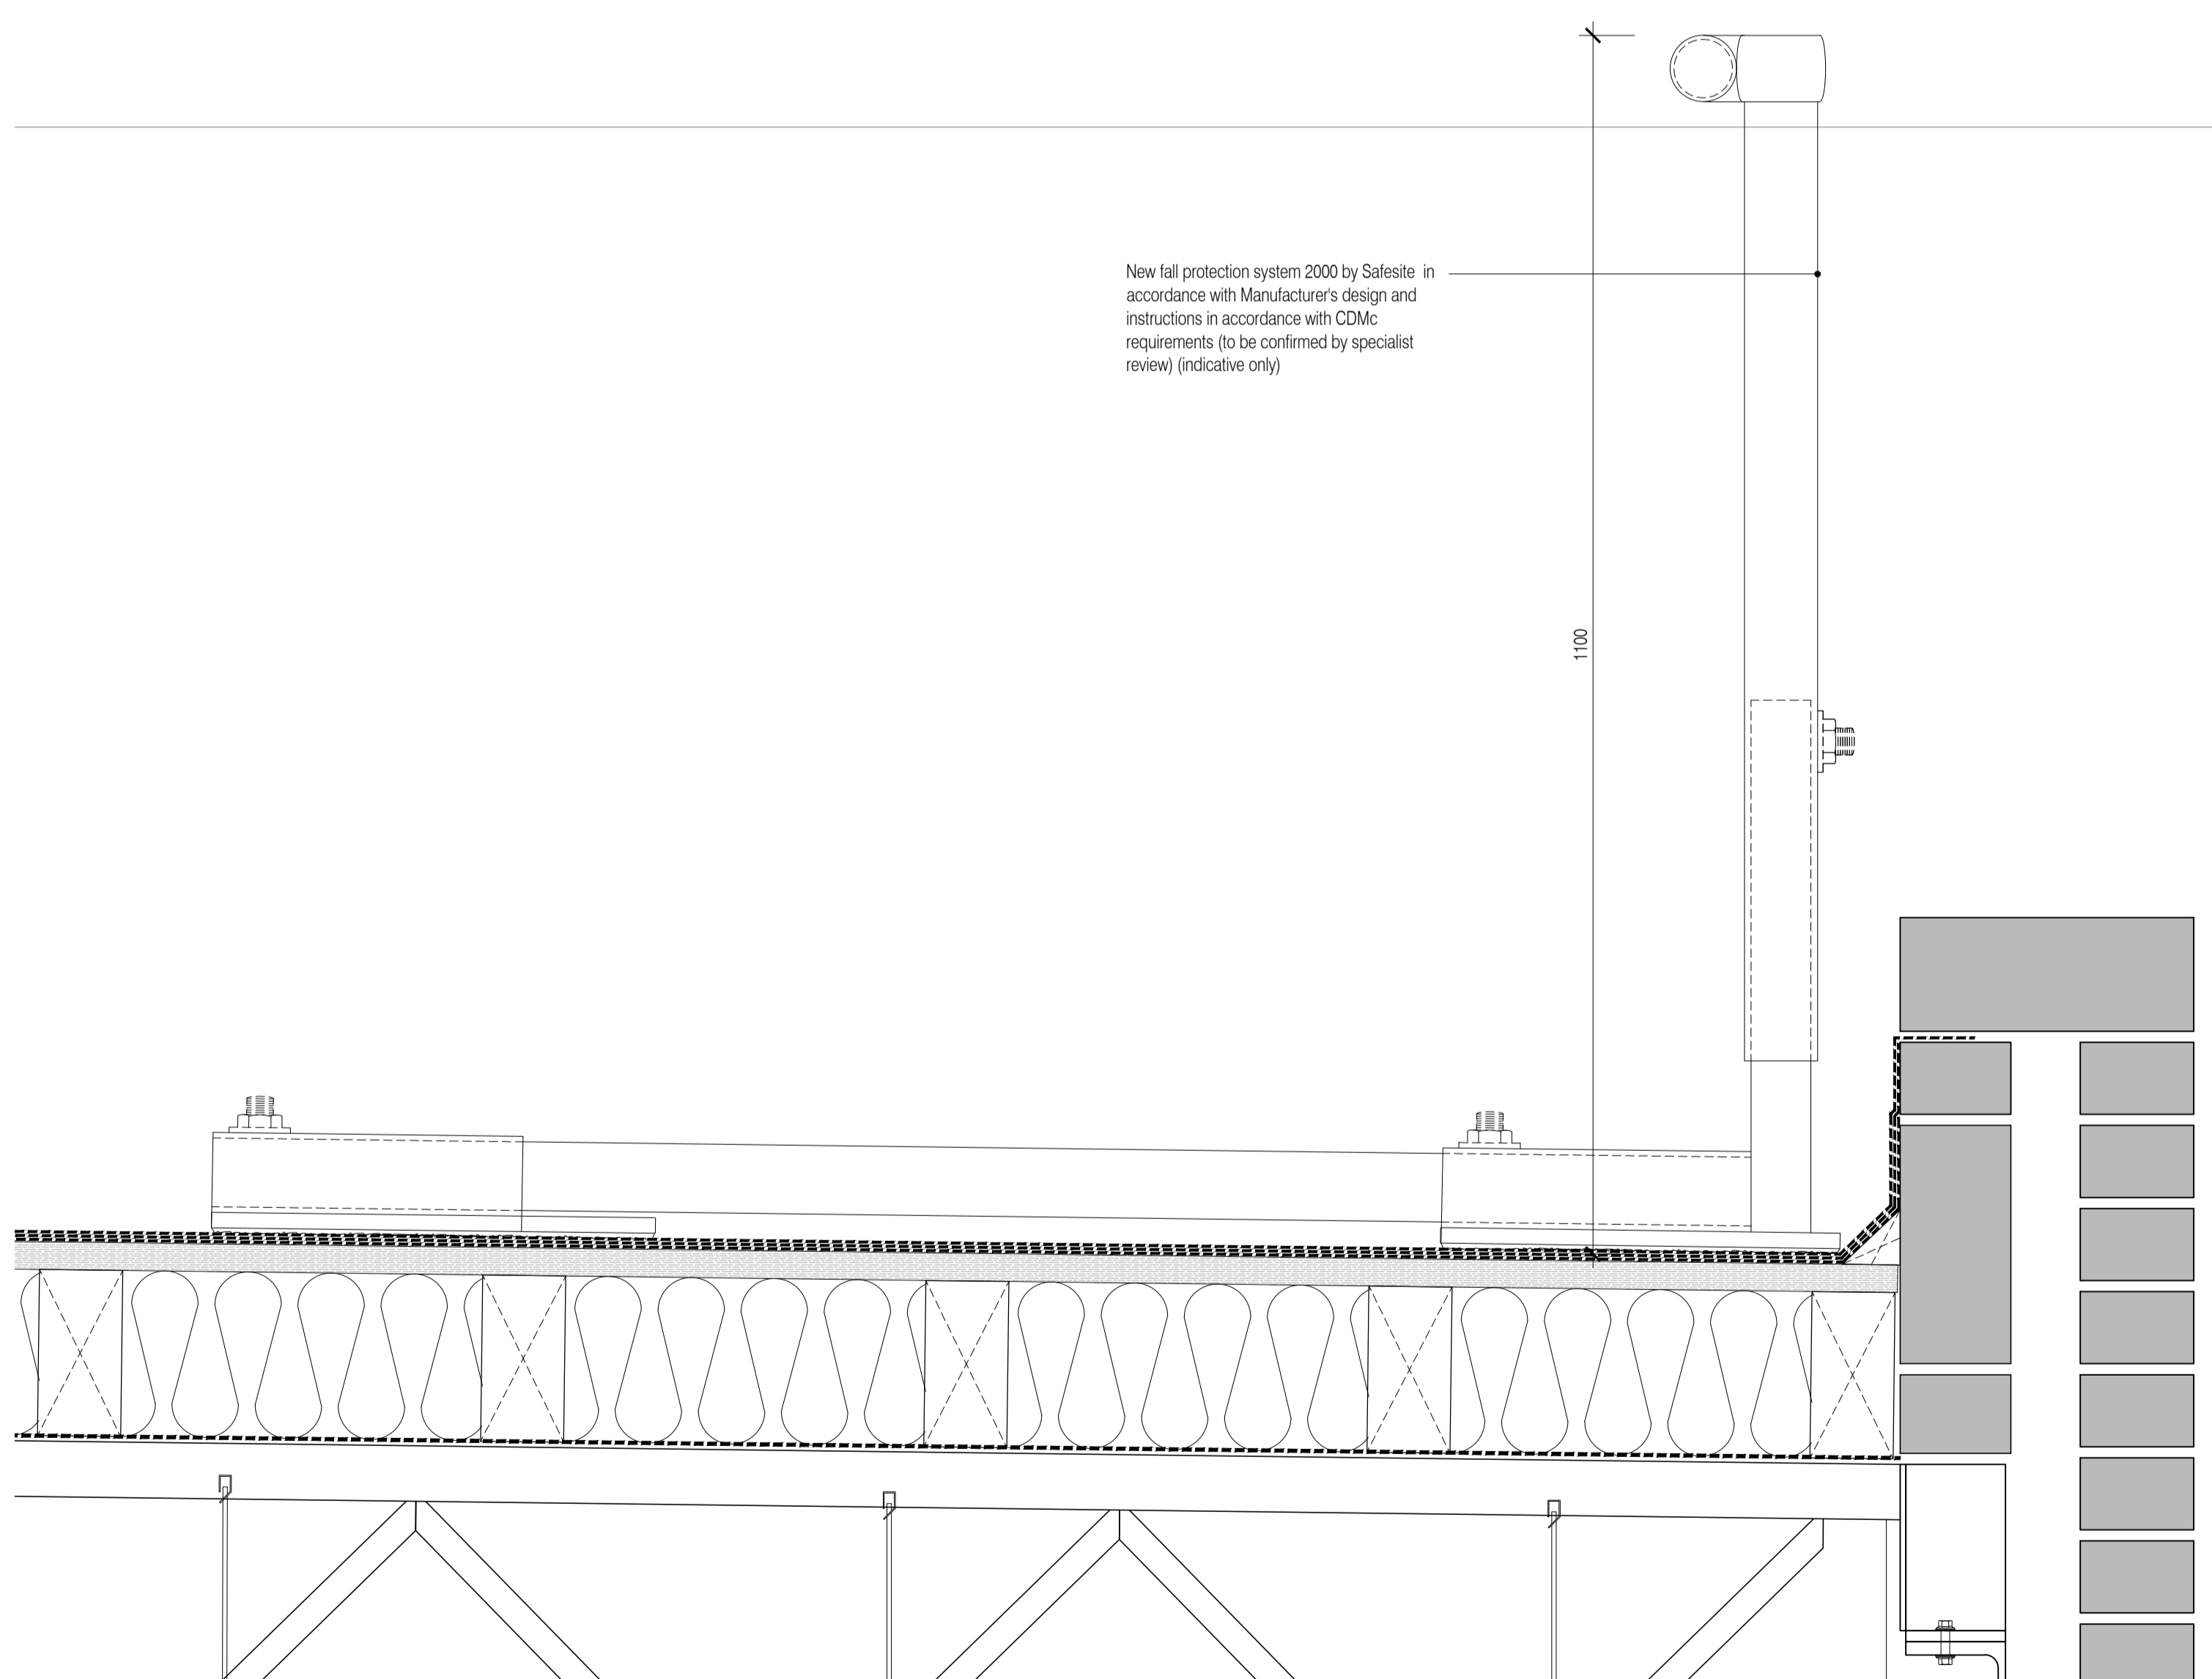

03 Safesite Guardrail Detail
Scale:1:5

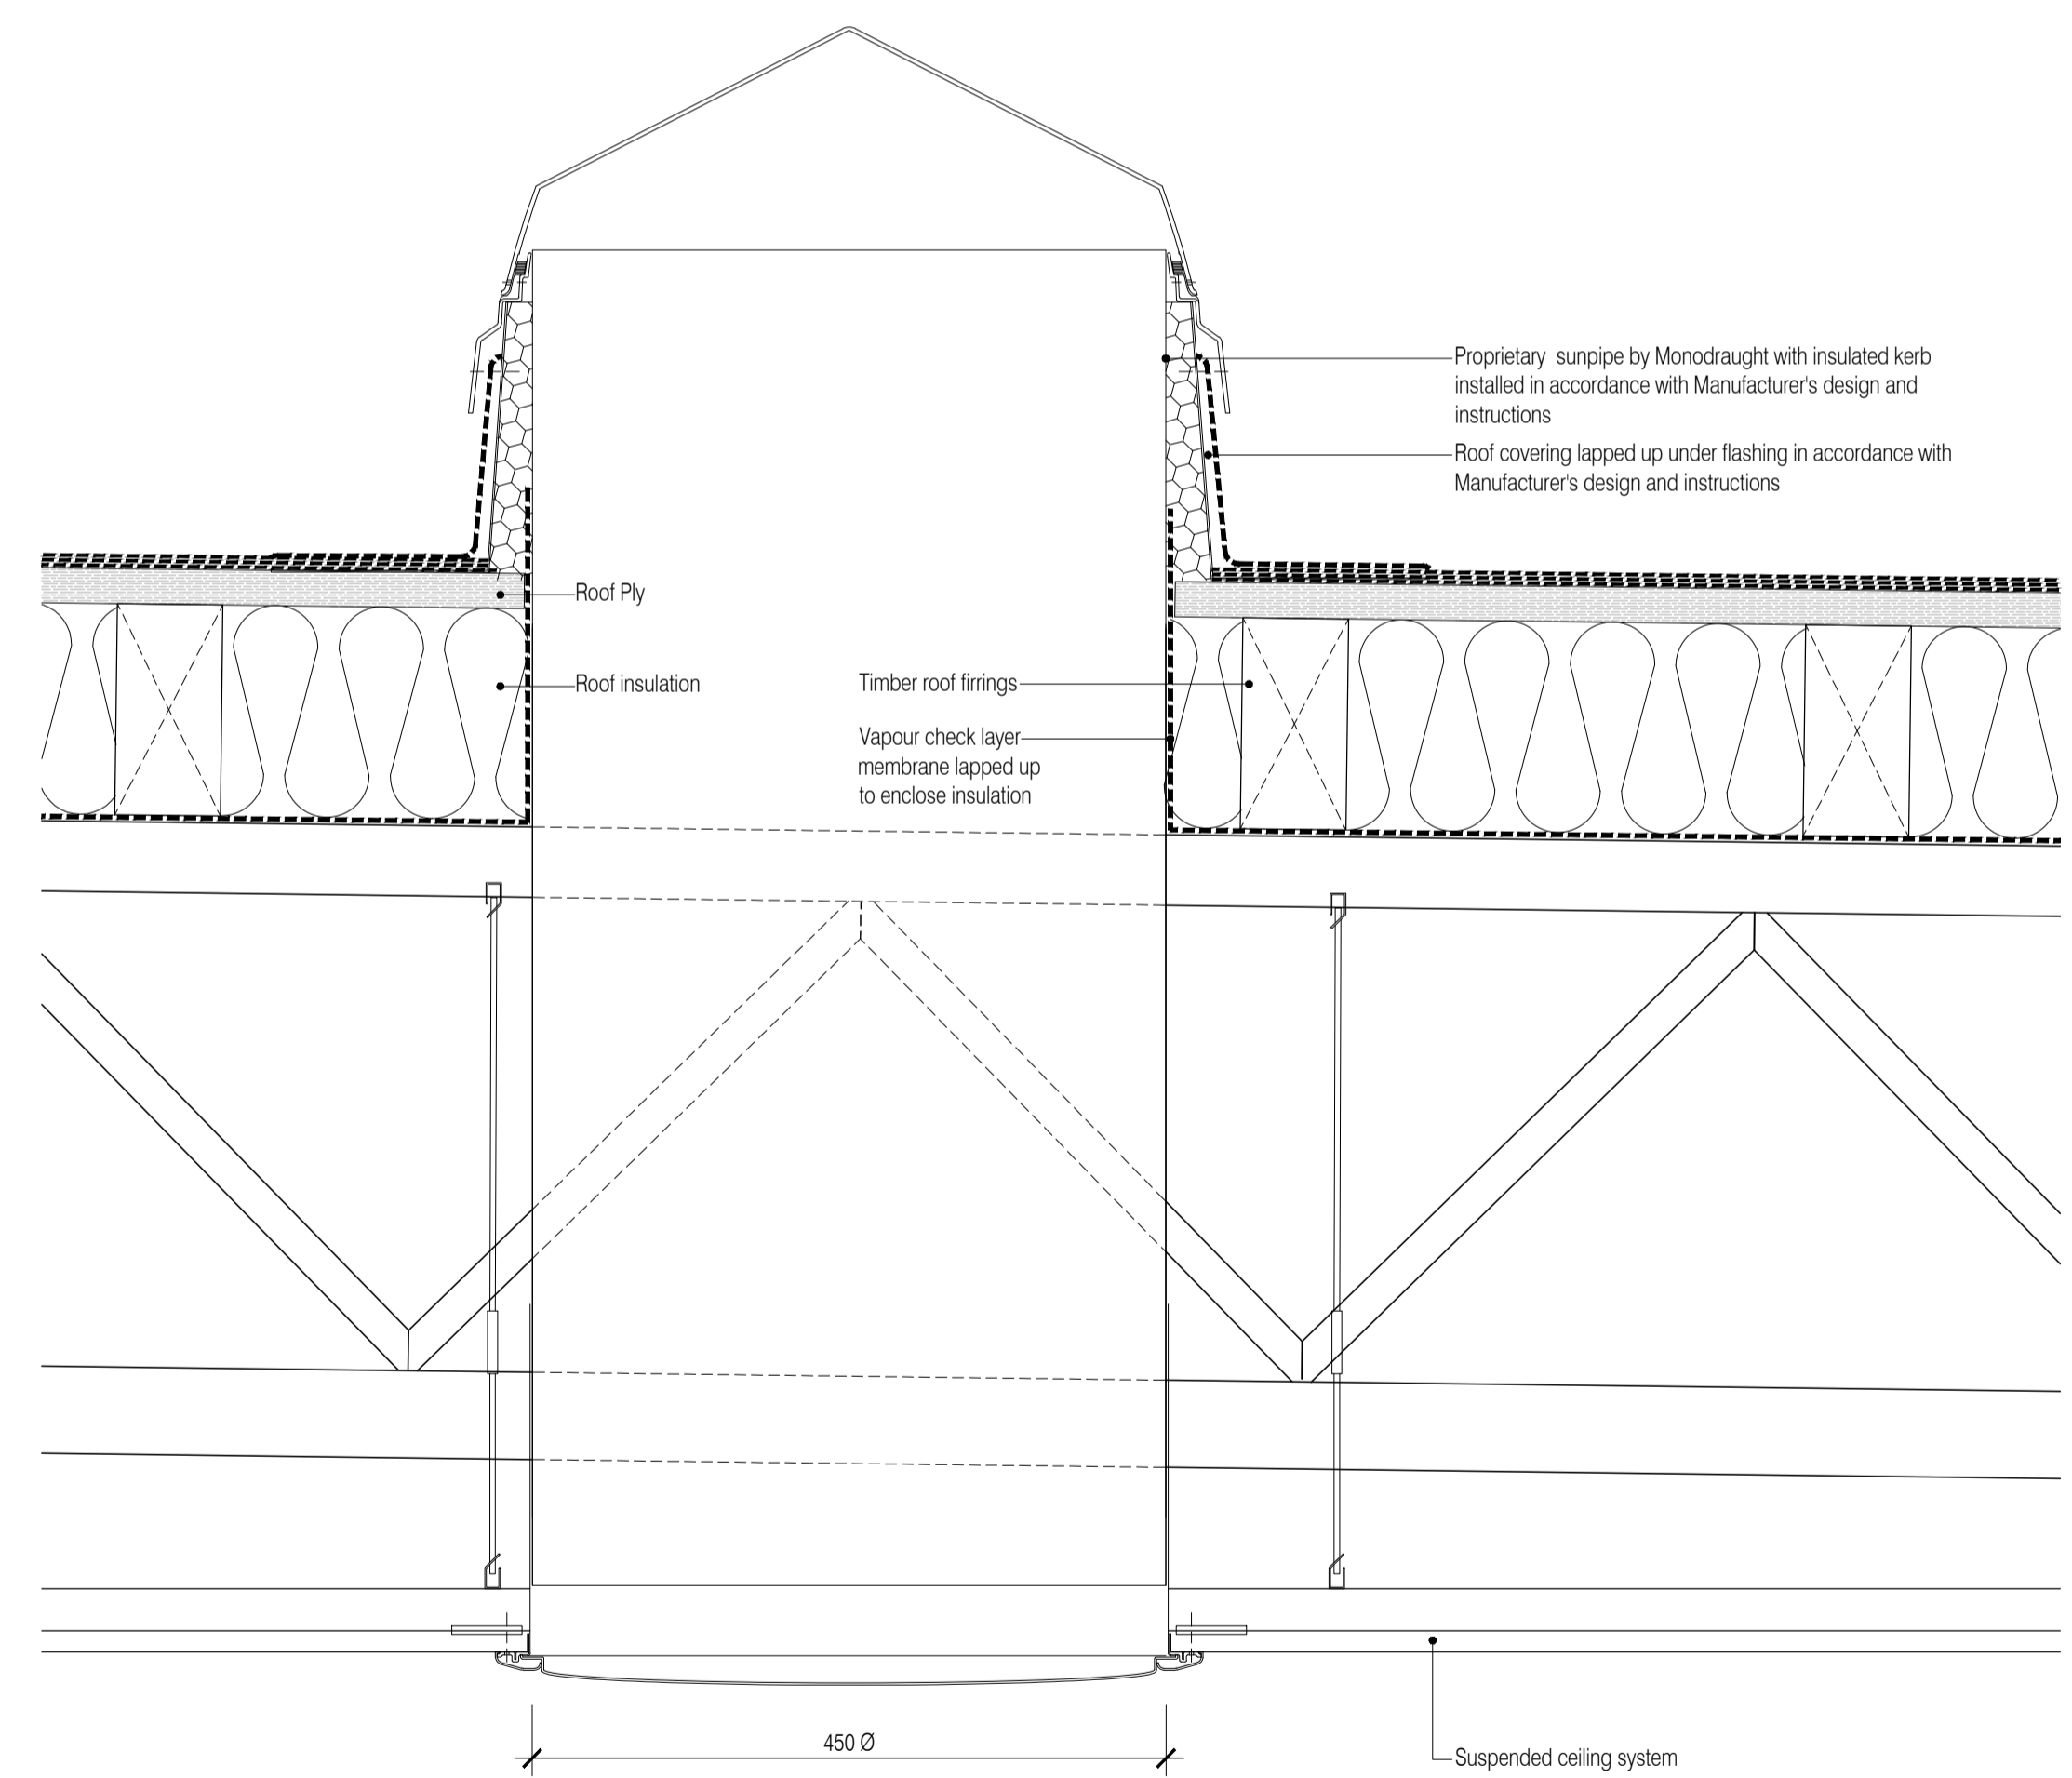

04 Sunpipe Detail
Scale:1:5

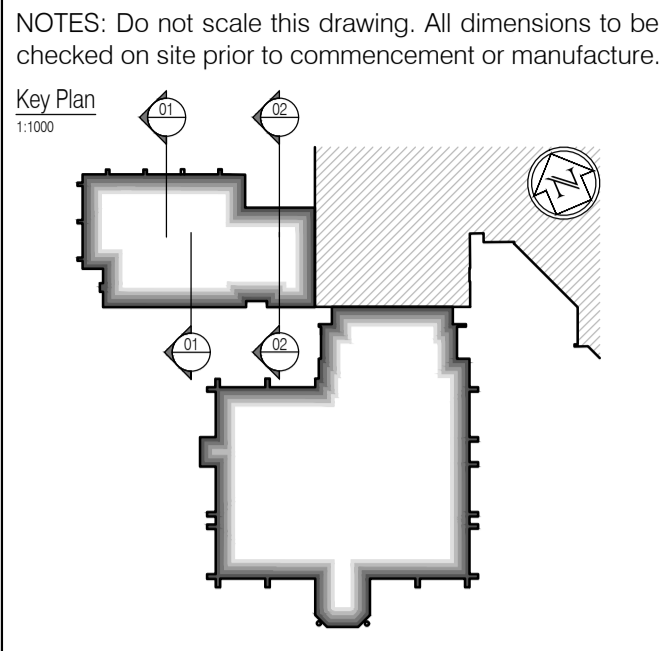

NOTES: Do not scale this drawing. All dimensions to be checked on site prior to commencement or manufacture.

Key Plan 1:100

AS BUILT DRAWING

NB: - Solid gray hatch denotes existing building fabric.

Rev	Date	By	Clk	Comment


BRINGING IDEAS TO LIFE



FRANKHAM

Frankham Consultancy Group Limited
21 Plympton Road
Haywards Heath RH16 3TP
t 01444 444900 f 01444 455642
enquire@frankham.com
www.frankham.com

Client



WILLMOTT DIXON CONSTRUCTION

Project Title

Wealden District Council
Hailsham Head Quarters
Refurbishments and Alterations

Drawing Title

Proposed Community Hall Sections
& Details

Drawn by: RKC	Scale: 1:100, 5@A1	Date: 27.05.11
Designed by: FCG	Checked by: JAS	Approved by: AC

File Ref.:	X:\FRANKHAM\2011\16\WALDEN\20ARCH20_06_SECTION8.dwg	20.06.11 16:10:58
Drawing No.	521185-A-204	Rev. -

NB: All information based on supplied third party survey information. All discrepancies to be reported to FCG immediately upon discovery.

All Mechanical & Electrical and Structural information shown indicative only. Please refer to Mechanical & Electrical and Structural documentation.