



Ordnance Survey, (c) Crown Copyright 2012. All rights reserved. Licence number 100020449

01 Location Plan  
Scale: 1:1250

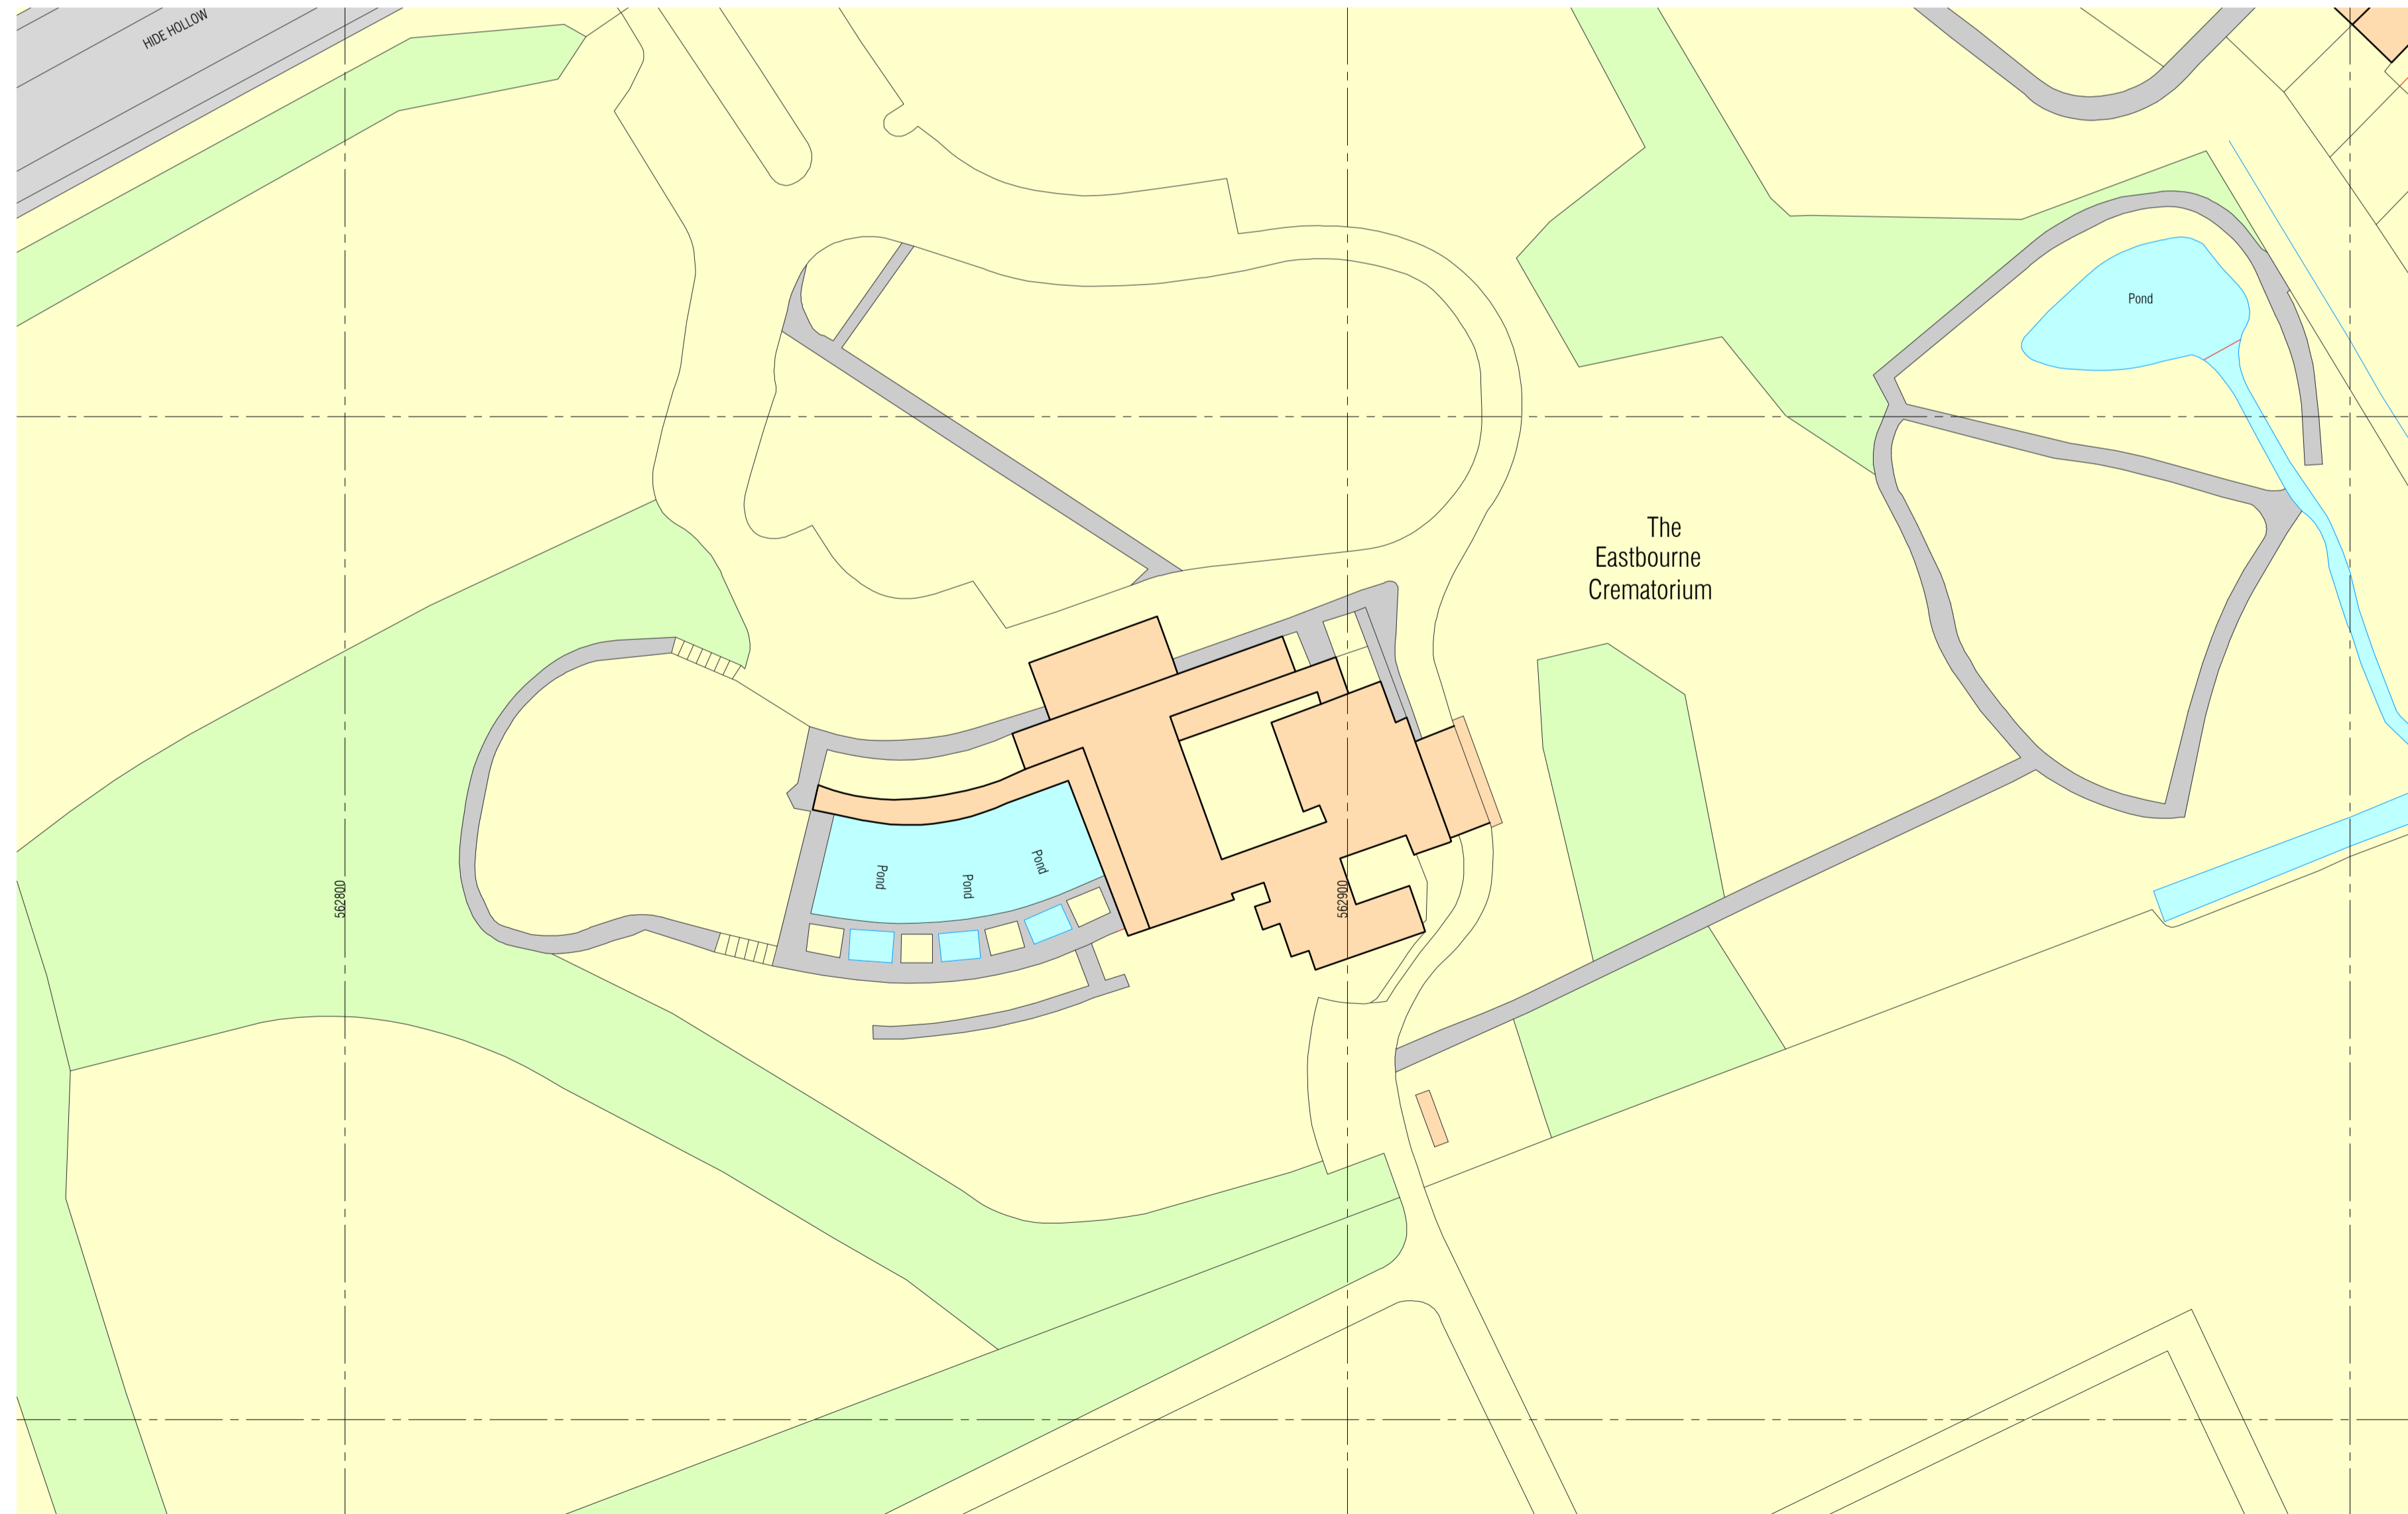

02 Block Plan  
Scale: 1:1250

NOTES: Do not scale this drawing. All dimensions to be checked on site prior to commencement or manufacture.  
Key Plan (m/s)

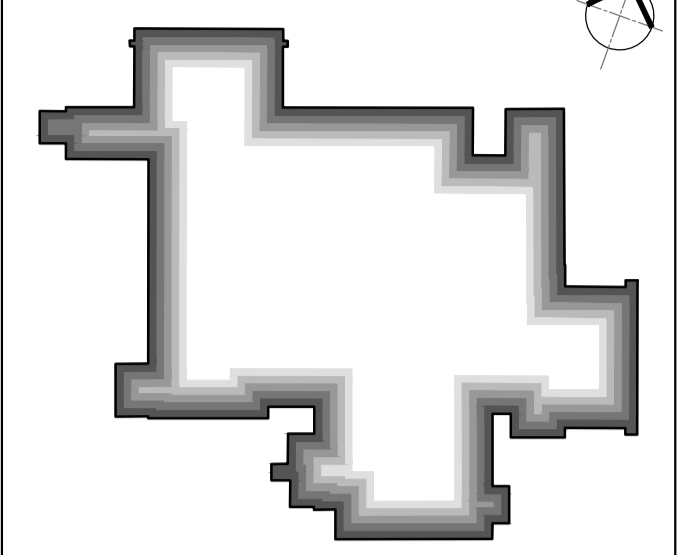

AS BUILT  
DRAWING

All details referenced in call outs supercede general arrangement or larger depictions.

Rev	Date	By	Chk	Comment
AB1	07.01.13	FRKC	JAS	DRAWING ISSUED - AS BUILT

AB1 07.01.13 FRKC JAS DRAWING ISSUED - AS BUILT

BRINGING IDEAS TO LIFE



FRANKHAM

Frankham Consultancy Group Limited  
21 Plympton Road  
Haywards Heath RH16 3TP  
t 01444 444900 f 01444 455642  
enquire@frankham.com  
www.frankham.com

Client  
**Mansell**  
Contract N°: MC0269

Project Title  
Eastbourne & Worthing  
Crematoria  
Refurbishments and Alterations

Drawing Title  
**EASTBOURNE**  
Eastbourne Crematorium  
Site Location & Block Plans

Drawn by: RKC	Scale: 1:100@A1	Date: 27.01.12
Designed by: FCG	Checked by: JAS	Approved by: AC

File Ref.: X:\FRANKHAM\2-2012\1210 CREMATORIA\ARCHIVE\999-BLOCK-AND-SITE-PLANS\521260-A-001-E.DWG - 200811190921 20.06.11.12.09.21

Drawing No. 521260-A-001-E	Rev. AB1
-------------------------------	-------------

NB: All information based on supplied third party survey information.  
All discrepancies to be reported to FCG immediately upon discovery.