


Ordnance Survey, (c) Crown Copyright 2012. All rights reserved. Licence number 100020449

01 Location Plan
Scale: 1:2500


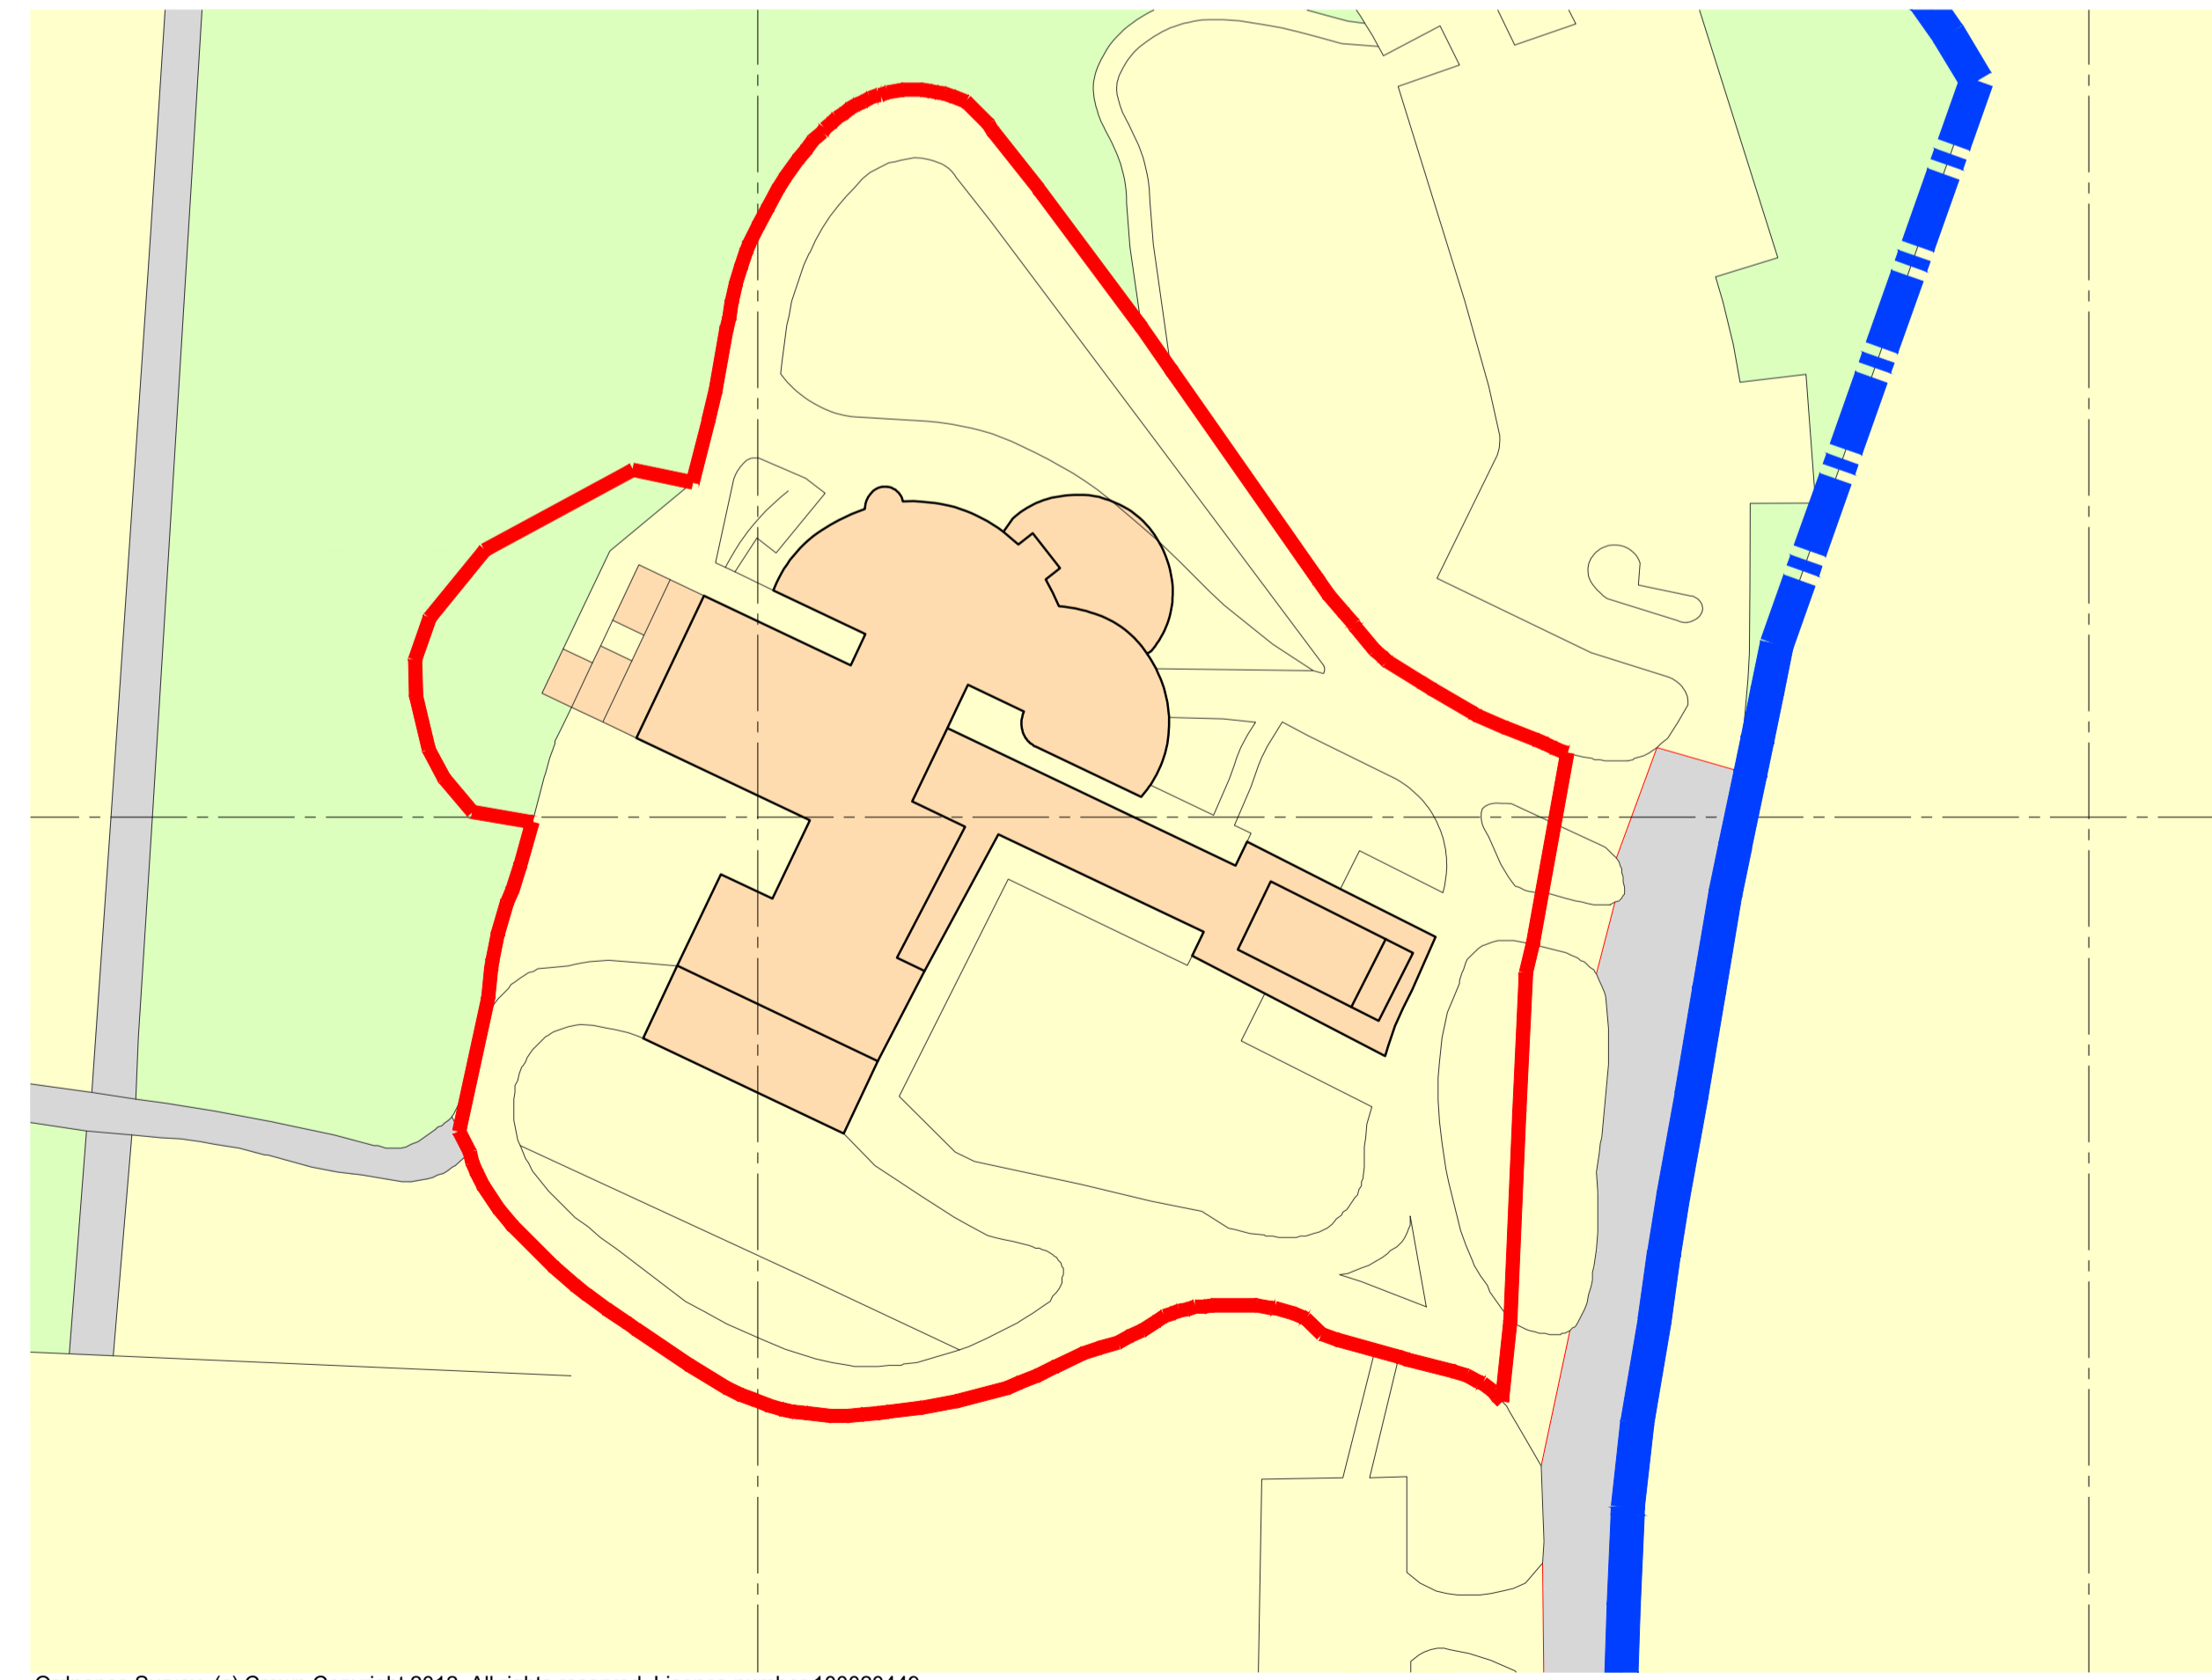


Ordnance Survey, (c) Crown Copyright 2012. All rights reserved. Licence number 100020449

02 Block Plan
Scale: 1:500

NB: All information based on supplied third party survey information. All discrepancies to be reported to FCG immediately upon discovery.

NOTES: Do not scale this drawing. All dimensions to be checked on site prior to commencement or manufacture.
Key Plan (nts)

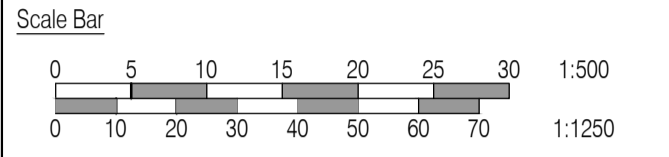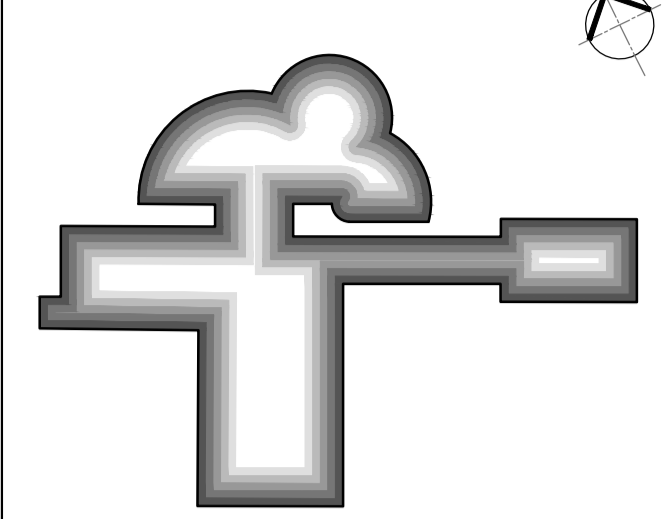

AS BUILT
DRAWING

All details referenced in call outs supercede general arrangement or larger depictions.

Rev	Date	By	Chk	Comment
AB1	07.01.13	RKC	JAS	DRAWING ISSUED - AS BUILT

BRINGING IDEAS TO LIFE



FRANKHAM

Frankham Consultancy Group Limited
21 Plymound Road
Haywards Heath RH16 3TP
t 01444 444900 f 01444 455642
enquire@frankham.com
www.frankham.com

Client



Mansell
Contract N°: Worthing

Project Title

Eastbourne & Worthing
Crematoria
Refurbishments and Alterations

Drawing Title



Worthing
Worthing Crematorium
Site Location & Block Plans

Drawn by: RKC	Scale: 1:500 & 2500@A1	Date: 07.02.12
Designed by: FCG	Checked by: JAS	Approved by: AC

File Ref.: X:\FRANKHAM\2-38512120-ORIS\DRAWING\005-000-BLOCK-AND-SITE-PLANS-20.06.11\12.09.24

Drawing No. 521260-A-005-W	Rev. AB1
-------------------------------	-------------