
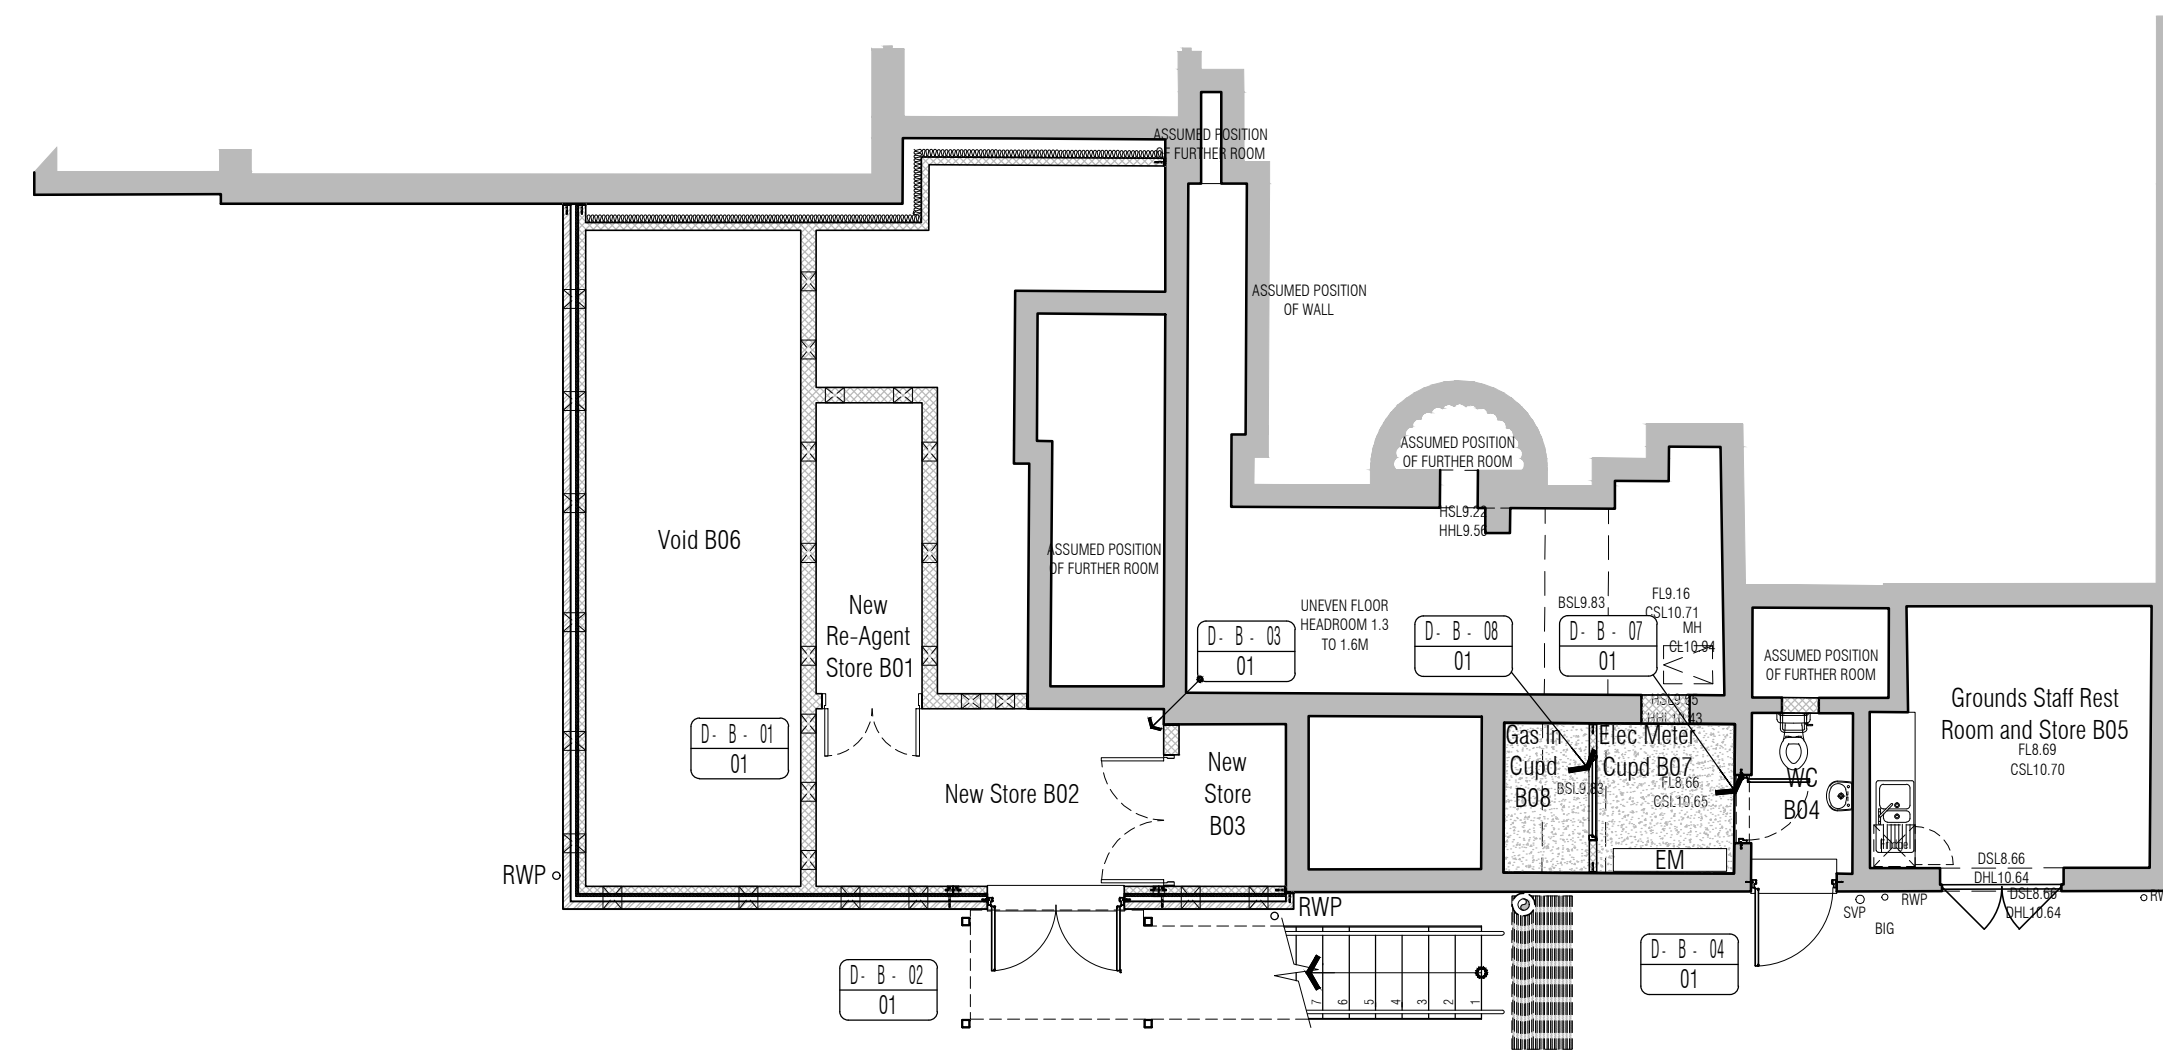


NOTES: Do not scale this drawing. All dimensions to be checked on site prior to commencement or manufacture.
Key Plan (r/s)

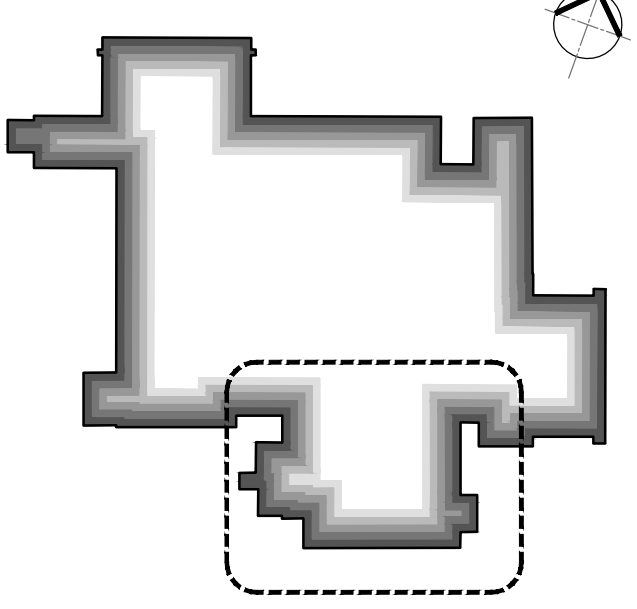

Refer to Dwg
521260-L-120-E
for Landscaping
Scheme

**AS BUILT
DRAWING**

All details referenced in call outs supersede general arrangement or larger depictions.

Rev	Date	By	Chk	Comment
01	07.01.13	RKC	JAS	DRAWING ISSUED - AS BUILT

BRINGING IDEAS TO LIFE

FRANKHAM

Frankham Consultancy Group Limited
21 Pymons Road
Haywards Heath RH16 3TP
t 01444 444900 f 01444 455642
enquire@frankham.com
www.frankham.com

Client

Contract N°: MC0269

Project Title

Eastbourne & Worthing
Crematoria
Refurbishments and Alterations

Drawing Title

Eastbourne Crematorium
Lower Ground Floor
General Arrangement Plan

Drawn by: RKC	Scale: 1:100@A1	Date: 18.10.11
Designed by: FCG	Checked by: JAS	Approved by: AC

File Ref.: X:\FRANKHAM\21 Pymons Road\CREMATORIA\ARCH\105-109-LOCATOR PLAN AND G.A.	20.06.11.12.11.07
Drawing No. 521260-A-130-E	Rev. 01