


NOTES: Do not scale this drawing. All dimensions to be checked on site prior to commencement or manufacture.
Key Plan (nts)

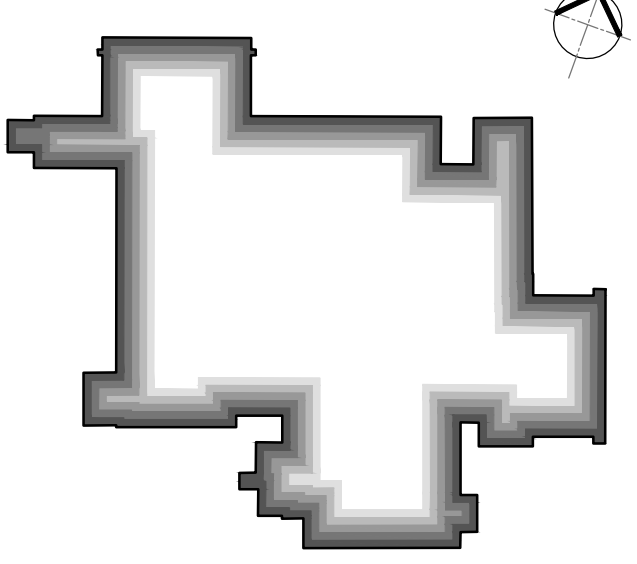

**AS BUILT
DRAWING**

All details referenced in call outs supercede general arrangement or larger depictions.

Rev	Date	By	Chk	Comment
01	07.01.13	FRKC	JAS	DRAWING ISSUED - AS BUILT

BRINGING IDEAS TO LIFE



FRANKHAM

Frankham Consultancy Group Limited
21 Perryman Road
Haywards Heath RH16 3TP
t 01444 444000 f 01444 455642
enquire@frankham.com
www.frankham.com

Client




Mansell
Contract N°: MC0269

Project Title

Eastbourne & Worthing
Crematoria
Refurbishments and Alterations

Drawing Title



EASTBOURNE
Council

Eastbourne Crematorium
Ground Floor
General Arrangement Plan

Drawn by: RKC	Scale: 1:50@A1	Date: 19.10.11
Designed by: FCG	Checked by: JAS	Approved by: AC

File Ref.: X:\FRANKHAM\2\JOB\01260 CREMATORIA\ARCH\105-109-LOCATOR PLAN-AND-GK
1:50@A1-131-ENG - 200811271212 20.06.11.12.11.12

Drawing No. 521260-A-131-E	Rev. 01
-------------------------------	------------