



All Disabled and Ambulant Disabled facilities to comply with Approved Document Part M - Access to and use of buildings, Disability Discrimination Act 1995 and BS83000 as required

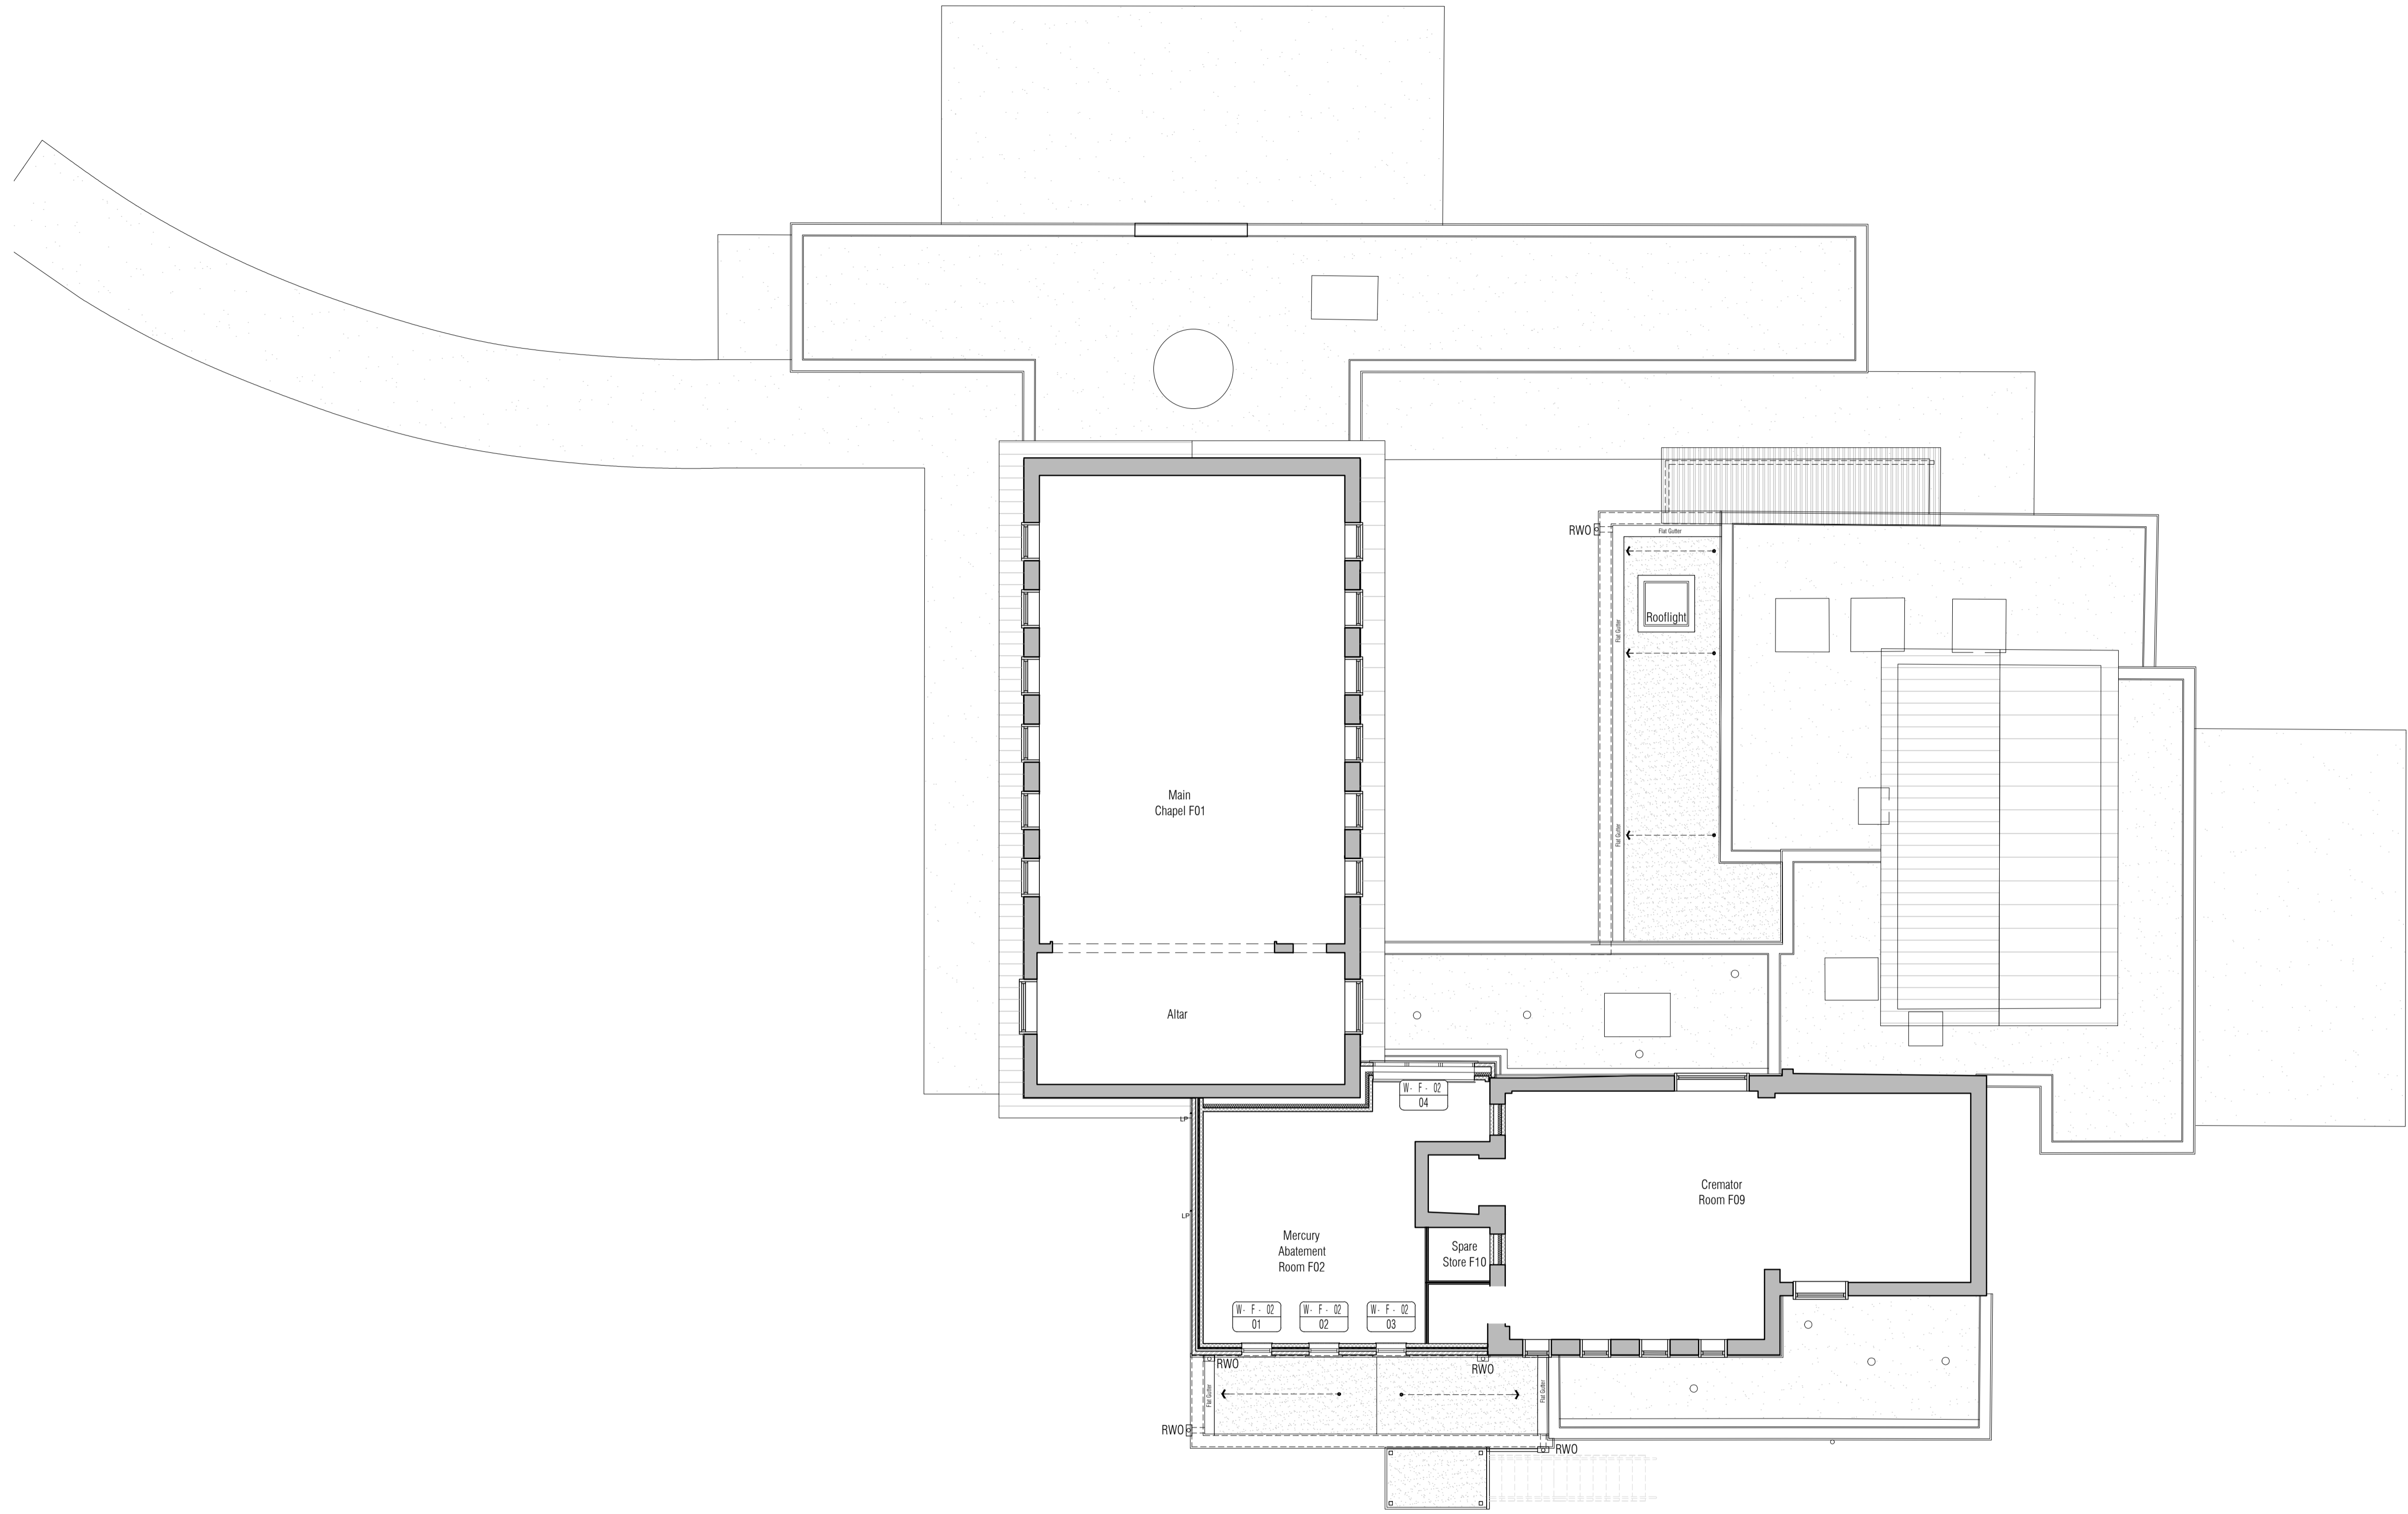

NOTES: Do not scale this drawing. All dimensions to be checked on site prior to commencement or manufacture.  
Key Plan (nts)

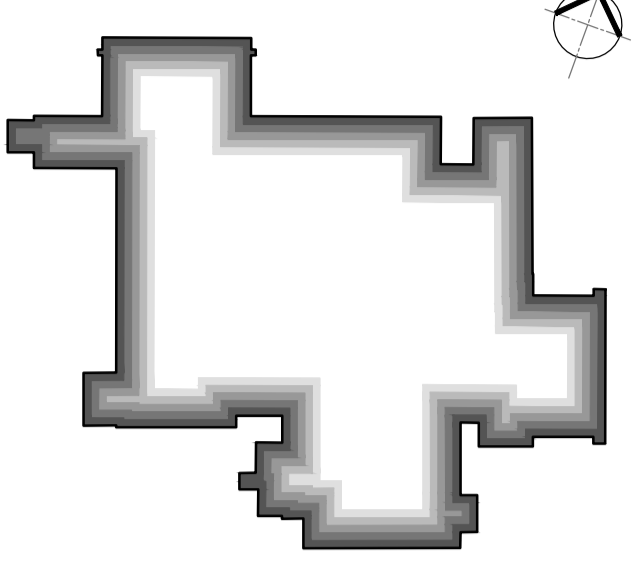

**AS BUILT  
DRAWING**

All details referenced in call outs supersede general arrangement or larger depictions.

Rev	Date	By	Chk	Comment
01	07.01.13	RKC	JAS	DRAWING ISSUED - AS BUILT

Rev	Date	By	Chk	Comment
01	07.01.13	RKC	JAS	DRAWING ISSUED - AS BUILT

BRINGING IDEAS TO LIFE



**FRANKHAM**

Frankham Consultancy Group Limited  
21 Plympton Road  
Haywards Heath RH16 3TP  
t 01444 444900 f 01444 455642  
enquire@frankham.com  
www.frankham.com

Client




Mansell  
Contract N°: MC0269

Project Title

Eastbourne & Worthing  
Crematoria  
Refurbishments and Alterations

Drawing Title



Eastbourne Crematorium  
First Floor  
General Arrangement Plan

Drawn by: RKC	Scale: 1:50@A1	Date: 11.01.12
Designed by: FCG	Checked by: JAS	Approved by: AC

File Ref.: X:\FRANKHAM\21 PLYMPTON ROAD\CREMATORIA\ARCH\106-109\LOCATOR PLANS AND GA\20.06.11.12.11.17

Drawing No. 521260-A-132-E	Rev. 01
-------------------------------	------------

NB: All information based on supplied third party survey information.  
All discrepancies to be reported to FCG immediately upon discovery.