


NOTES: Do not scale this drawing. All dimensions to be checked on site prior to commencement or manufacture.
Key Plan (nts)

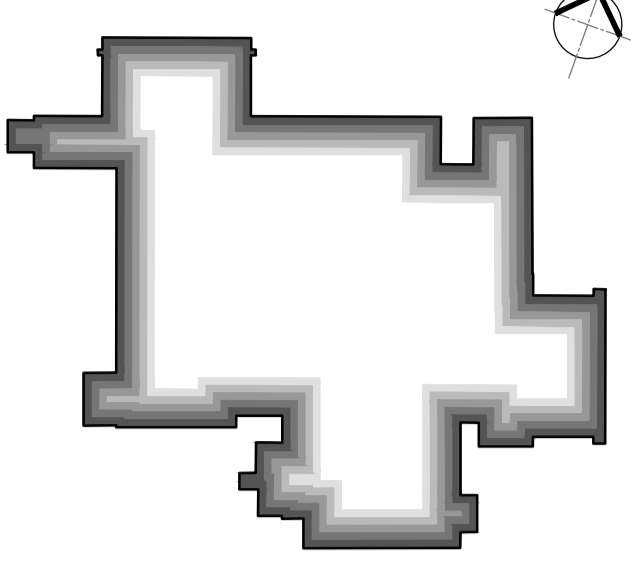

**AS BUILT
DRAWING**

All details referenced in call outs supersede general arrangement or larger depictions.

Rev	Date	By	Chk	Comment
01	07.01.13	RKC	JAS	DRAWING ISSUED - AS BUILT

01 07.01.13 RKC JAS DRAWING ISSUED - AS BUILT

Rev Date By Chk Comment

BRINGING IDEAS TO LIFE



FRANKHAM

Frankham Consultancy Group Limited
21 Pymons Road
Haywards Heath RH16 3TP
t 01444 444000 f 01444 455642
enquire@frankham.com
www.frankham.com

Client




Contract N°: MC0269

Project Title

Eastbourne & Worthing
Crematoria
Refurbishments and Alterations

Drawing Title



Eastbourne Crematorium
Roof General Arrangement Plan

Drawn by: RKC	Scale: 1:100@A1	Date: 18.10.11
Designed by: FCG	Checked by: JAS	Approved by: AC

File Ref.: X:\FRANKHAM\21 Pymons Road\CREMATORIA\ARCH\106-109\SECTION PLANS AND GR...
20.06.11.12.11.21

Drawing No. 521260-A-133-E	Rev. 01
-------------------------------	------------

NB: All information based on supplied third party survey information.
All discrepancies to be reported to FCG immediately upon discovery.