

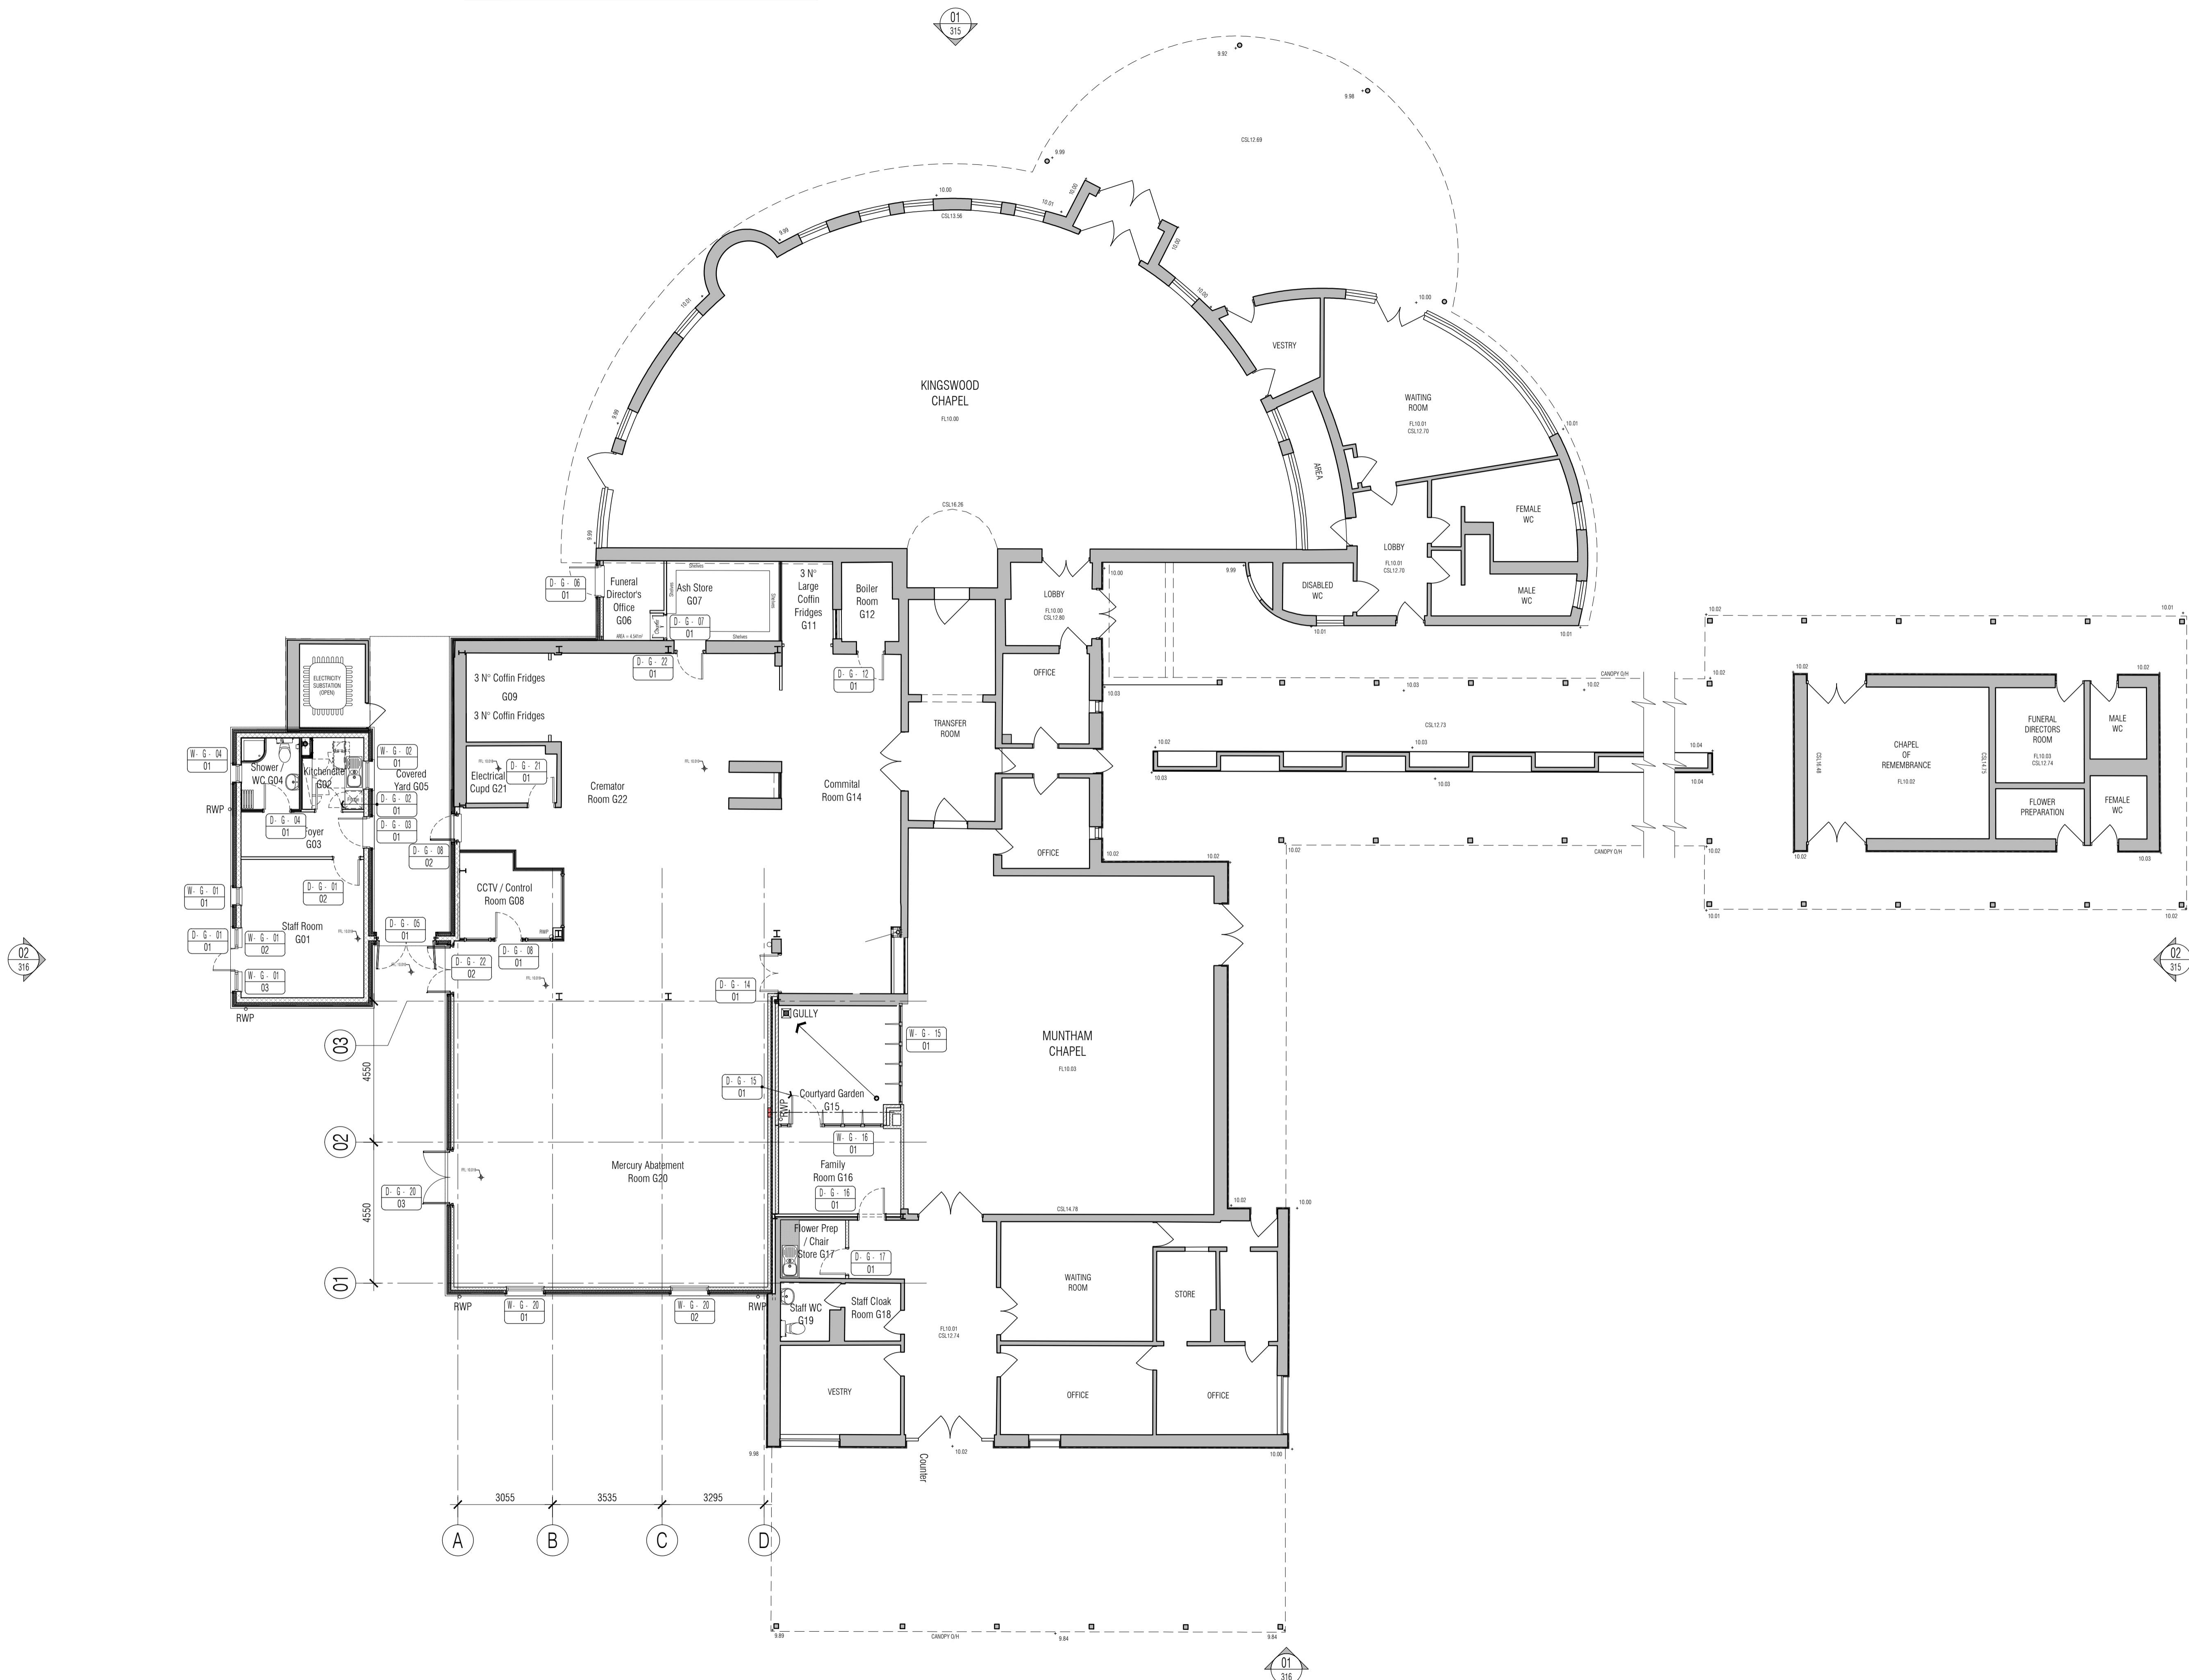


All Disabled and Ambulant Disabled facilities to comply with Approved Document Part M - Access to and use of buildings, Disability Discrimination Act 1995 and BS83000 as required

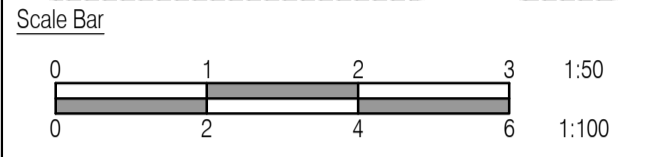

NOTES: Do not scale this drawing. All dimensions to be checked on site prior to commencement or manufacture.
Key Plan (mts)

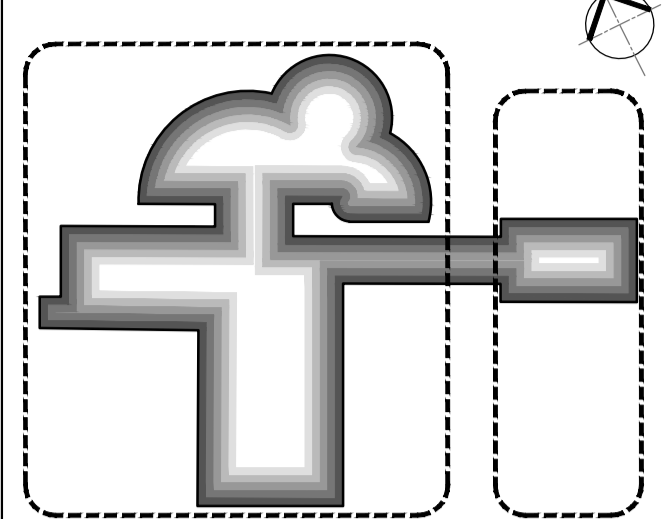

AS BUILT DRAWING

All details referenced in call outs supersede general arrangement or larger depictions.

Rev	Date	By	Chk	Comment
AB1	07.01.13	RKC	JAS	DRAWING ISSUED - AS BUILT

BRINGING IDEAS TO LIFE

FRANKHAM

Frankham Consultancy Group Limited
21 Plympton Road
Haywards Heath RH16 3TP
t 01444 444000 f 01444 455642
enquiries@frankham.com
www.frankham.com

Client

Contract N°: Worthing

Project Title

Eastbourne & Worthing
Crematoria
Refurbishments and Alterations

Drawing Title

Worthing Crematorium
Ground Floor
General Arrangement Plan

Drawn by: RKC	Scale: 1:100@A1	Date: 18.10.11
Designed by: FCG	Checked by: JAS	Approved by: AC

File Ref.: X:\FRANKHAM\21 PLYMPTON ROAD\CREMATORIA\ARCH\106-109-LOCATOR PLANS AND GR...
20.06.11.12.11.26

Drawing No. 521260-A-135-W	Rev. AB1
-------------------------------	-------------

NB: All information based on supplied third party survey information.
All discrepancies to be reported to FCG immediately upon discovery.