




01  
315





KINGSWOOD  
CHAPEL

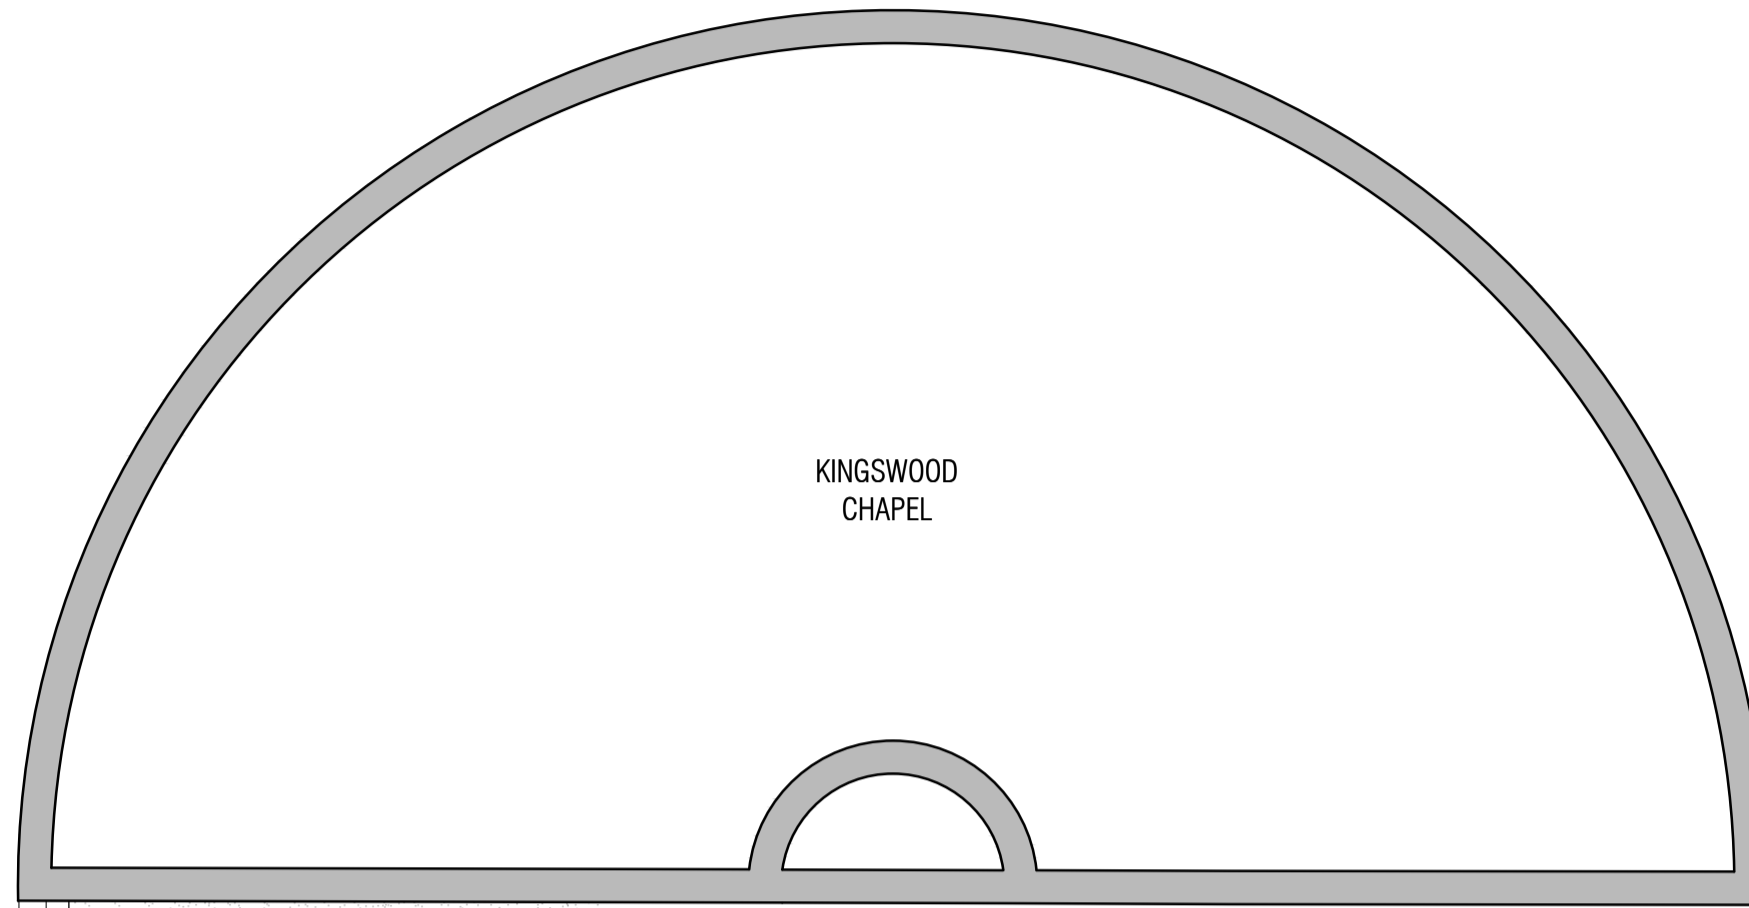

02  
316

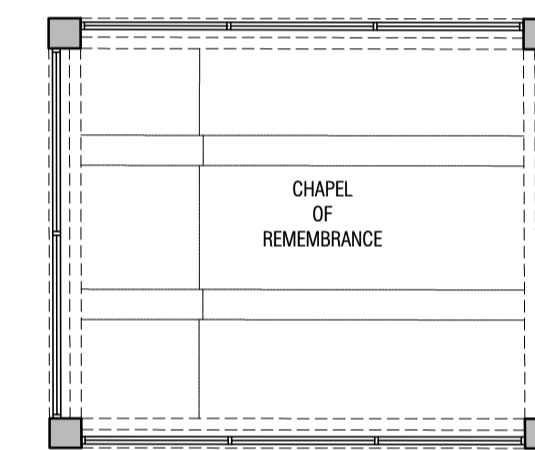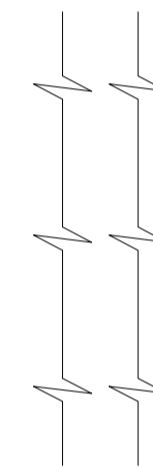

NOTES: Do not scale this drawing. All dimensions to be checked on site prior to commencement or manufacture.  
Key Plan (m/s)

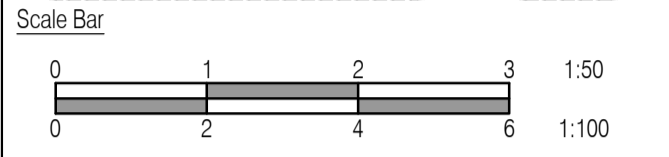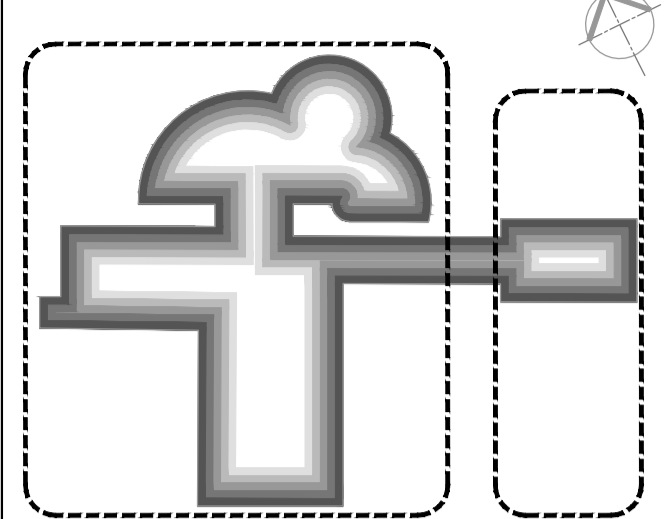

Scale Bar  
0 1 2 3 1.50  
0 2 4 6 1:100

AS BUILT  
DRAWING

All details referenced in call outs supercede general arrangement or larger depictions.

Rev	Date	By	Chk	Comment
AB1	07.01.13	RKC	JAS	DRAWING ISSUED - AS BUILT

BRINGING IDEAS TO LIFE

**FRANKHAM**

Frankham Consultancy Group Limited  
21 Parnymount Road  
Haywards Heath RH16 3TP  
t 01444 444000 f 01444 455642  
enquire@frankham.com  
www.frankham.com

Client

Mansell  
Contract N°: Worthing

Project Title

Eastbourne & Worthing  
Crematoria  
Refurbishments and Alterations

Drawing Title

Worthing Crematorium  
General Arrangement First Floor Plan

Drawn by: RKC	Scale: 1:100@A1	Date: 20.01.12
Designed by: FCG	Checked by: JAS	Approved by: AC

File Ref.: X:\FRANKHAM\21 PARNYMOUNT ROAD\105-109 LOCATOR PLANS AND GR... 20.06.11.12.11.31

Drawing No. 521260-A-136-W	Rev. AB1
-------------------------------	-------------

NB: All information based on supplied third party survey information.  
All discrepancies to be reported to FCG immediately upon discovery.

01  
315