



01 East Elevation
Scale: 1:100

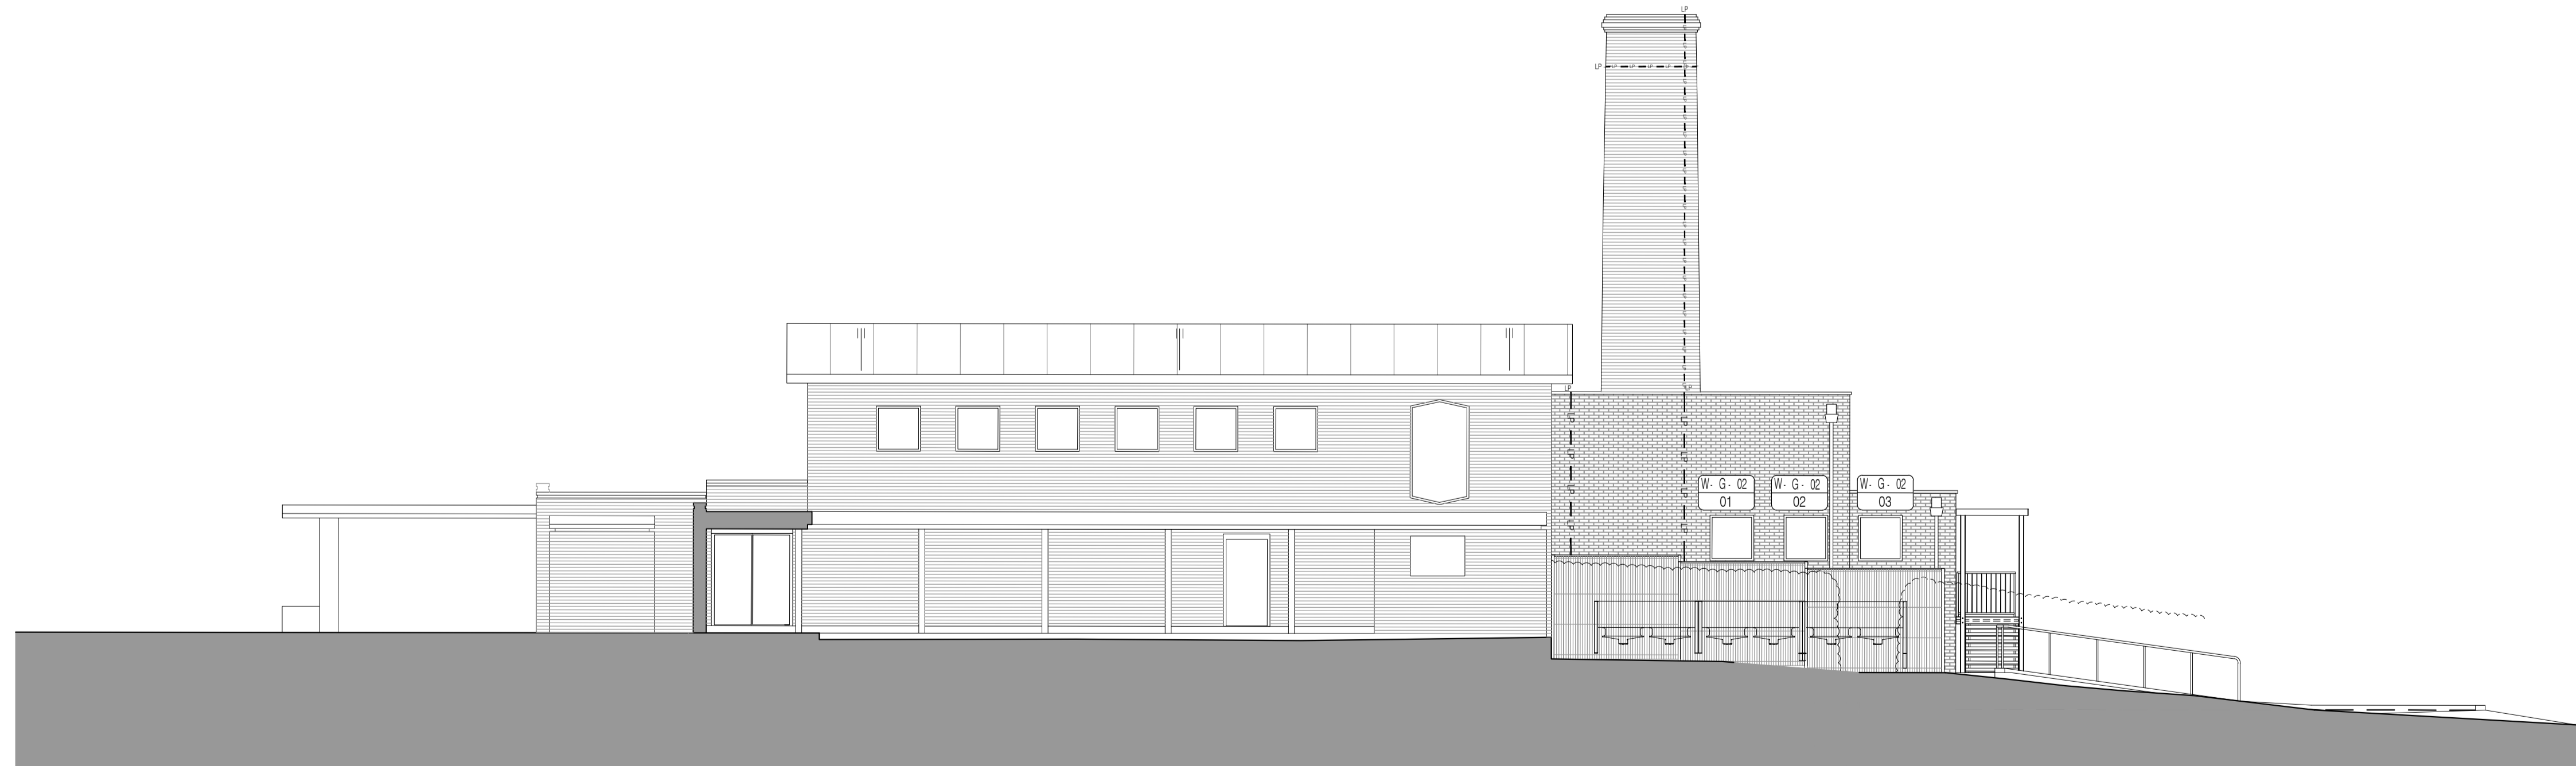

02 West Elevation
Scale: 1:100

NOTES: Do not scale this drawing. All dimensions to be checked on site prior to commencement or manufacture.
Key Plan (nts)

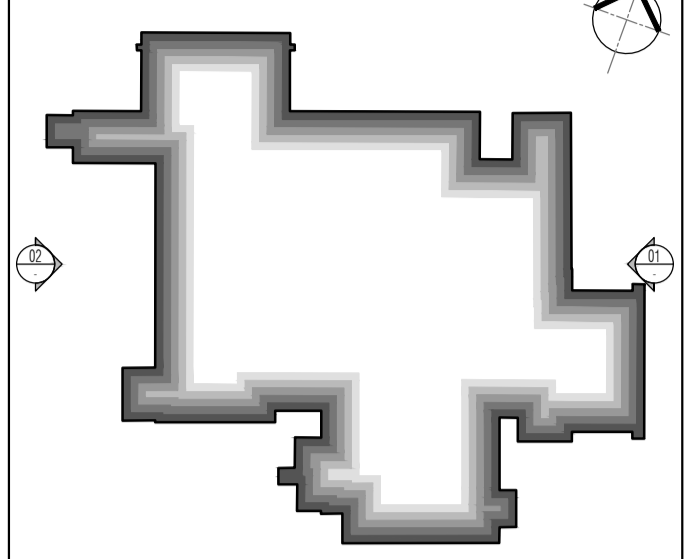

AS BUILT
DRAWING

All details referenced in call outs supercede general arrangement or larger depictions.

Rev	Date	By	Chk	Comment
AB1	07.01.13	RKC	JAS	DRAWING ISSUED - AS BUILT

Rev	Date	By	Chk	Comment
AB1	07.01.13	RKC	JAS	DRAWING ISSUED - AS BUILT

Rev	Date	By	Chk	Comment
AB1	07.01.13	RKC	JAS	DRAWING ISSUED - AS BUILT



FRANKHAM

Frankham Consultancy Group Limited
21 Plymound Road
Haywards Heath RH12 3TP
t 01444 444900 f 01444 455642
enquire@frankham.com
www.frankham.com

Client



Contract N°: MC0269

Project Title

Eastbourne & Worthing
Crematoria
Refurbishments and Alterations

Drawing Title



Eastbourne Crematorium
Proposed East & West Elevations

Drawn by: RKC	Scale: 1:100@A1	Date: 28.10.11
Designed by: FCG	Checked by: JAS	Approved by: AC

File Ref.: X:\FRANKHAM\21 PLYMOUND ROAD\CREMATORIA\ARCH\06-09-09\ELEVATIONS\20.06.11\12-16-14

Drawing No. 521260-A-311-E	Rev. AB1
-------------------------------	-------------

NB: All information based on supplied third party survey information.
All discrepancies to be reported to FCG immediately upon discovery.