


NOTES: Do not scale this drawing. All dimensions to be checked on site prior to commencement or manufacture.  
Key Plan (n/s)

Scale Bar



01 South Elevation  
Scale: 1:100

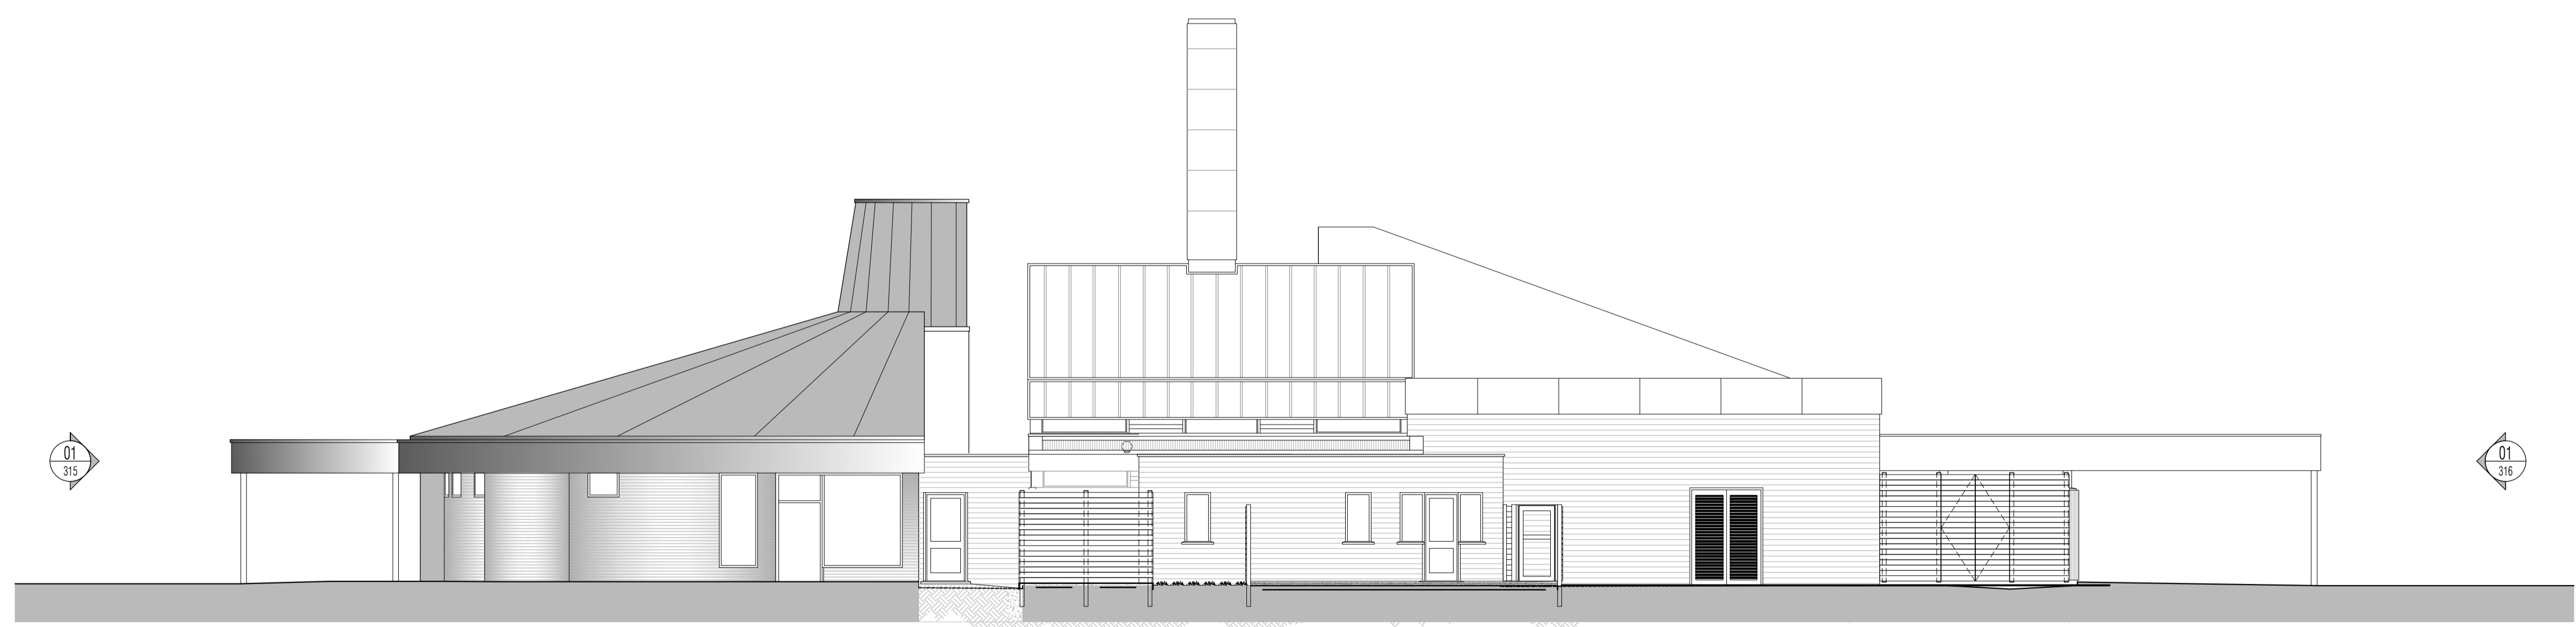

02 West Elevation  
Scale: 1:100

AS BUILT  
DRAWING

All details referenced in call outs supercede general arrangement or larger depictions.

Rev	Date	By	Chk	Comment
AB1	07.01.13	RKC	JAS	DRAWING ISSUED - AS BUILT

BRINGING IDEAS TO LIFE

**FRANKHAM**

Frankham Consultancy Group Limited  
21 Parnymount Road  
Haywards Heath RH12 3TP  
t 01444 444900 f 01444 455642  
enquire@frankham.com  
www.frankham.com

Client

Mansell  
Contract N°: Worthing

Project Title

Eastbourne & Worthing  
Crematoria  
Refurbishments and Alterations

Drawing Title

Worthing Crematorium  
Proposed South & West Elevations

Drawn by: RKC	Scale: 1:100@A1	Date: 28.10.11
Designed by: FCG	Checked by: JAS	Approved by: AC

File Ref.: X:\FRANKHAM\2-ASBUILT\01 CREMATORIA\ARCH\06-000-01.ELEVATIONS 1:100@A1-01-02-03-999-1000	20.06.11 12:16:23
Drawing No: 521260-A-316-W	Rev: AB1

NB: All information based on supplied third party survey information.  
All discrepancies to be reported to FCG immediately upon discovery.