



01 Ground Floor Level Plan
Scale: 1:100

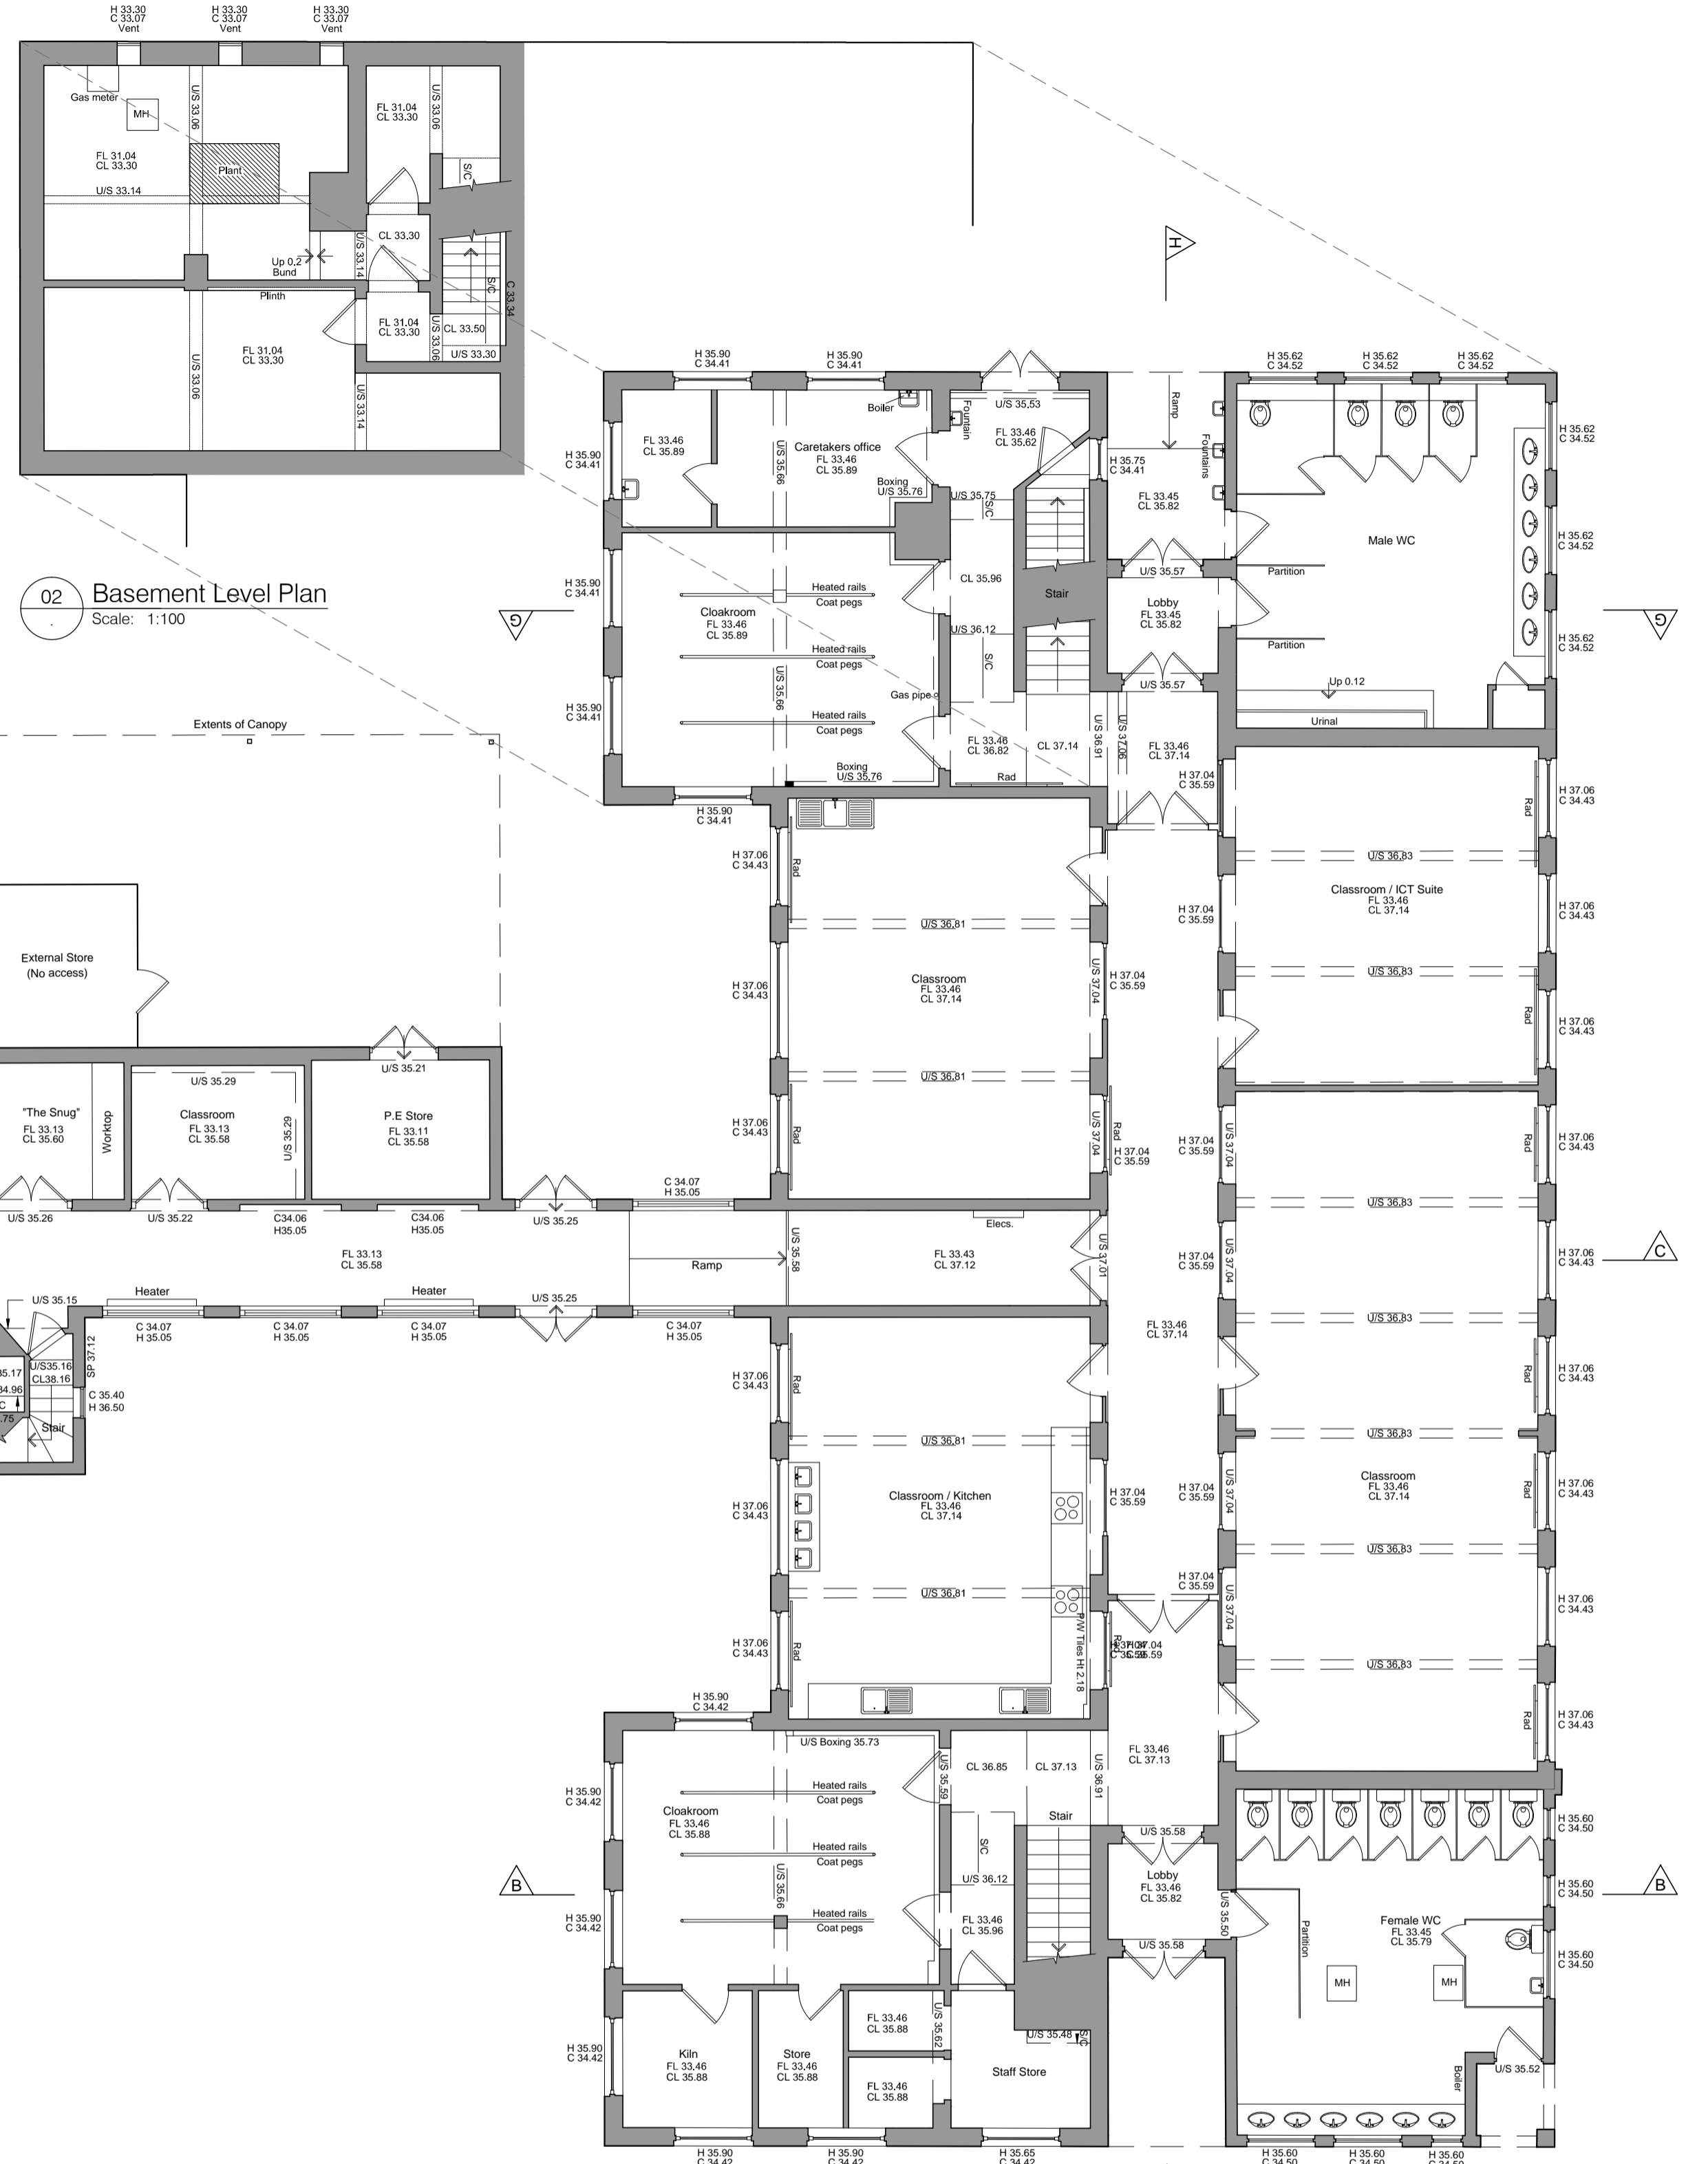

02 Basement Level Plan
Scale: 1:100

NOTES: Do not scale this drawing. All dimensions to be checked on site prior to commencement or manufacture.
NB: All information based on supplied third party survey information. All discrepancies to be reported to FCG immediately upon discovery.

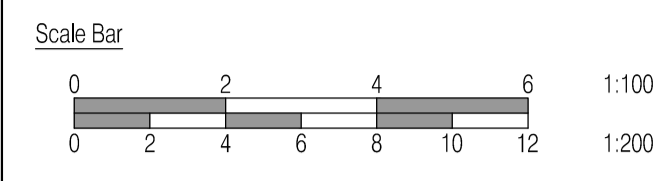

AS BUILT
DRAWING

Rev	Date	By	Clk	Comment

AB1 17.04.14 RKC AGC DRAWING ISSUED - AS BUILT



FRANKHAM

Frankham Consultancy Group Limited

Frankham House Wootton Business Park
Besselsleigh Road Wootton Abingdon
Oxfordshire OX13 6FD
T 01865 322500 F 01865 327393
E enquire@frankham.com
www.frankham.com



Project Title
Whitehall Junior & Infant School
Refurbishment, Extension and New Build
Cowley Road
London Borough of Hillingdon

Drawing Title
Junior School
Existing Ground Floor Plan &
Basement Level Plan

Drawn by: RKC	Scale: 1:100@A1	Date: 23.04.12
Designed by: FCG	Checked by: JAS	Approved by: AC

File Ref: J:\000001\BIB-HELVINGDON\SCHOOL-NEW\ALL REVISED\DWG\10_LOCATION PLANS AND GAs
14.04.24.10.30.45

Drawing No. 611869-A-103	Rev. AB1
-----------------------------	-------------