
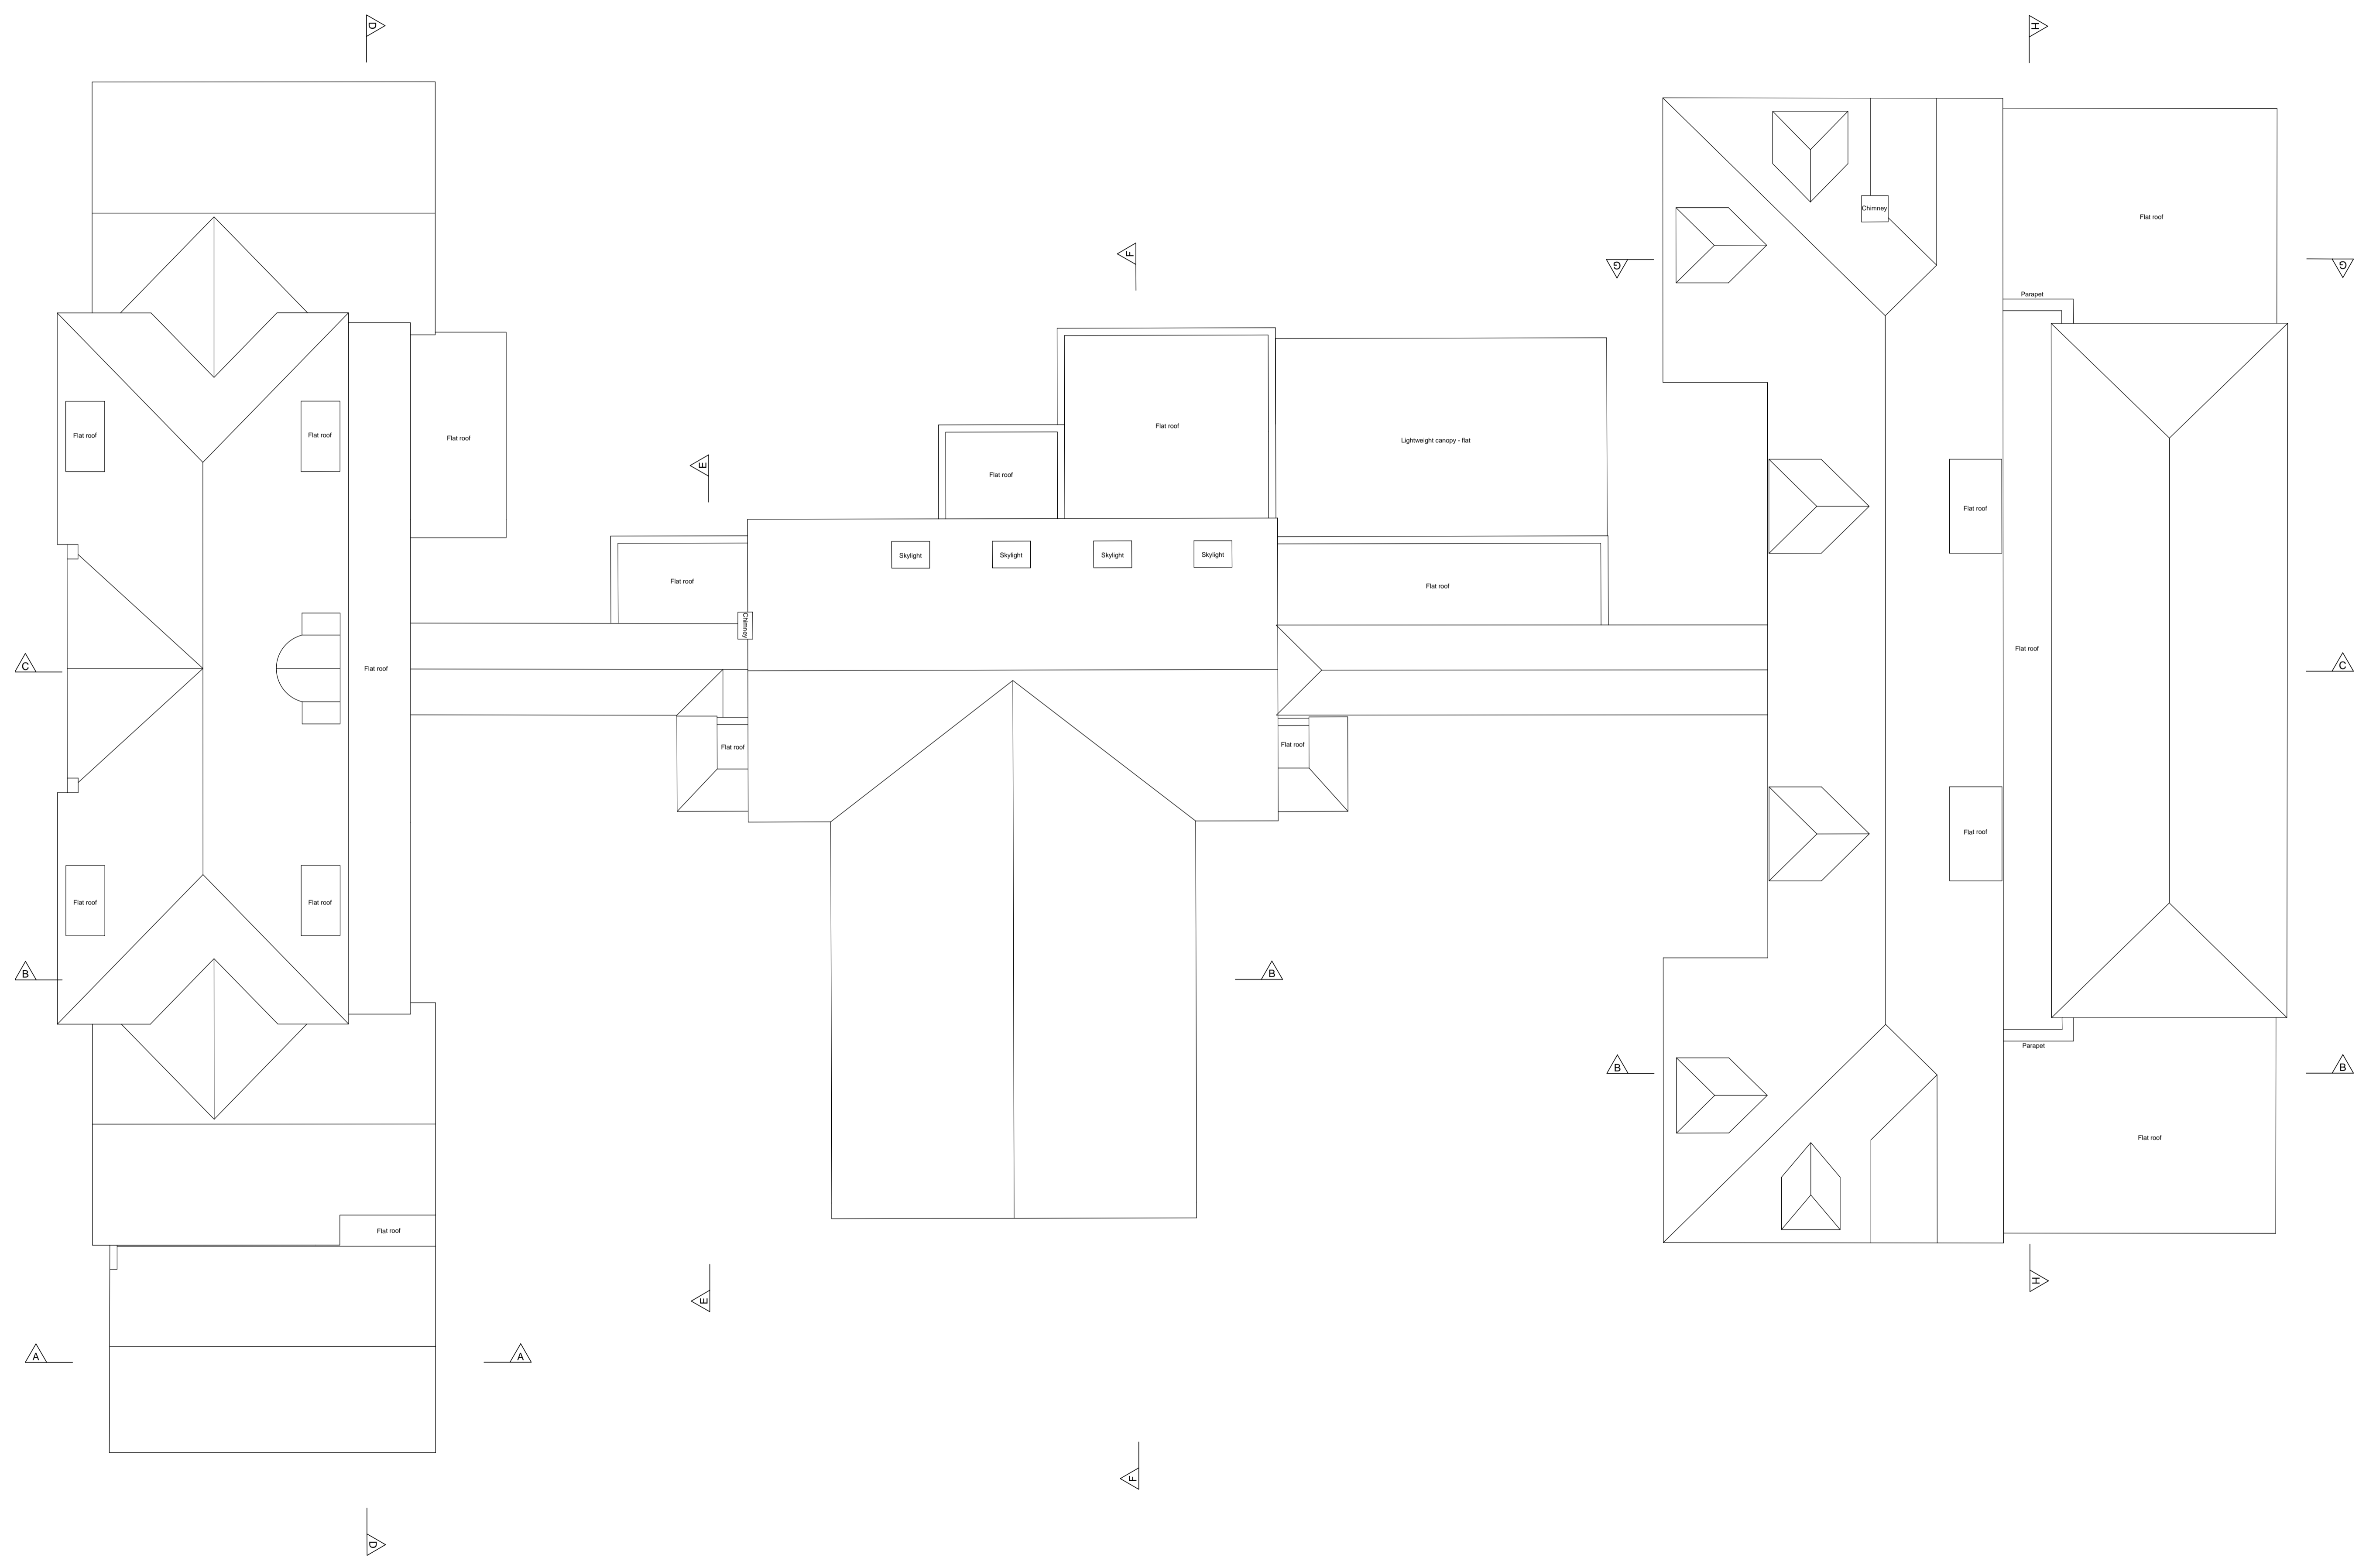


NOTES: Do not scale this drawing. All dimensions to be checked on site prior to commencement or manufacture.

NB: All information based on supplied third party survey information. All discrepancies to be reported to FCG immediately upon discovery.

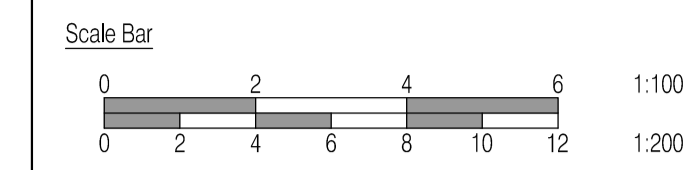

AS BUILT  
DRAWING

Rev	Date	By	Clk	Comment
AB1	17.04.14	RKC	AGC	DRAWING ISSUED - AS BUILT

25 YEARS OF BRINGING IDEAS TO LIFE

**FRANKHAM**

**Frankham Consultancy Group Limited**

Frankham House Wootton Business Park  
Besselsleigh Road Wootton Abingdon  
Oxfordshire OX13 6FD  
T 01865 322500 F 01865 327393  
E enquire@frankham.com  
www.frankham.com

Client

**Leadbitter**  
CONSTRUCTION

Project Title  
Whitehall Junior & Infant School  
Refurbishment, Extension and New Build  
Cowley Road  
London Borough of Hillingdon

Drawing Title  
Junior School  
Existing Roof Plan

Drawn by: RKC	Scale: 1:100@A1	Date: 11.05.12
Designed by: FCG	Checked by: JAS	Approved by: AC

Drawing No.  
**611869-A-105**

Rev.  
**AB1**