


NOTES: Do not scale this drawing. All dimensions to be checked on site prior to commencement or manufacture.

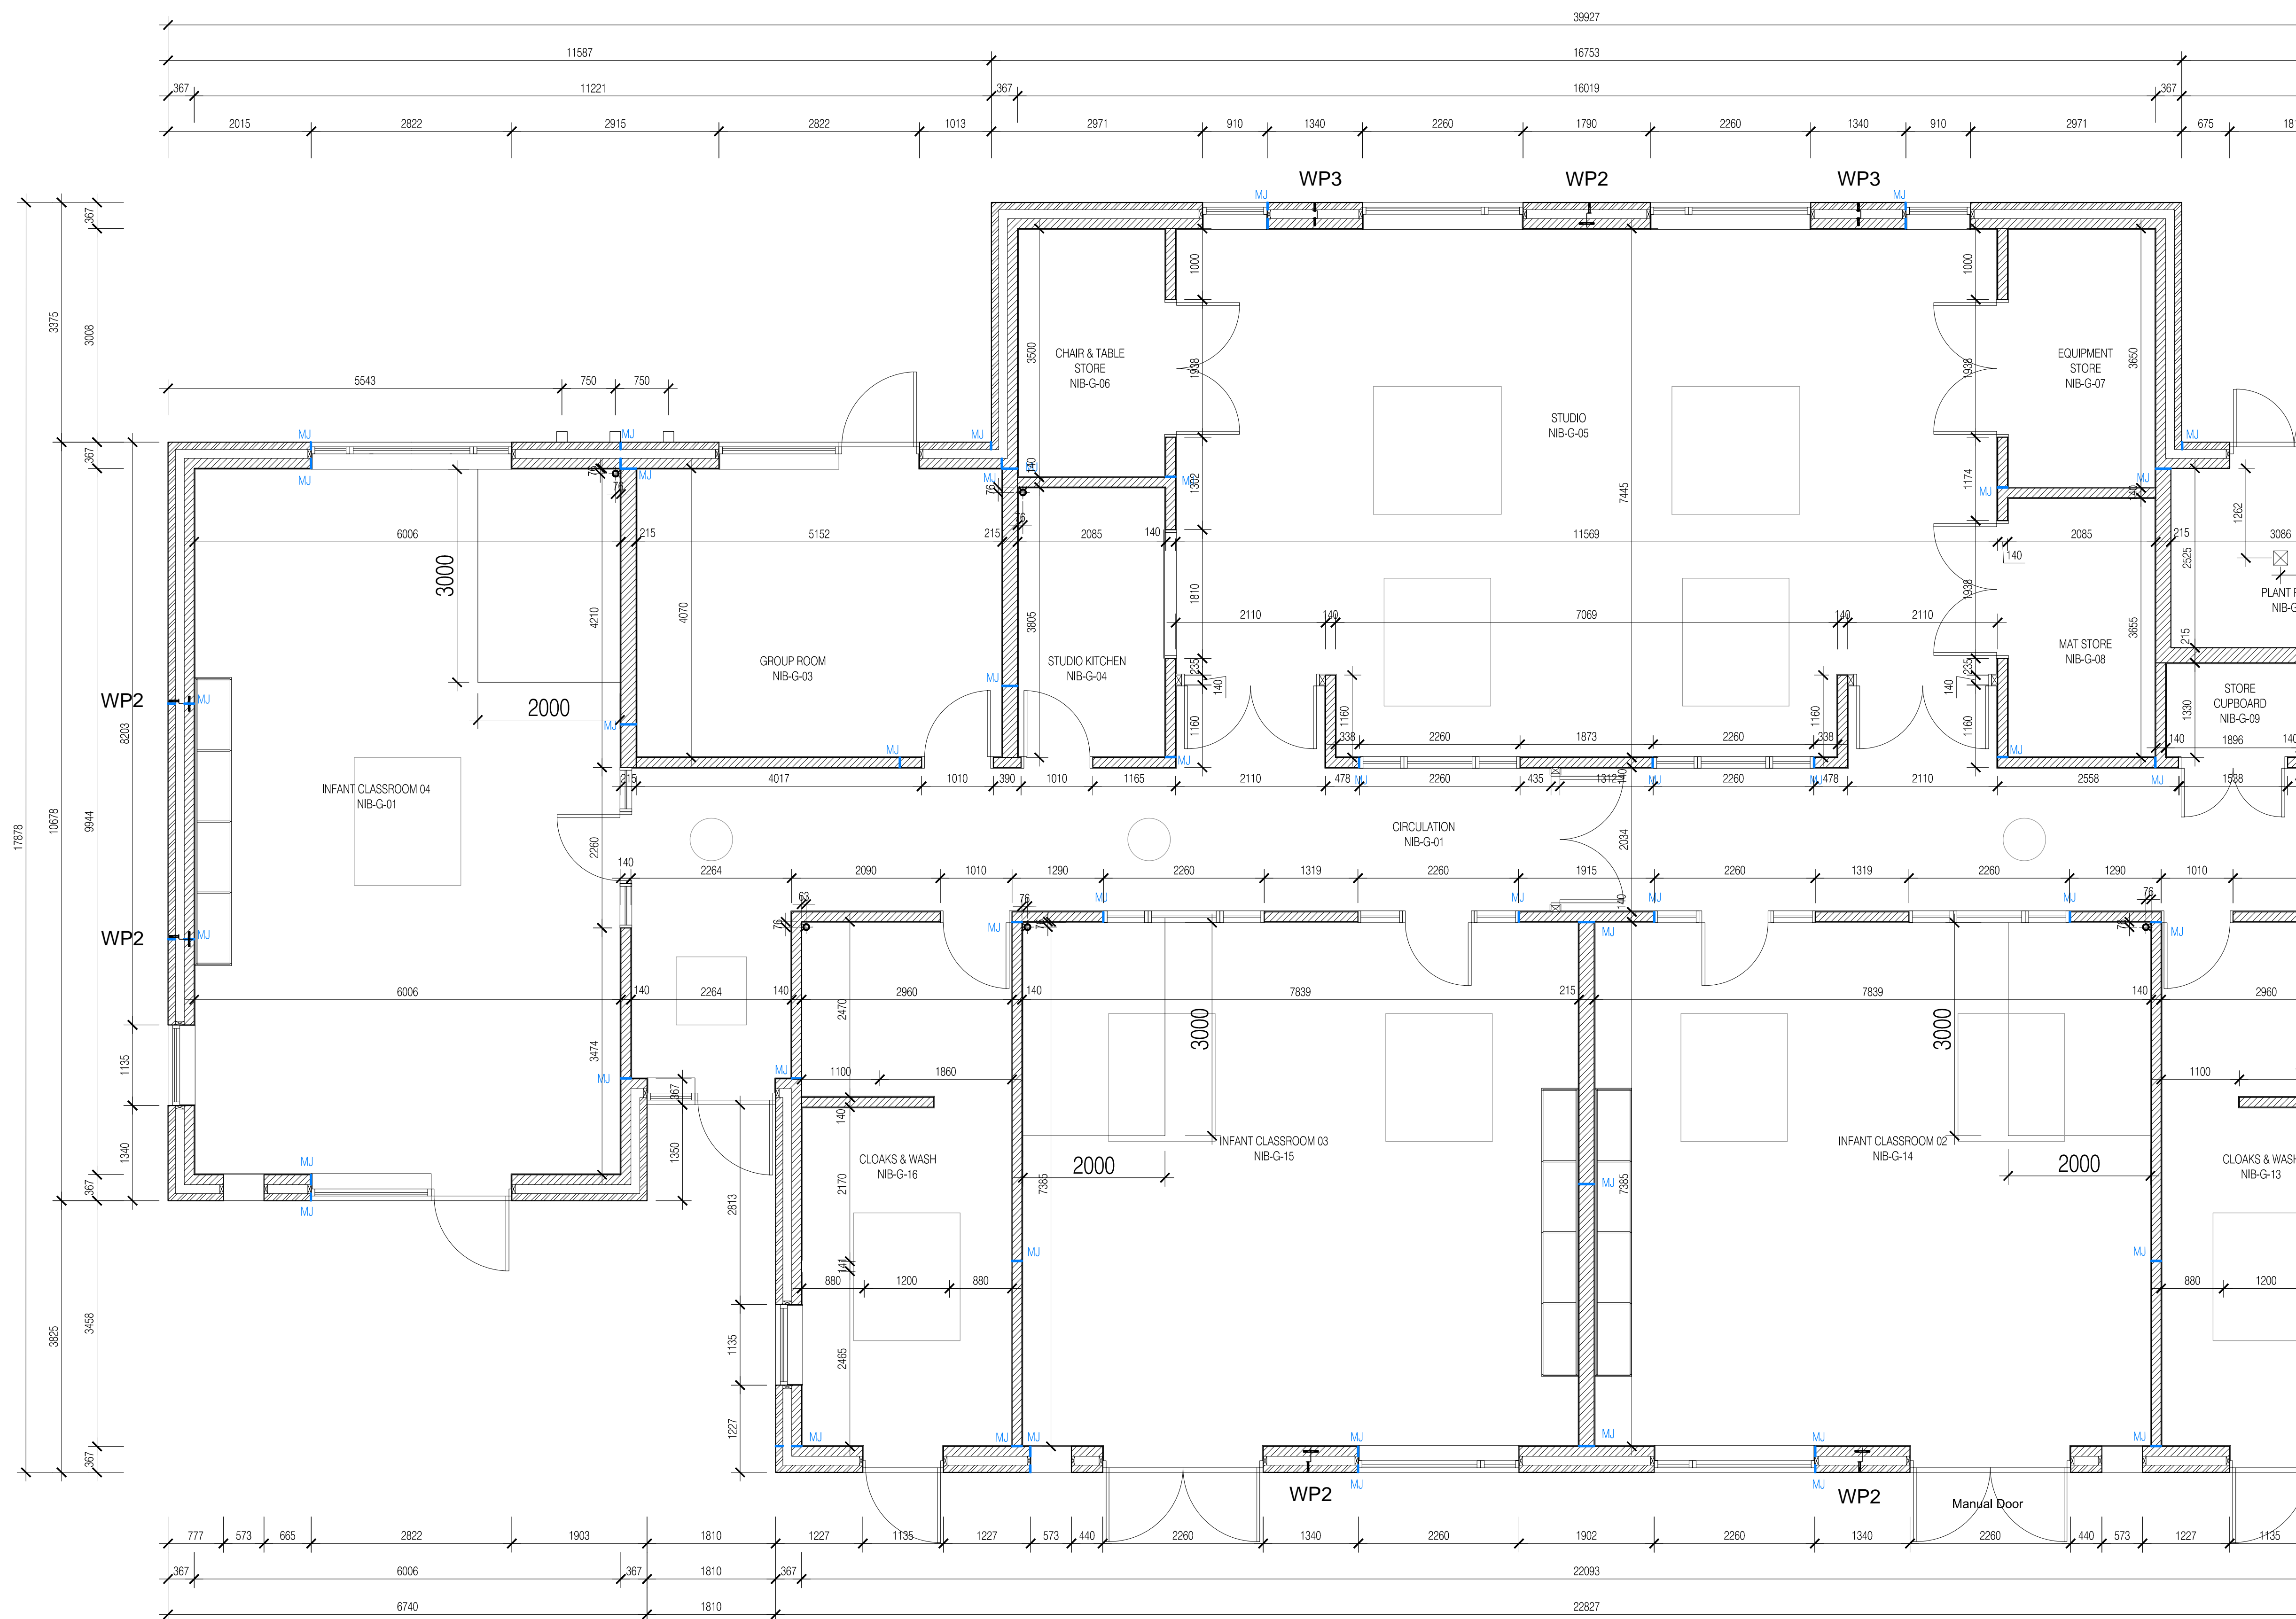

03  
301

AS BUILT  
DRAWING

Rev	Date	By	Clk	Comment
AB1	17.04.14	FRK	AGC	DRAWING ISSUED - AS BUILT

25 YEARS OF BRINGING IDEAS TO LIFE



**FRANKHAM**

Frankham Consultancy Group Limited  
 Frankham House Woolton Business Park  
 Besselsleigh Road Woolton Abingdon  
 Oxfordshire OX13 6FD  
 T 01865 322500 F 01865 327393  
 E enquiry@frankham.com  
 www.frankham.com

Client



Project Title  
 Whitehall Junior & Infant School  
 Refurbishment, Extension and New Build  
 Cowley Road  
 London Borough of Hillingdon

Drawing Title  
 New 4 Classroom Infants Block  
 Setting Out Plan  
 Sheet 1 of 2

Drawn by: RKC	Scale: 1:50@A1	Date: 26.06.12
Designed by: 26.06.12	Checked by: JAS	Approved by: AGC

File Ref: J:\000001\001 - HILLINGDON SCHOOLS - WHITEHALL JUNIOR & INFANT SCHOOL - NEW 4 CLASSROOM INFANTS BLOCK - SETTING OUT PLAN AND G.A. 14.04.24.10.32.50

Drawing No. 611869-A-131	Rev. AB1
-----------------------------	-------------