


NOTES: Do not scale this drawing. All dimensions to be checked on site prior to commencement or manufacture.

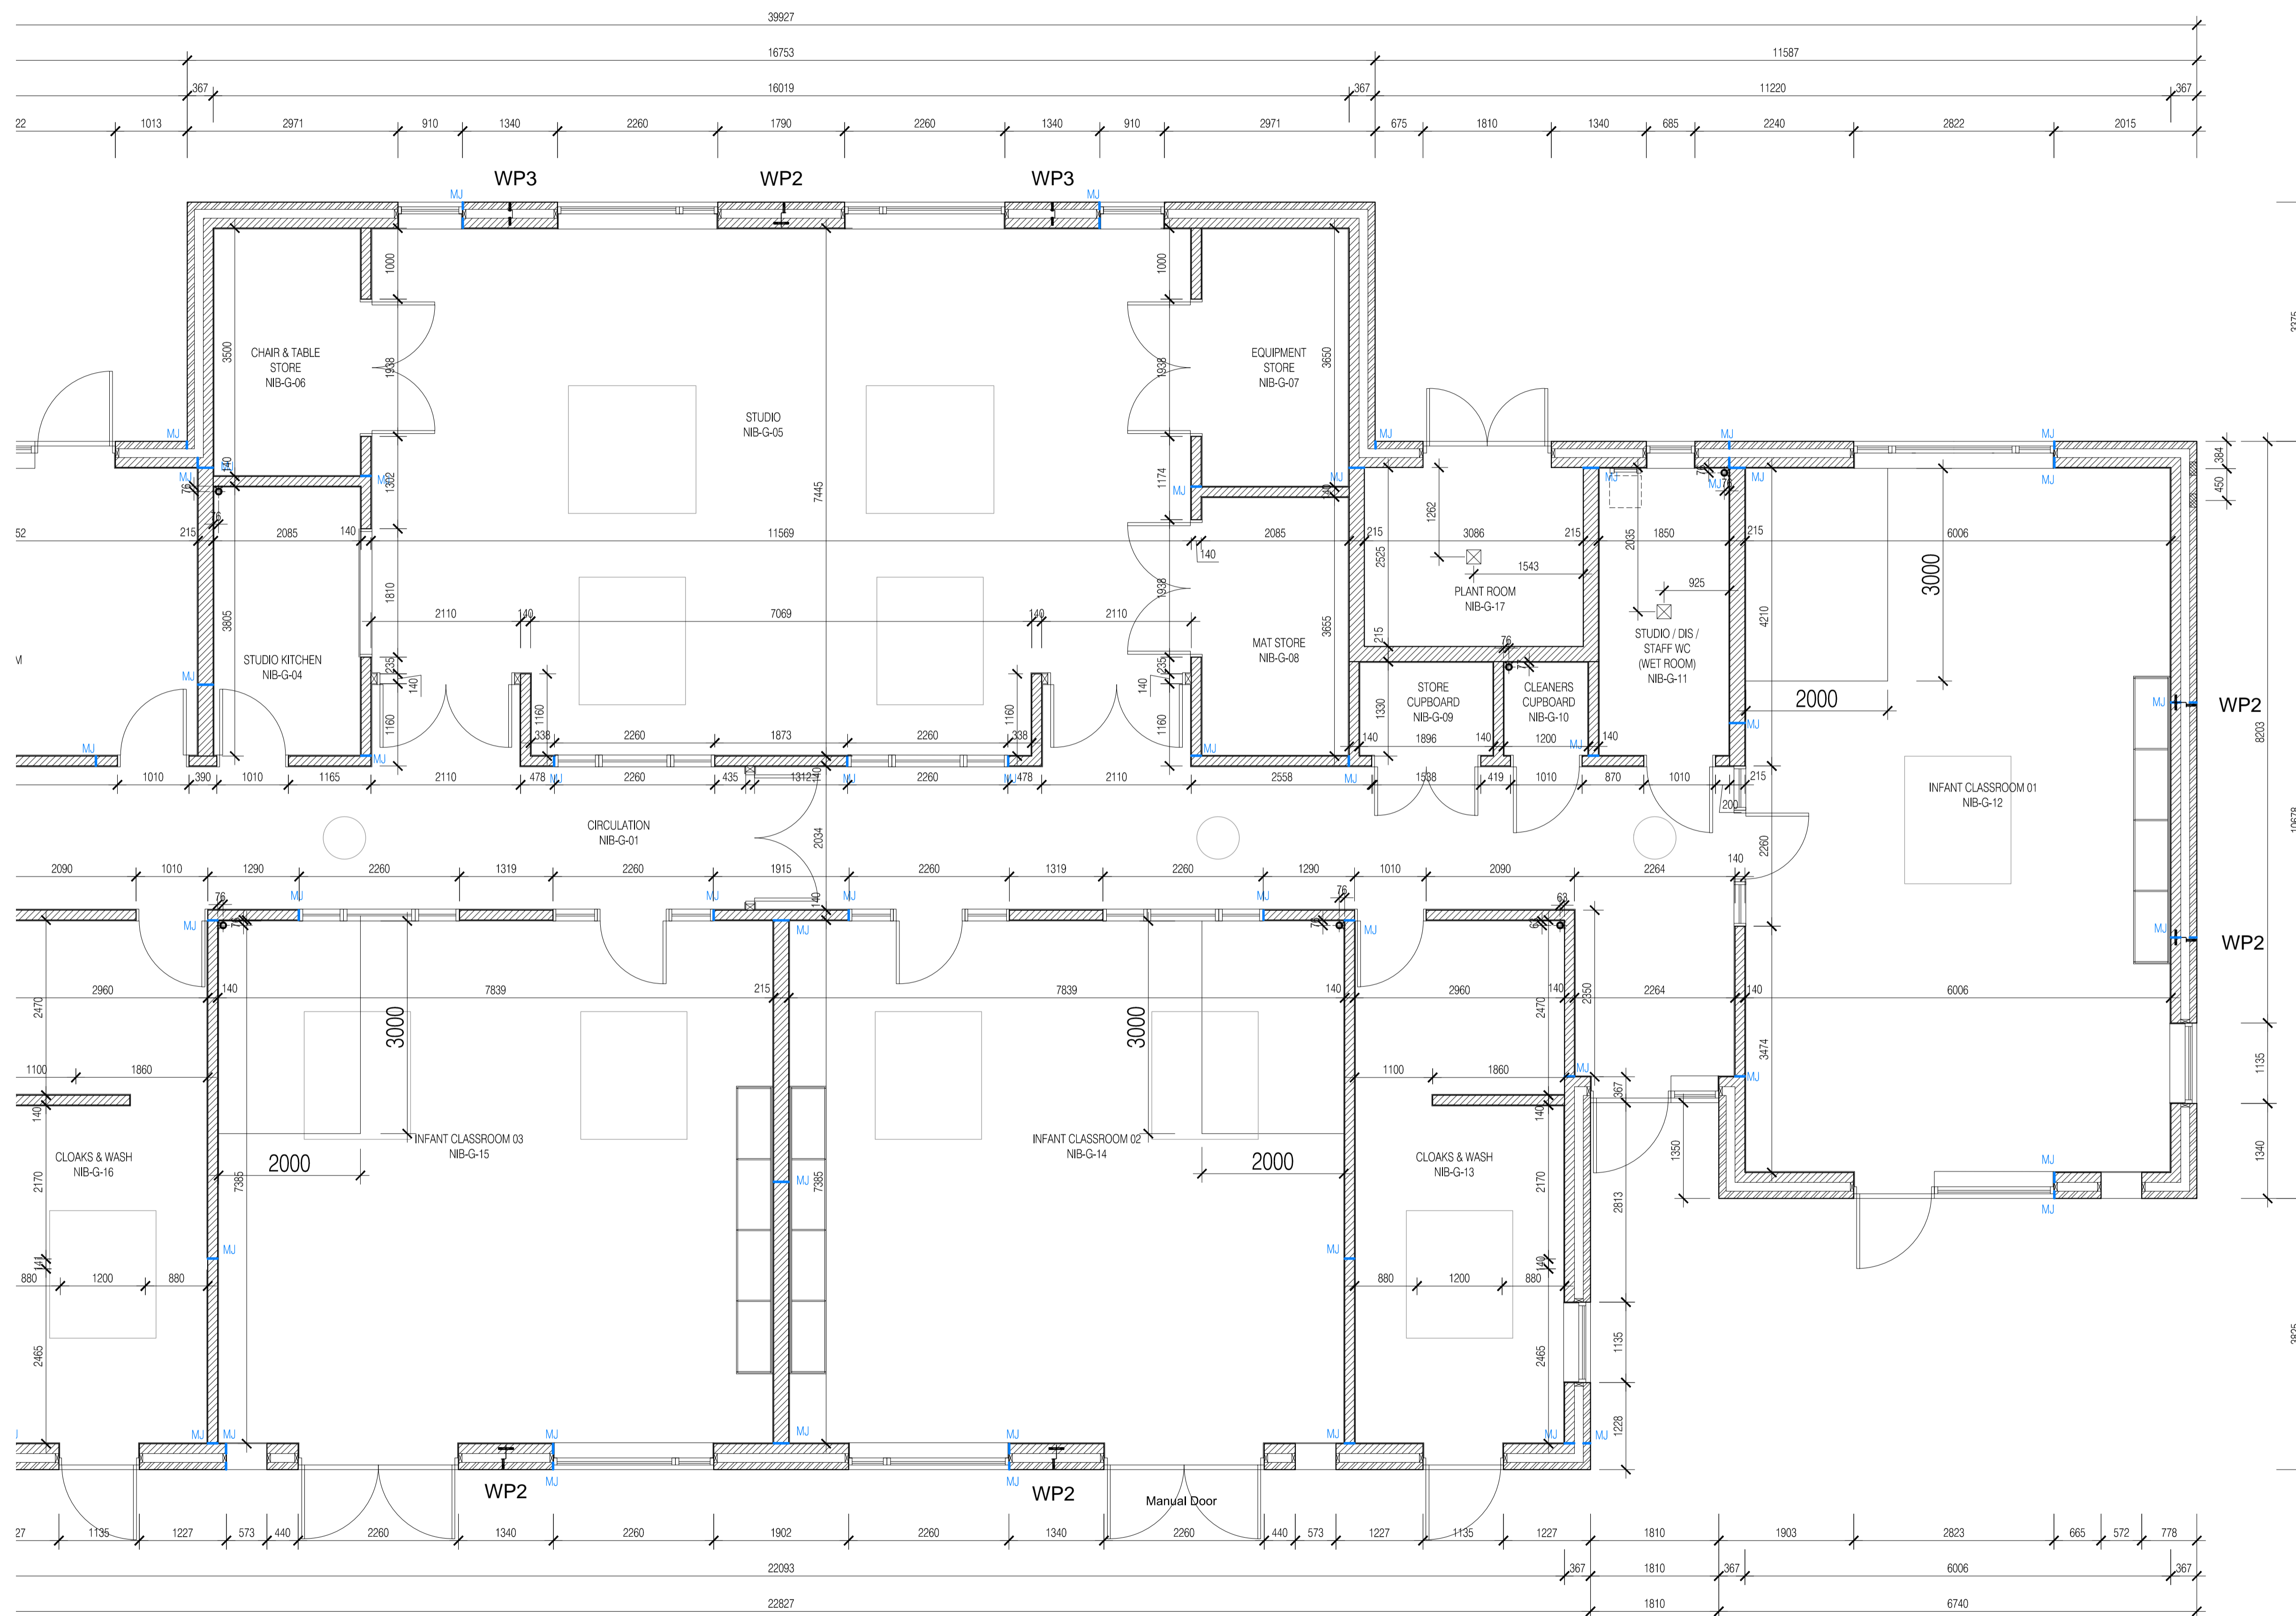

AS BUILT
DRAWING

Rev	Date	By	Clk	Comment
AB1	17.04.14	FRK	AGC	DRAWING ISSUED - AS BUILT



FRANKHAM

Frankham Consultancy Group Limited
 Frankham House Woolton Business Park
 Besselsleigh Road Woolton Abingdon
 Oxfordshire OX13 6FD
 T 01865 322500 F 01865 327393
 E enquire@frankham.com
 www.frankham.com



Client
Leadbitter
 CONSTRUCTION

Project Title
 Whitehall Junior & Infant School
 Refurbishment, Extension and New Build
 Cowley Road
 London Borough of Hillingdon

Drawing Title
 New 4 Classroom Infants Block
 Setting Out Plan
 Sheet 2 of 2

Drawn by: RKC	Scale: 1:50@A1	Date: 26.06.12
Designed by: 26.06.12	Checked by: JAS	Approved by: AGC

Drawing No. 611869-A-132	Rev. AB1
-----------------------------	-------------