


NOTES: Do not scale this drawing. All dimensions to be checked on site prior to commencement or manufacture.

NB: All information based on supplied third party survey information. All discrepancies to be reported to FCG immediately upon discovery.

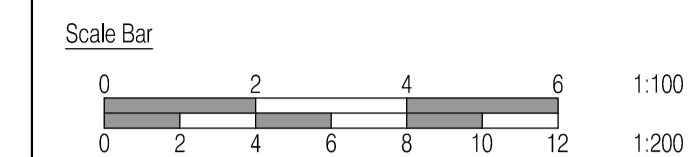

Floor Finishes Legend - Infants School
All colours to be confirmed. Similar hatch in adjacent rooms does not necessarily represent or signify same colour. All changes in floor finish type, floor finish colour, carpet colour, etc.

- EXISTING FLOOR TO BE RETAINED.
- M50 HEAVY CONTRACT BROADLOOM CLEAN OFF CARPET TO ENTRANCE AREAS / EXTERNAL DOORS. MANUFACTURE & REFERENCE - HECKMONDWIKE BATTLESHIP. COLOUR: ANTHRACITE.
- M50 CARPETING TO CLASSROOMS AND GROUP ROOM. MANUFACTURE & REFERENCE - HECKMONDWIKE SUPACORD. COLOUR: CLARET.
- M50 VINYL FLOORING TO CIRCULATION AREAS + CLASSROOM SKIR AREAS, AS INDICATED. MANUFACTURE & REFERENCE - POLYFLOR, Standard XL. COLOUR: Graphite.
- M50 CARPETING TO CIRCULATION, MANUFACTURE & REFERENCE - HECKMONDWIKE SUPACORD.
- M50 VINYL FLOORING TO WET HYGIENE AREAS / WC AREAS / KITCHEN / ETC. MANUFACTURE & REFERENCE - POLYSAFE Standard Silver Birch. MAKE ALLOWANCE FOR COVED SKIRTING TO ALL WCs / CLEANER AREAS.
- M50 CONCRETE FLOOR SEALER TO PLANT ROOM. MANUFACTURE & REFERENCE - WATCO LTD. UNIVERSAL SEALER.
- M50 VINYL FLOORING TO STORES. MANUFACTURE & REFERENCE - POLYFLOR STANDARD XL. COLOUR: TBC.
- K11 SPRUNG TIMBER FLOORING TO HALL EXTENSION. MANUFACTURE & REFERENCE - GRANFLOOR SPRUNG SYSTEM IN NATURAL WOOD FINISH - SPECIES TO MATCH EXISTING. ALLOW FOR MOVEMENT JOINT TO EXISTING.

FLOOR FINISHES TO BE LAID UNDER ALL BASE UNITS.
JOINT BETWEEN UNITS OR SKIRTING TO BE SEALED WITH WHITE SILICONE SEALANT ON VINYL FLOORS.

JUCTION BETWEEN CARPET AND VINYL FLOOR FINISH TO HAVE ALUMINIUM COVER STRIPS.

AS BUILT
DRAWING

Rev	Date	By	Clk	Comment
AB1	17.04.14	RKC	AGC	DRAWING ISSUED - AS BUILT

25 YEARS OF BRINGING IDEAS TO LIFE



FRANKHAM

Frankham Consultancy Group Limited

Frankham House Wootton Business Park
Besselsleigh Road Wootton Abingdon
Oxfordshire OX13 6FD
T 01865 322500 F 01865 327393
E enquiries@frankham.com
www.frankham.com

Client



Project Title

Whitehall Junior & Infant School
Refurbishment, Extension and New Build
Cowley Road
London Borough of Hillingdon

Drawing Title

Junior School
Proposed First Floor Plan
Floor Finishes Legend

Drawn by: RKC	Scale: 1:100@A1	Date: 28.05.12
Designed by: FCG	Checked by: JAS	Approved by: AC

File Ref: J:\00000188-HELDON SCHOOL-NEW HALL REDEVELOPMENT-NEW LOCATION PLAN AND GARDENS-161800-161800-REV 1431-00010310 14.04.24.10.34.11

Drawing No. 611869-A-143	Rev. AB1
------------------------------------	--------------------