


NOTES: Do not scale this drawing. All dimensions to be checked on site prior to commencement or manufacture.

NB: All information based on supplied third party survey information. All discrepancies to be reported to FCG immediately upon discovery.

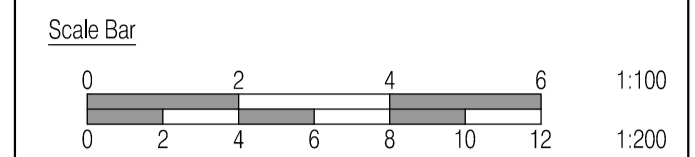

Reflected Ceiling Plan Legend - Junior School  
All colours to be confirmed.

- Plasterboard bulkhead with downlights
- Suspended Ceiling 600x600 Grid - Armstrong Bioguard (light green), Sierra (dark green)
- Kitchen Cold Room Ceiling
- Plasterboard Ceiling
- Fire rated & insulated external semi exposed undercroft Ceiling
- Existing Ceiling
- Extent of Shadow Gap to Rooms
- Extent of Line of Bulkhead to Voids & Rooflights
- Centre Line of Room for Ceiling Tile Setting Out
- Proposed ceiling level

AS BUILT DRAWING

Rev	Date	By	Clk	Comment
AB1	17.04.14	FRK	AGC	DRAWING ISSUED - AS BUILT

25 YEARS OF BRINGING IDEAS TO LIFE

ANNIVERSARY 25 YEARS 1982-2007

**FRANKHAM**

Frankham Consultancy Group Limited  
Frankham House Wootton Business Park  
Besselsleigh Road Wootton Abingdon  
Oxfordshire OX13 6FD  
T 01865 322500 F 01865 327393  
E enquire@frankham.com  
www.frankham.com

Client: **Leadbitter**  
CONSTRUCTION

Project Title  
Whitehall Junior & Infant School  
Refurbishment, Extension and New Build  
Cowley Road  
London Borough of Hillingdon

Drawing Title  
Junior School  
Proposed First Floor  
Reflected Ceiling Plan

Drawn by: FRK	Scale: 1:100@A1	Date: 28.05.12
Designed by: JCS	Checked by: JAS	Approved by: AC

File Ref: J:\000001188-HELINGDON SCHOOLS- WHITEHALL JUNIOR & INFANT SCHOOL- RE-LOCATION PLANS AND CAD...  
14.04.24.10.38.19

Drawing No. 611869-A-153	Rev. AB1
-----------------------------	-------------

