


NOTES: Do not scale this drawing. All dimensions to be checked on site prior to commencement or manufacture.

NB: All information based on supplied third party survey information. All discrepancies to be reported to FCG immediately upon discovery.

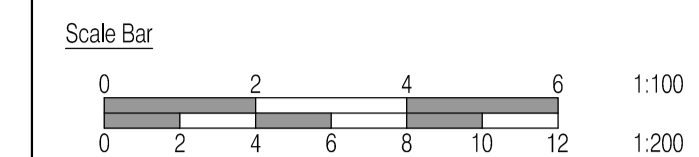

ACOUSTIC STRATEGY KEY

- Acoustic Level up to Rw 45 dB
- Acoustic Level up to Rw 40 dB
- Acoustic Level up to Rw 30 dB
- Acoustic Level up to Rw 35 dB

**AS BUILT
DRAWING**

17/04/14 RKC AGC DRAWING ISSUED - AS BUILT

25 YEARS OF BRINGING IDEAS TO LIFE
ANNIVERSARY
1982-2007



FRANKHAM

Frankham Consultancy Group Limited
Frankham House Wootton Business Park
Besselsleigh Road Wootton Abingdon
Oxfordshire OX13 6FD
T 01865 322500 F 01865 327393
E enquiry@frankham.com
www.frankham.com

Client
Leadbitter
CONSTRUCTION

Project Title
Whitehall Junior & Infant School
Refurbishment, Extension and New Build
Cowley Road
London Borough of Hillingdon

Drawing Title
Junior School
Acoustic Strategy
Proposed Ground Floor Plan

Drawn by: RKC Scale: 1:100@A1 Date: 15.09.12

Designed by: FCG Checked by: JAS Approved by: AC

File Path: J:\000061881-BLANK2009-00-COLE-01-RE-ALL-REDESIGN\AC101_01_LOCATION PLANS AND GAUGES... Rev 4/14/12/09

Drawing No. 611869-A-162 Rev. AB1