
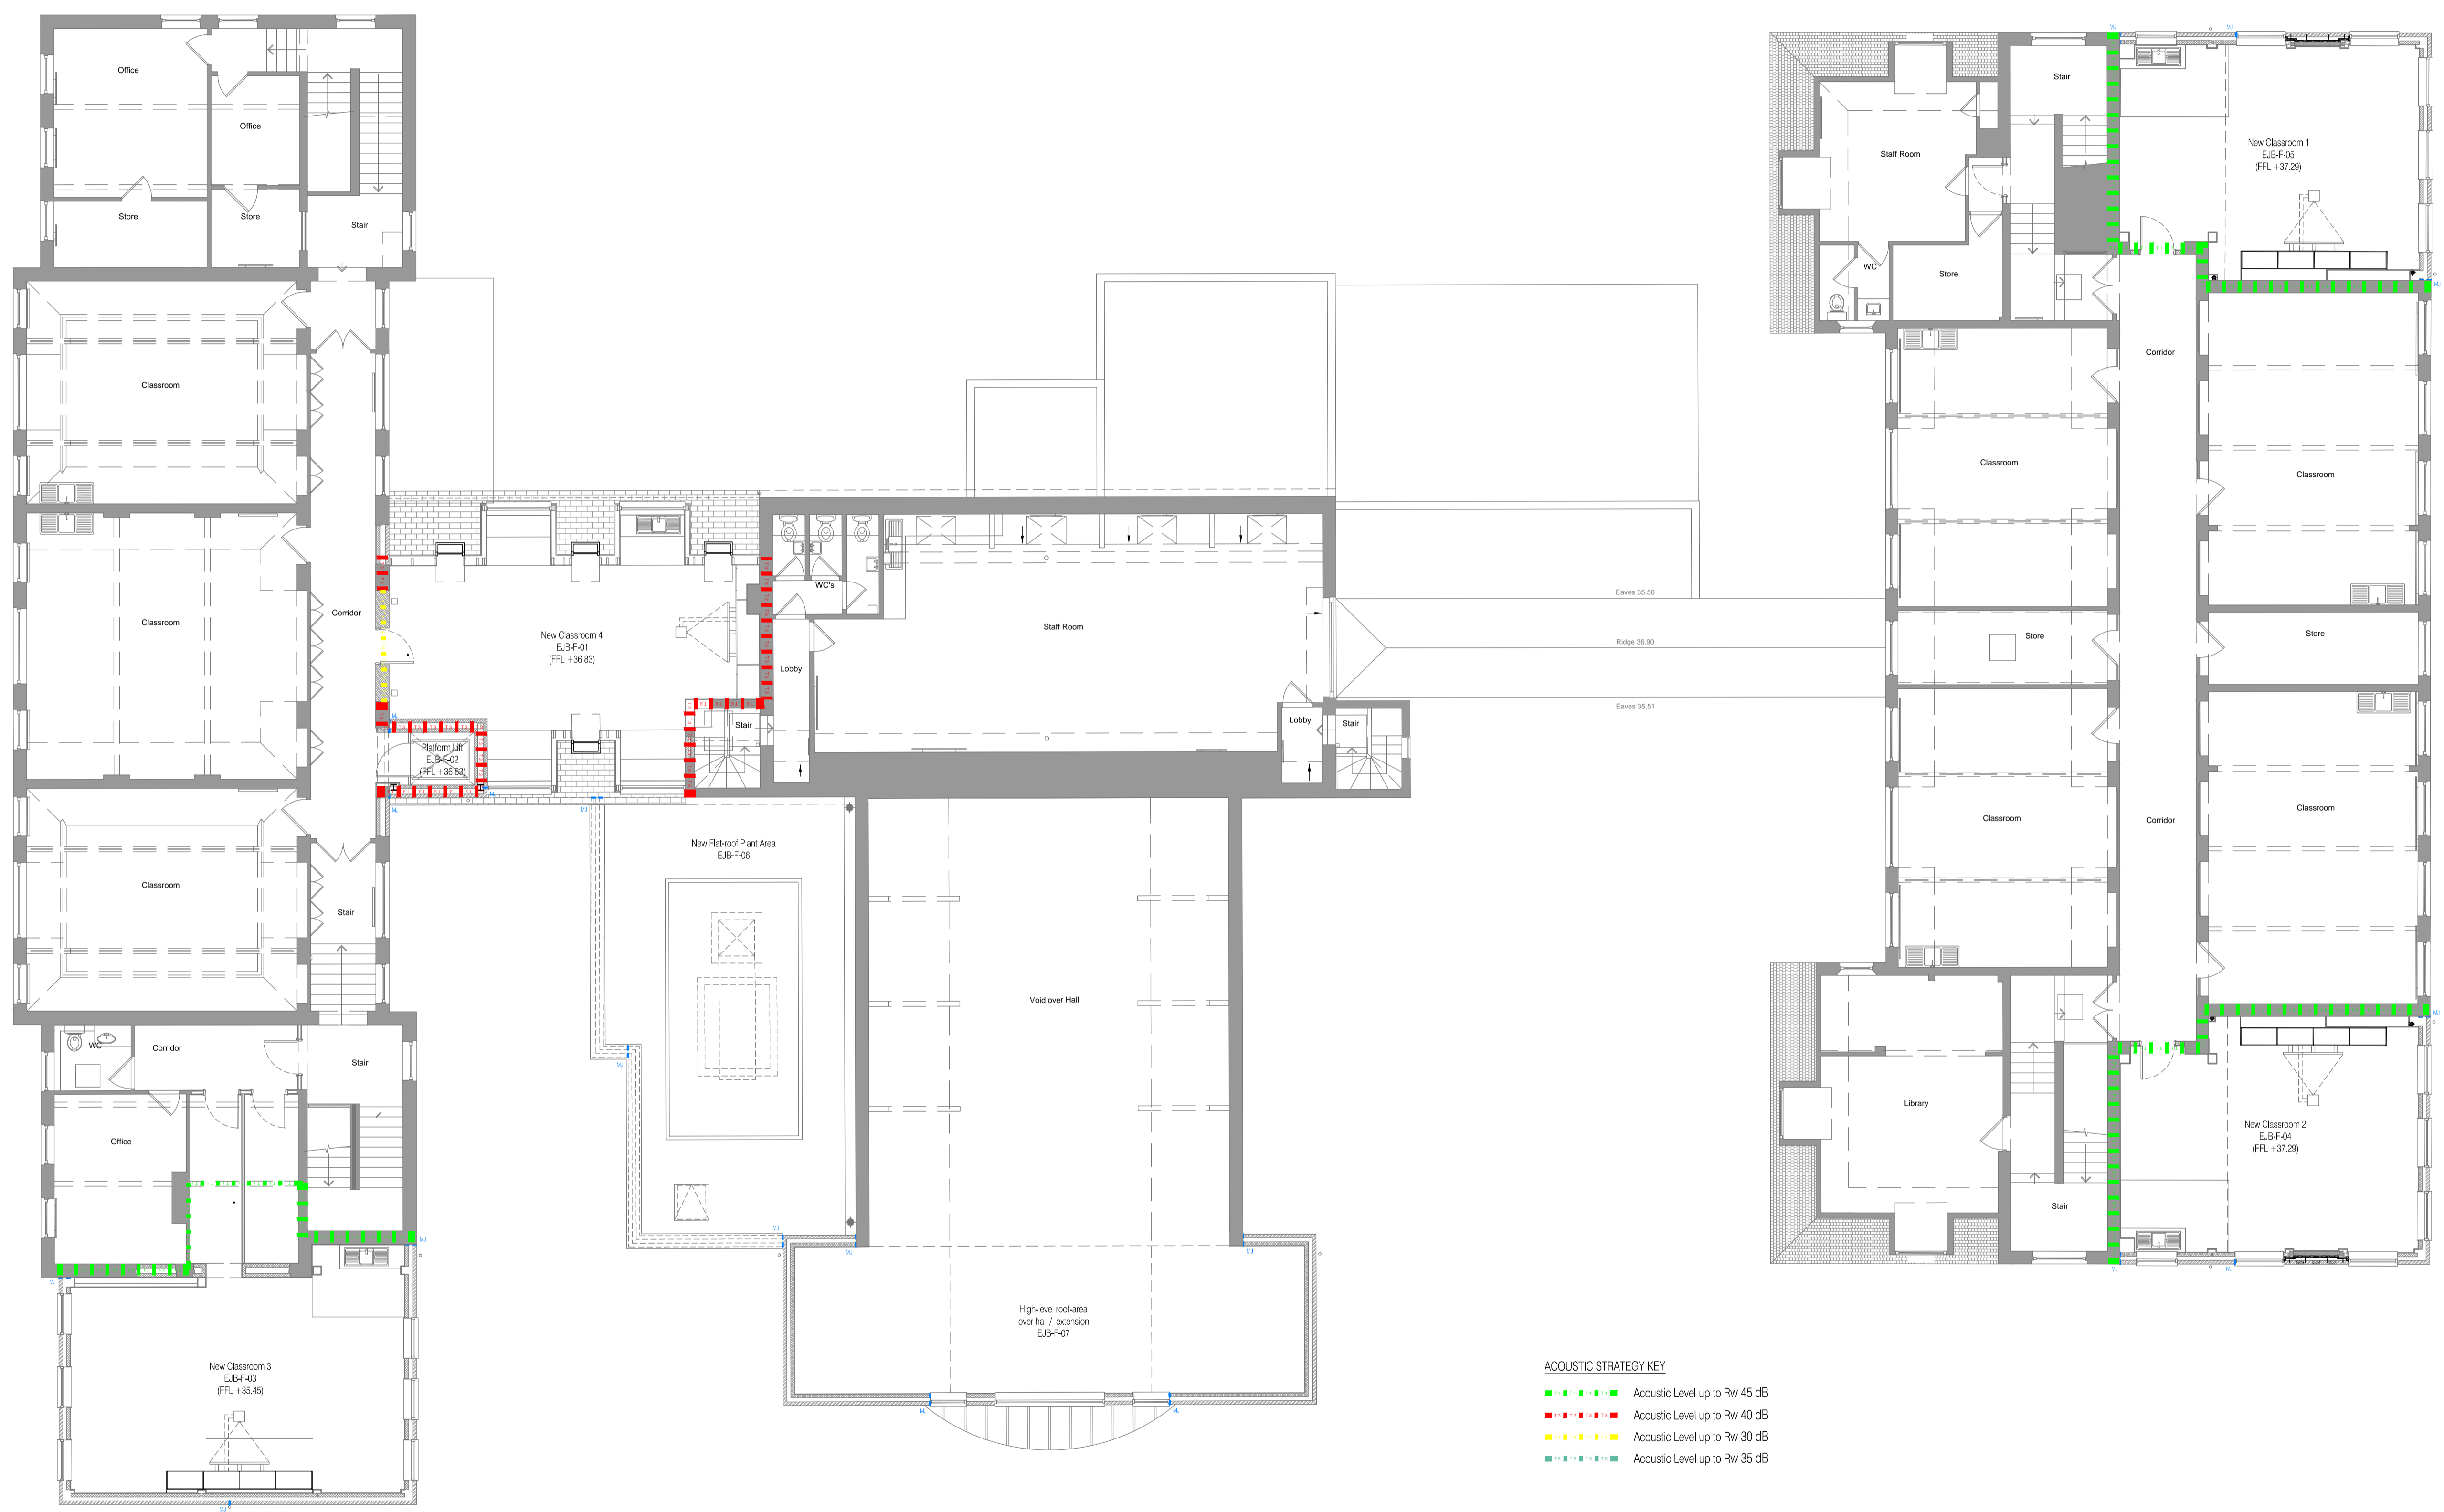


NOTES: Do not scale this drawing. All dimensions to be checked on site prior to commencement or manufacture.

NB: All information based on supplied third party survey information. All discrepancies to be reported to FCG immediately upon discovery.

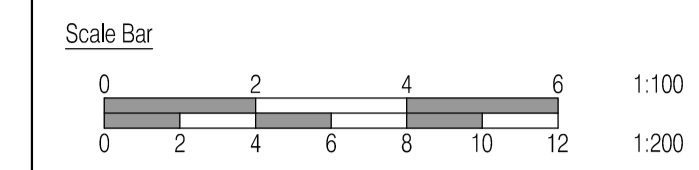

- ACOUSTIC STRATEGY KEY**
- ■ ■ ■ ■ Acoustic Level up to Rw 45 dB
 - ■ ■ ■ ■ Acoustic Level up to Rw 40 dB
 - ■ ■ ■ ■ Acoustic Level up to Rw 30 dB
 - ■ ■ ■ ■ Acoustic Level up to Rw 35 dB

AS BUILT
DRAWING

Rev	Date	By	Clk	Comment
AB1	17.04.14	RKC	AGC	DRAWING ISSUED - AS BUILT

25 YEARS OF BRINGING IDEAS TO LIFE

25
YEARS
1982-2007

FRANKHAM

Frankham Consultancy Group Limited

Frankham House Wootton Business Park
Besselsleigh Road Wootton Abingdon
Oxfordshire OX13 6FD
T 01865 322500 F 01865 327393
E enquire@frankham.com
www.frankham.com

Client

Leadbitter

CONSTRUCTION

Project Title

Whitehall Junior & Infant School
Refurbishment, Extension and New Build
Cowley Road
London Borough of Hillingdon

Drawing Title

Junior School
Acoustic Strategy Plan
Proposed First Floor Plan

Drawn by: RKC	Scale: 1:100@A1	Date: 15.09.12
Designed by: FCG	Checked by: JAS	Approved by: AC

File Ref: J:\000001\0001\HILLINGDON\0001\WHITEHALL JUNIOR & INFANT SCHOOL\10_LOCATION PLANS AND GAUGES\10_01\1000A-163.dwg - REV 14/09/12

Drawing No. 611869-A-163	Rev. AB1
------------------------------------	--------------------