
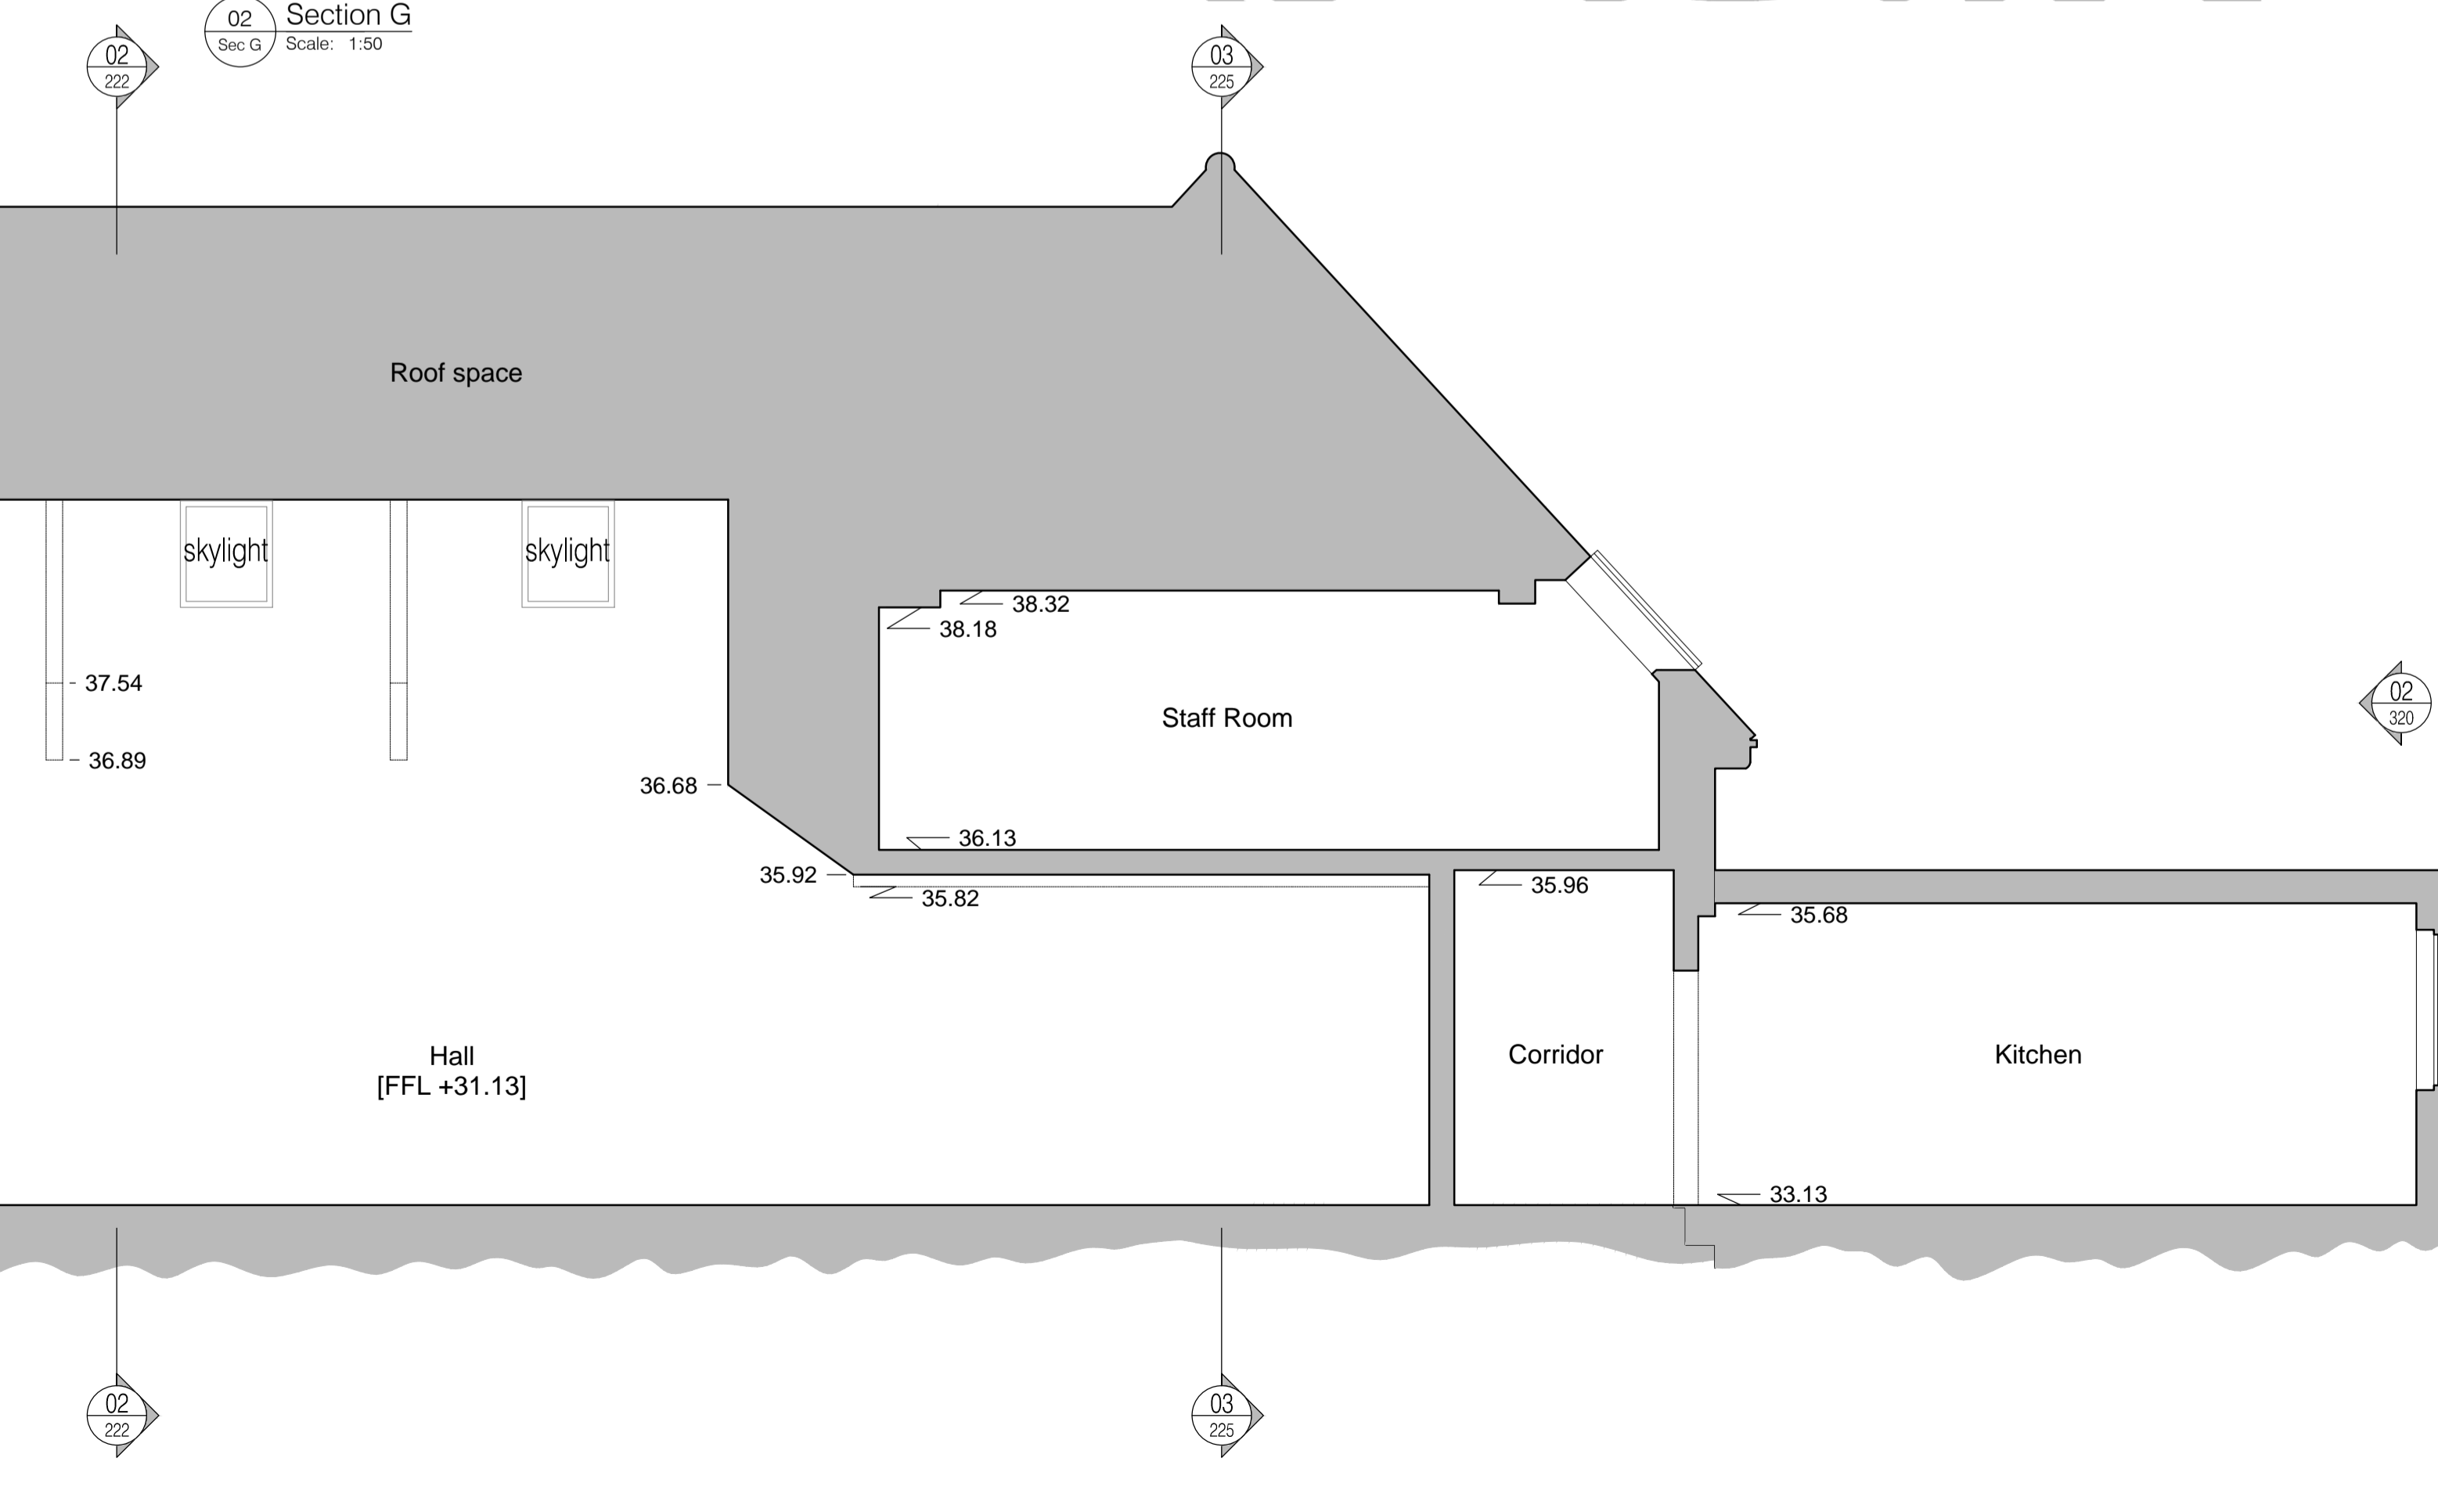
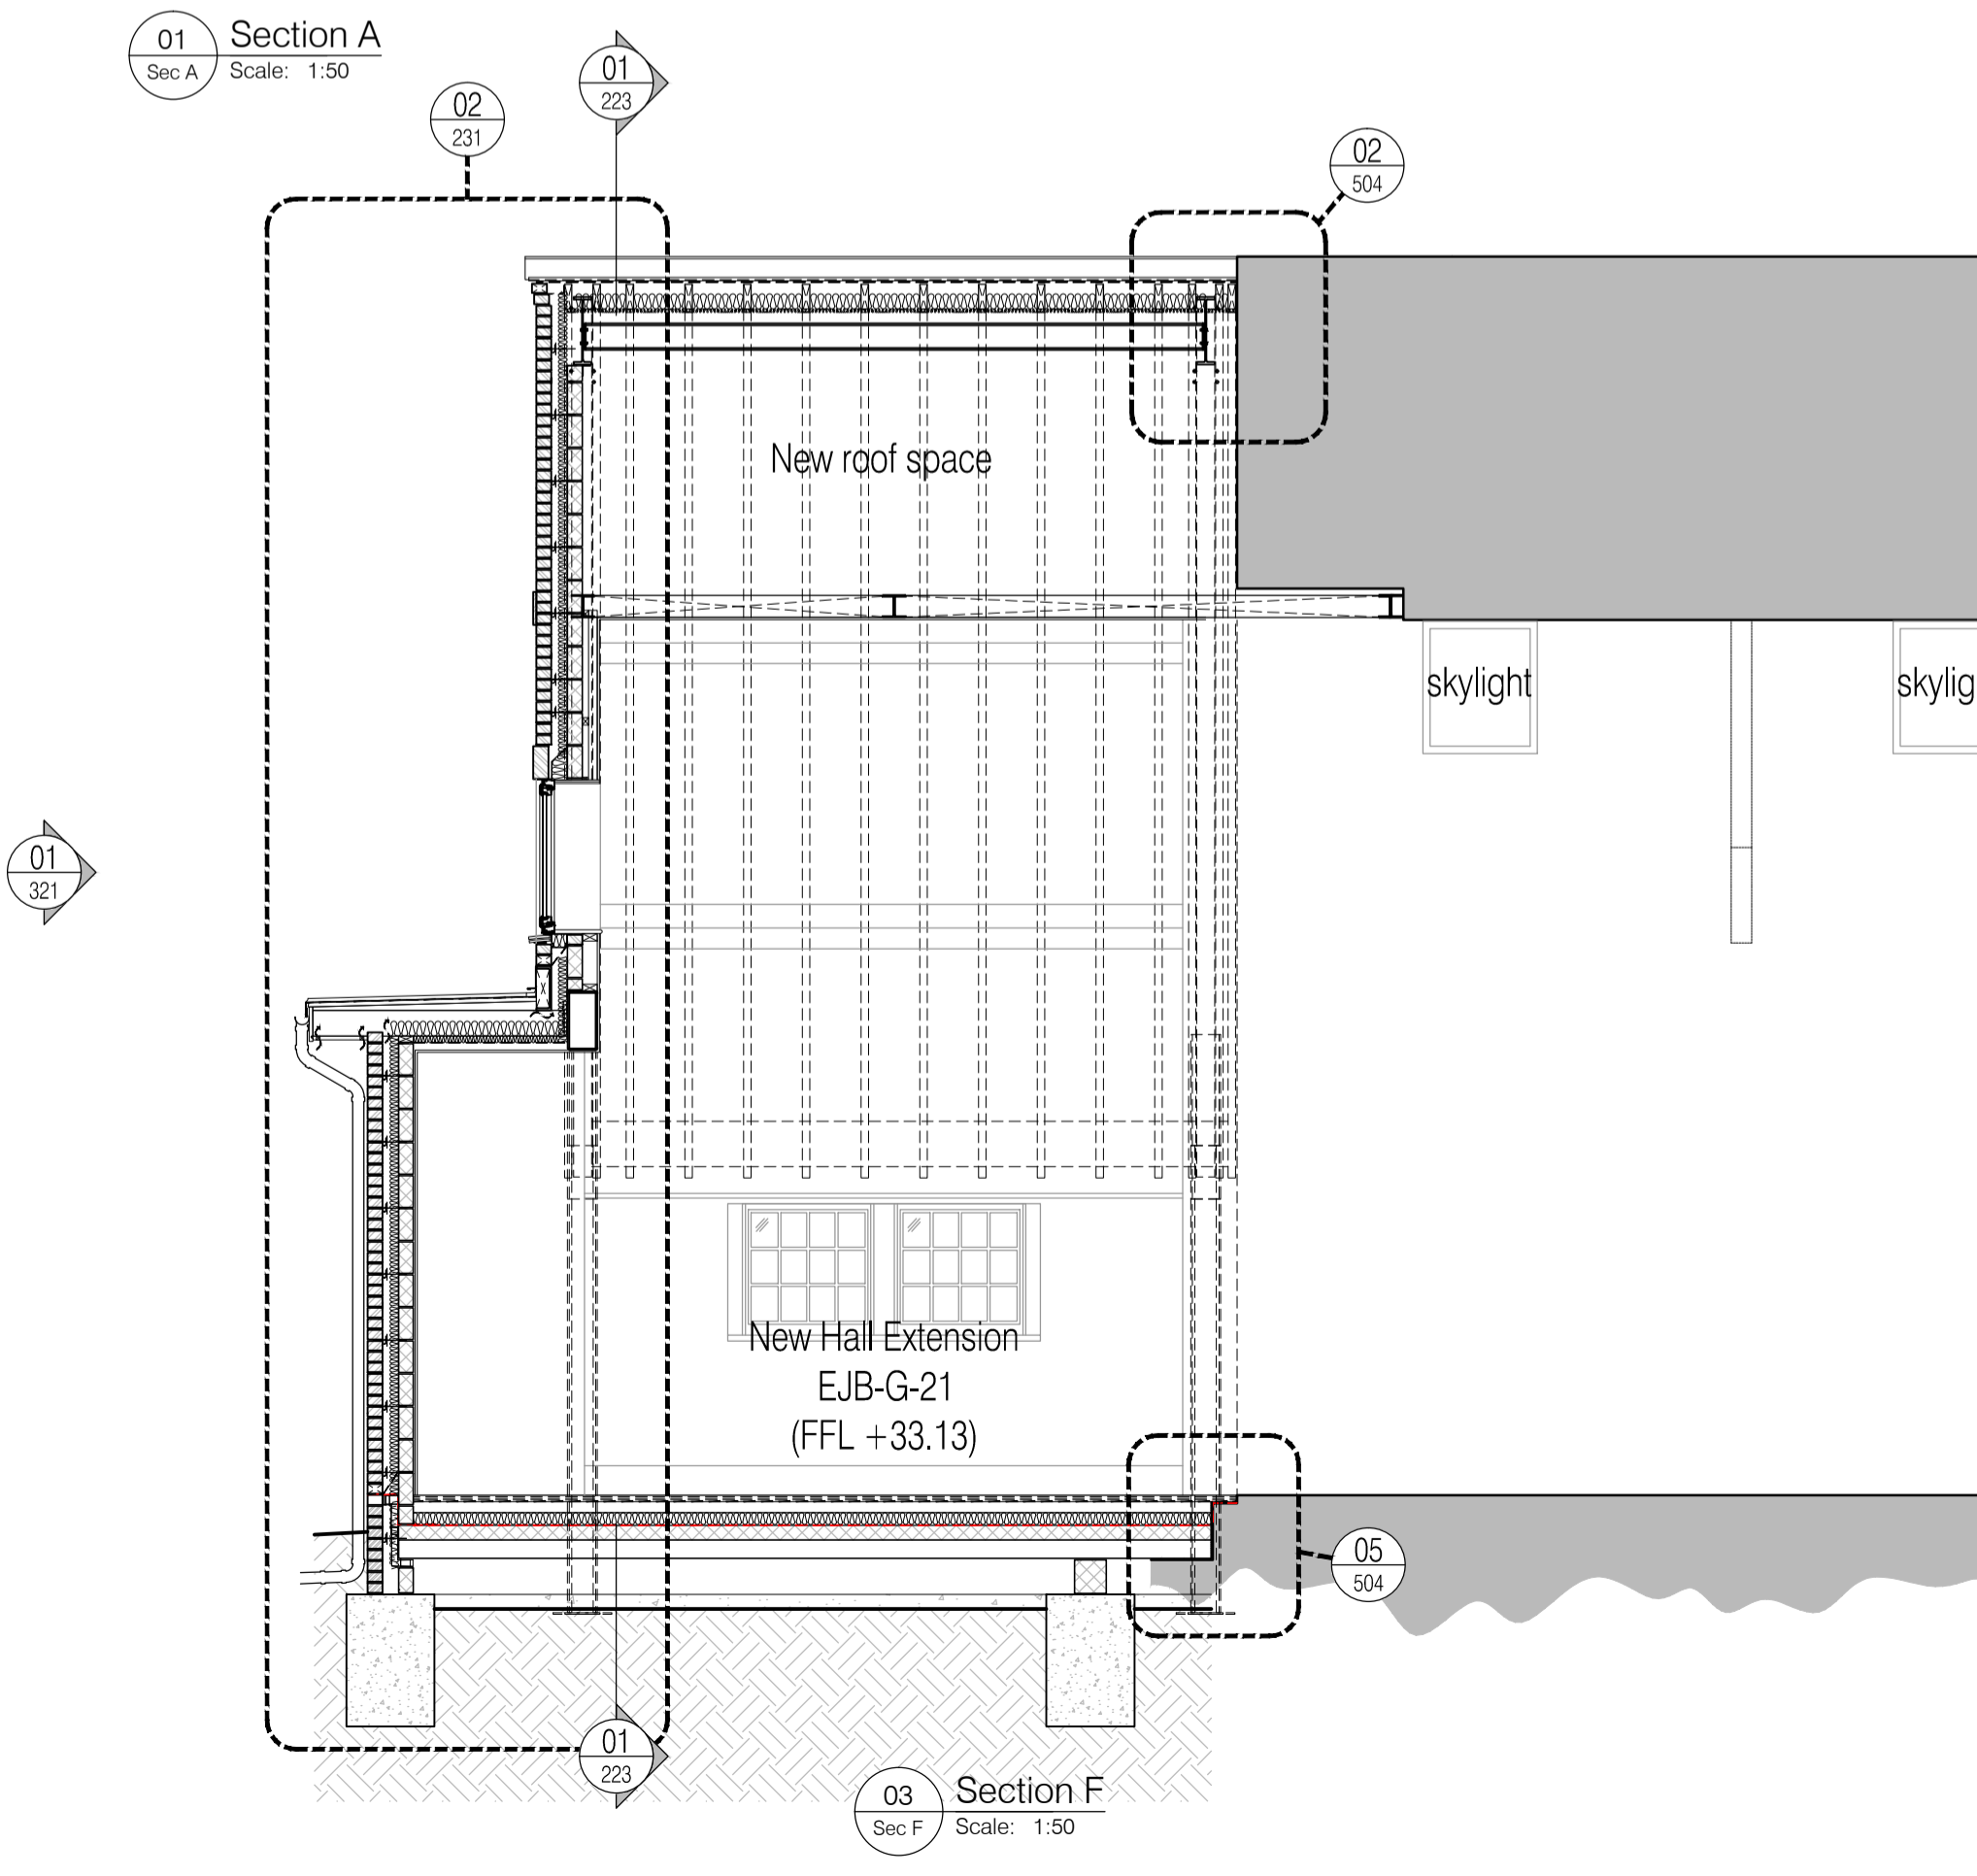
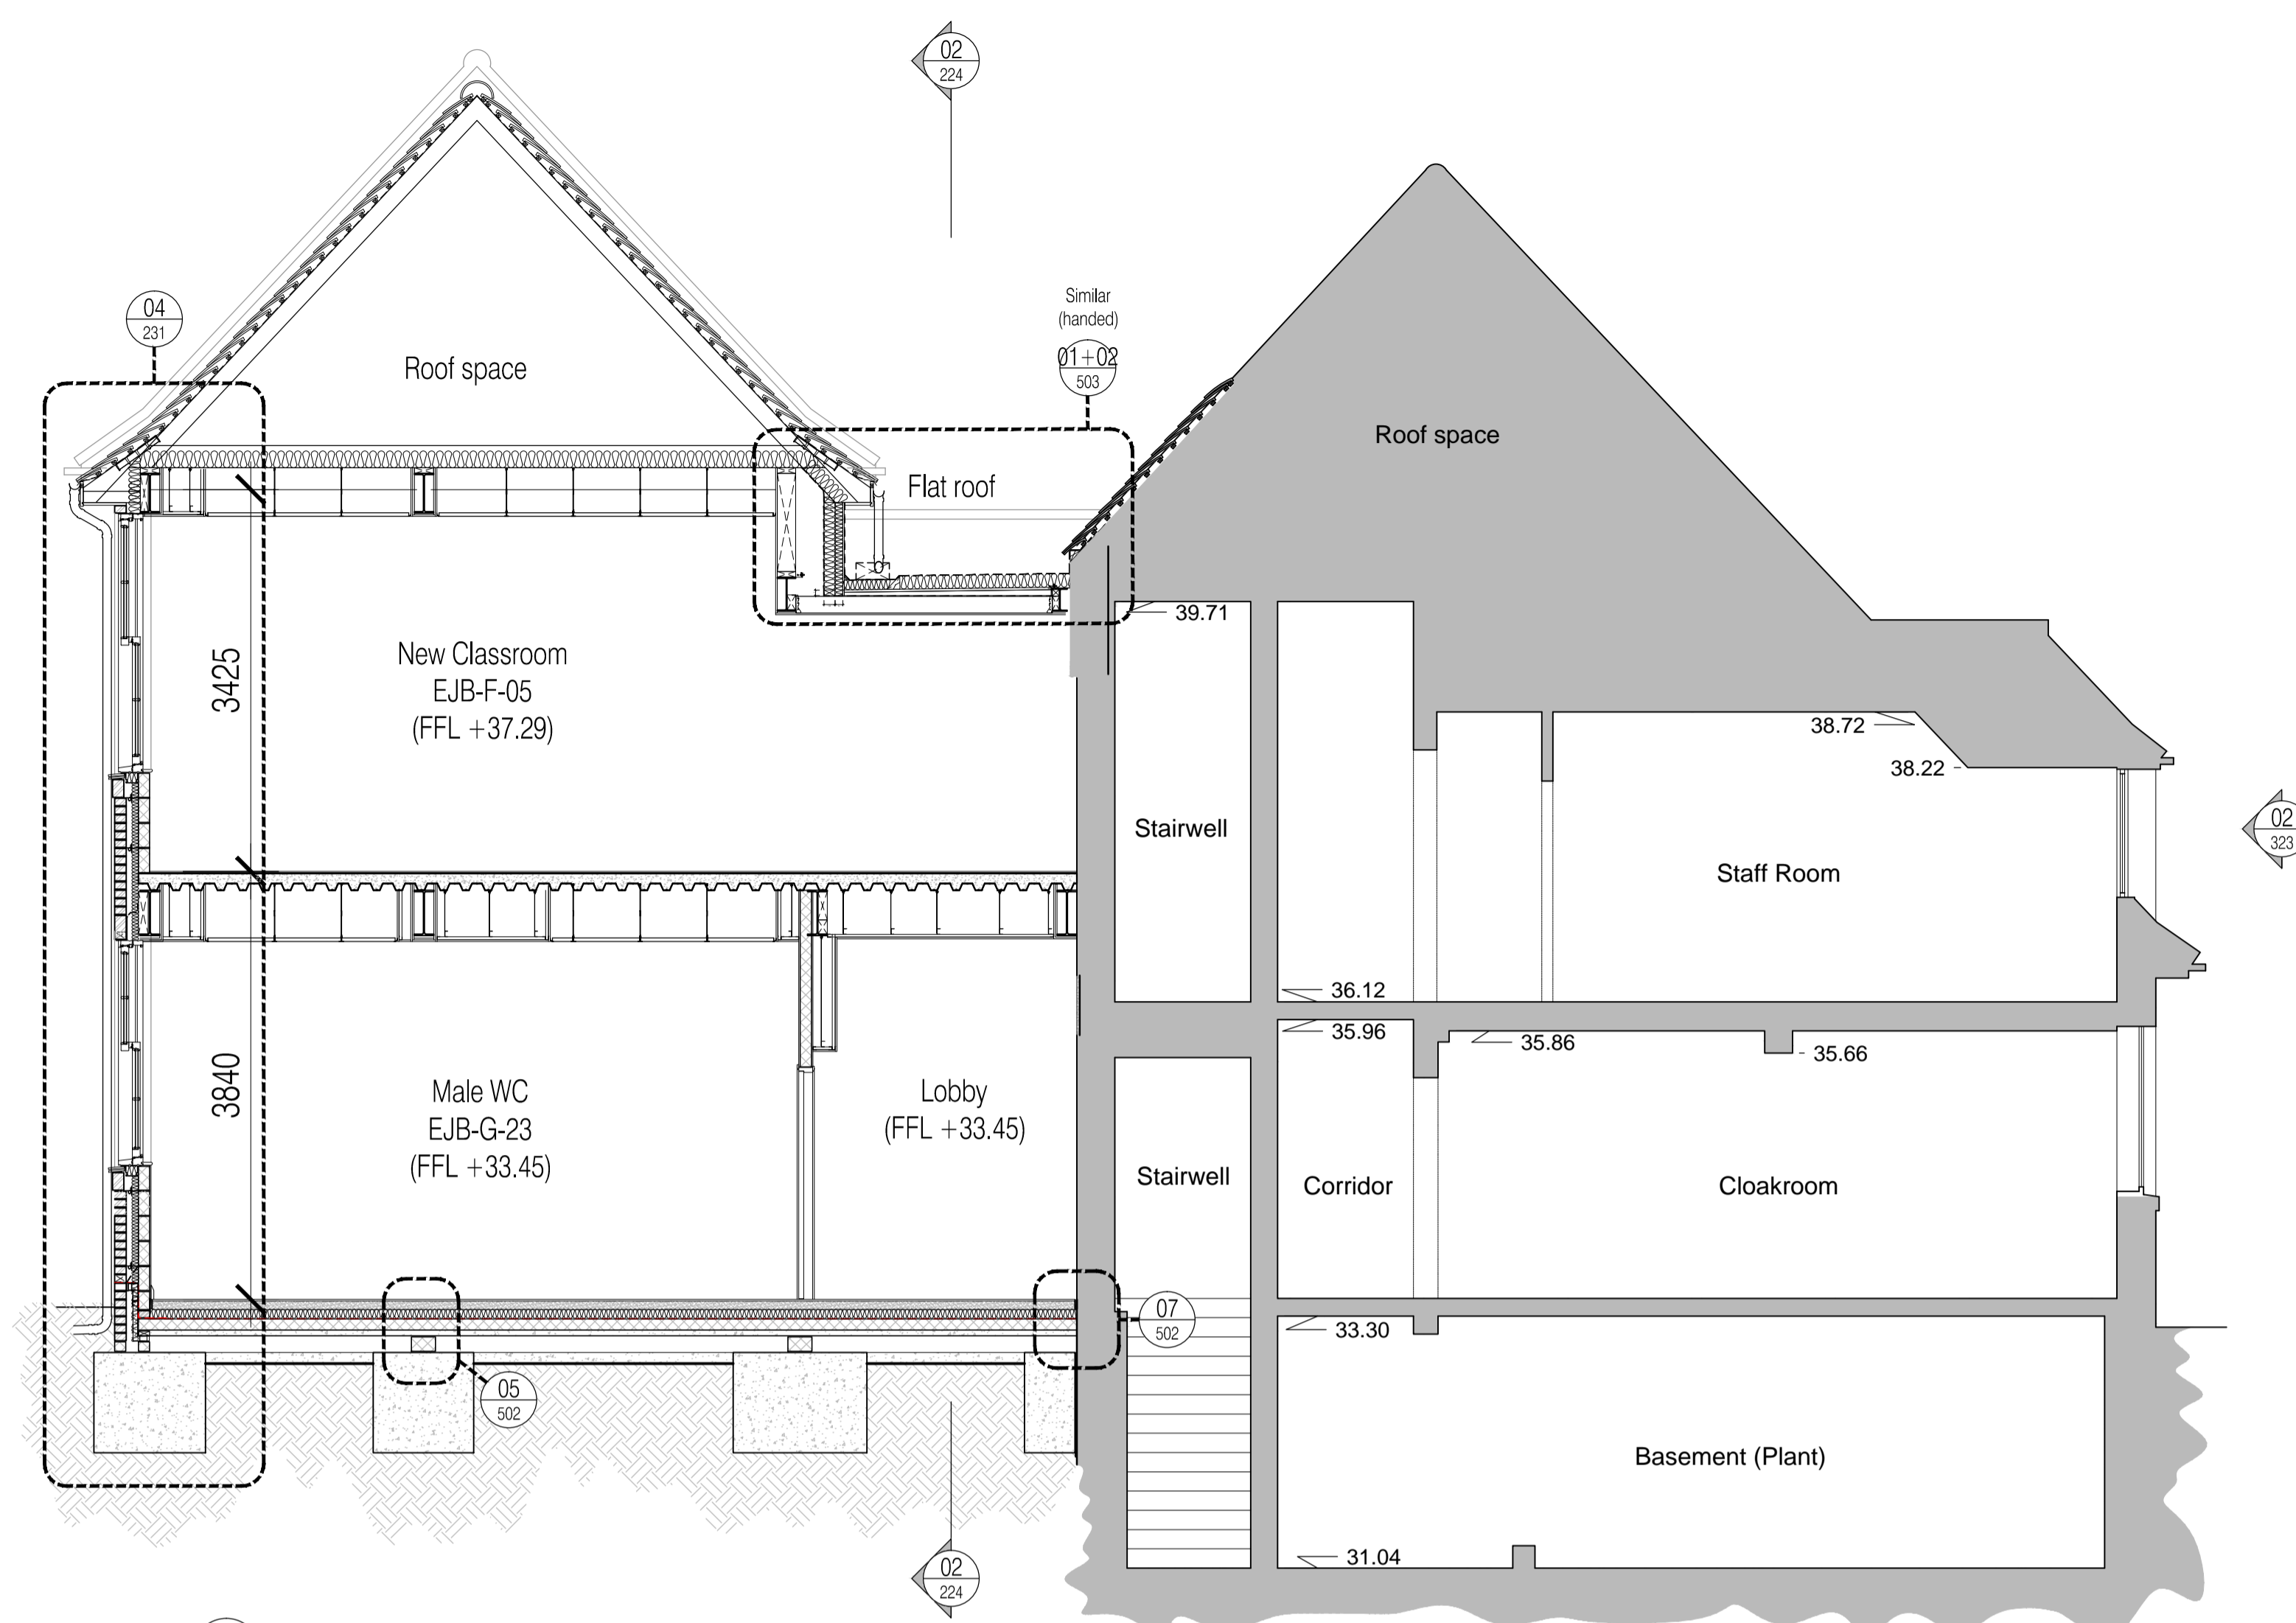
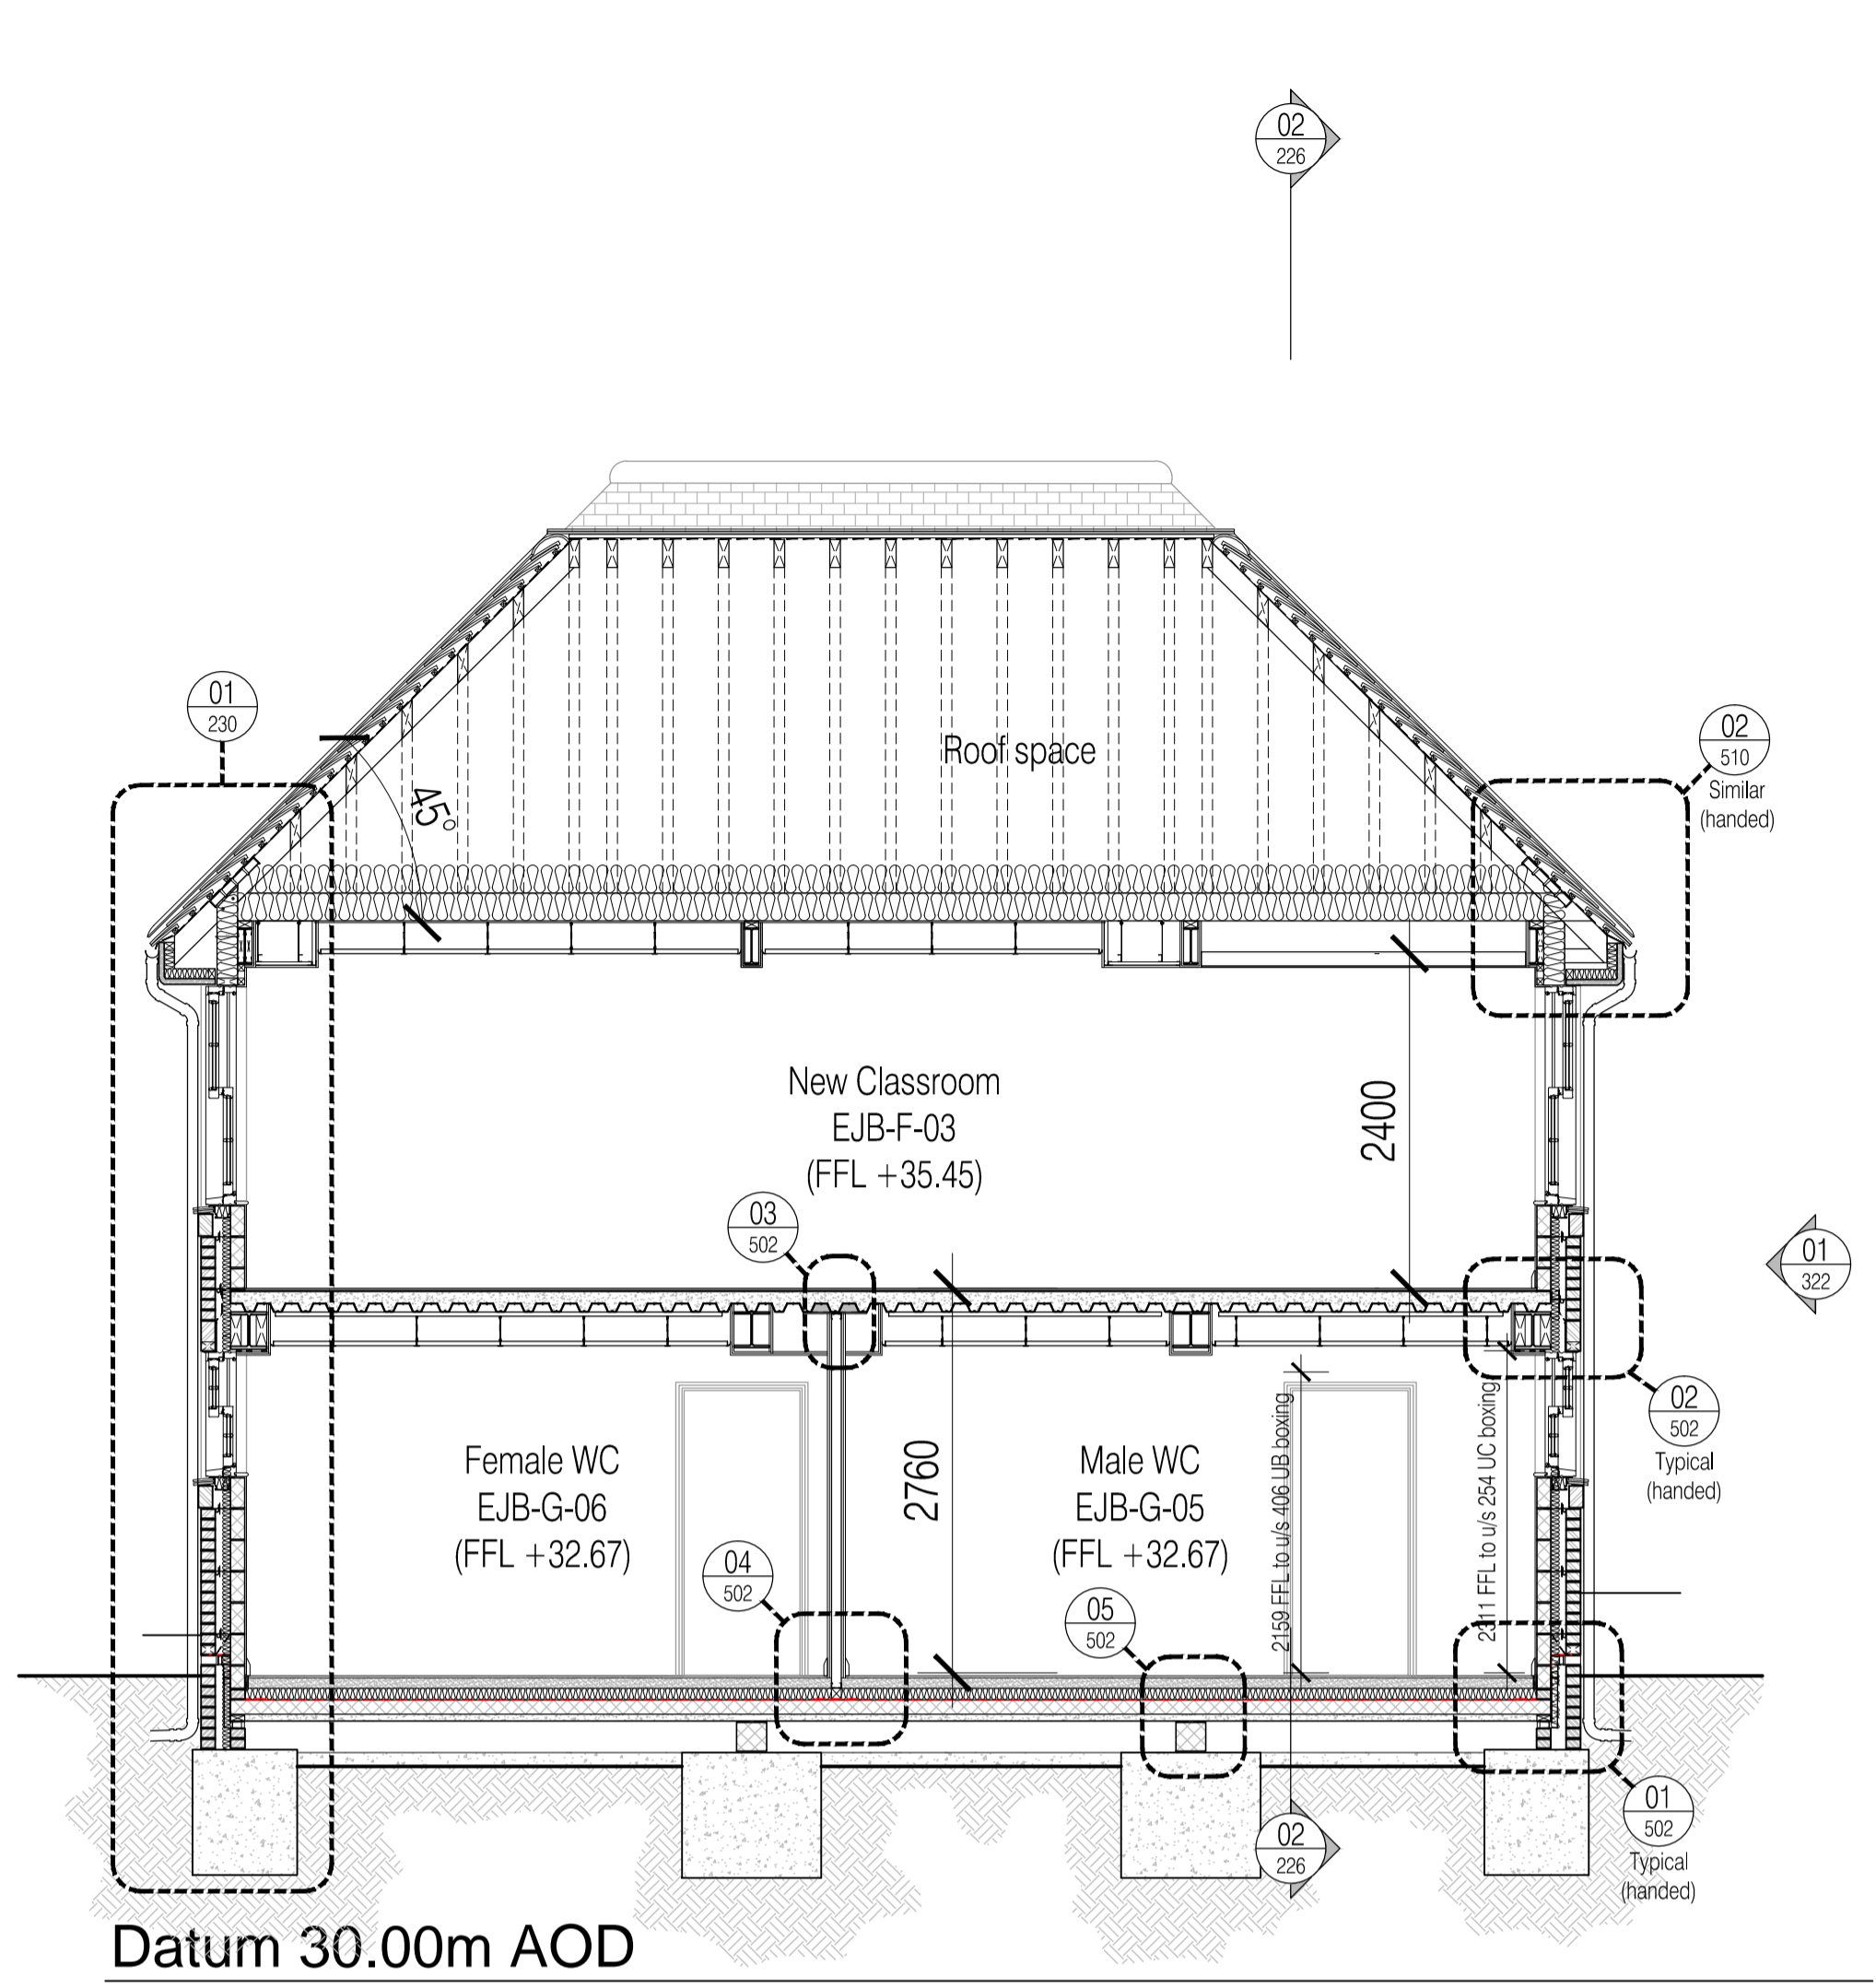


NOTES: Do not scale this drawing. All dimensions to be checked on site prior to commencement or manufacture.
 NB: All information based on supplied third party survey information. All discrepancies to be reported to FCG immediately upon discovery.

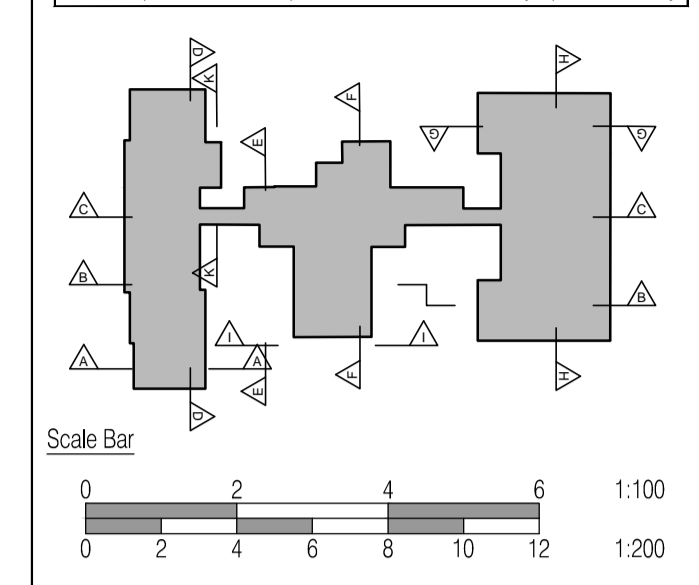

AS BUILT
DRAWING

Rev	Date	By	Clk	Comment
AB1	17.04.14	FRK	AGC	DRAWING ISSUED - AS BUILT

25 YEARS OF BRINGING IDEAS TO LIFE

FRANKHAM

Frankham Consultancy Group Limited
 Frankham House Wootton Business Park
 Besselsleigh Road Wootton Abingdon
 Oxfordshire OX13 6FD
 T 01865 322500 F 01865 327393
 E enquiry@frankham.com www.frankham.com

Client: **Leadbitter CONSTRUCTION**

Project Title: Whitehall Junior & Infant School
 Refurbishment, Extension and New Build
 Cowley Road
 London Borough of Hillingdon

Drawing Title: Junior School
 Proposed GA Sections A, F & G

Drawn by: FRK	Scale: 1:50@A1	Date: 01.08.12
Designed by: FCG	Checked by: JAS	Approved by: AC

File Ref: J:\000001\001\HILLINGDON\SCHOOLS\WHITEHALL\REFURB\GA\SECTION A, F & G\14.04.24.10.41.03

Drawing No. 611869-A-223 Rev. AB1