

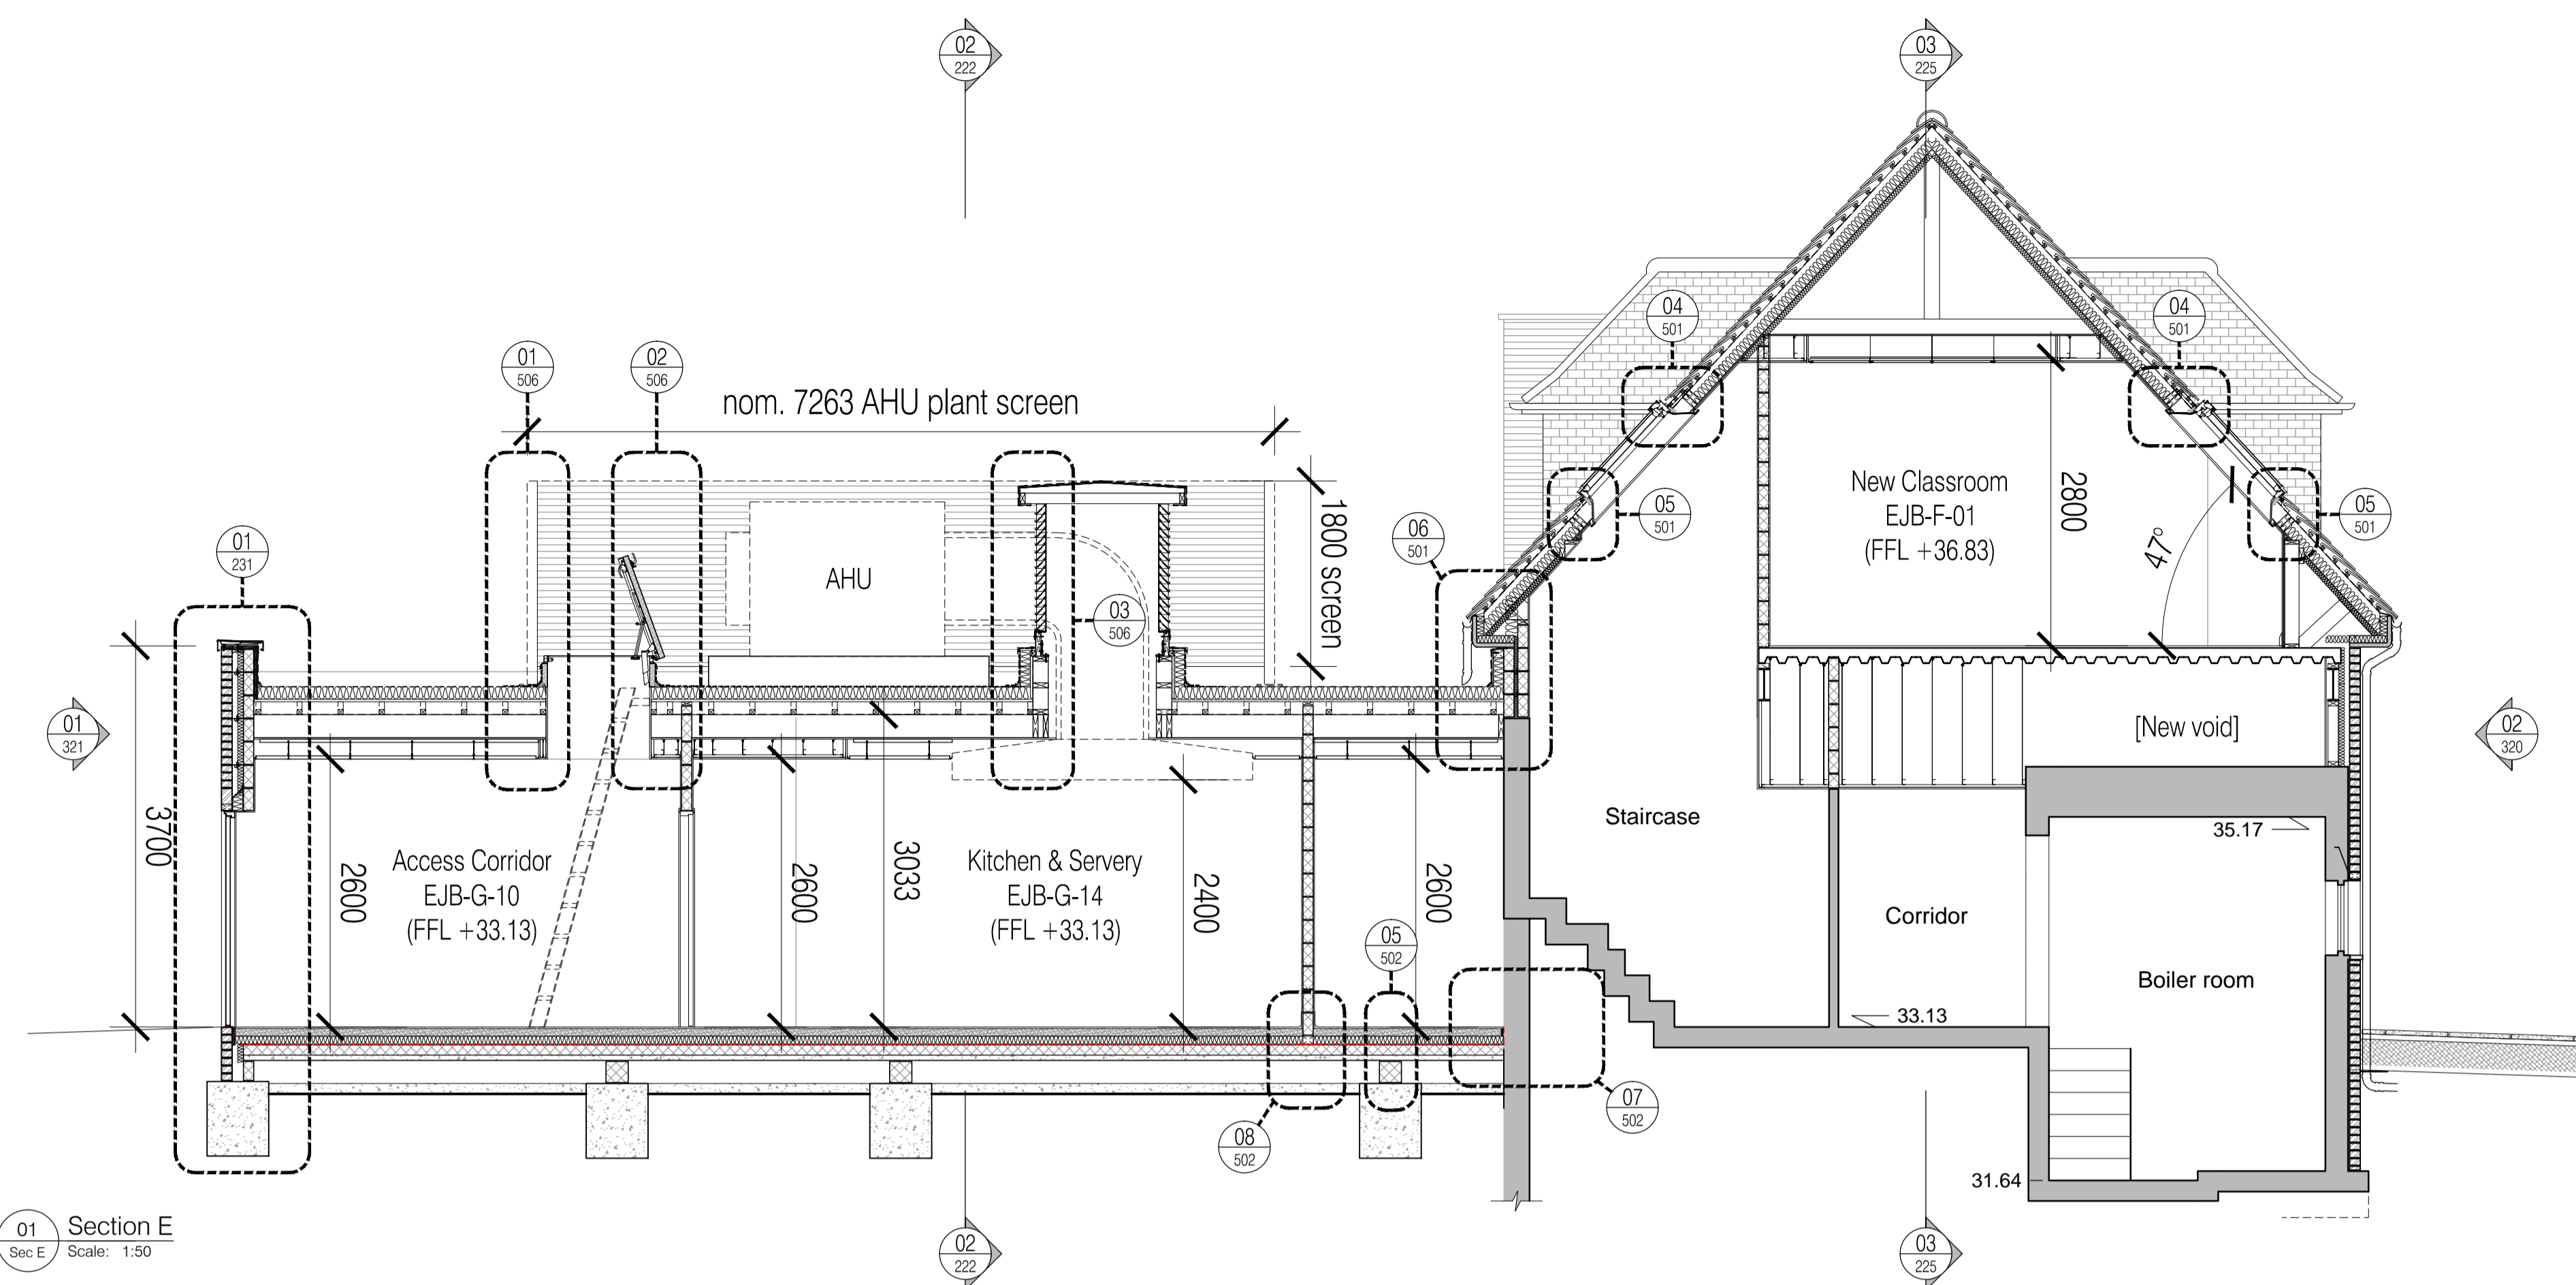


NOTES: Do not scale this drawing. All dimensions to be checked on site prior to commencement or manufacture.
 NB: All information based on supplied third party survey information. All discrepancies to be reported to FCG immediately upon discovery.

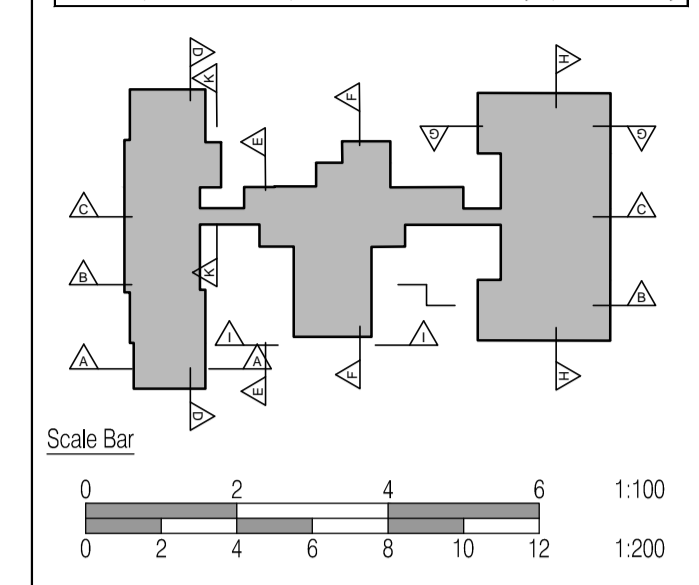

01 Section E
 Sec E
 Scale: 1:50

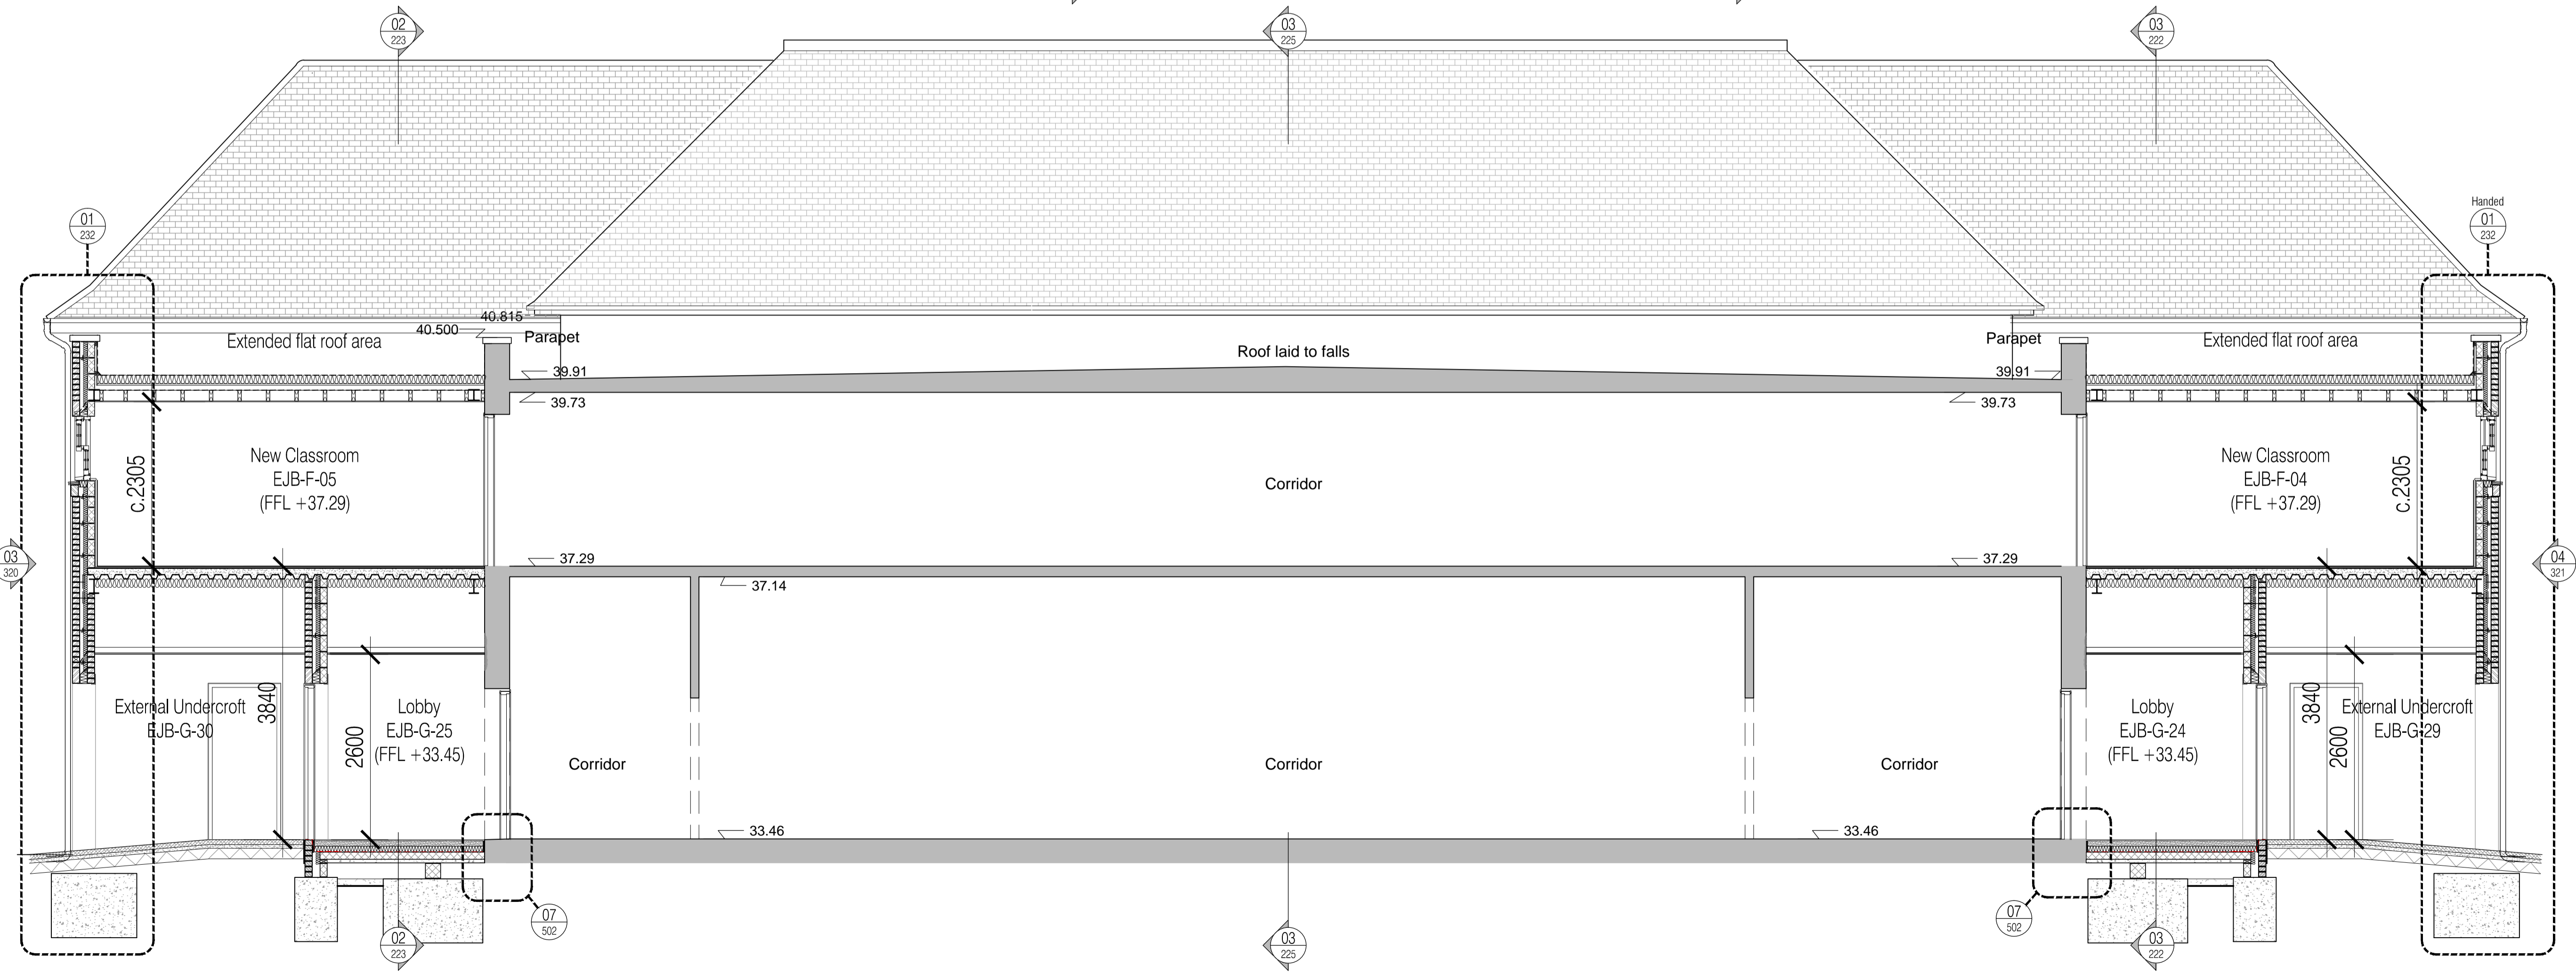

02 Section H
 Sec H
 Scale: 1:50

AS BUILT
 DRAWING

Rev	Date	By	Clk	Comment
AB1	17.04.14	FRK	AGC	DRAWING ISSUED - AS BUILT

25 YEARS OF BRINGING IDEAS TO LIFE

FRANKHAM

Frankham Consultancy Group Limited
 Frankham House Wootton Business Park
 Besselsleigh Road Wootton Abingdon
 Oxfordshire OX13 6FD
 T 01865 322500 F 01865 327393
 E enquire@frankham.com
 www.frankham.com

Client: **Leadbitter CONSTRUCTION**

Project Title: Whitehall Junior & Infant School
 Refurbishment, Extension and New Build
 Cowley Road
 London Borough of Hillingdon

Drawing Title: Junior School
 Proposed GA Sections E & H

Drawn by: RKC	Scale: 1:50@A1	Date: 01.08.12
Designed by: FCG	Checked by: JAS	Approved by: AC
Drawing No. 611869-A-224		Rev. AB1