

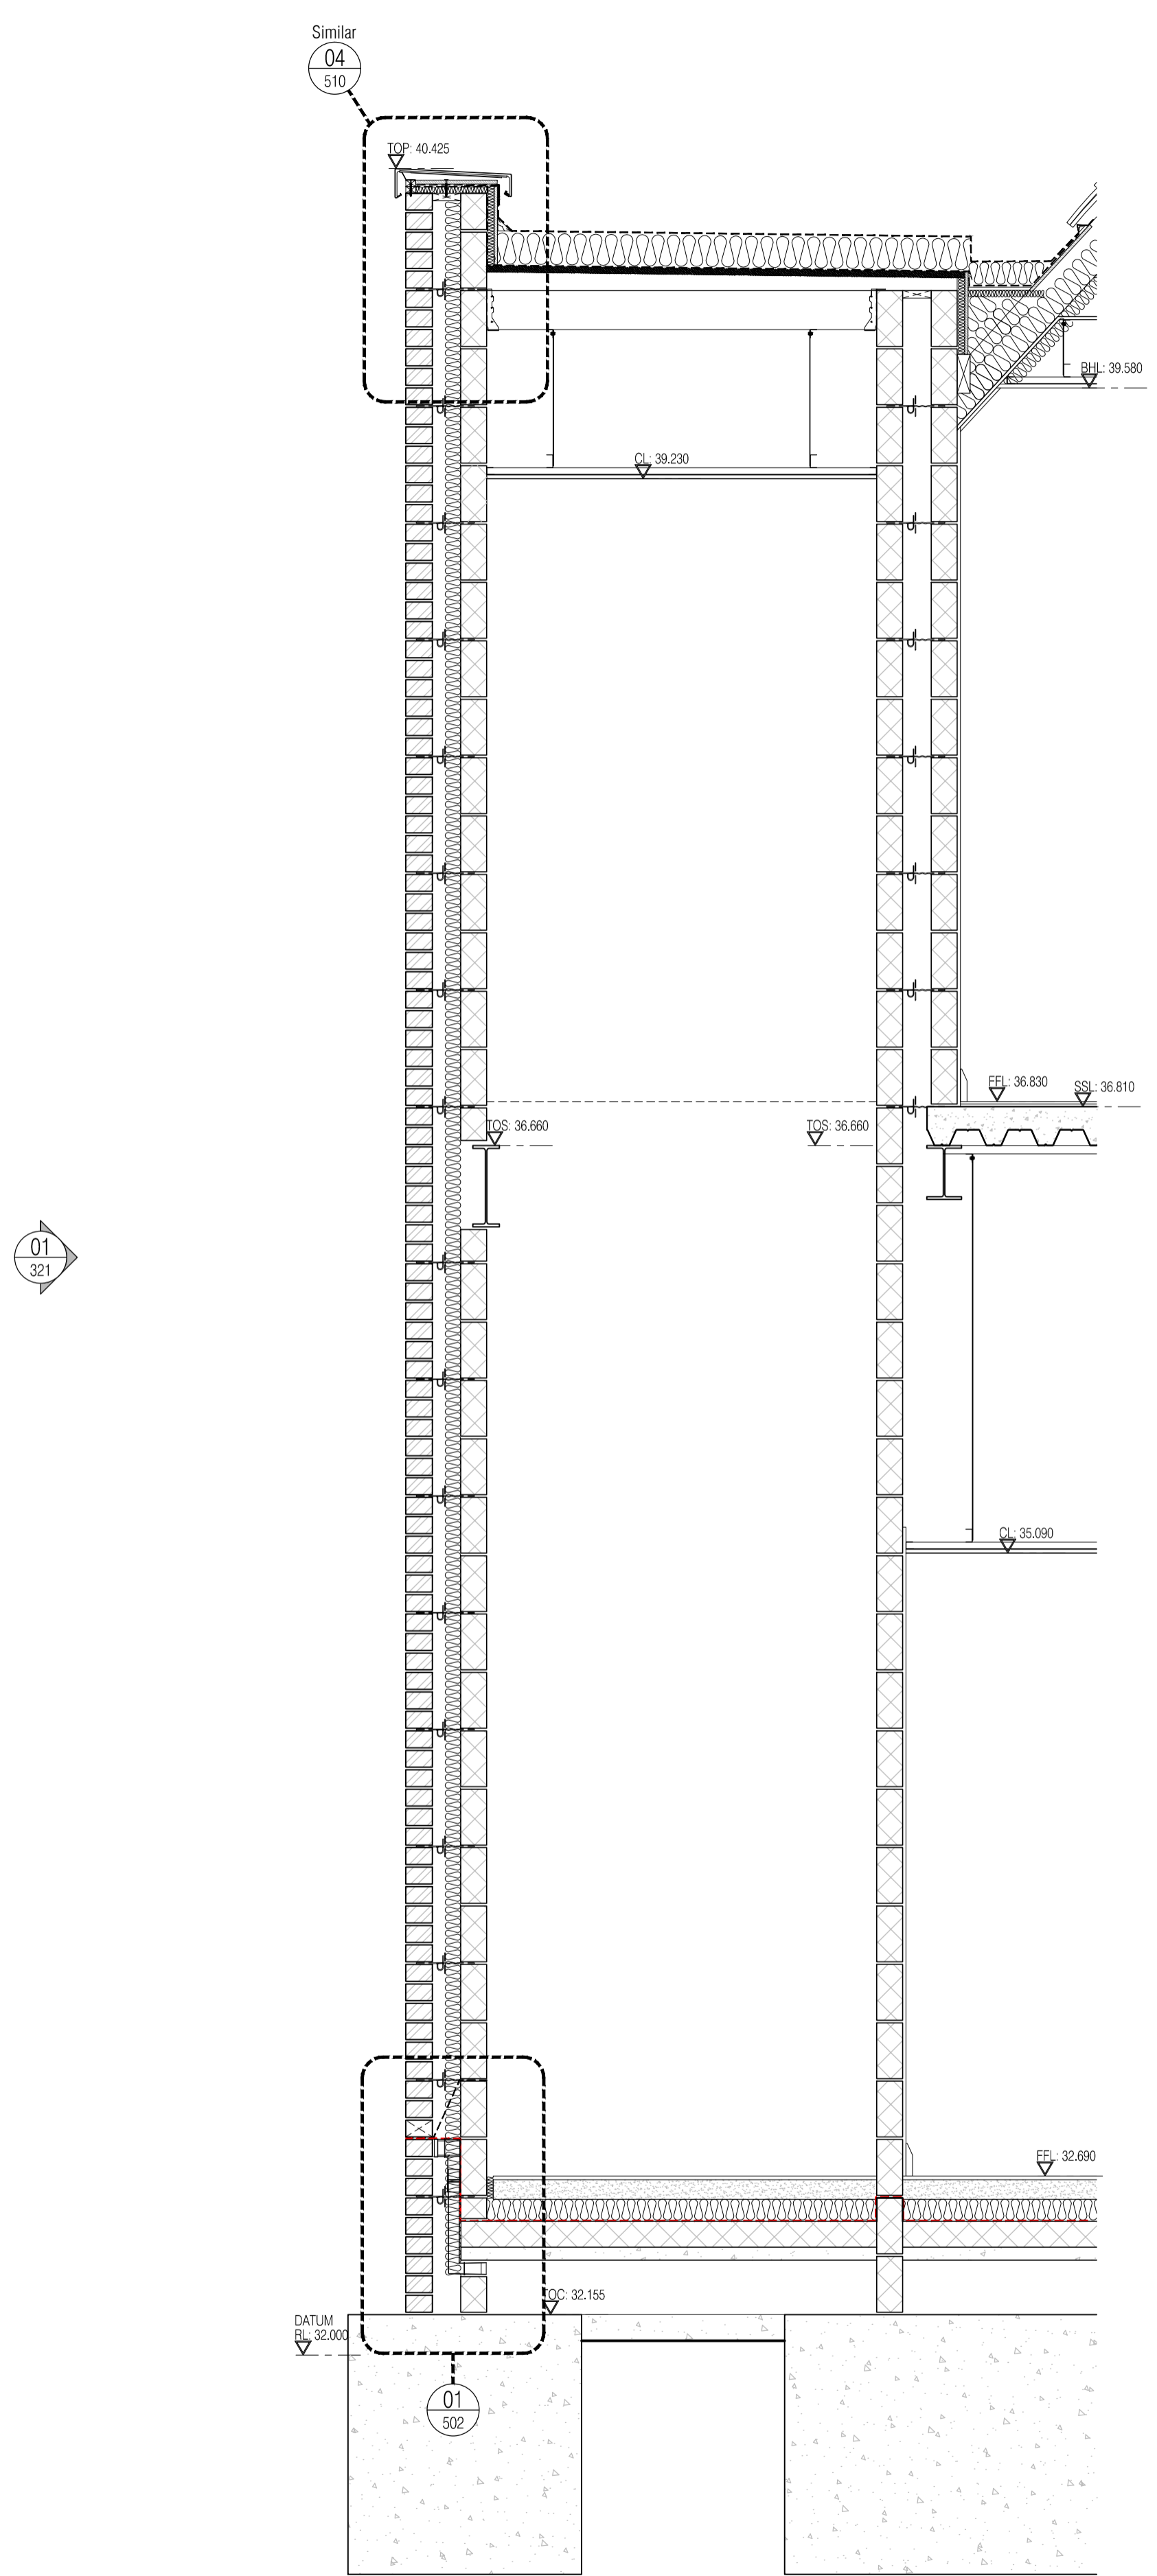



NOTES: Do not scale this drawing. All dimensions to be checked on site prior to commencement or manufacture.
 NB: All information based on supplied third party survey information. All discrepancies to be reported to FCG immediately upon discovery.

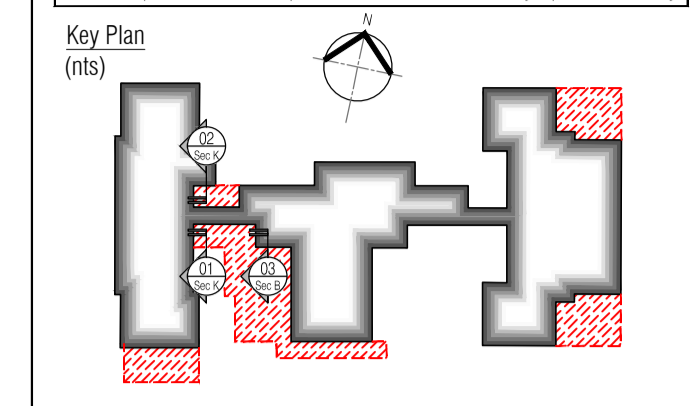

01 Section K 01
Scale: 1:20

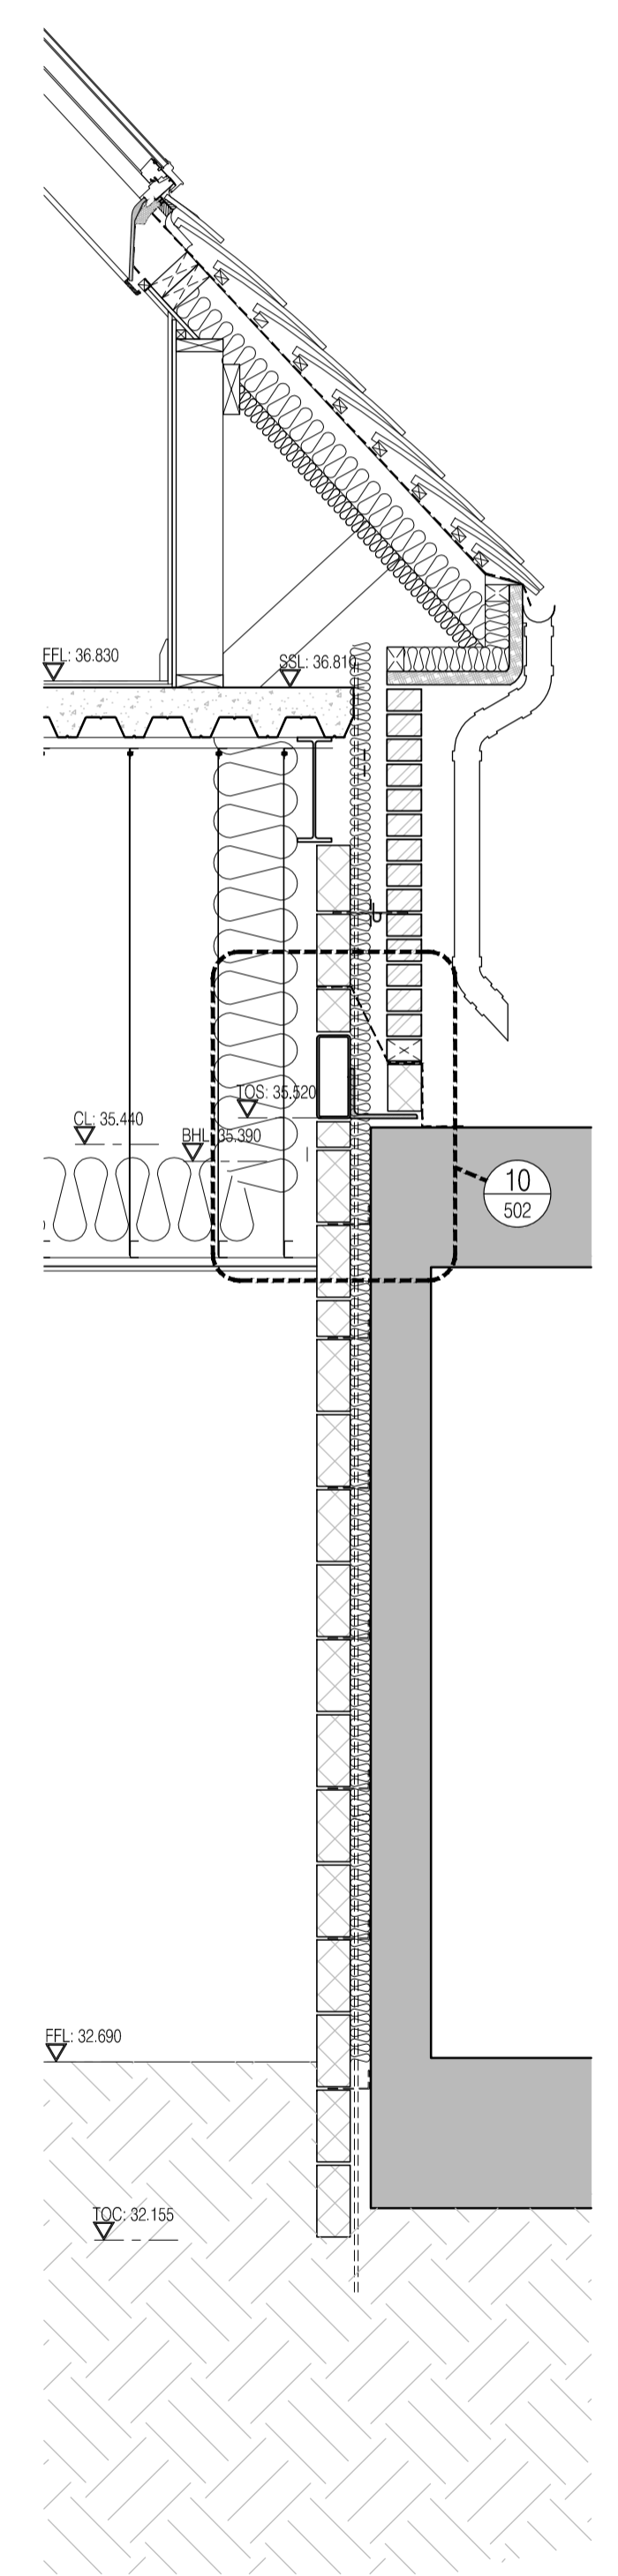

02 Section K 02
Scale: 1:20

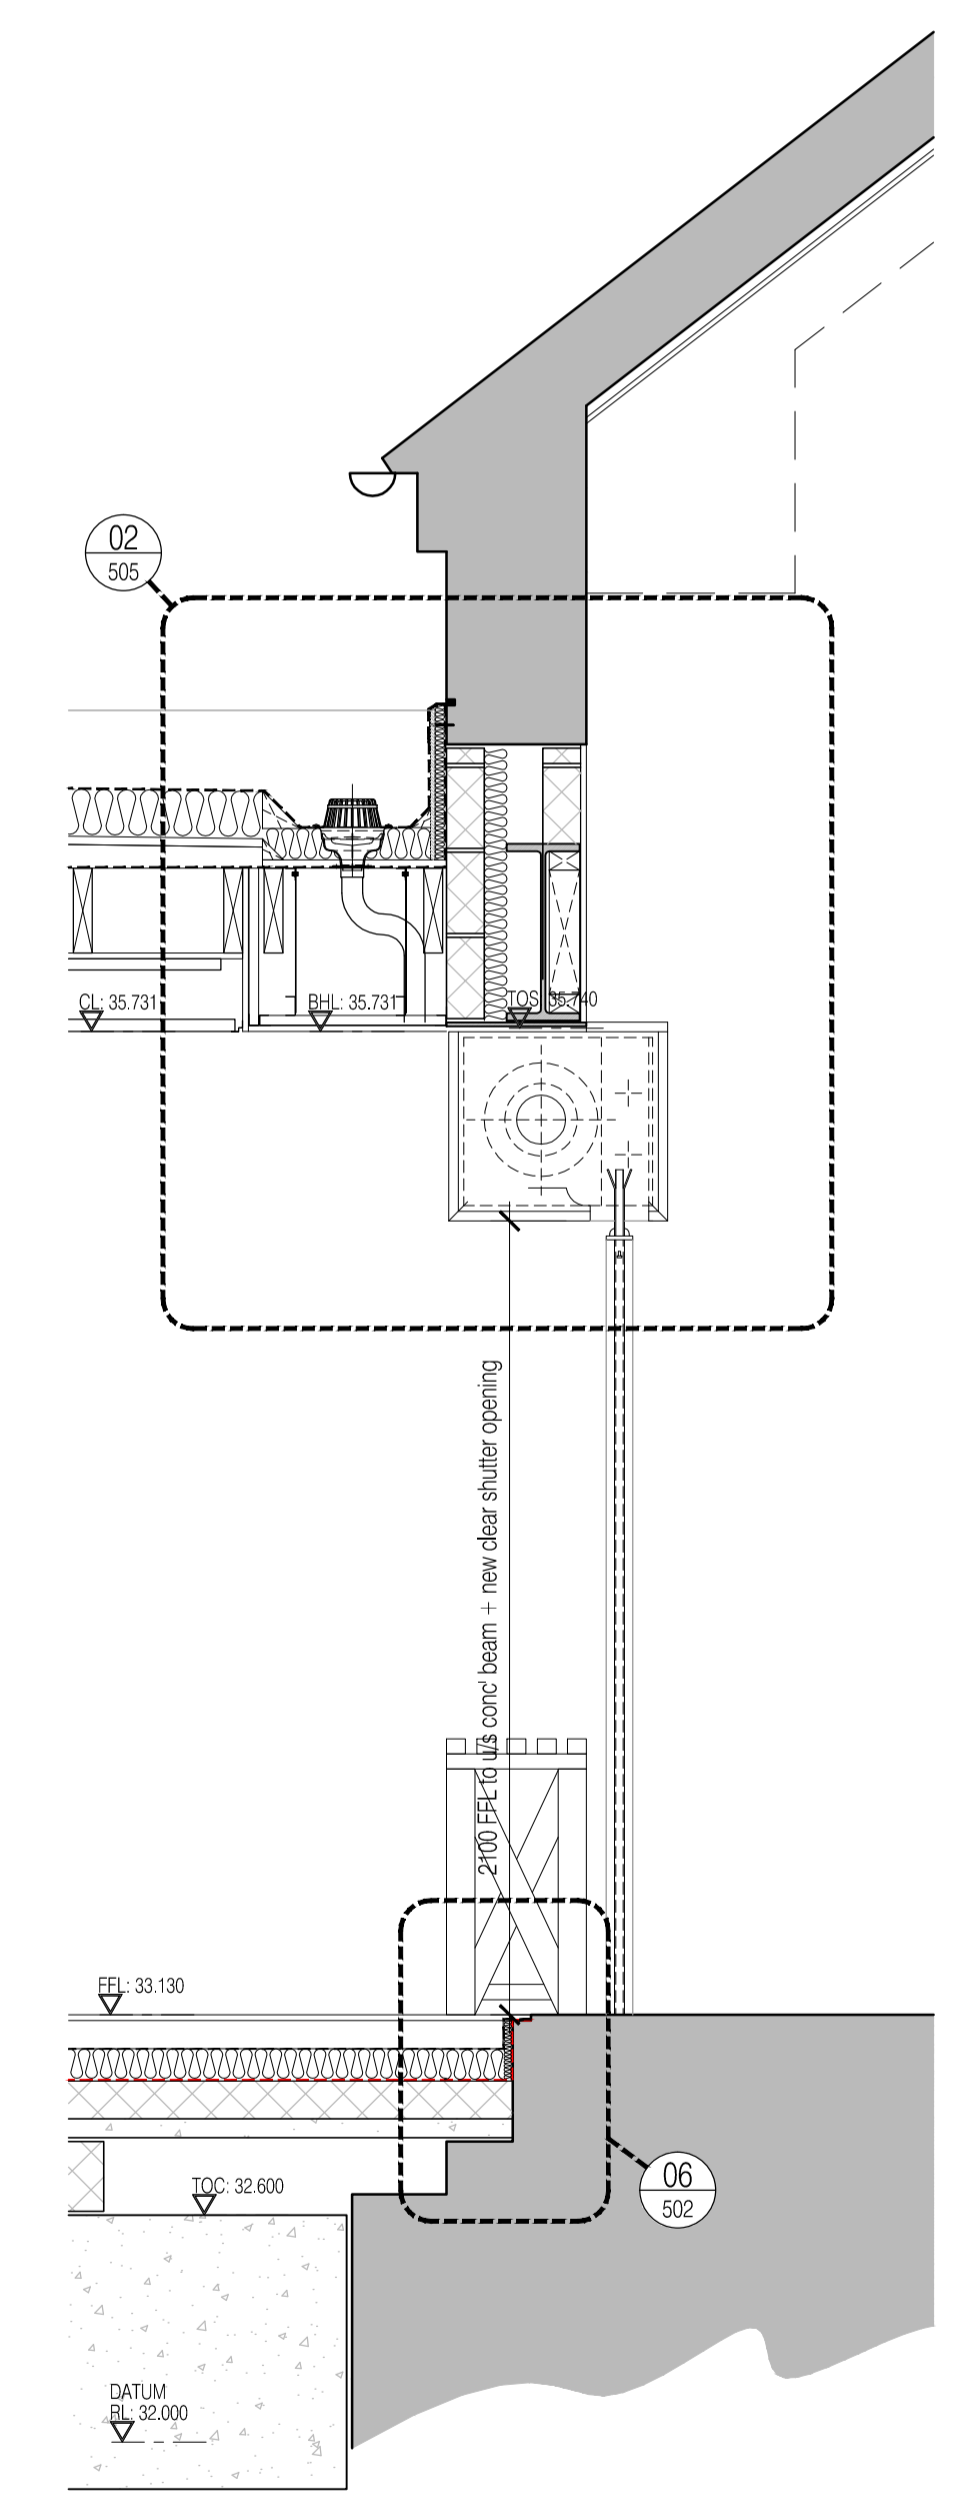

03 Section B
Scale: 1:20

AS BUILT
DRAWING

Rev	Date	By	Clk	Comment
AB1	17.04.14	RKC	AGC	DRAWING ISSUED - AS BUILT

25 YEARS OF BRINGING IDEAS TO LIFE

ANNIVERSARY 25 YEARS 1982-2007

FRANKHAM

Frankham Consultancy Group Limited
 Frankham House Woolton Business Park
 Besselsleigh Road Woolton Abingdon
 Oxfordshire OX13 6FD
 T 01865 322500 F 01865 327393
 E enquire@frankham.com www.frankham.com

Client: **Leadbitter**
CONSTRUCTION

Project Title: Whitehall Junior & Infant School
 Refurbishment, Extension and New Build
 Cowley Road
 London Borough of Hillingdon

Drawing Title: Junior School
 Proposed Wall Strip Sections
 (Sheet 4)

Drawn by: RKC	Scale: 1:20@A1	Date: 03.10.12
Designed by: FCG	Checked by: JAS	Approved by: AC

File Ref: J:\00004188 - HILLINGDON SCHOOLS - WHITEHALL JUNIOR & INFANT SCHOOL\SECTION 4
 14.04.24.10.42.23

Drawing No. 611869-A-233 Rev. AB1