

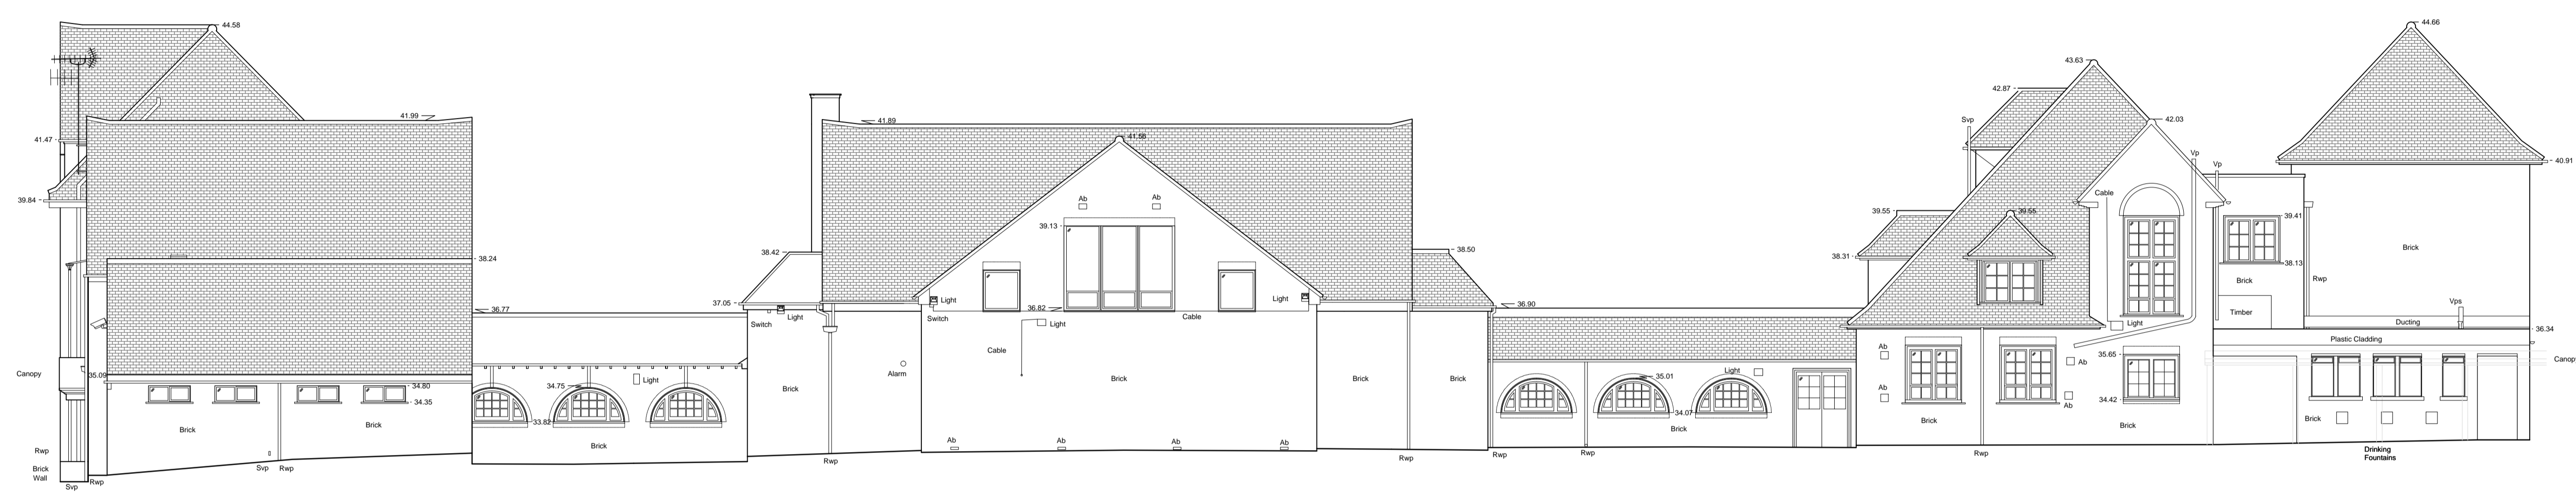
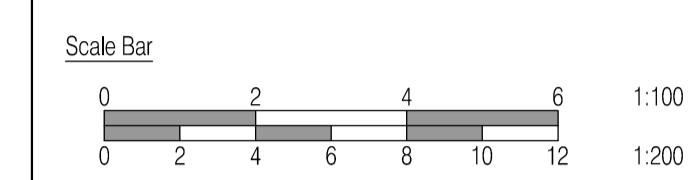


NOTES: Do not scale this drawing. All dimensions to be checked on site prior to commencement or manufacture.  
 NB: All information based on supplied third party survey information. All discrepancies to be reported to FCG immediately upon discovery.

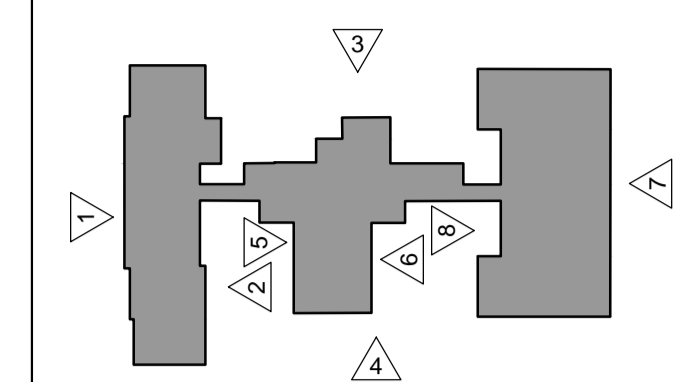

01 Elevation 4 - Proposed  
 Scale: 1:100

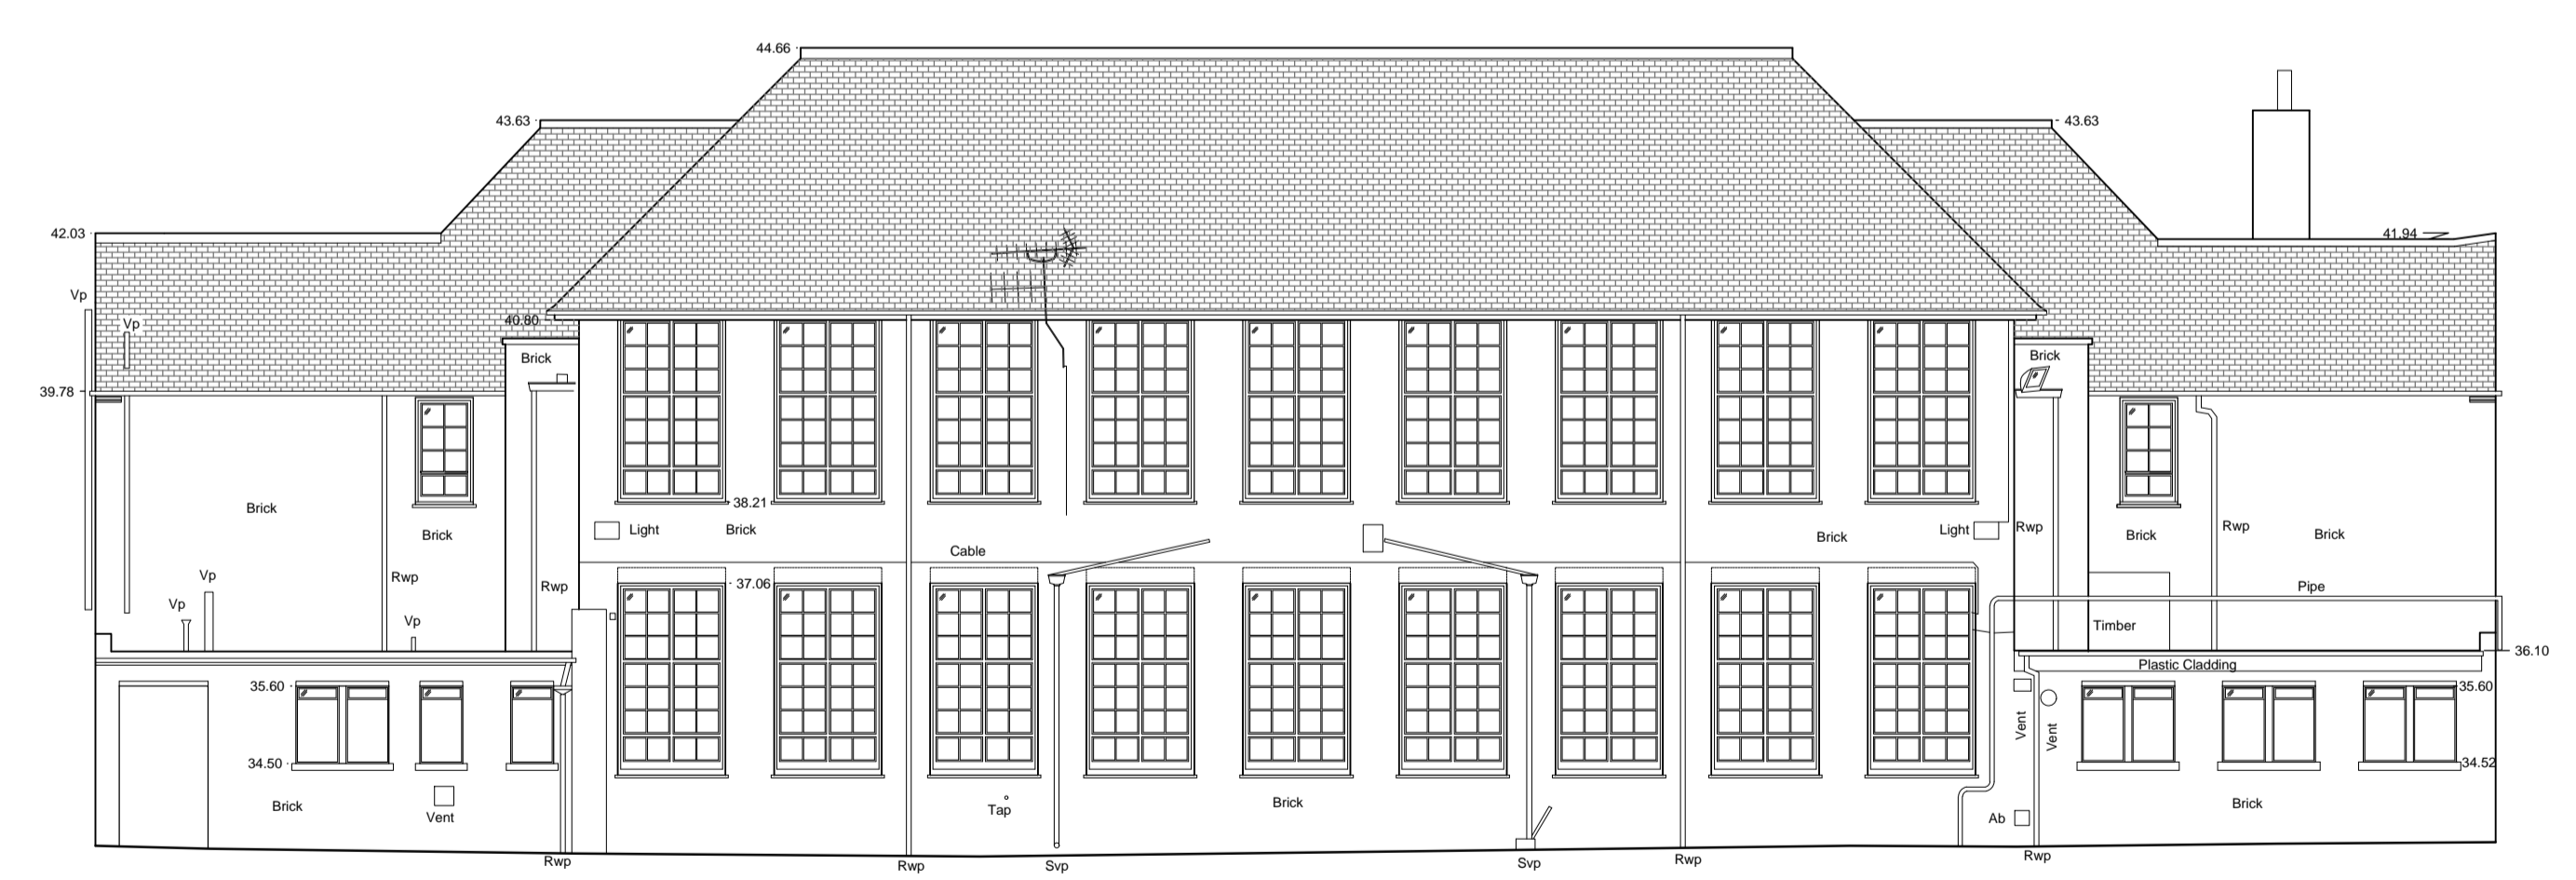

02 Elevation 7 - Proposed  
 Scale: 1:100

AS BUILT  
 DRAWING

Rev	Date	By	Clk	Comment
AB1	17.04.14	RKC	AGC	DRAWING ISSUED - AS BUILT

25 YEARS OF BRINGING IDEAS TO LIFE

**FRANKHAM**

Frankham Consultancy Group Limited  
 Frankham House Wootton Business Park  
 Besselsleigh Road Wootton Abingdon  
 Oxfordshire OX13 6FD  
 T 01865 322500 E 01865 327393  
 enquiries@frankham.com www.frankham.com

Client: **Leadbitter**  
 CONSTRUCTION

Project Title  
 Whitehall Junior & Infant School  
 Refurbishment, Extension and New Build  
 Cowley Road  
 London Borough of Hillingdon

Drawing Title  
 Junior School  
 Existing Elevations  
 Sheet 2

Drawn by: RKC	Scale: 1:100@A1	Date: 08.05.12
Designed by: FCG	Checked by: JAS	Approved by: AC

File Ref: J:\00000188-16100001-SCHOOL-16100001-REVISIONS\16100001-REV-14-16100001.DWG - REV-14-16100001.DWG	14.04.2014 14.04.14
Drawing No. 611869-A-311	Rev. AB1