

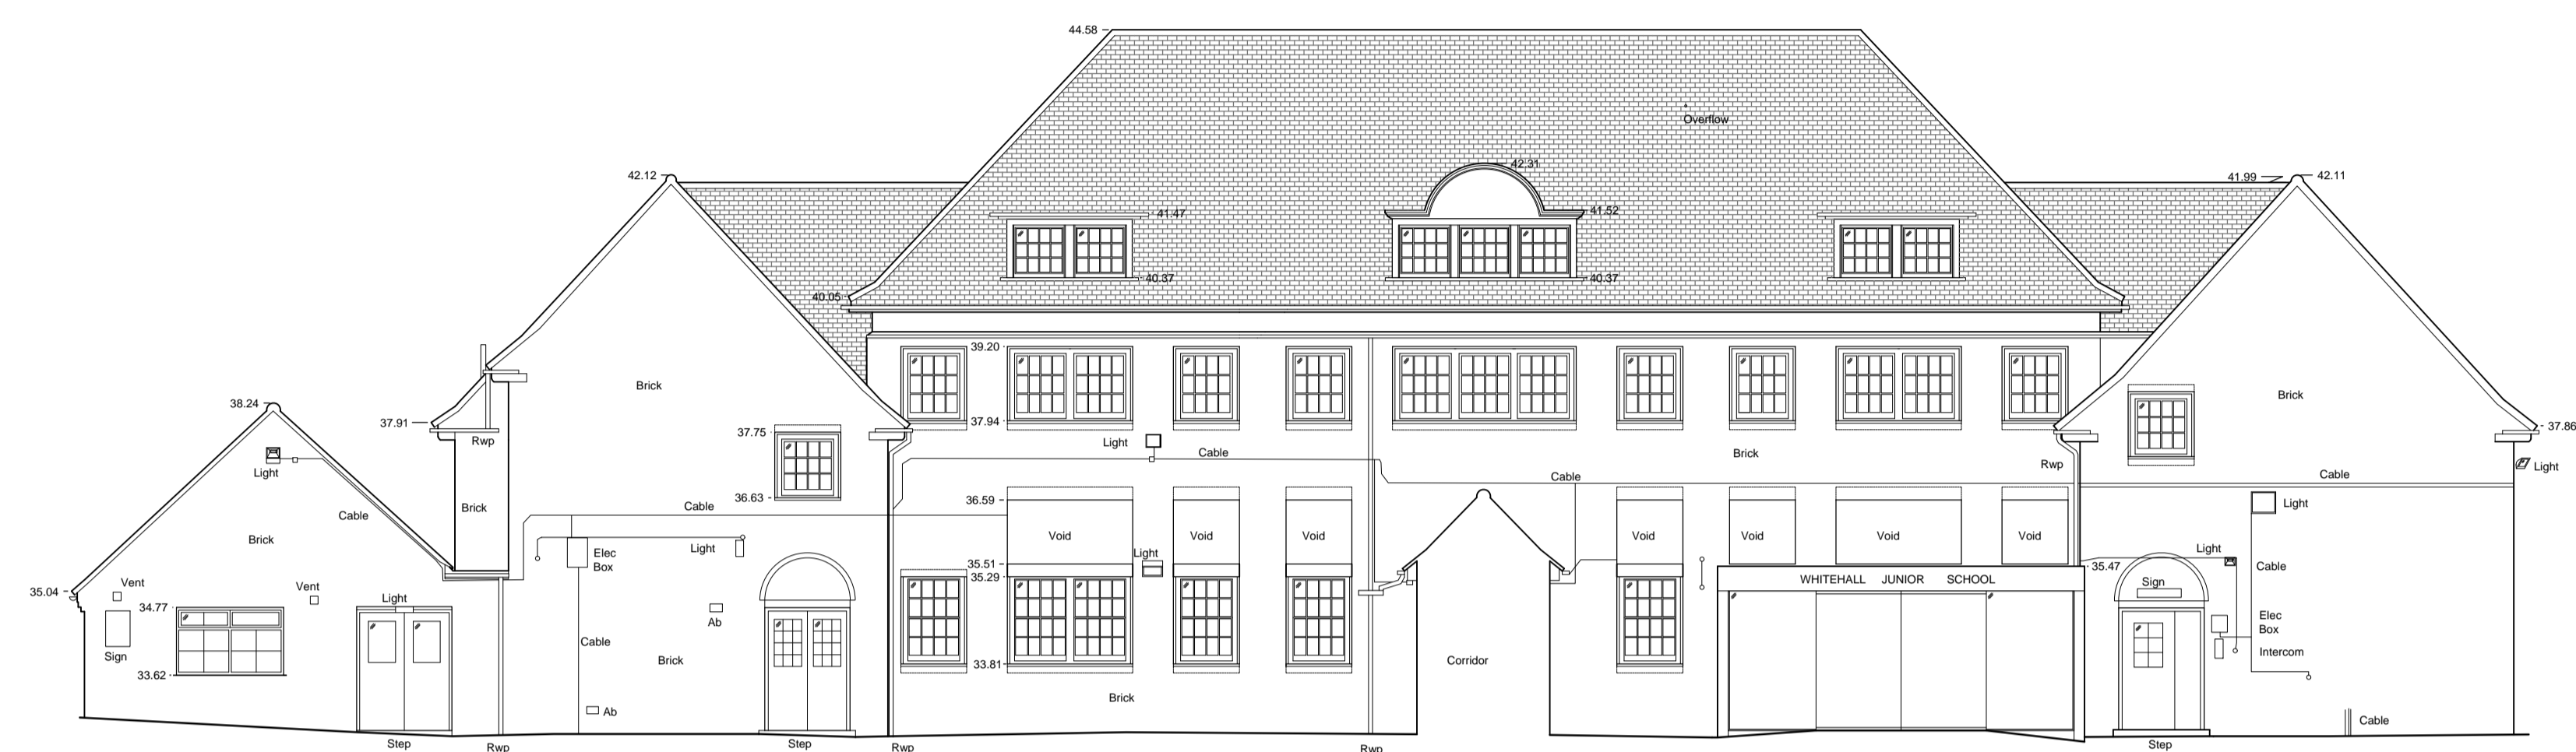
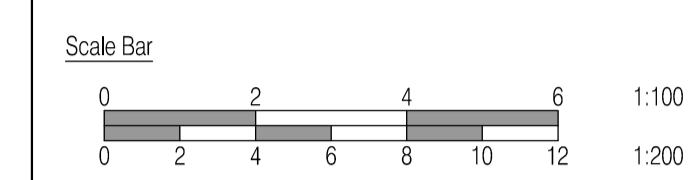


NOTES: Do not scale this drawing. All dimensions to be checked on site prior to commencement or manufacture.
 NB: All information based on supplied third party survey information. All discrepancies to be reported to FCG immediately upon discovery.

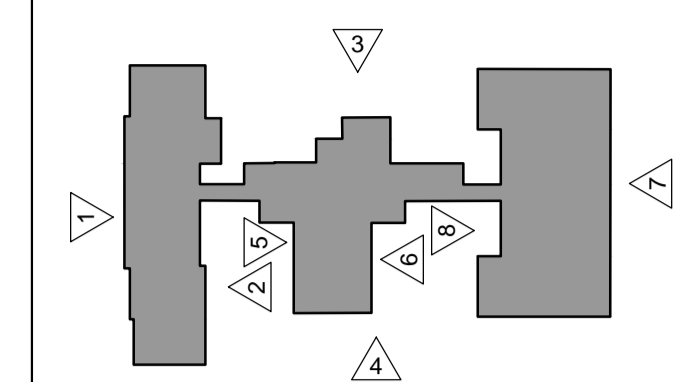

01 Elevation 2 - Proposed
 Scale: 1:100

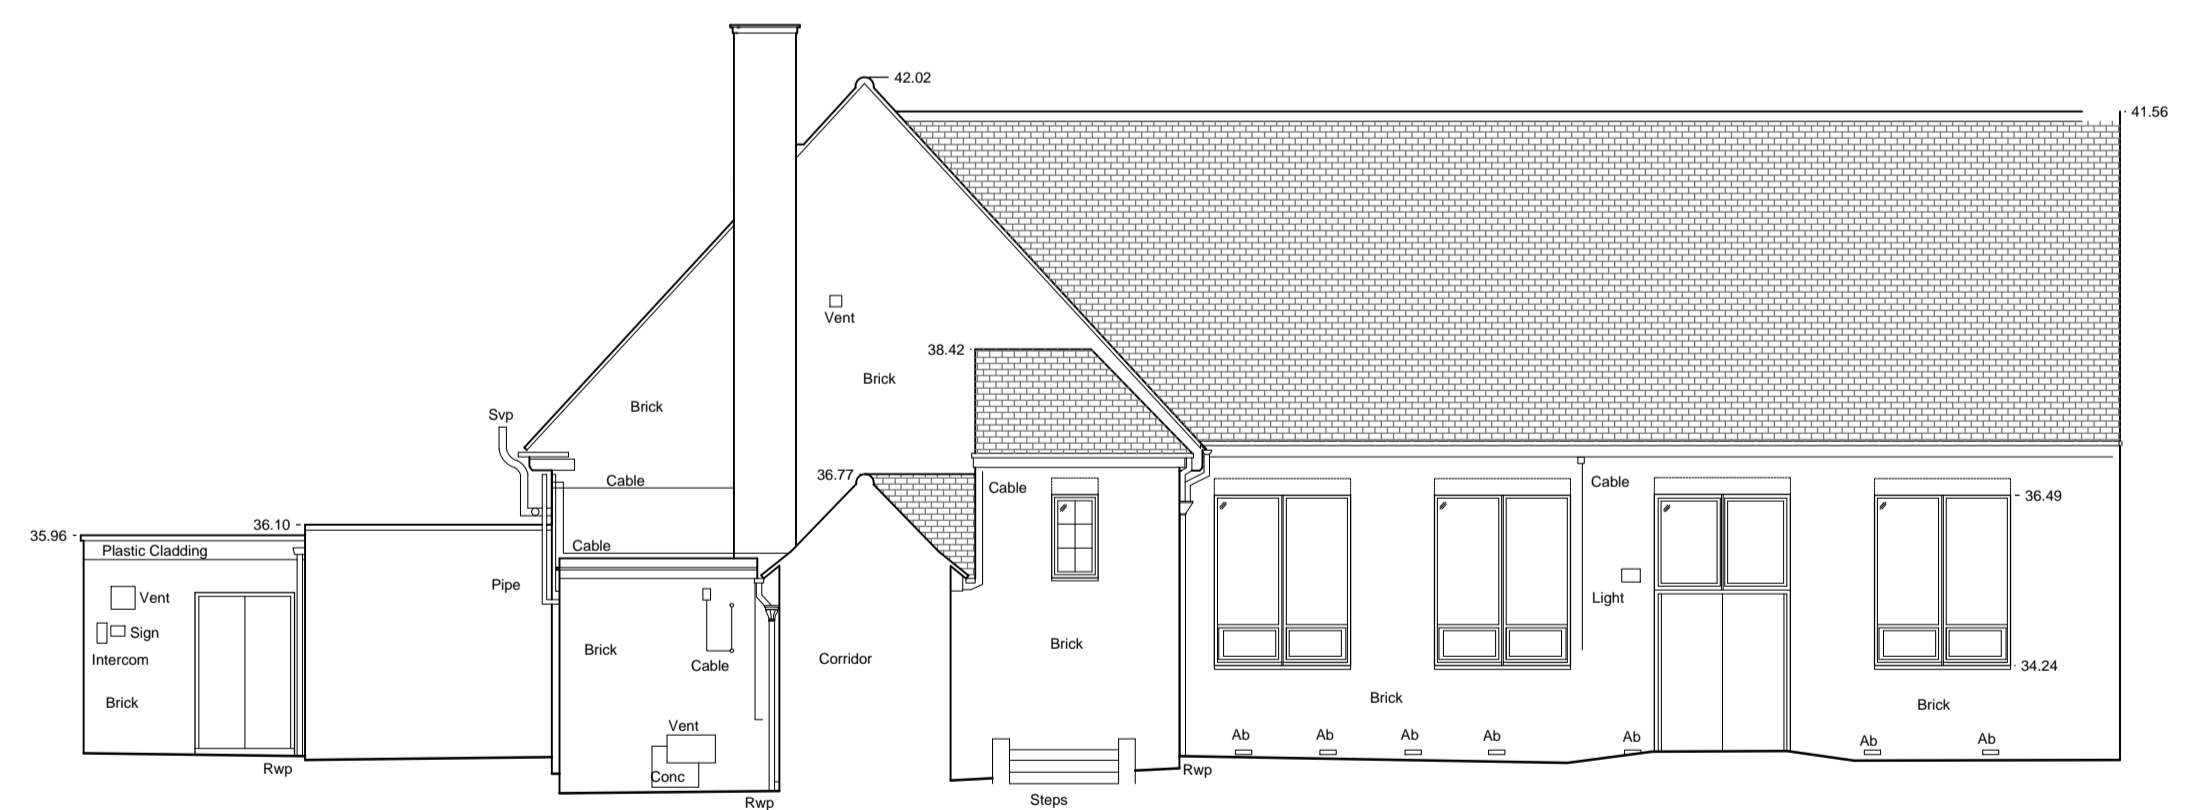

02 Elevation 5 - Proposed
 Scale: 1:100

AS BUILT
 DRAWING

AB1 17.04.14 RKC AGC DRAWING ISSUED - AS BUILT

Rev Date By Ck Comment

25 YEARS OF BRINGING IDEAS TO LIFE

FRANKHAM

Frankham Consultancy Group Limited

Frankham House Wootton Business Park
 Besselsleigh Road Wootton Abingdon
 Oxfordshire OX13 6FD
 T 01865 322500 F 01865 327393
 E enquire@frankham.com
 www.frankham.com

ANNIVERSARY
 25 YEARS
 1982-2007

Client **Leadbitter CONSTRUCTION**

Project Title
 Whitehall Junior & Infant School
 Refurbishment, Extension and New Build
 Cowley Road
 London Borough of Hillingdon

Drawing Title
 Junior School
 Existing Elevations
 Sheet 3

Drawn by: RKC	Scale: 1:100@A1	Date: 08.05.12
Designed by: FCG	Checked by: JAS	Approved by: AC

File Ref: J:\000001\88 - HILLINGDON SCHOOLS - WHITEHALL JUNIOR & INFANT SCHOOL\DWG - REVISED\0001\0001.DWG 14.04.24.10.43.23

Drawing No. 611869-A-312	Rev. AB1
-----------------------------	-------------