

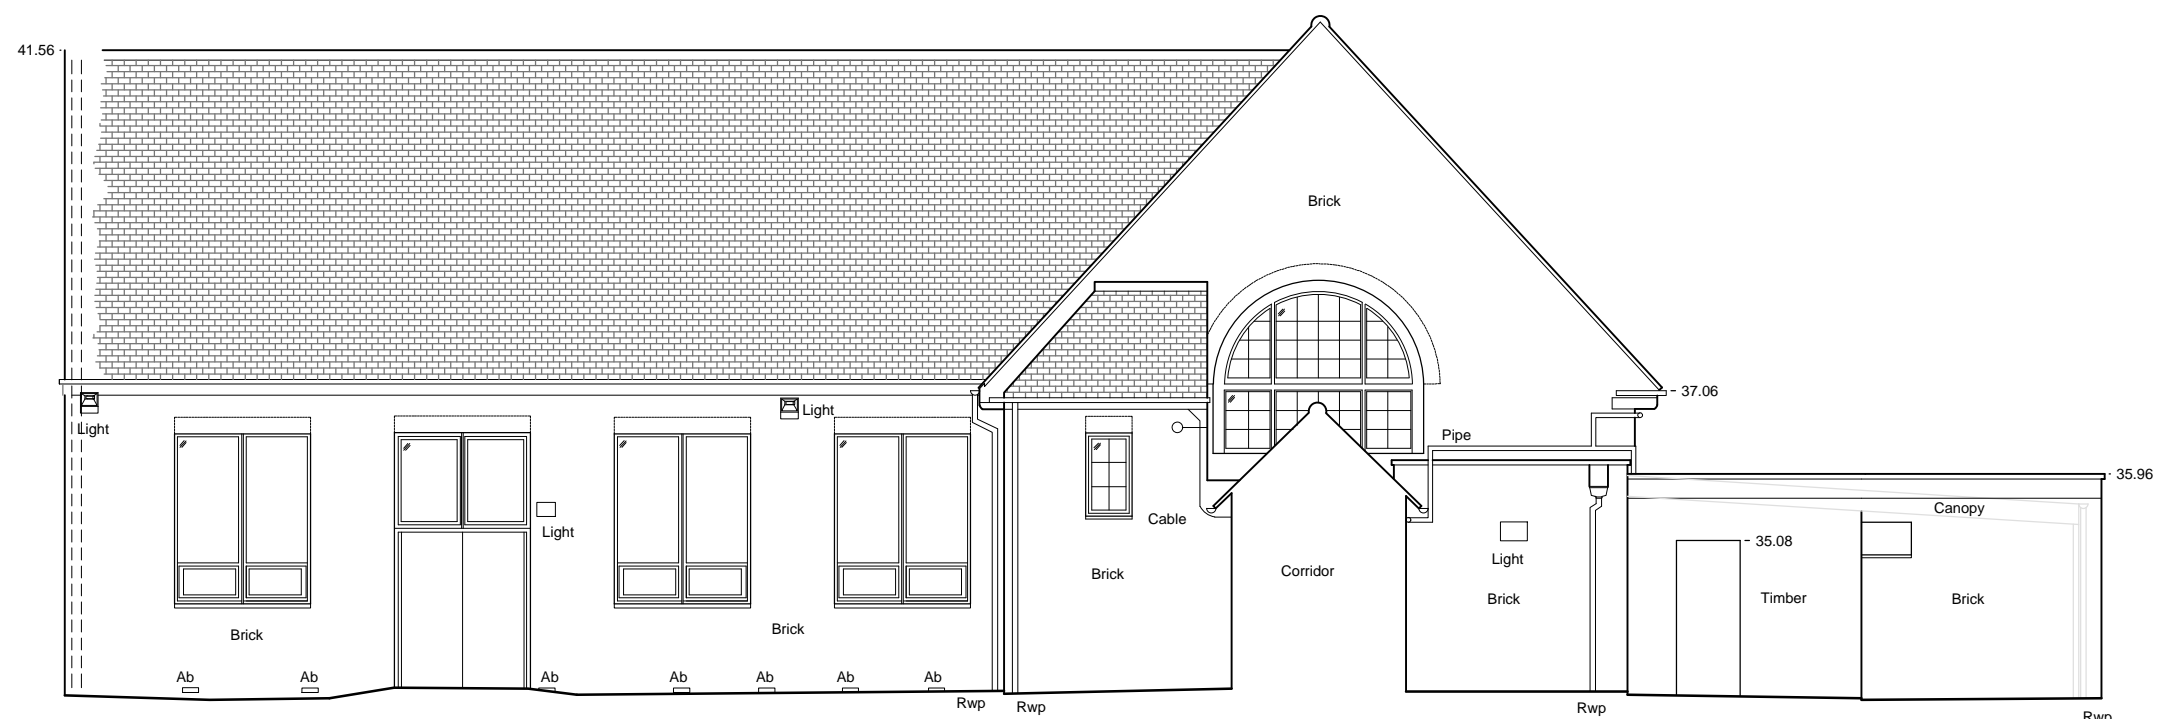


NOTES: Do not scale this drawing. All dimensions to be checked on site prior to commencement or manufacture.
 NB: All information based on supplied third party survey information. All discrepancies to be reported to FCG immediately upon discovery.

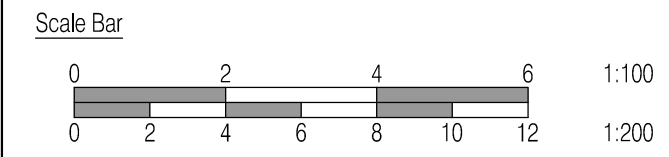

01 Elevation 6 - Proposed
 Scale: 1:100

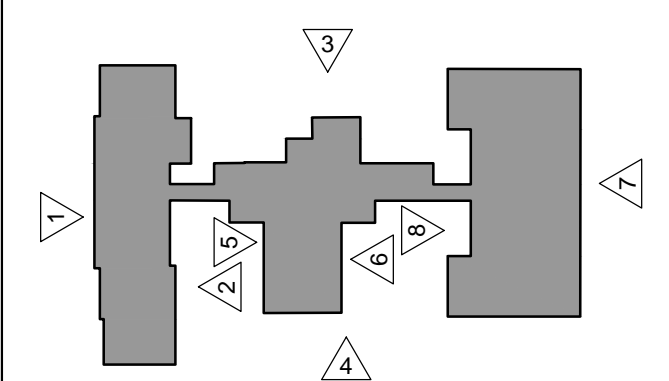

02 Elevation 8 - Proposed
 Scale: 1:100

AS BUILT
 DRAWING

Rev	Date	By	Clk	Comment
AB1	17.04.14	RKC	AGC	DRAWING ISSUED - AS BUILT

25 YEARS OF BRINGING IDEAS TO LIFE

FRANKHAM

Frankham Consultancy Group Limited
 Frankham House Wootton Business Park
 Besselsleigh Road Wootton Abingdon
 Oxfordshire OX13 6FD
 T 01865 322500 F 01865 327393
 E enquiry@frankham.com
 www.frankham.com

Client
Leadbitter
 CONSTRUCTION

Project Title
 Whitehall Junior & Infant School
 Refurbishment, Extension and New Build
 Cowley Road
 London Borough of Hillingdon

Drawing Title
 Junior School
 Existing Elevations
 Sheet 4

Drawn by: RKC	Scale: 1:100@A1	Date: 08.05.12
Designed by: FCG	Checked by: JAS	Approved by: AC

File Ref: J:\000001\08 - HILLINGDON SCHOOLS - WHITEHALL REDEVELOPMENT\08_ELEVATIONS (1)180614\101210 - REV A31-00010302	Rev: 14.04.24:10.43.31
Drawing No. 611869-A-313	Rev. AB1