

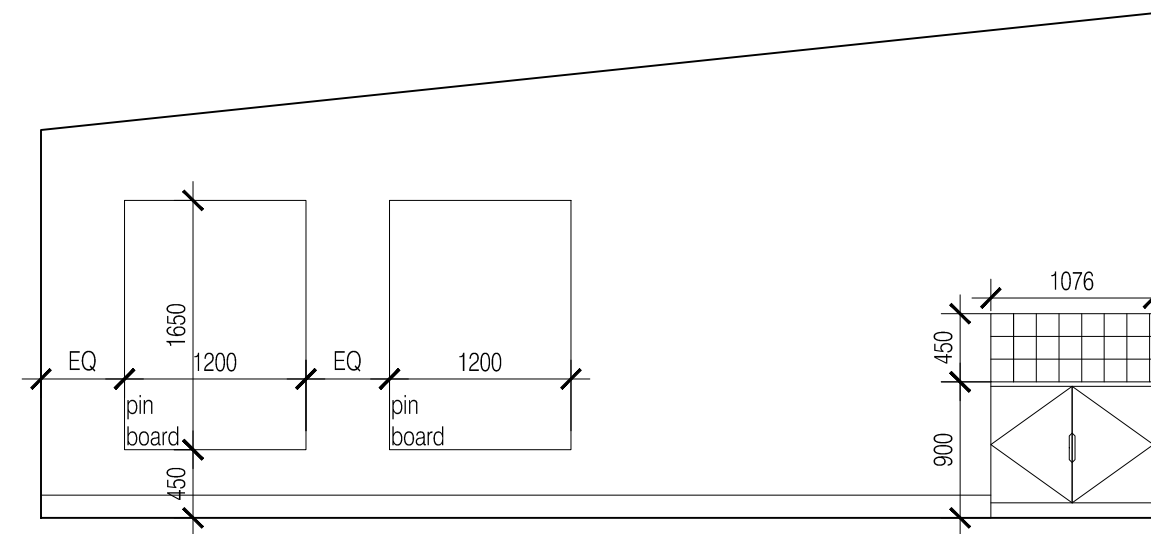



NOTES: Do not scale this drawing. All dimensions to be checked on site prior to commencement or manufacture.

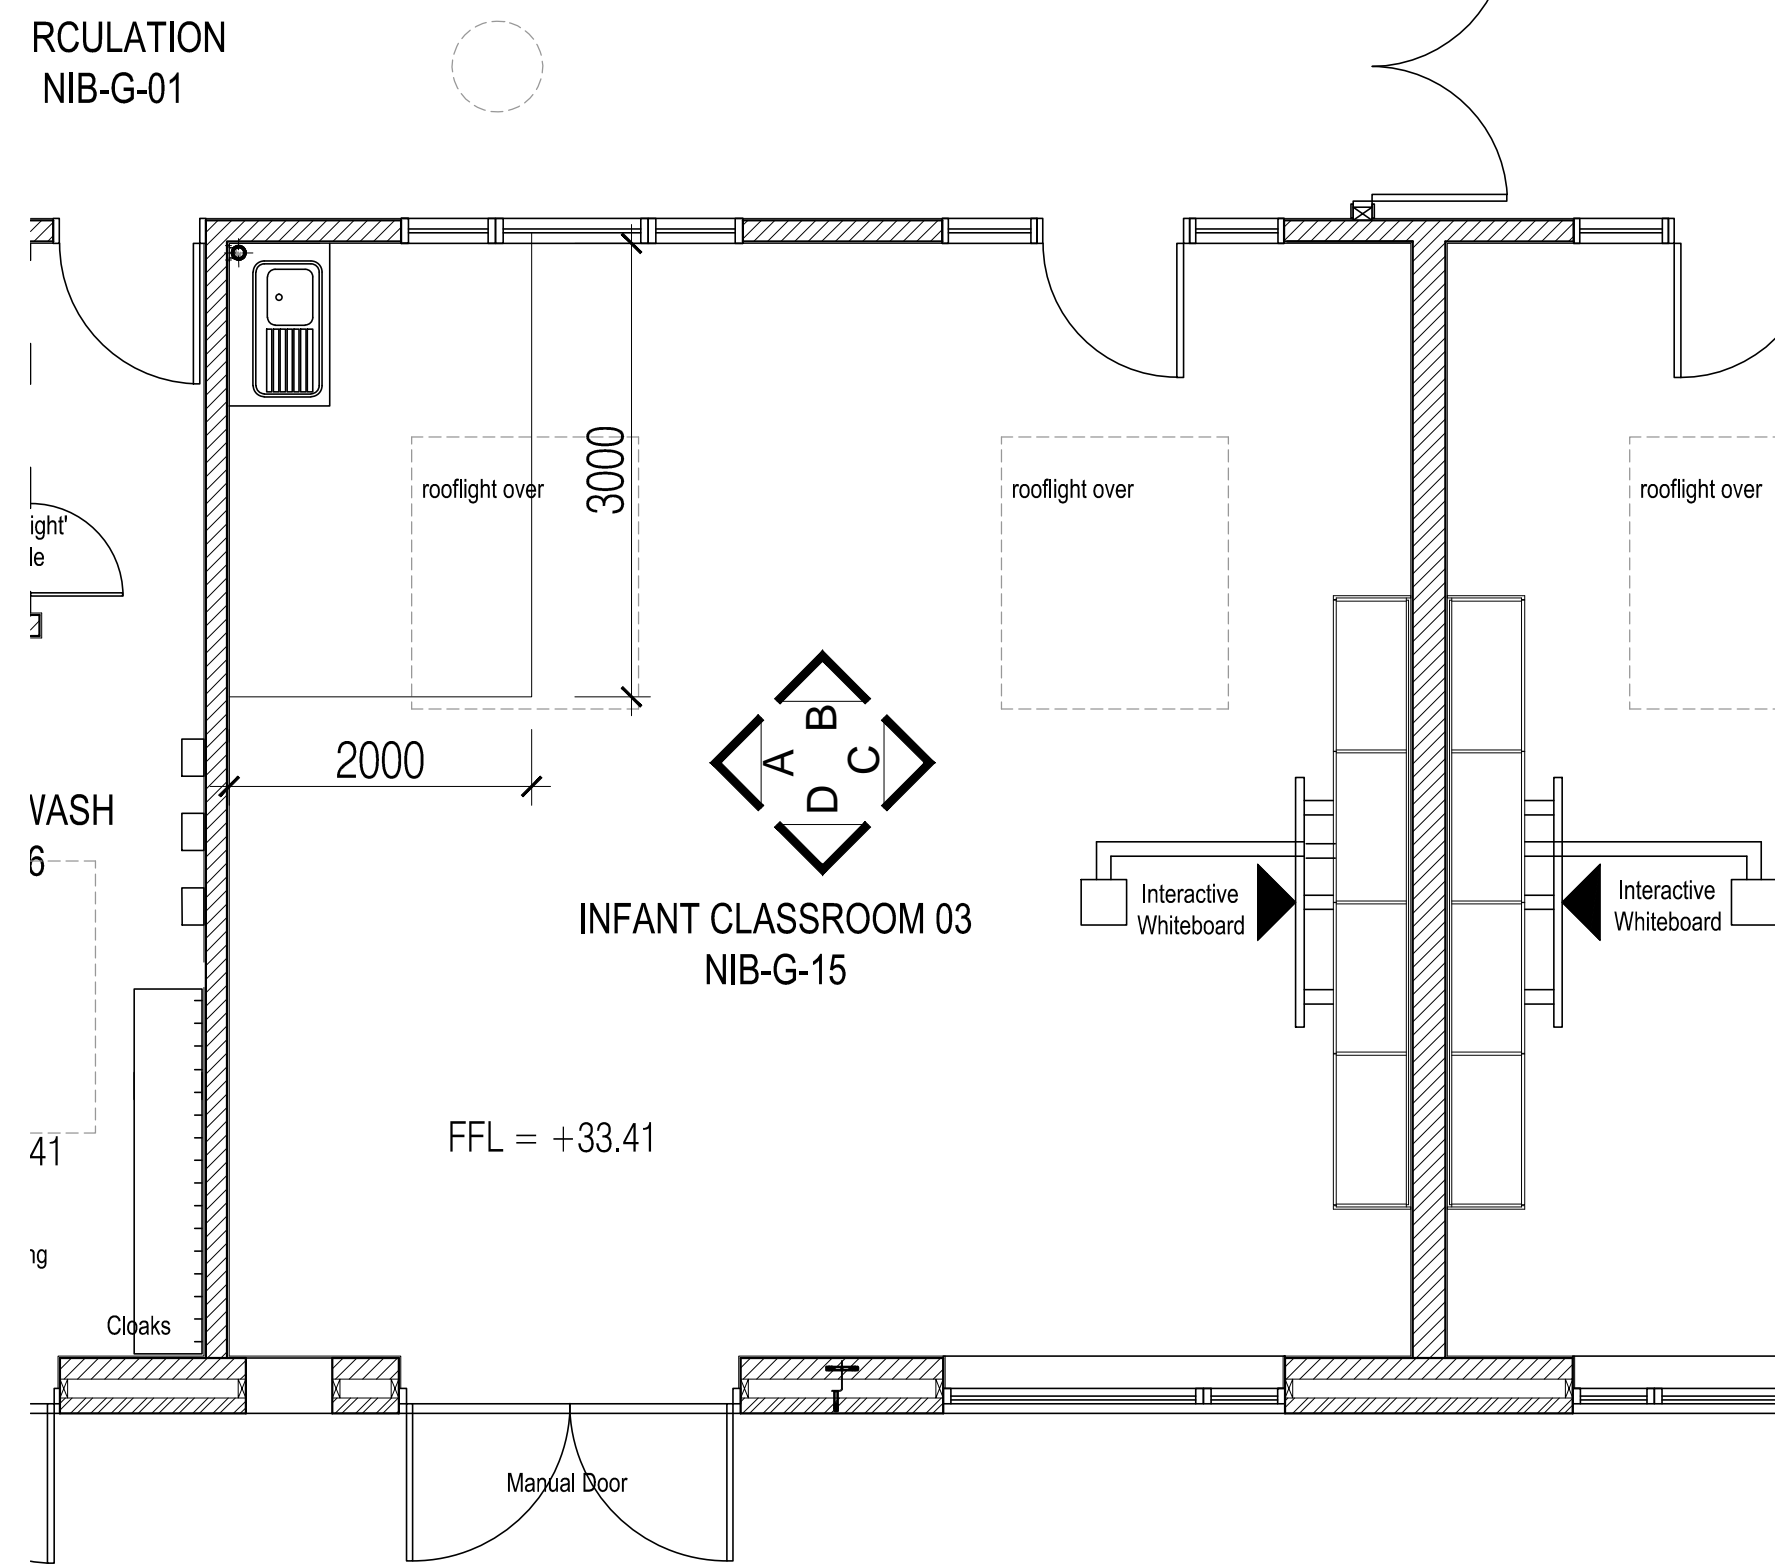


ELEVATION A
NIB-G-15 - INFANT CLASSROOM 03
NIB-G-14 - INFANT CLASSROOM 02 (HANDED)

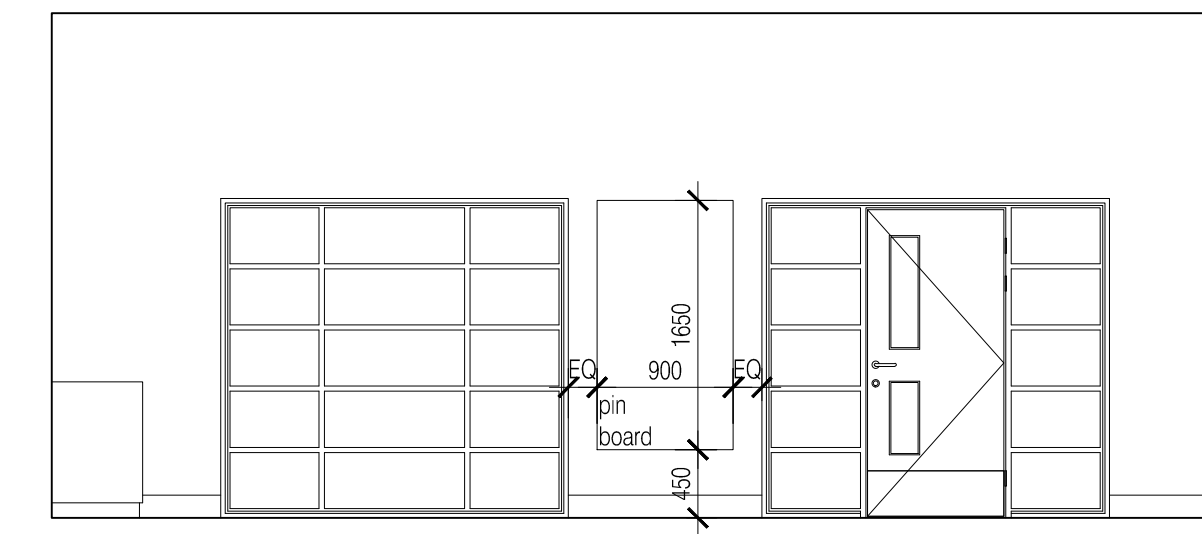

ELEVATION B
NIB-G-15 - INFANT CLASSROOM 03
NIB-G-14 - INFANT CLASSROOM 02 (HANDED)

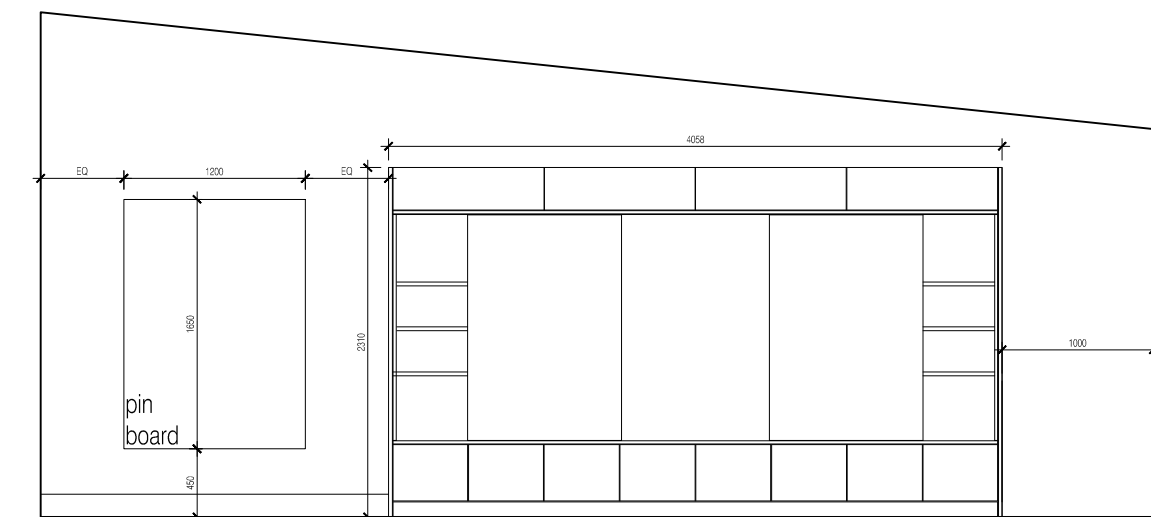

ELEVATION C
NIB-G-15 - INFANT CLASSROOM 03
NIB-G-14 - INFANT CLASSROOM 02 (HANDED)

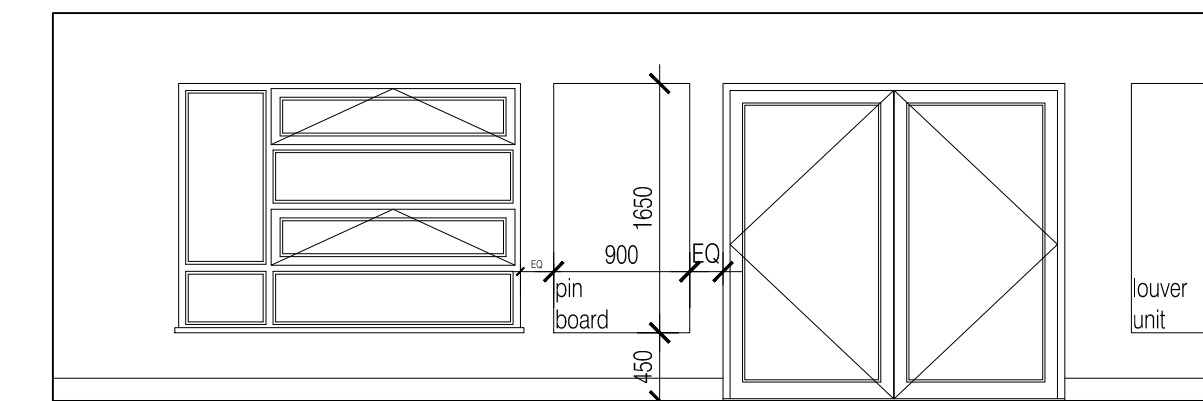

ELEVATION D
NIB-G-15 - INFANT CLASSROOM 03
NIB-G-14 - INFANT CLASSROOM 02 (HANDED)

AS BUILT
DRAWING

Rev	Date	By	Clk	Comment
AB1	17.04.14	FKC	AGC	DRAWING ISSUED - AS BUILT

25 YEARS OF BRINGING IDEAS TO LIFE

FRANKHAM

Frankham Consultancy Group Limited
 Frankham House Woolton Business Park
 Besselsleigh Road Woolton Abingdon
 Oxfordshire OX13 6FD
 T 01865 322500 F 01865 327393
 E enquiries@frankham.com www.frankham.com

Client
Leadbitter
CONSTRUCTION

Project Title
Whitehall Junior & Infant School
Refurbishment, Extension and New Build
Cowley Road
London Borough of Hillingdon

Drawing Title
New Infants Block
Proposed Room Elevations
Classrooms 3 + 2 (Handed)

Drawn by: FKC	Scale: 1:50@A1	Date: 05.04.12
Designed by: FCG	Checked by: JAS	Approved by: AGC

File Ref: J:\00004188 - HILLINGDON SCHOOLS - WHITEHALL JUNIOR & INFANT SCHOOL - 14.04.2012\10.44.40	Drawing No. 611869-A-341	Rev. AB1
--	-----------------------------	-------------