

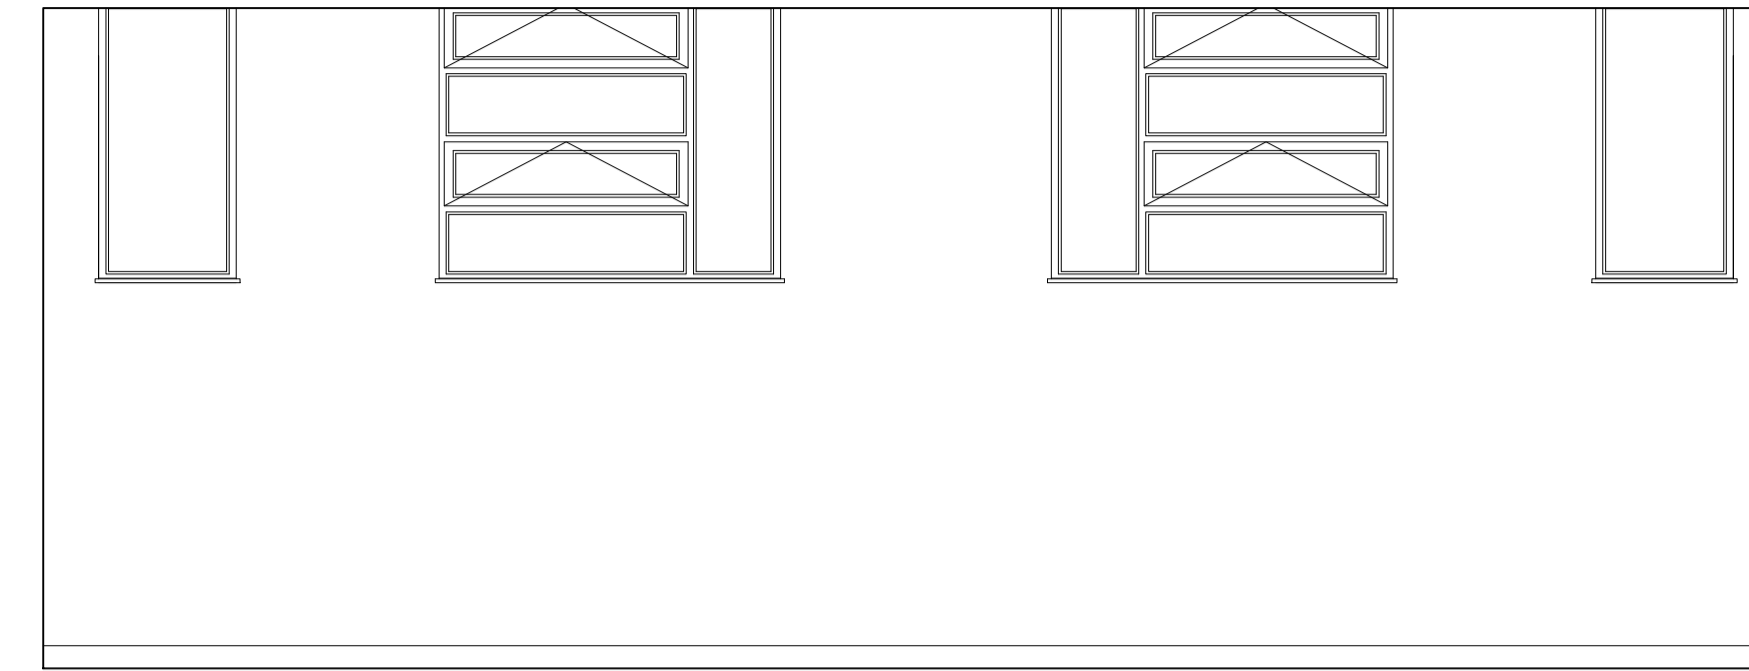



NOTES: Do not scale this drawing. All dimensions to be checked on site prior to commencement or manufacture.

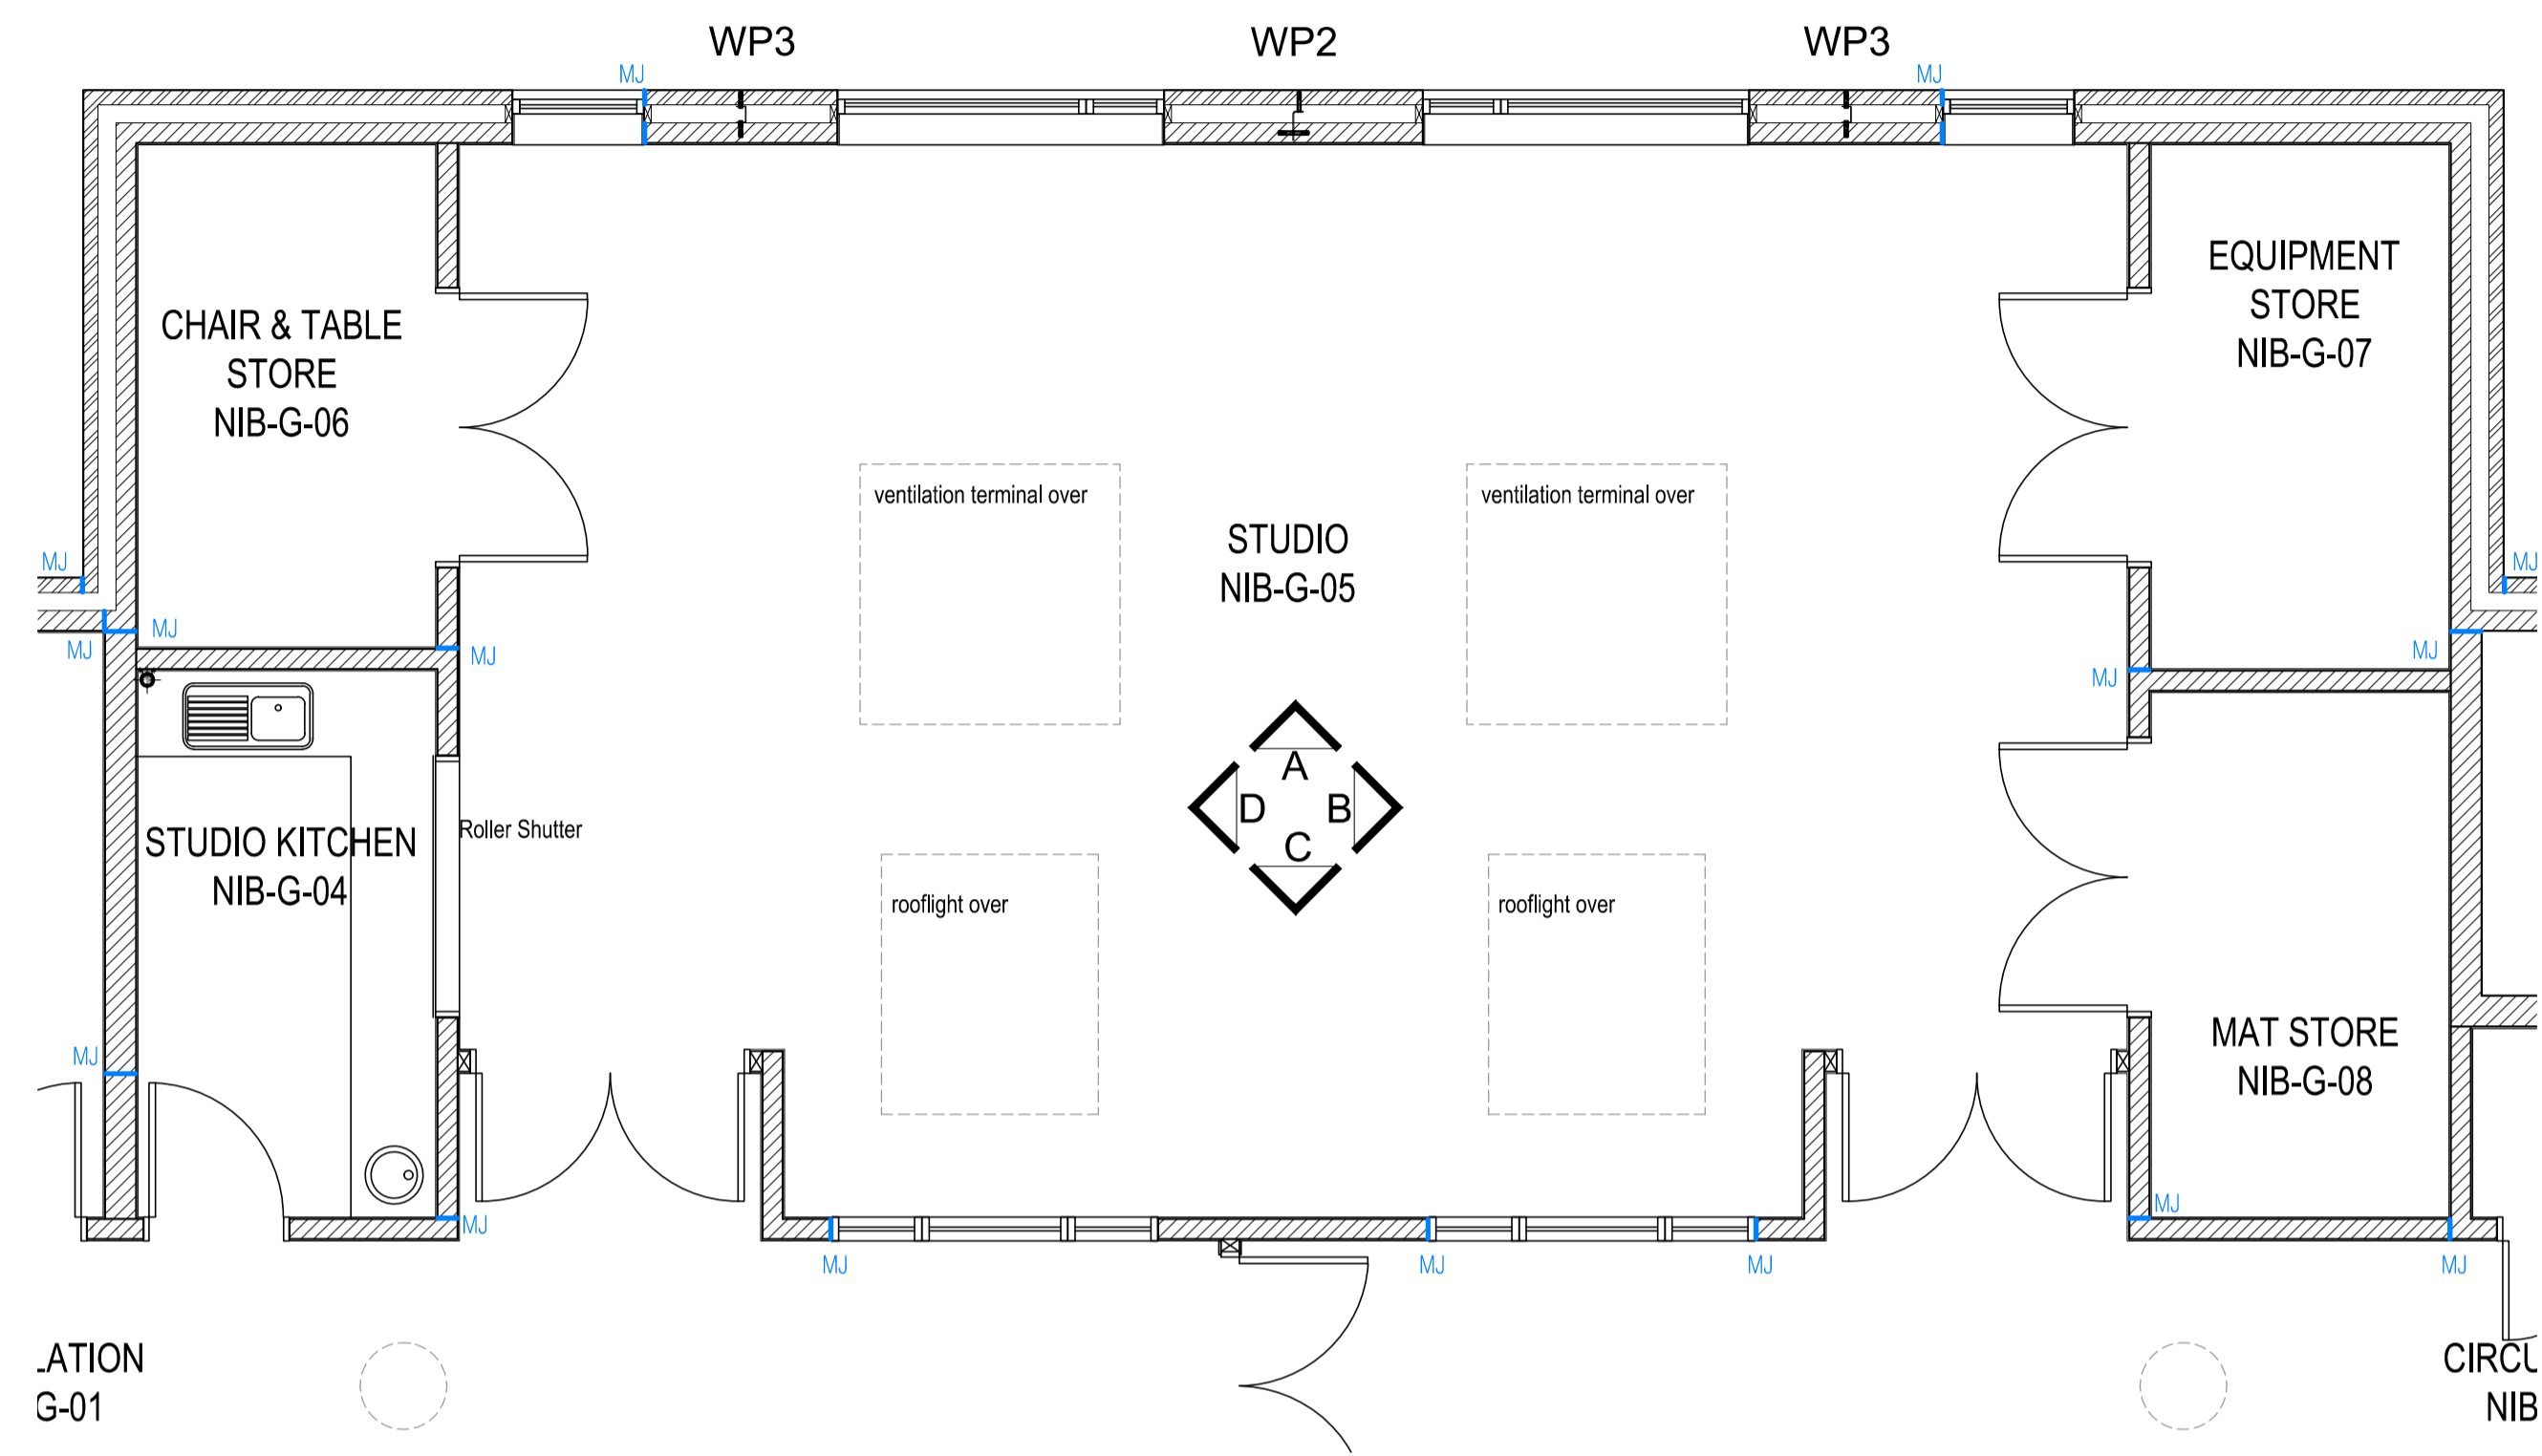


ELEVATION A
NIB-G-05 - STUDIO

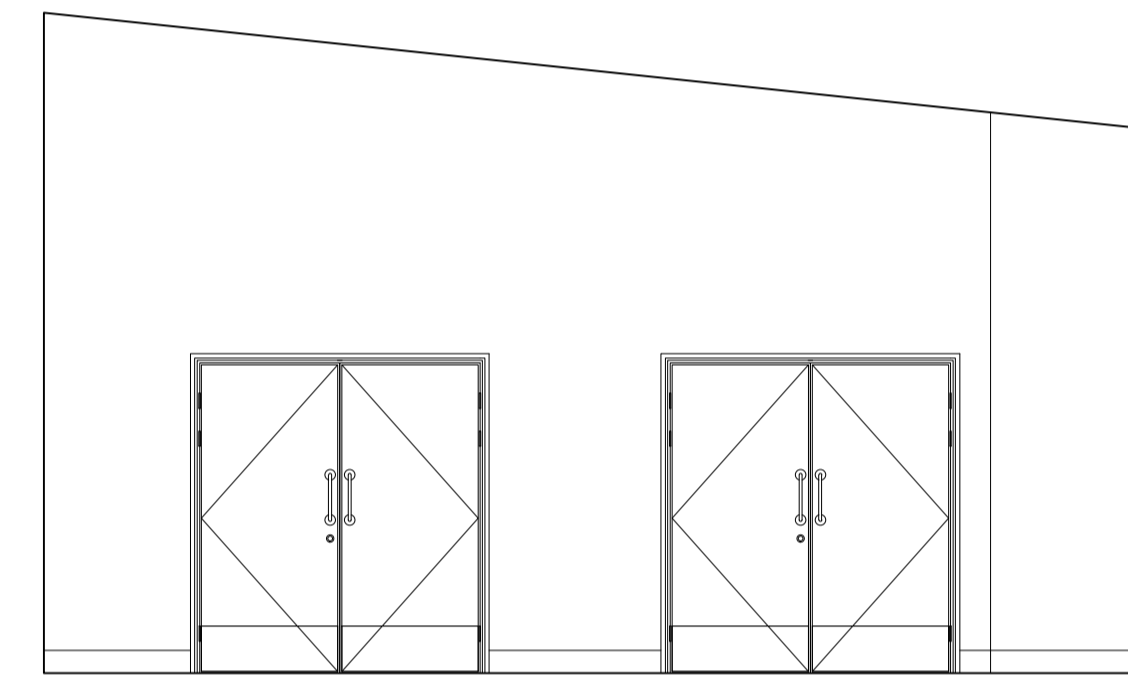

ELEVATION B
NIB-G-05 - STUDIO

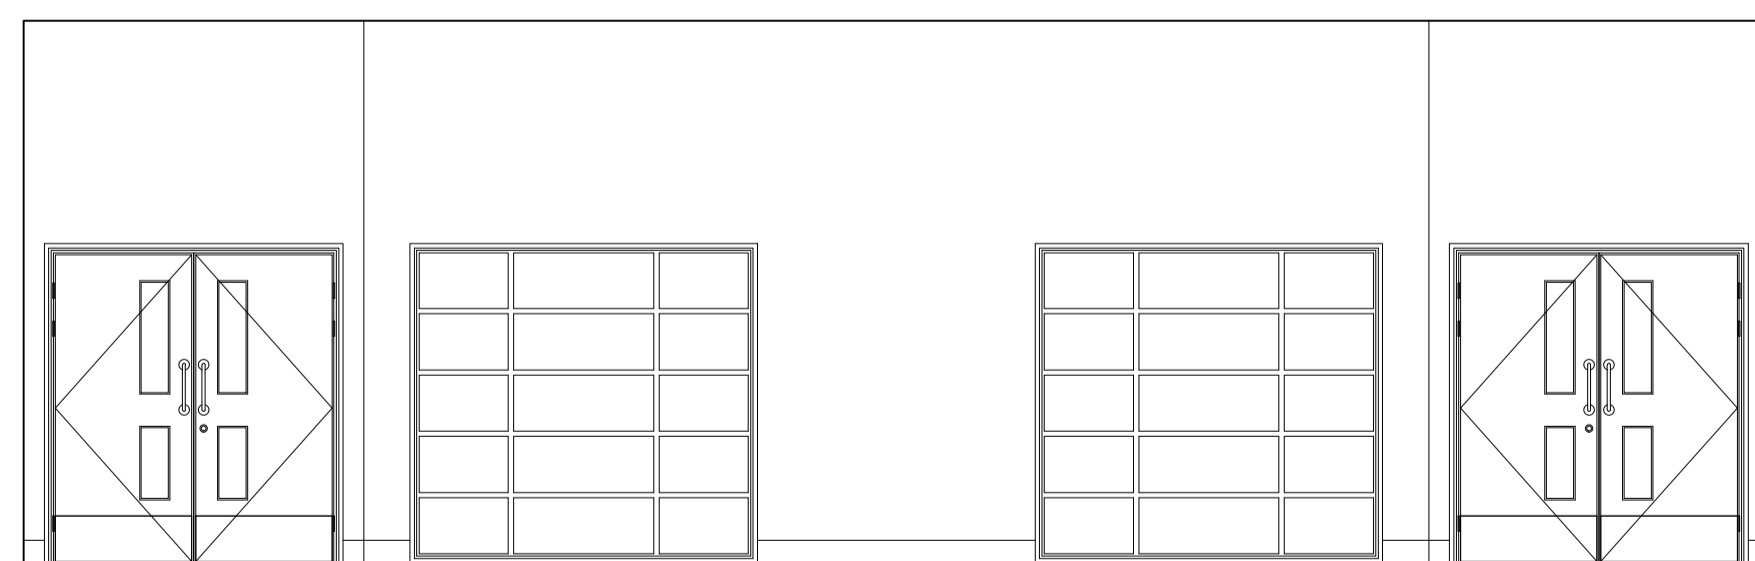

ELEVATION C
NIB-G-05 - STUDIO

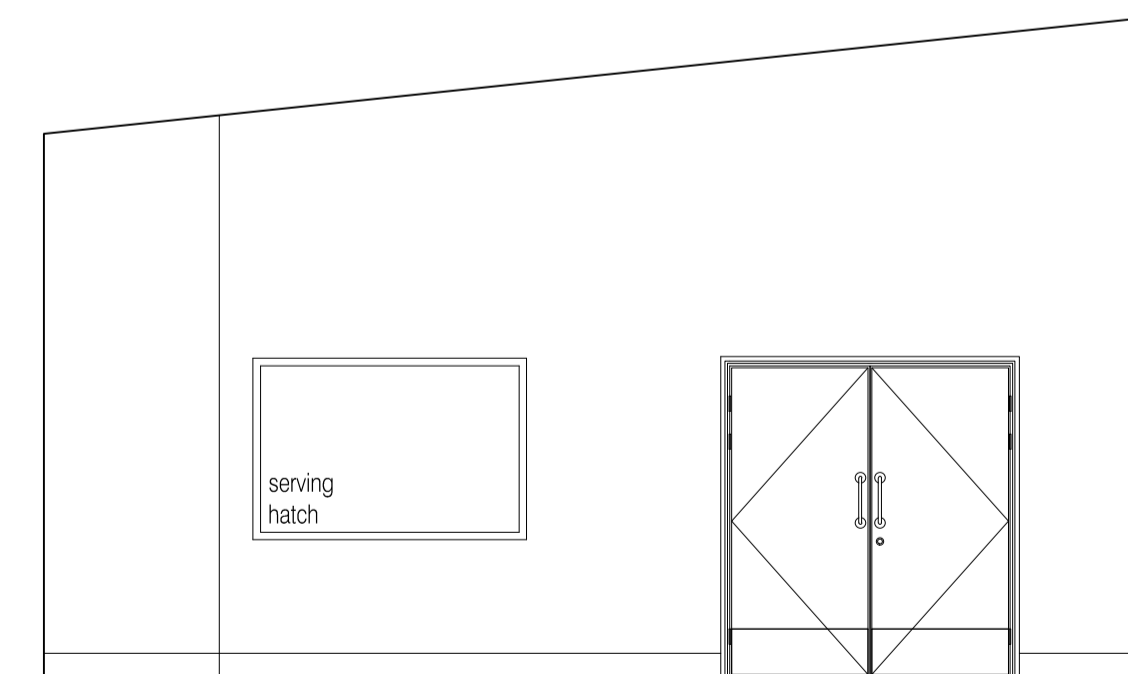

ELEVATION D
NIB-G-05 - STUDIO

AS BUILT
DRAWING

| Rev | Date | By | Clk | Comment |
|-----|----------|-----|-----|---------------------------|
| AB1 | 17.04.14 | RKC | AGC | DRAWING ISSUED - AS BUILT |

25 YEARS OF BRINGING IDEAS TO LIFE

FRANKHAM

Frankham Consultancy Group Limited
 Frankham House Woolton Business Park
 Besselsleigh Road Woolton Abingdon
 Oxfordshire OX13 6FD
 T 01865 322500 F 01865 327393
 E enquiries@frankham.com www.frankham.com

Client
Leadbitter
 CONSTRUCTION

Project Title
 Whitehall Junior & Infant School
 Refurbishment, Extension and New Build
 Cowley Road
 London Borough of Hillingdon

Drawing Title
 New Infants Block
 Proposed Room Elevations
 Studio

| | | |
|---------------------|--------------------|---------------------|
| Drawn by: RKC | Scale: 1:50@A1 | Date: 27.07.12 |
| Designed by: FCG | Checked by: JAS | Approved by: AGC |

| | |
|--|-------------|
| File Ref: J:\000001186-18612001-SCHOOL-11-NEW-ALL-REDESIGN-01-01-12\01186-18612001-REV-01-12\01186-18612001-REV-01-12.dwg | Rev. AB1 |
|--|-------------|

Drawing No.
611869-A-343