




NOTES: Do not scale this drawing. All dimensions to be checked on site prior to commencement or manufacture.

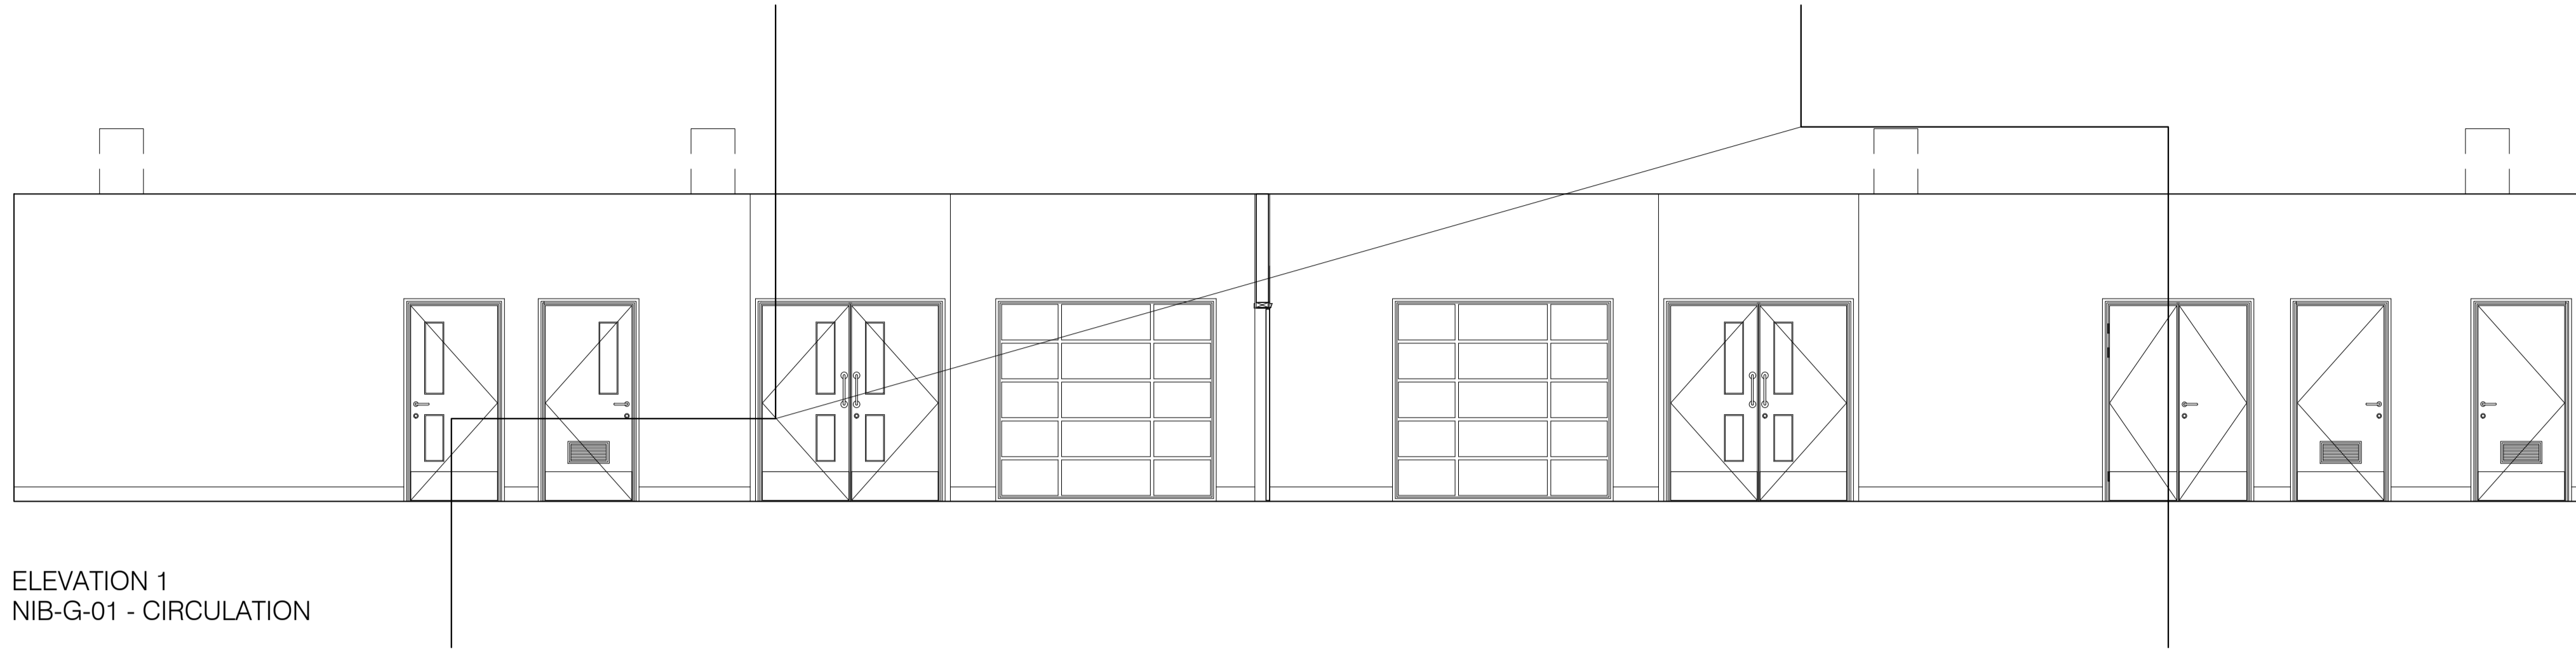


ELEVATION 1
NIB-G-01 - CIRCULATION

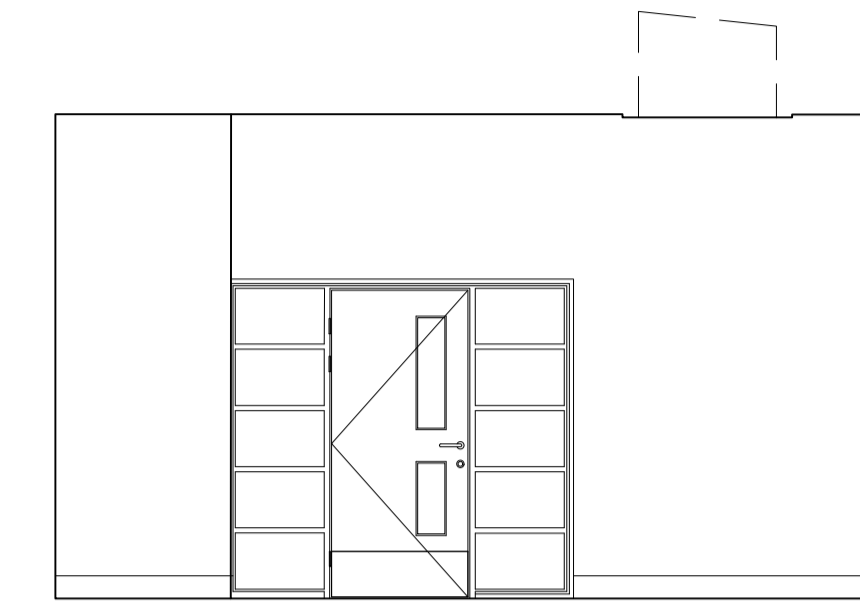


ELEVATION 2
NIB-G-01 - CIRCULATION

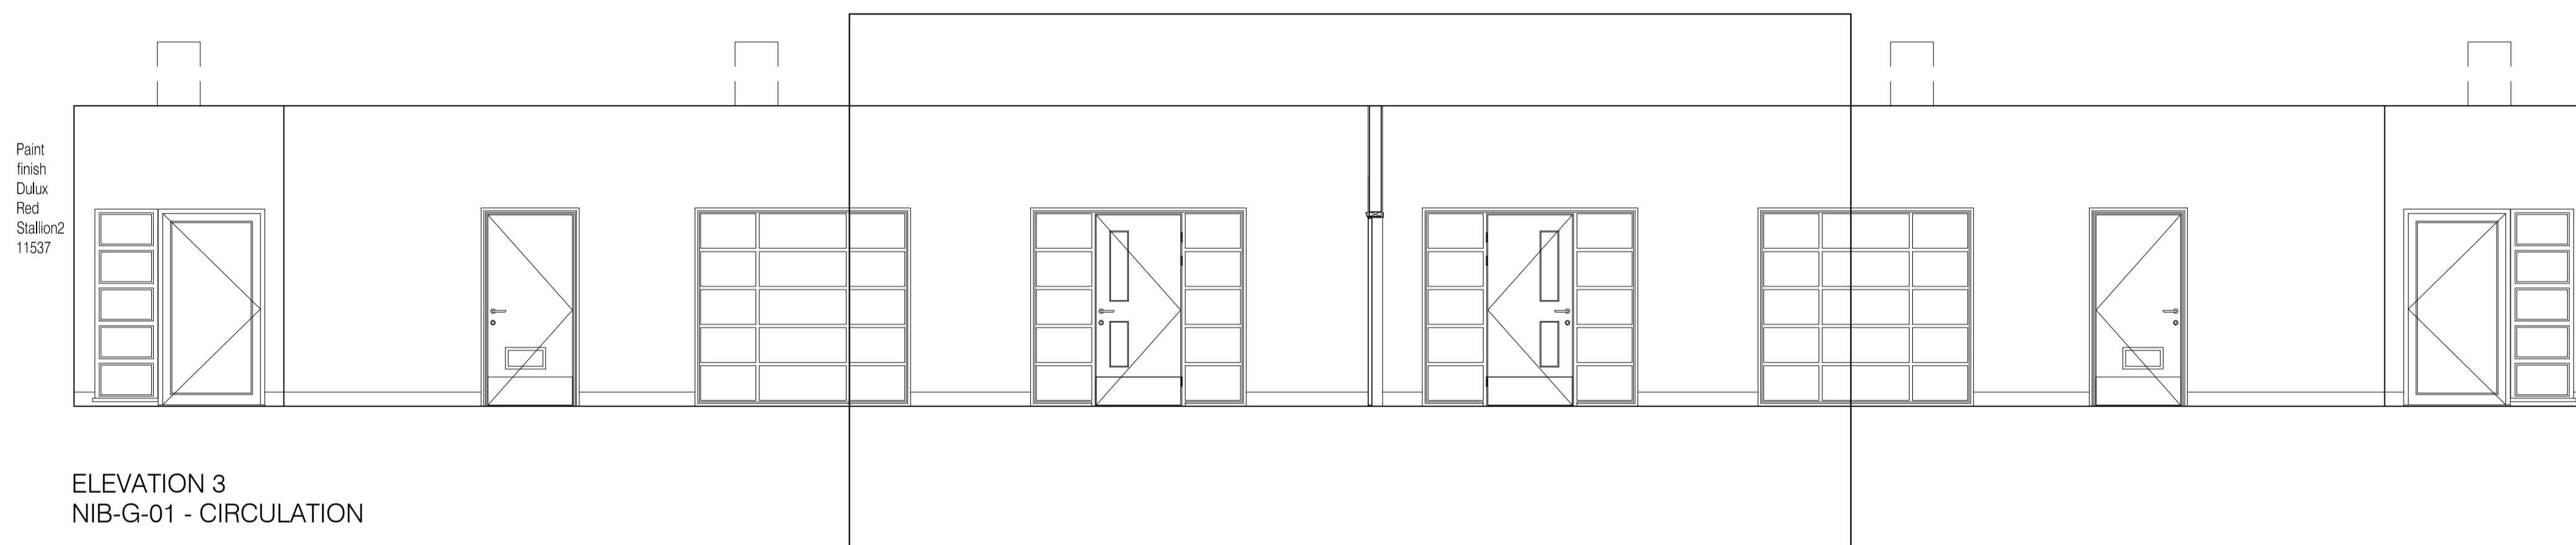

ELEVATION 3
NIB-G-01 - CIRCULATION

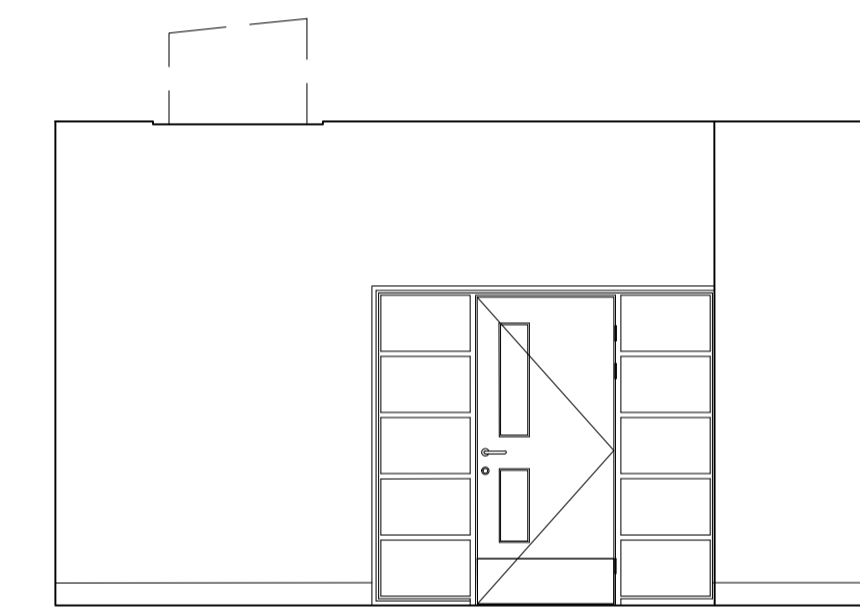

ELEVATION 4
NIB-G-01 - CIRCULATION

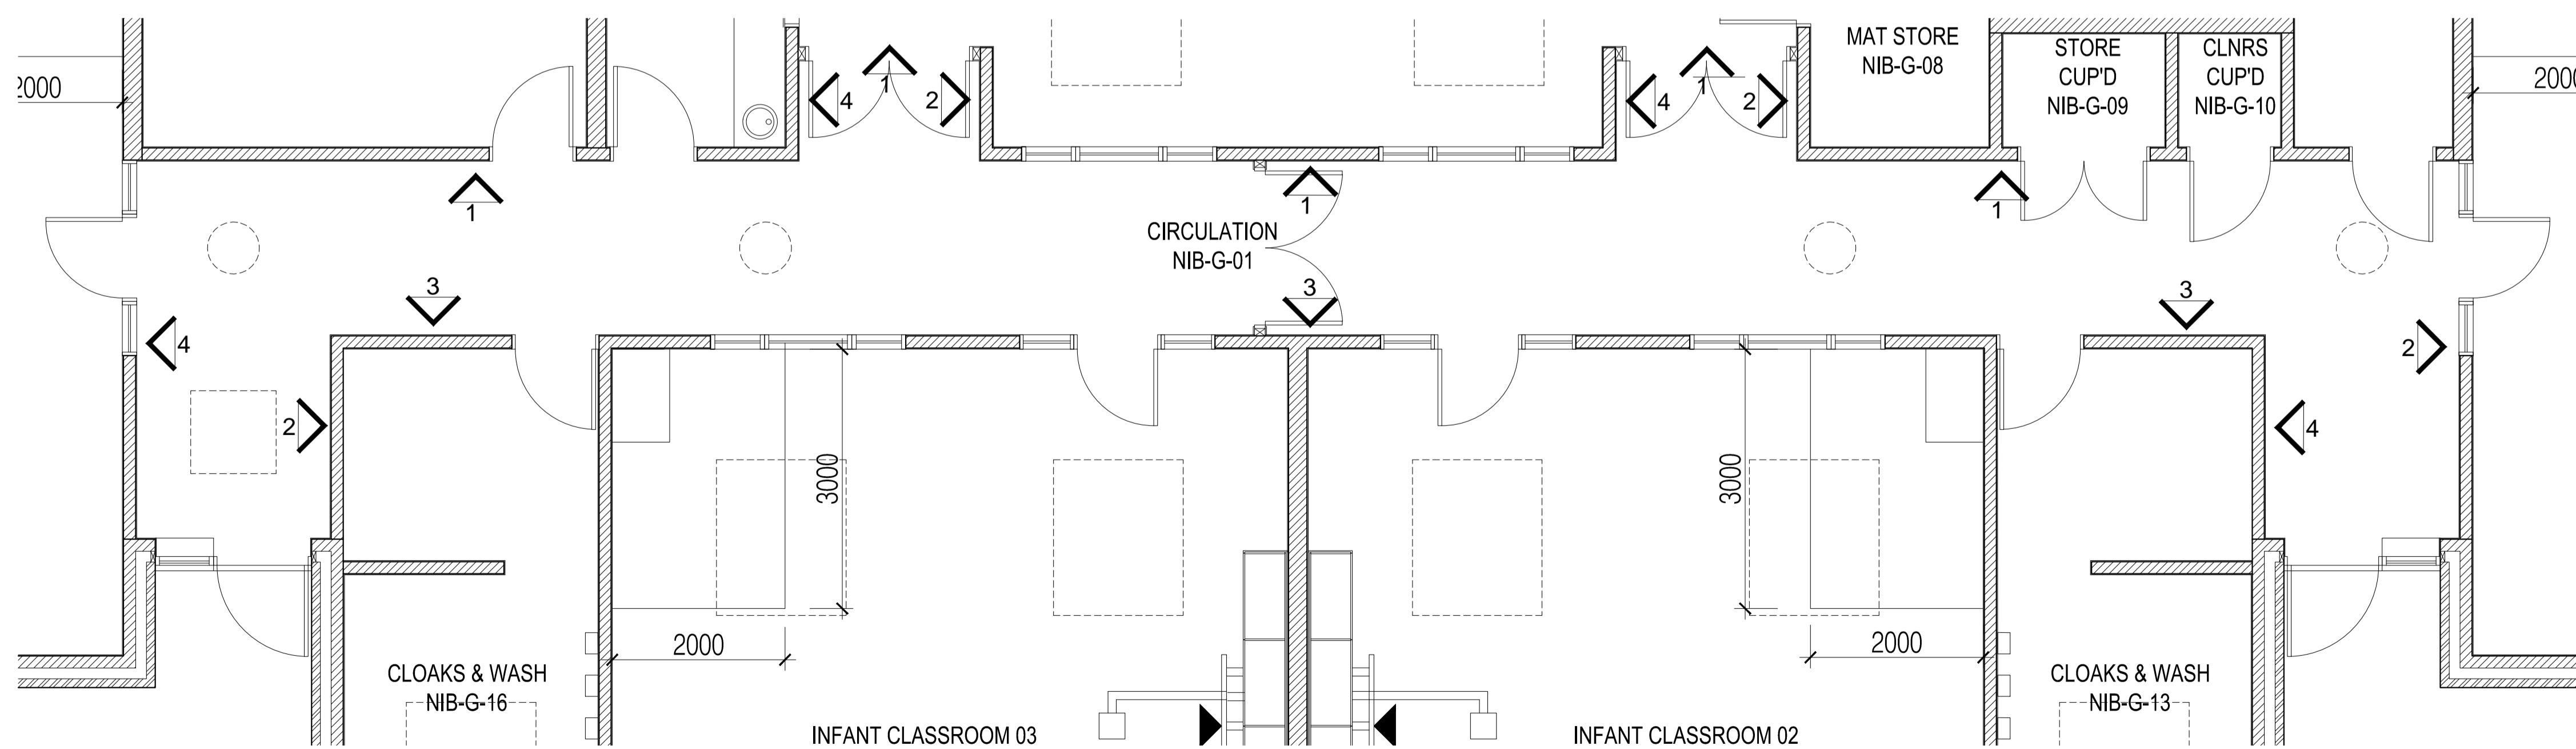

AS BUILT
DRAWING

Rev	Date	By	Clk	Comment
AB1	17.04.14	RKC	AGC	DRAWING ISSUED - AS BUILT

25 YEARS OF BRINGING IDEAS TO LIFE

FRANKHAM

Frankham Consultancy Group Limited
 Frankham House Woolton Business Park
 Besselsleigh Road Woolton Abingdon
 Oxfordshire OX13 6FD
 T 01865 322500 F 01865 327393
 E enquiry@frankham.com www.frankham.com

ANNIVERSARY 25 YEARS 1982-2007

Client: **Leadbitter**
CONSTRUCTION

Project Title: Whitehall Junior & Infant School
 Refurbishment, Extension and New Build
 Cowley Road
 London Borough of Hillingdon

Drawing Title: New Infants Block
 Proposed Room Elevations
 Circulation

Drawn by: RKC	Scale: 1:50@A1	Date: 15.04.13
Designed by: FCG	Checked by: JAS	Approved by: AGC

File Ref: J:\000001\NIB - HILLINGDON SCHOOL - INFANTS BLOCK\2013\04\13\15.04.13\15.04.13.10.45.29	Drawing No. 611869-A-347	Rev. AB1
--	-----------------------------	-------------