




01 Floor Plan  
Scale: 1:20

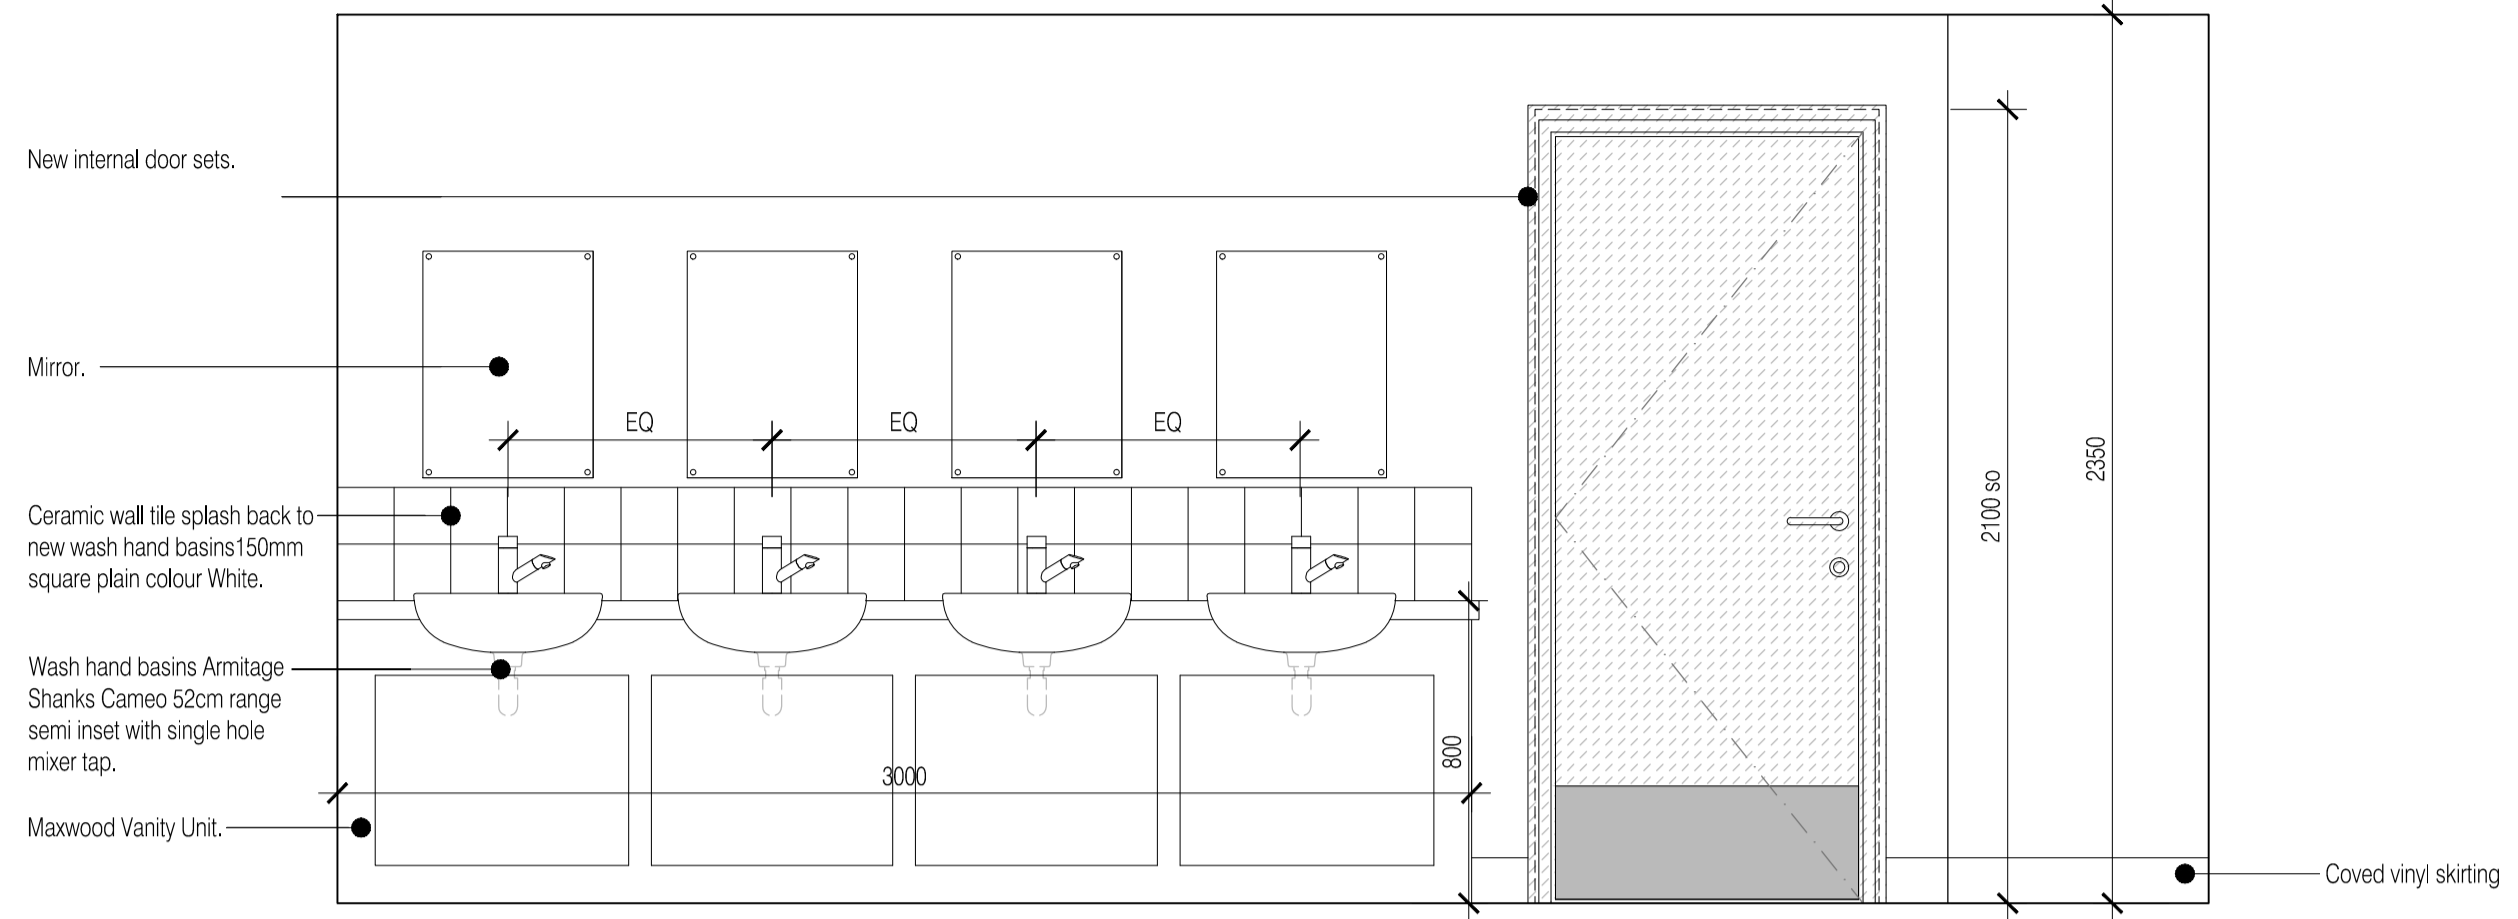


02 Elevation 01  
Scale: 1:20

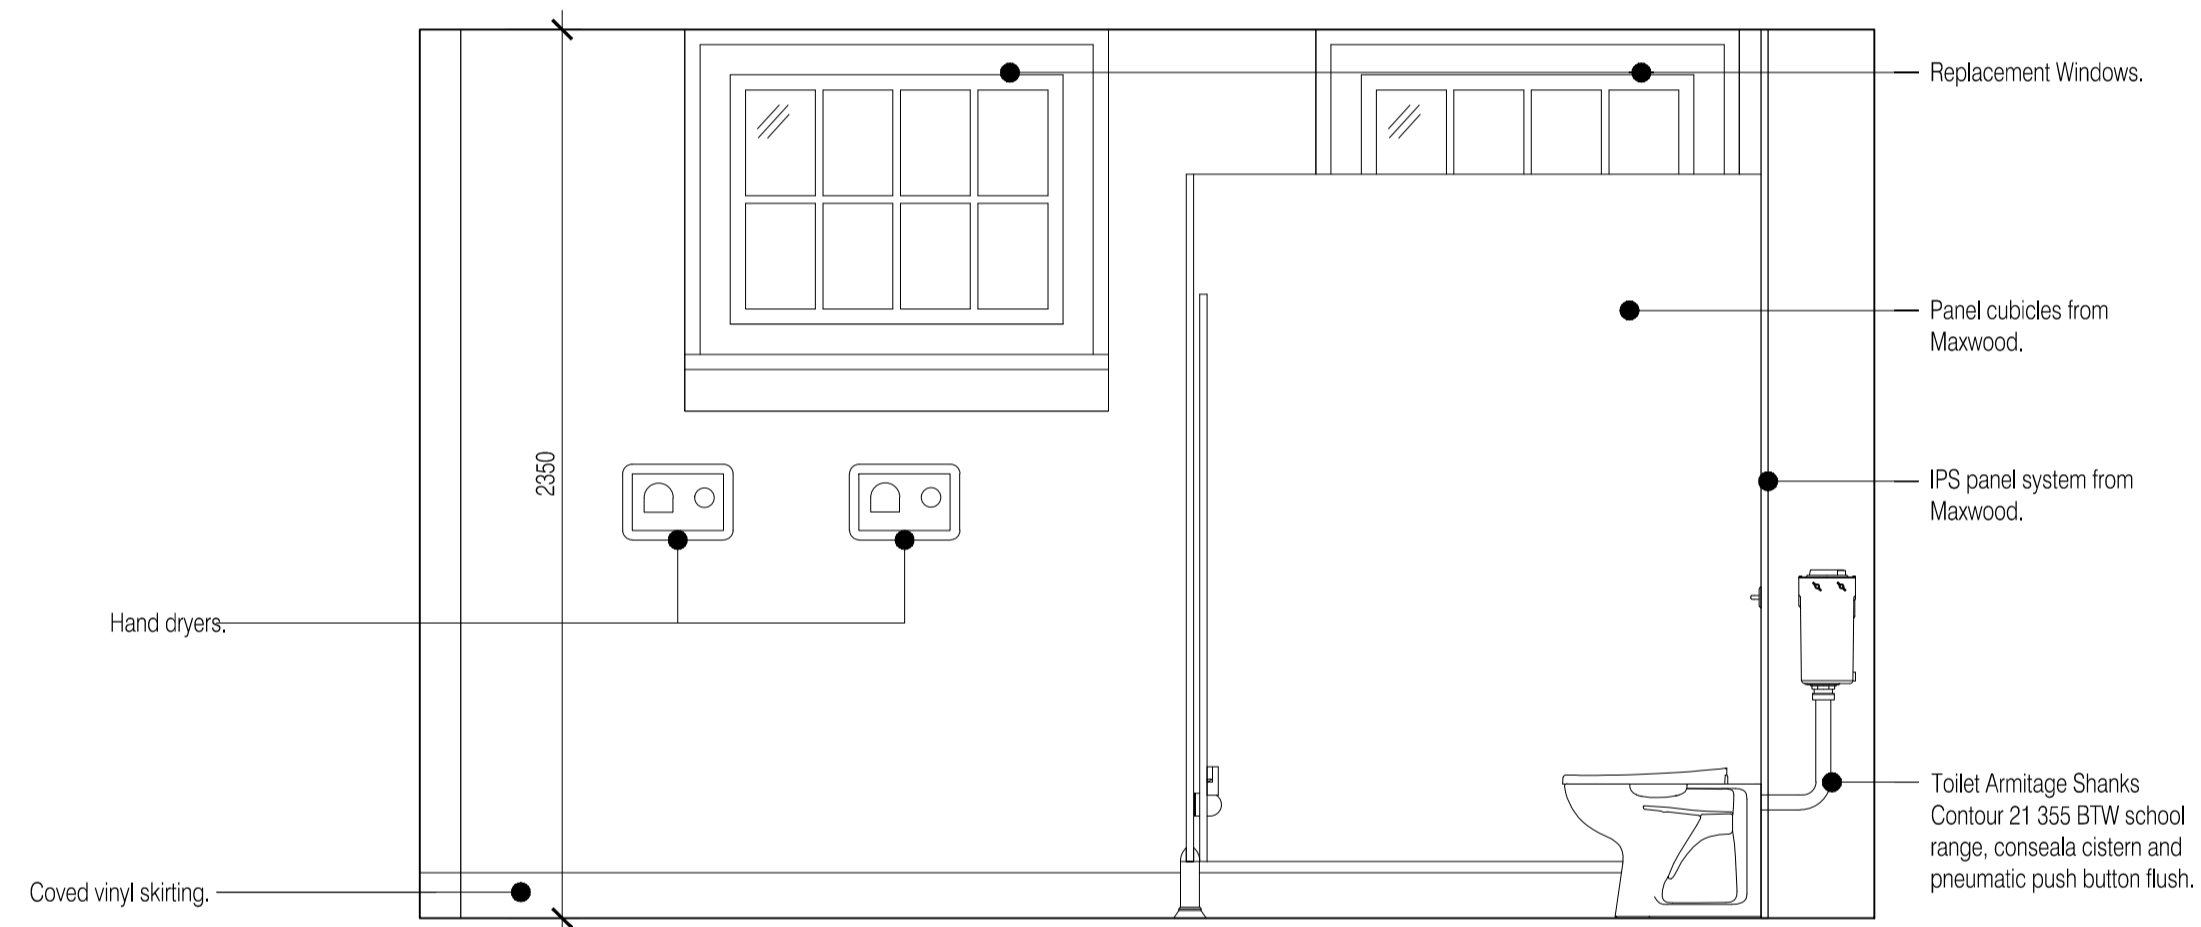

03 Elevation 02  
Scale: 1:20

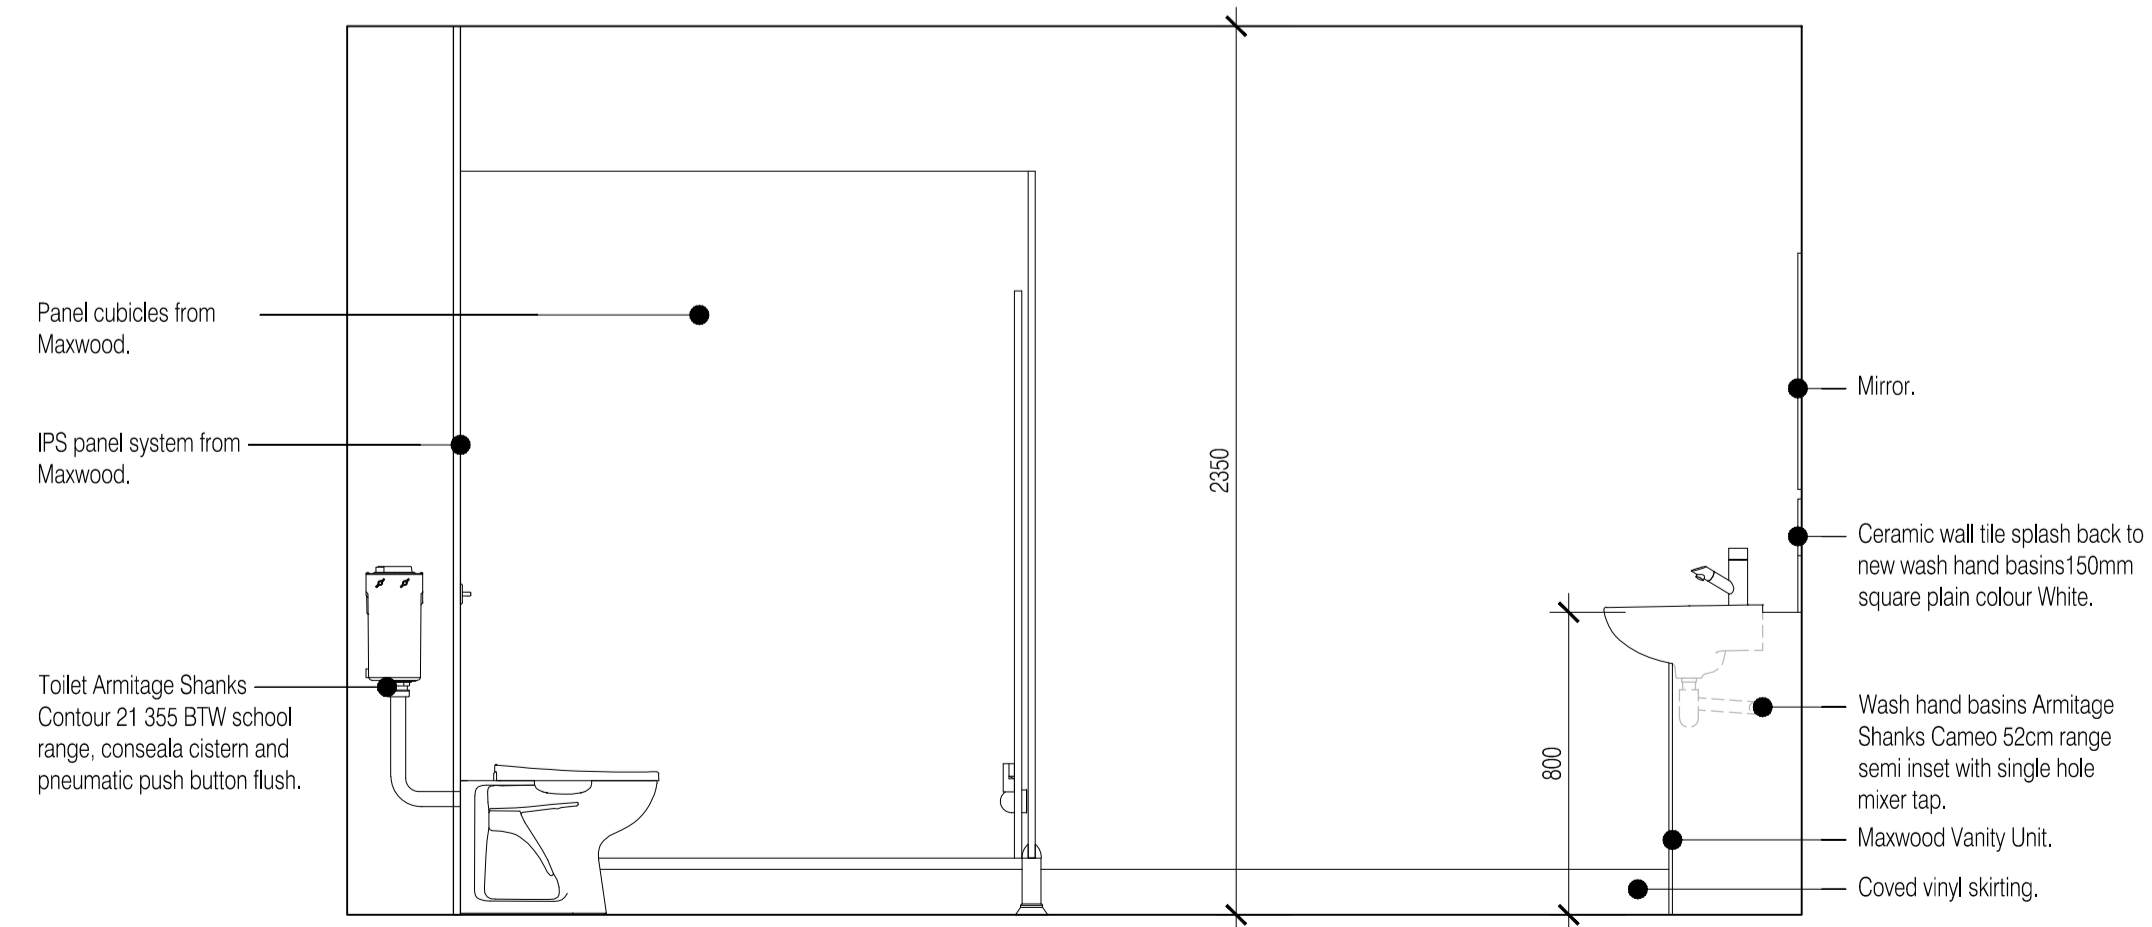

05 Elevation 04  
Scale: 1:20

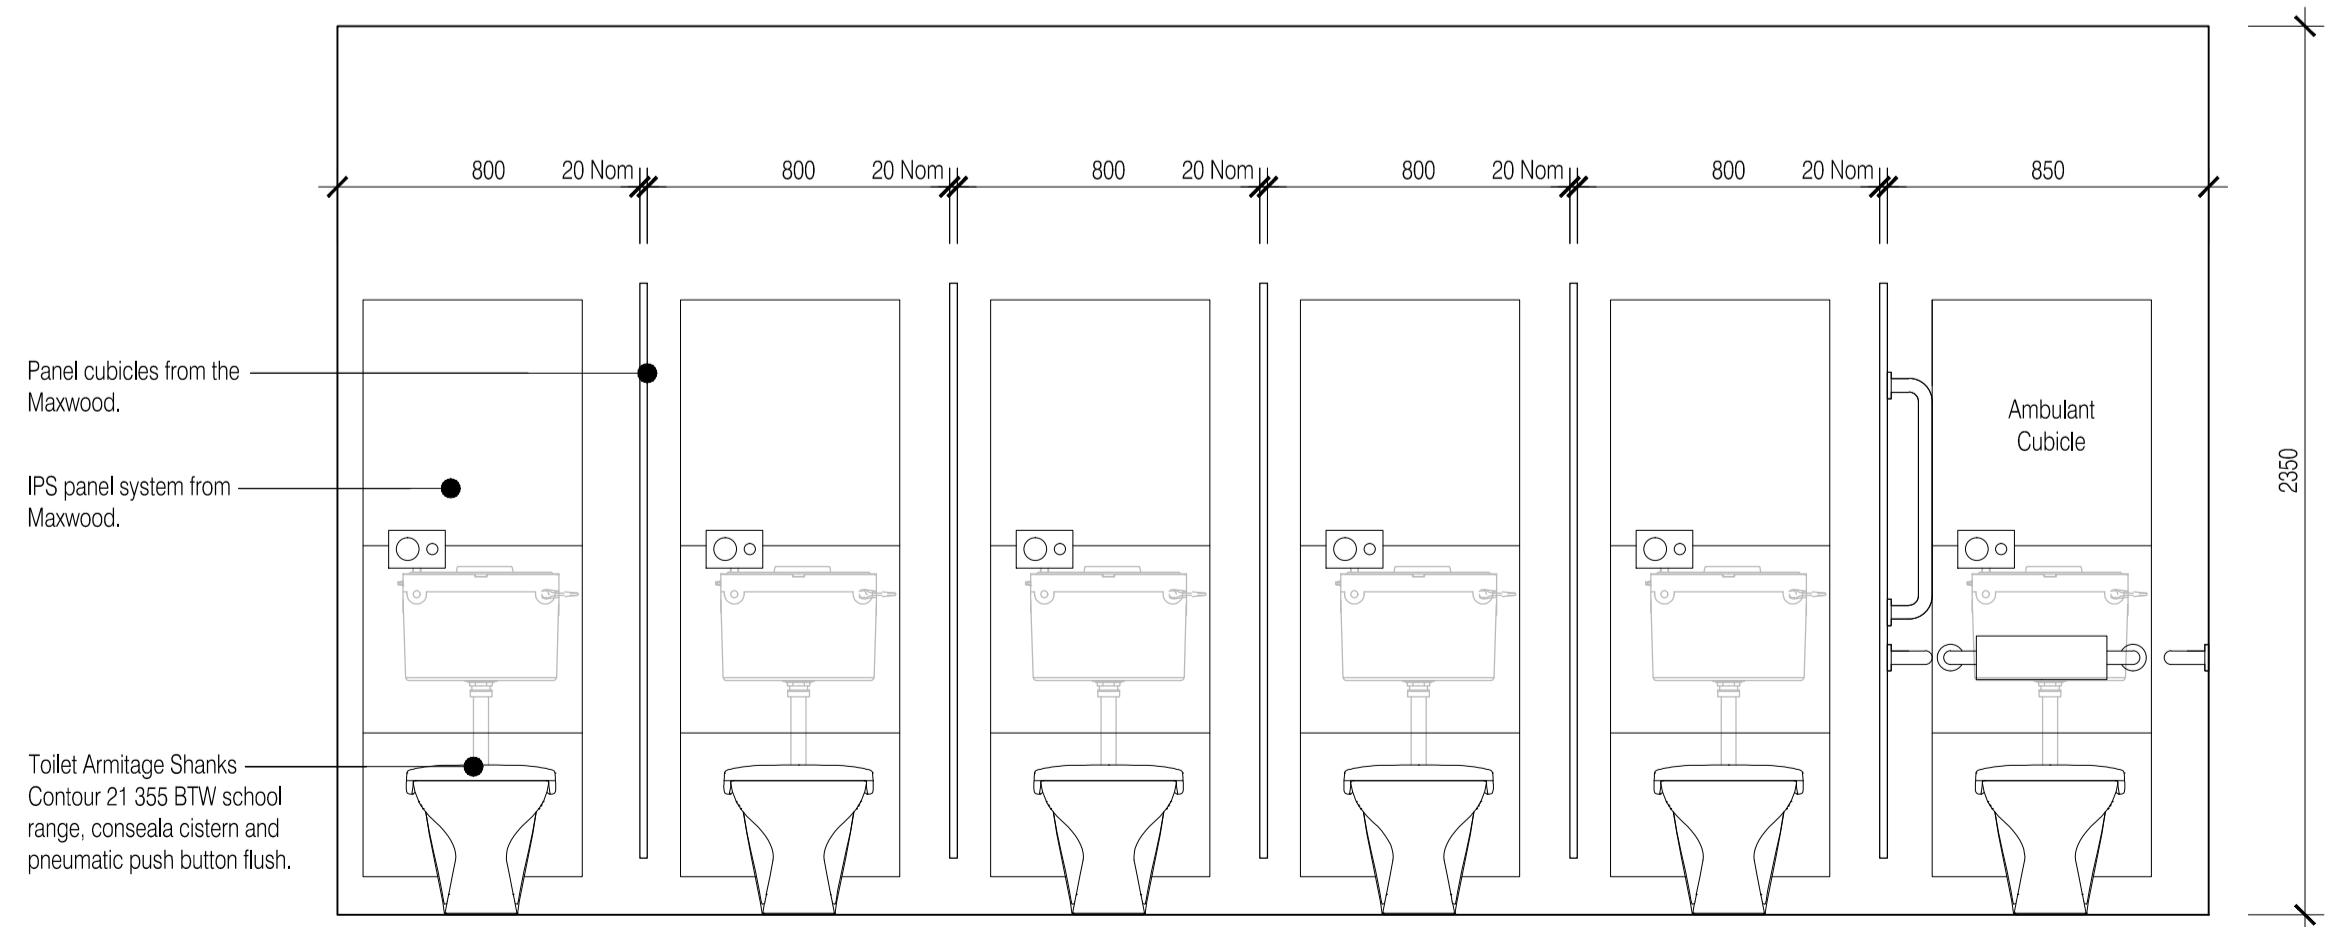

04 Elevation 03  
Scale: 1:20

NOTES: Do not scale this drawing. All dimensions to be checked on site prior to commencement or manufacture.  
NB: All information based on supplied third party survey information. All discrepancies to be reported to FCG immediately upon discovery.

AS BUILT DRAWING

Rev	Date	By	Clk	Comment
AB1	17.04.14	FRK	AGC	DRAWING ISSUED - AS BUILT

25 YEARS OF BRINGING IDEAS TO LIFE

**FRANKHAM**

Frankham Consultancy Group Limited  
 Frankham House Wootton Business Park  
 Besselsleigh Road Wootton Abingdon  
 Oxfordshire OX13 6FD  
 T 01865 322500 F 01865 327393  
 E enquire@frankham.com  
 www.frankham.com

Client: **Leadbitter CONSTRUCTION**

Project Title: Whitehall Junior & Infant School  
 Refurbishment, Extension and New Build  
 Cowley Road  
 London Borough of Hillingdon

Drawing Title: Existing Junior School WC Area  
 Room Elevations - New Pupil Toilets  
 EJB-G-05

Drawn by: FRK	Scale: 1:20@A1	Date: 31.05.12
Designed by: FCG	Checked by: JAS	Approved by: AC
File Ref: 14.04.24.10.45.38		
Drawing No. 611869-A-350	Rev. AB1	