



NOTES: Do not scale this drawing. All dimensions to be checked on site prior to commencement or manufacture.
 NB: All information based on supplied third party survey information. All discrepancies to be reported to FCG immediately upon discovery.


01 Floor Plan
 Scale: 1:50

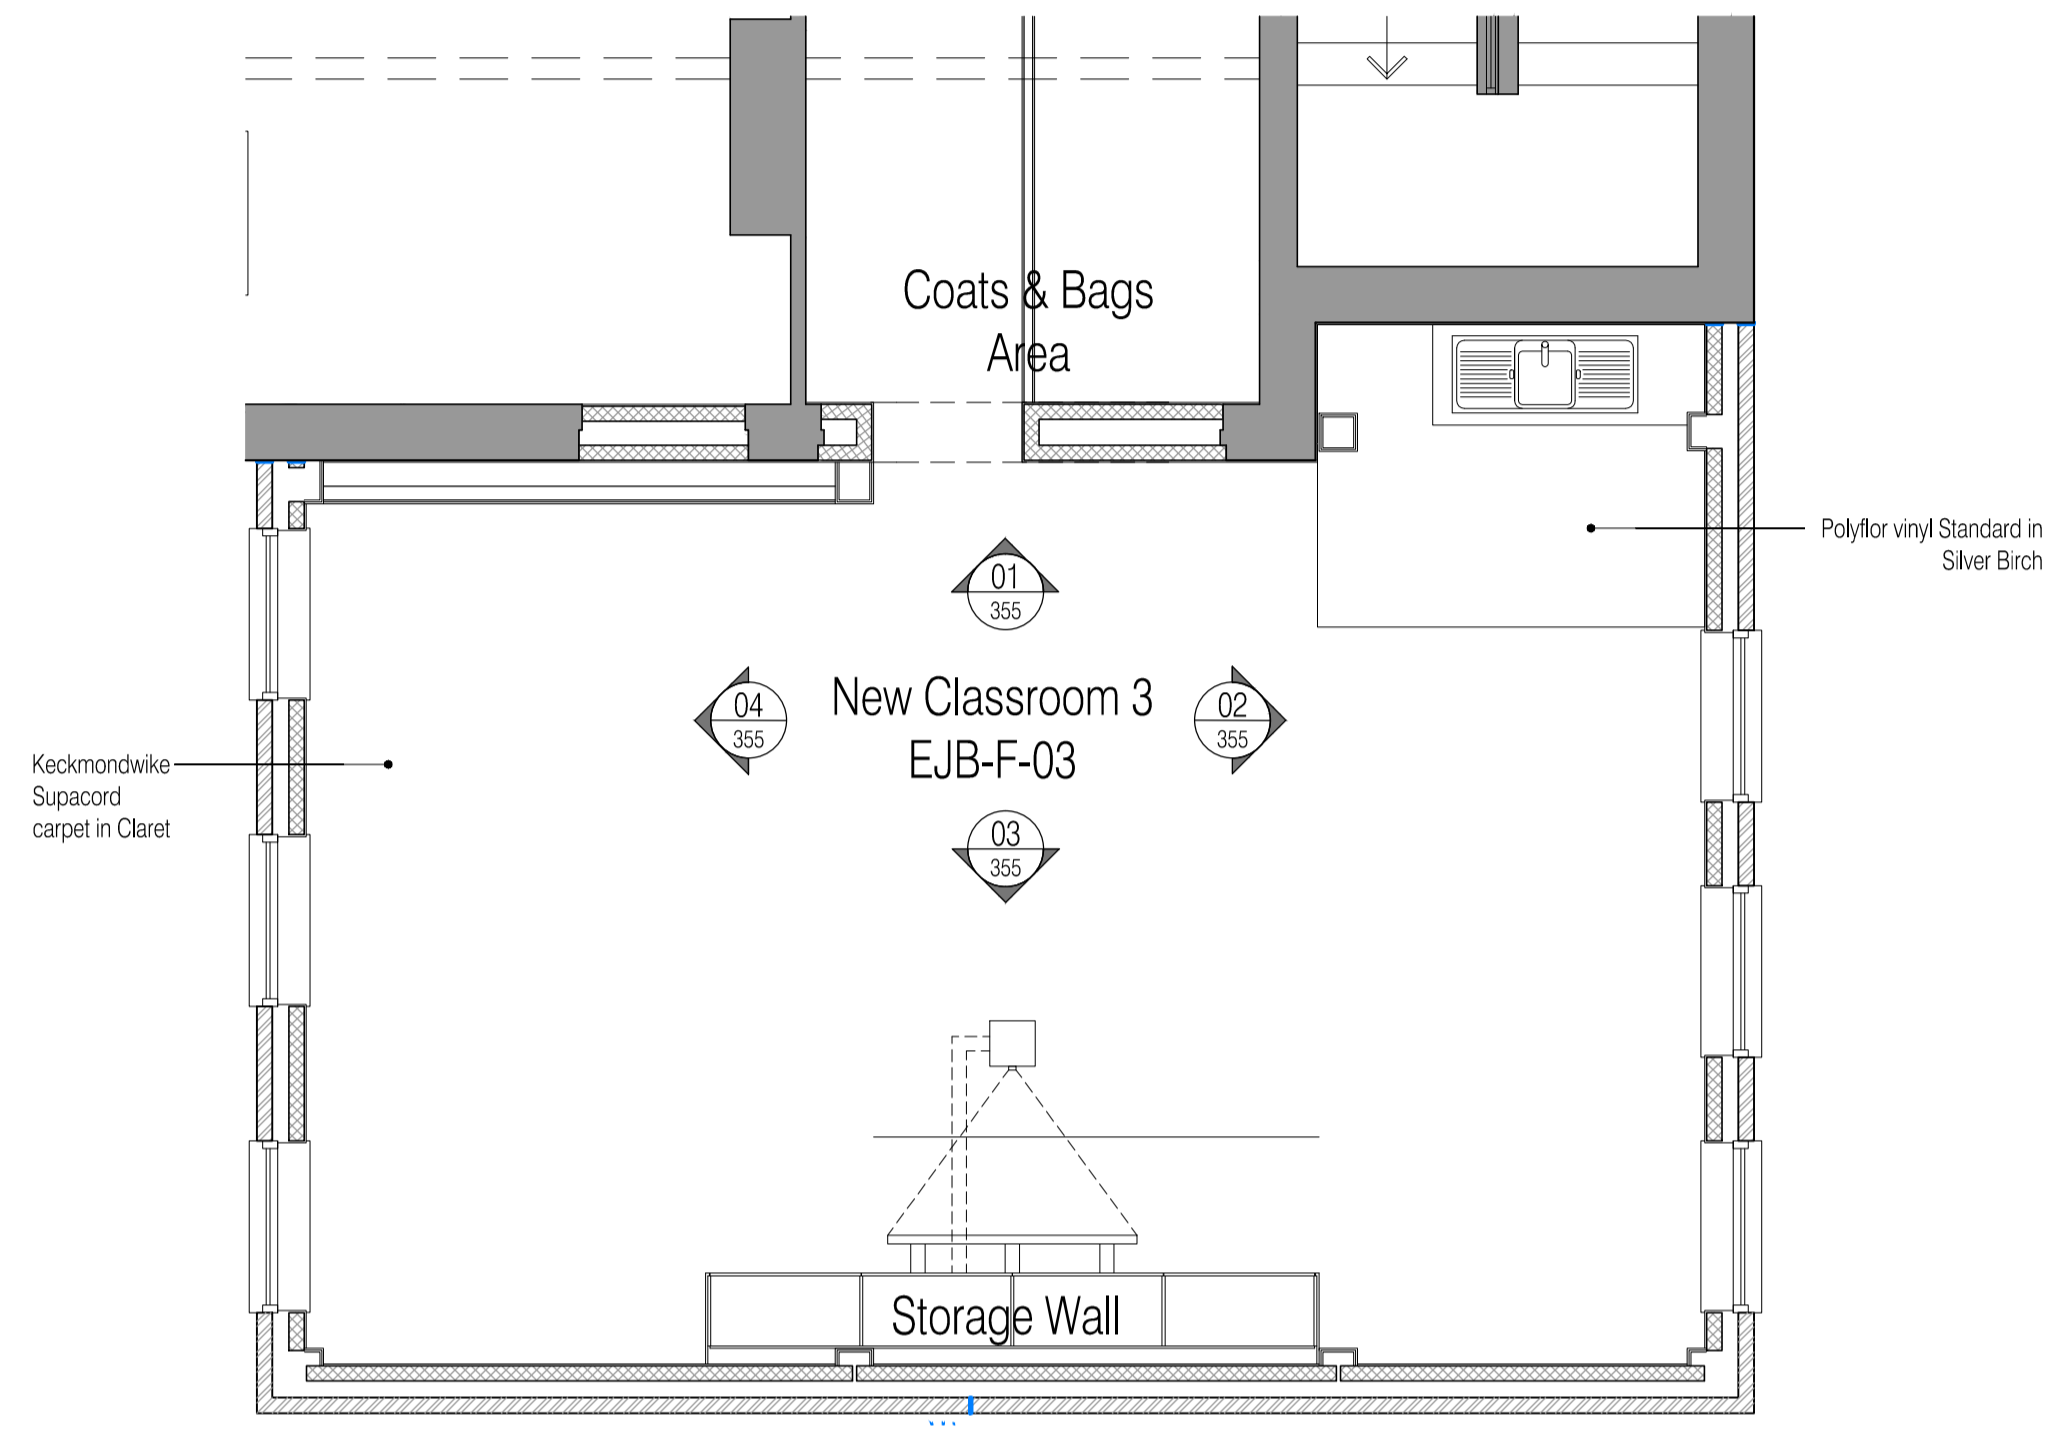


02 Elevation 01
 Scale: 1:50

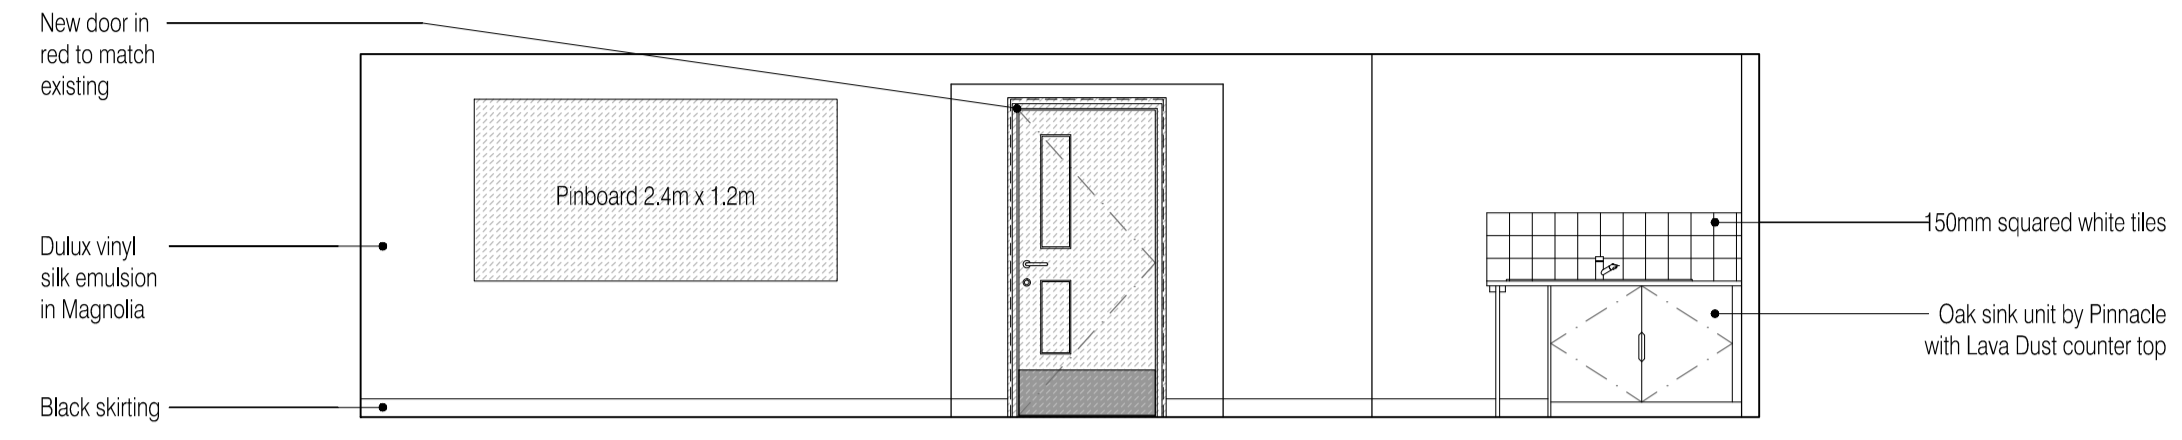


03 Elevation 02
 Scale: 1:50

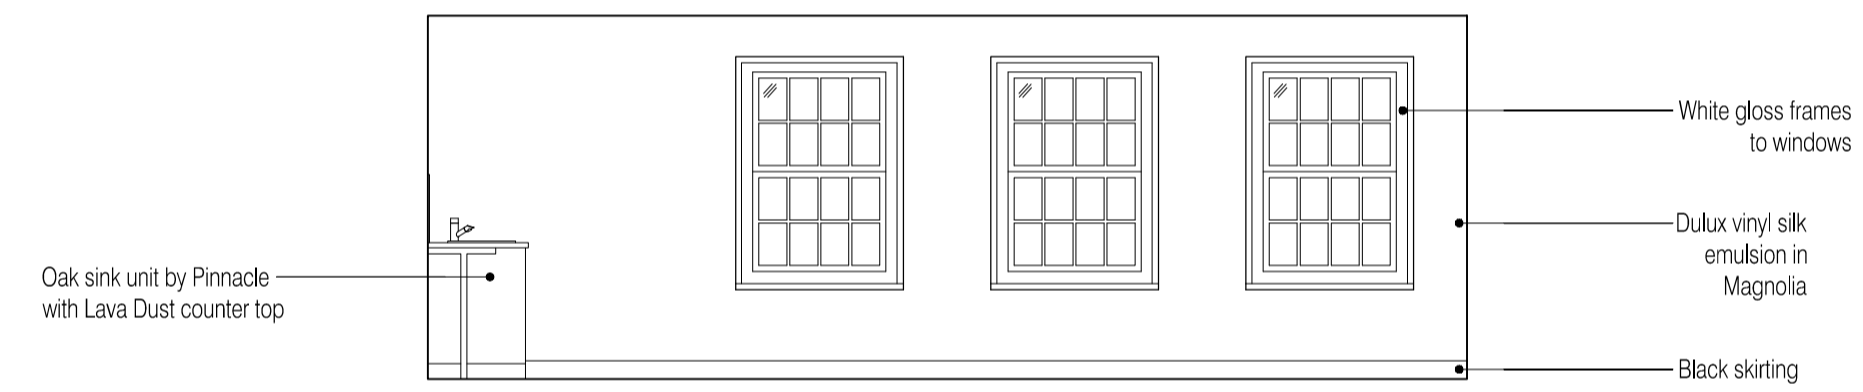

05 Elevation 04
 Scale: 1:50

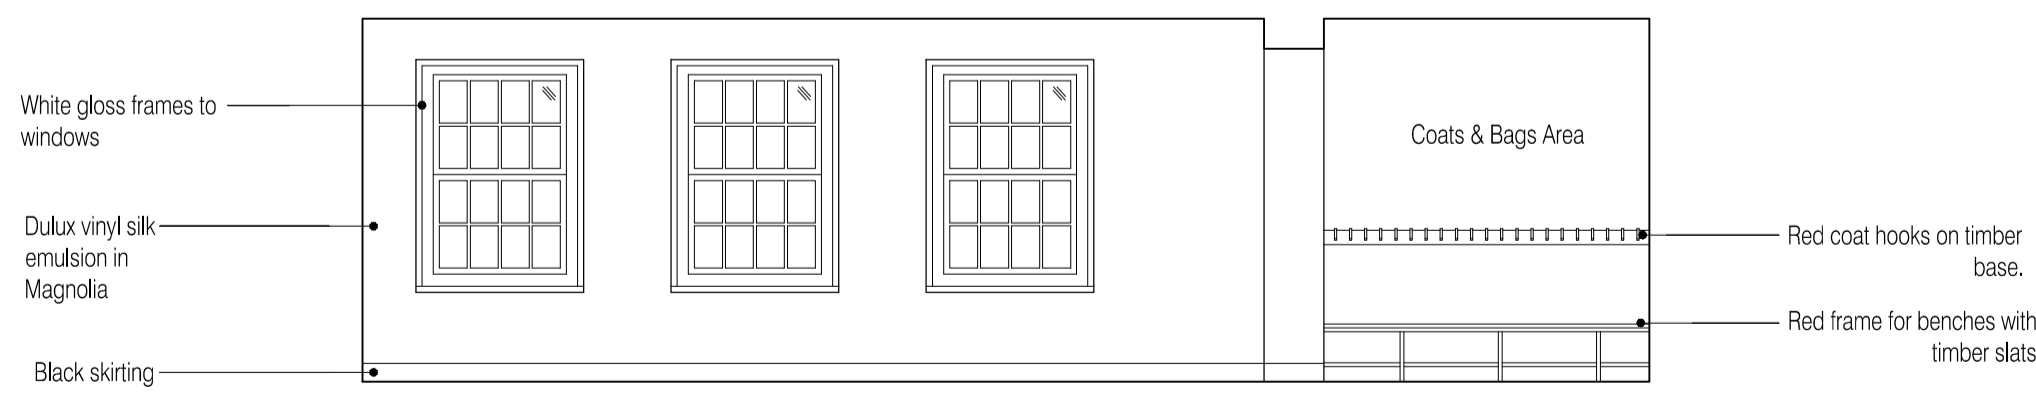

04 Elevation 03
 Scale: 1:50

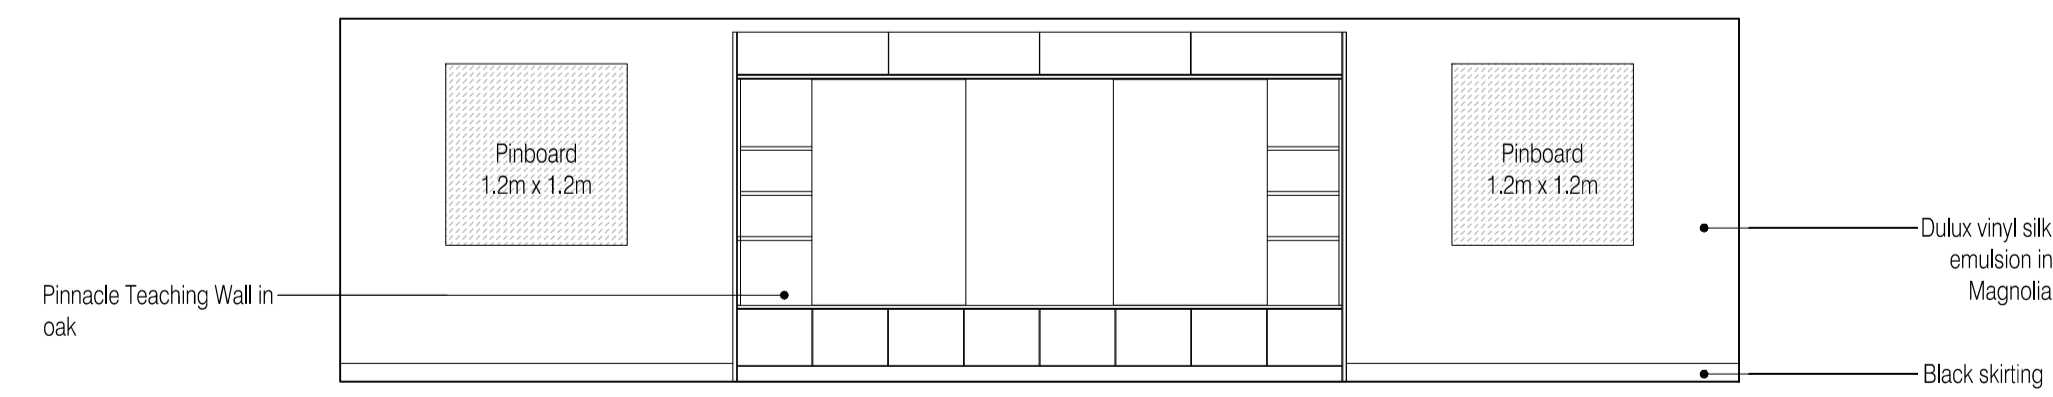

**AS BUILT
 DRAWING**

Rev	Date	By	Clk	Comment
AB1	17.04.14	RKC	AGC	DRAWING ISSUED - AS BUILT

25 YEARS OF BRINGING IDEAS TO LIFE
 ANNUARY 25 YEARS 1982-2007

FRANKHAM

Frankham Consultancy Group Limited

Frankham House Woolton Business Park
 Besselsleigh Road Woolton Abingdon
 Oxfordshire OX13 6FD
 T 01865 322500 F 01865 327393
 E enquiry@frankham.com www.frankham.com

Client
Leadbitter
 CONSTRUCTION

Project Title
 Whitehall Junior & Infant School
 Refurbishment, Extension and New Build
 Cowley Road
 London Borough of Hillingdon

Drawing Title
 Existing Junior School WC Area
 Room Elevations - New Classroom West Wing
 EJB-F-03

Drawn by: RKC	Scale: 1:50@A1	Date: 09.07.12
Designed by: FCG	Checked by: JAS	Approved by: AC

File Ref: Y:\000001881\HLN\2010\10\001 - HWELL\REDESIGN\WC_AREA\ELEVATIONS - (1)180620.DWG - REV A31 - 09.07.12	14.04.24.10.46.06
--------------------------------------------------------------------------------------------------------------------	-------------------

Drawing No. 611869-A-355	Rev. AB1
-----------------------------	-------------