
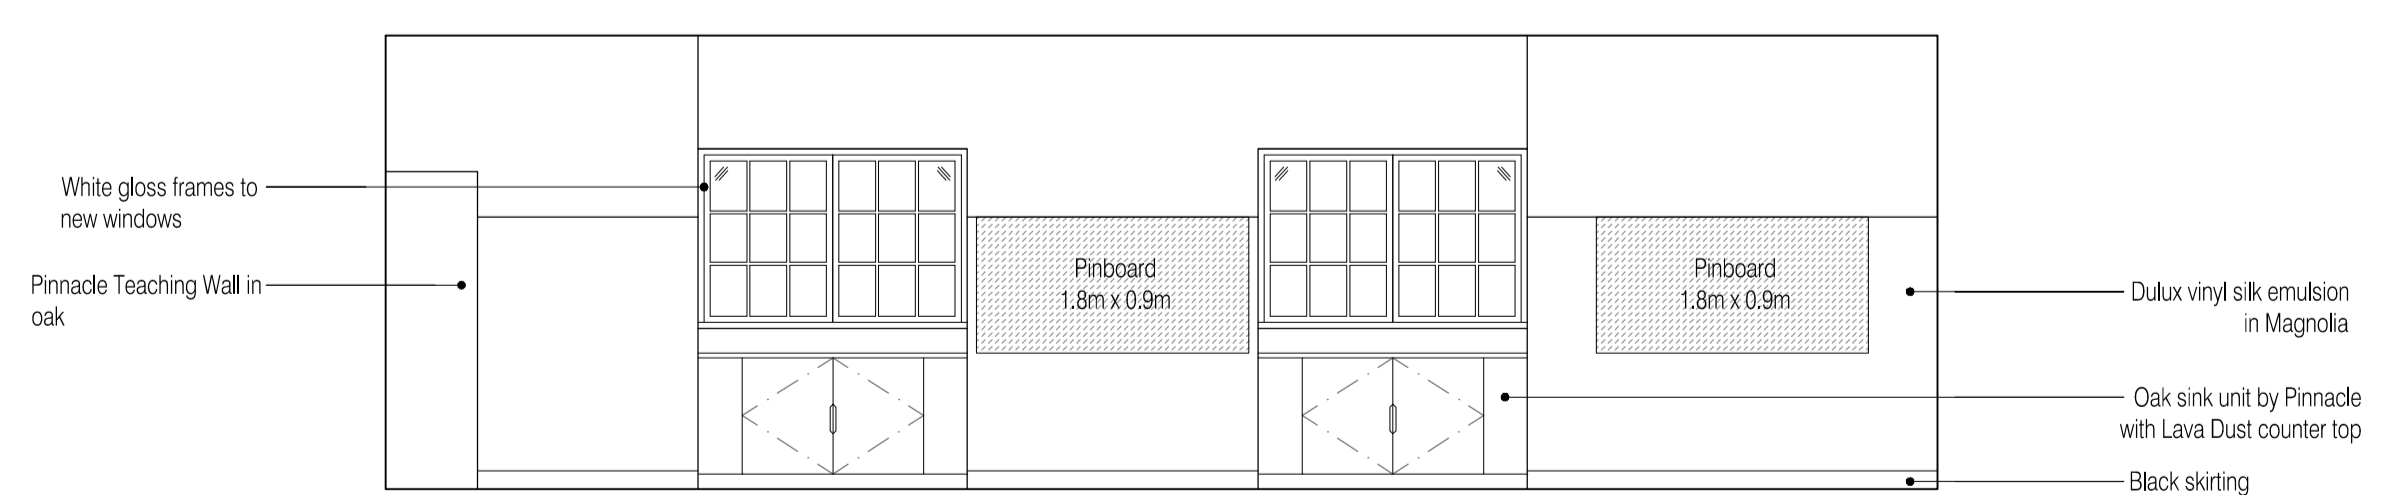
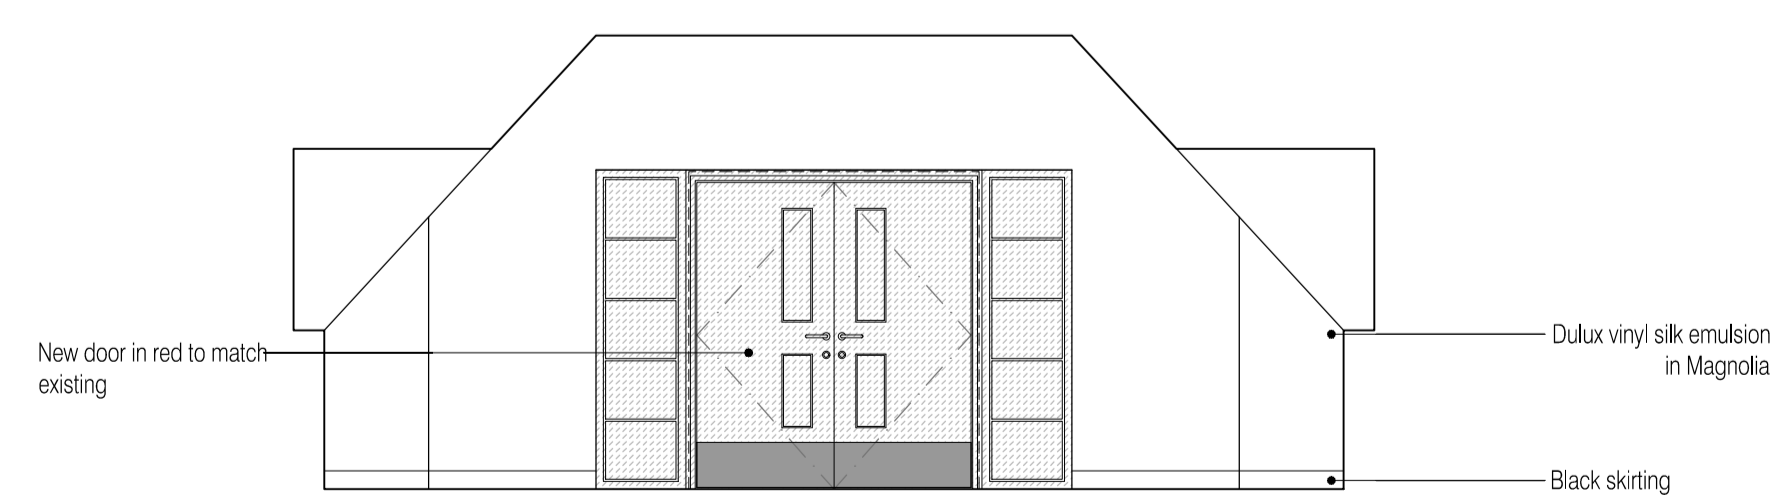
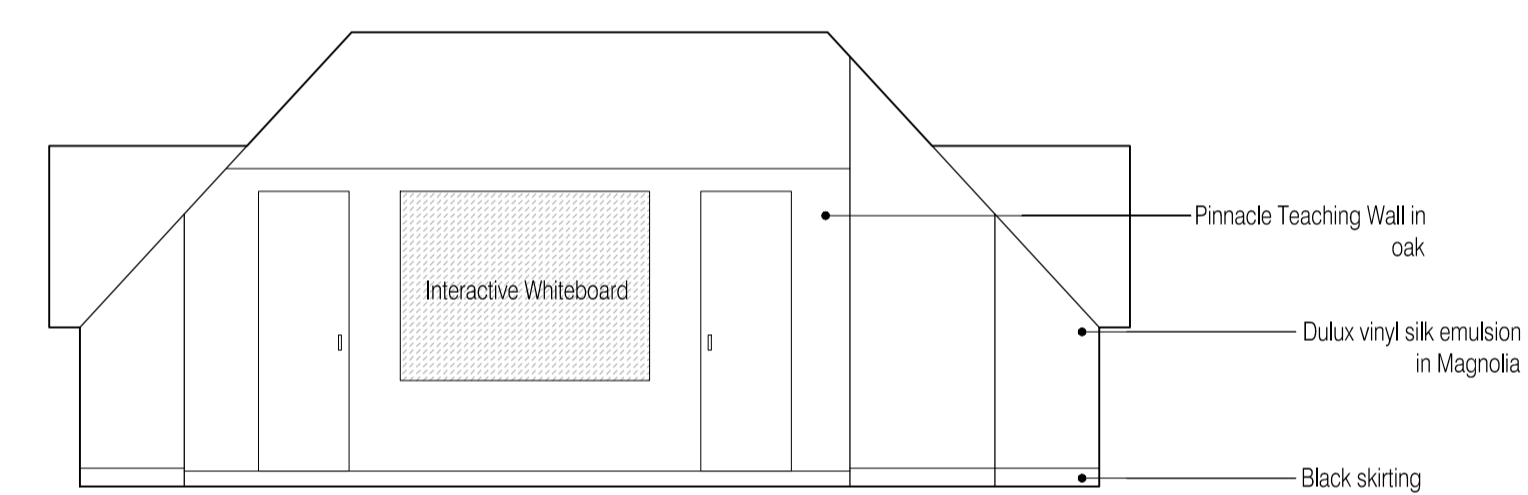
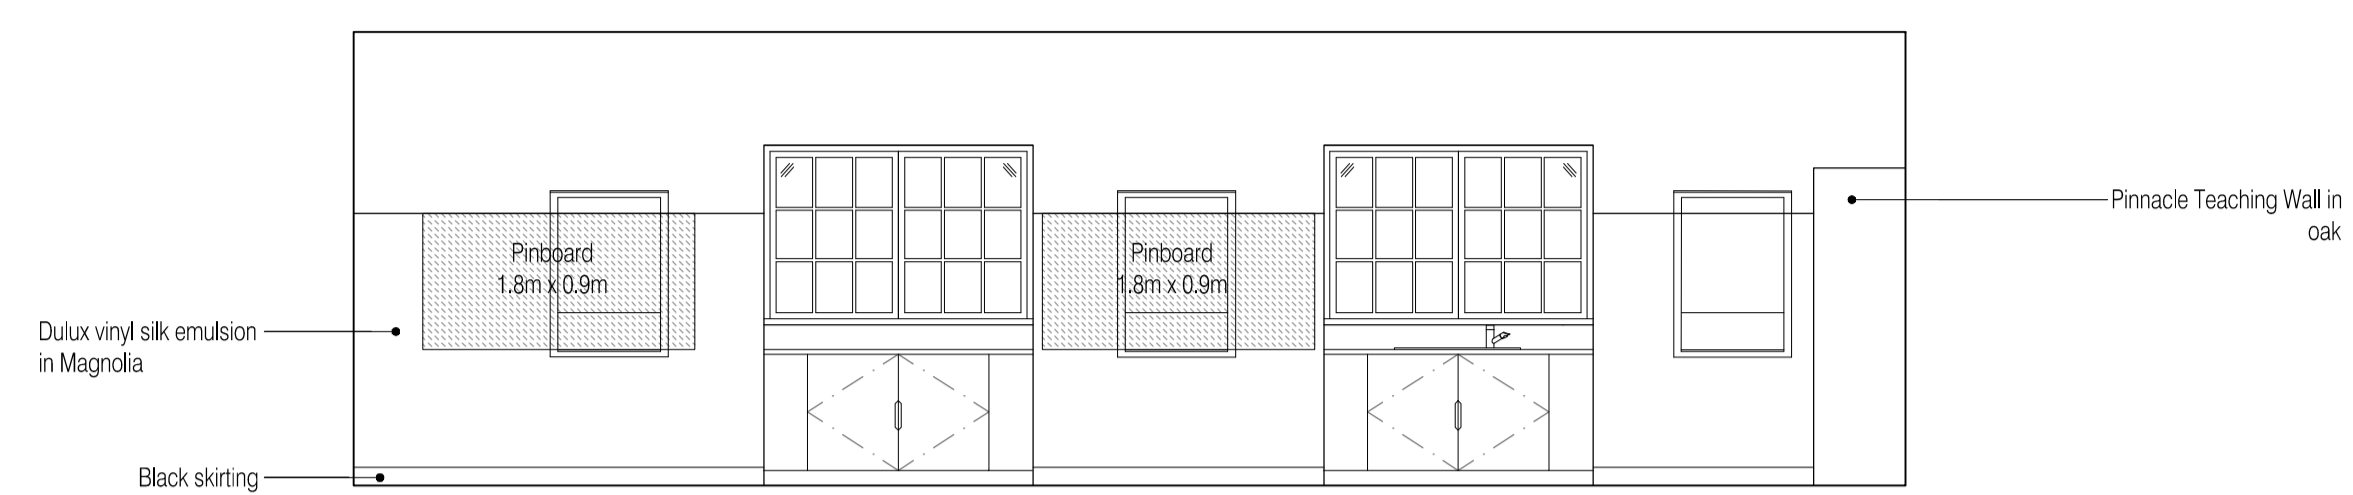


NOTES: Do not scale this drawing. All dimensions to be checked on site prior to commencement or manufacture.
 NB: All information based on supplied third party survey information. All discrepancies to be reported to FCG immediately upon discovery.

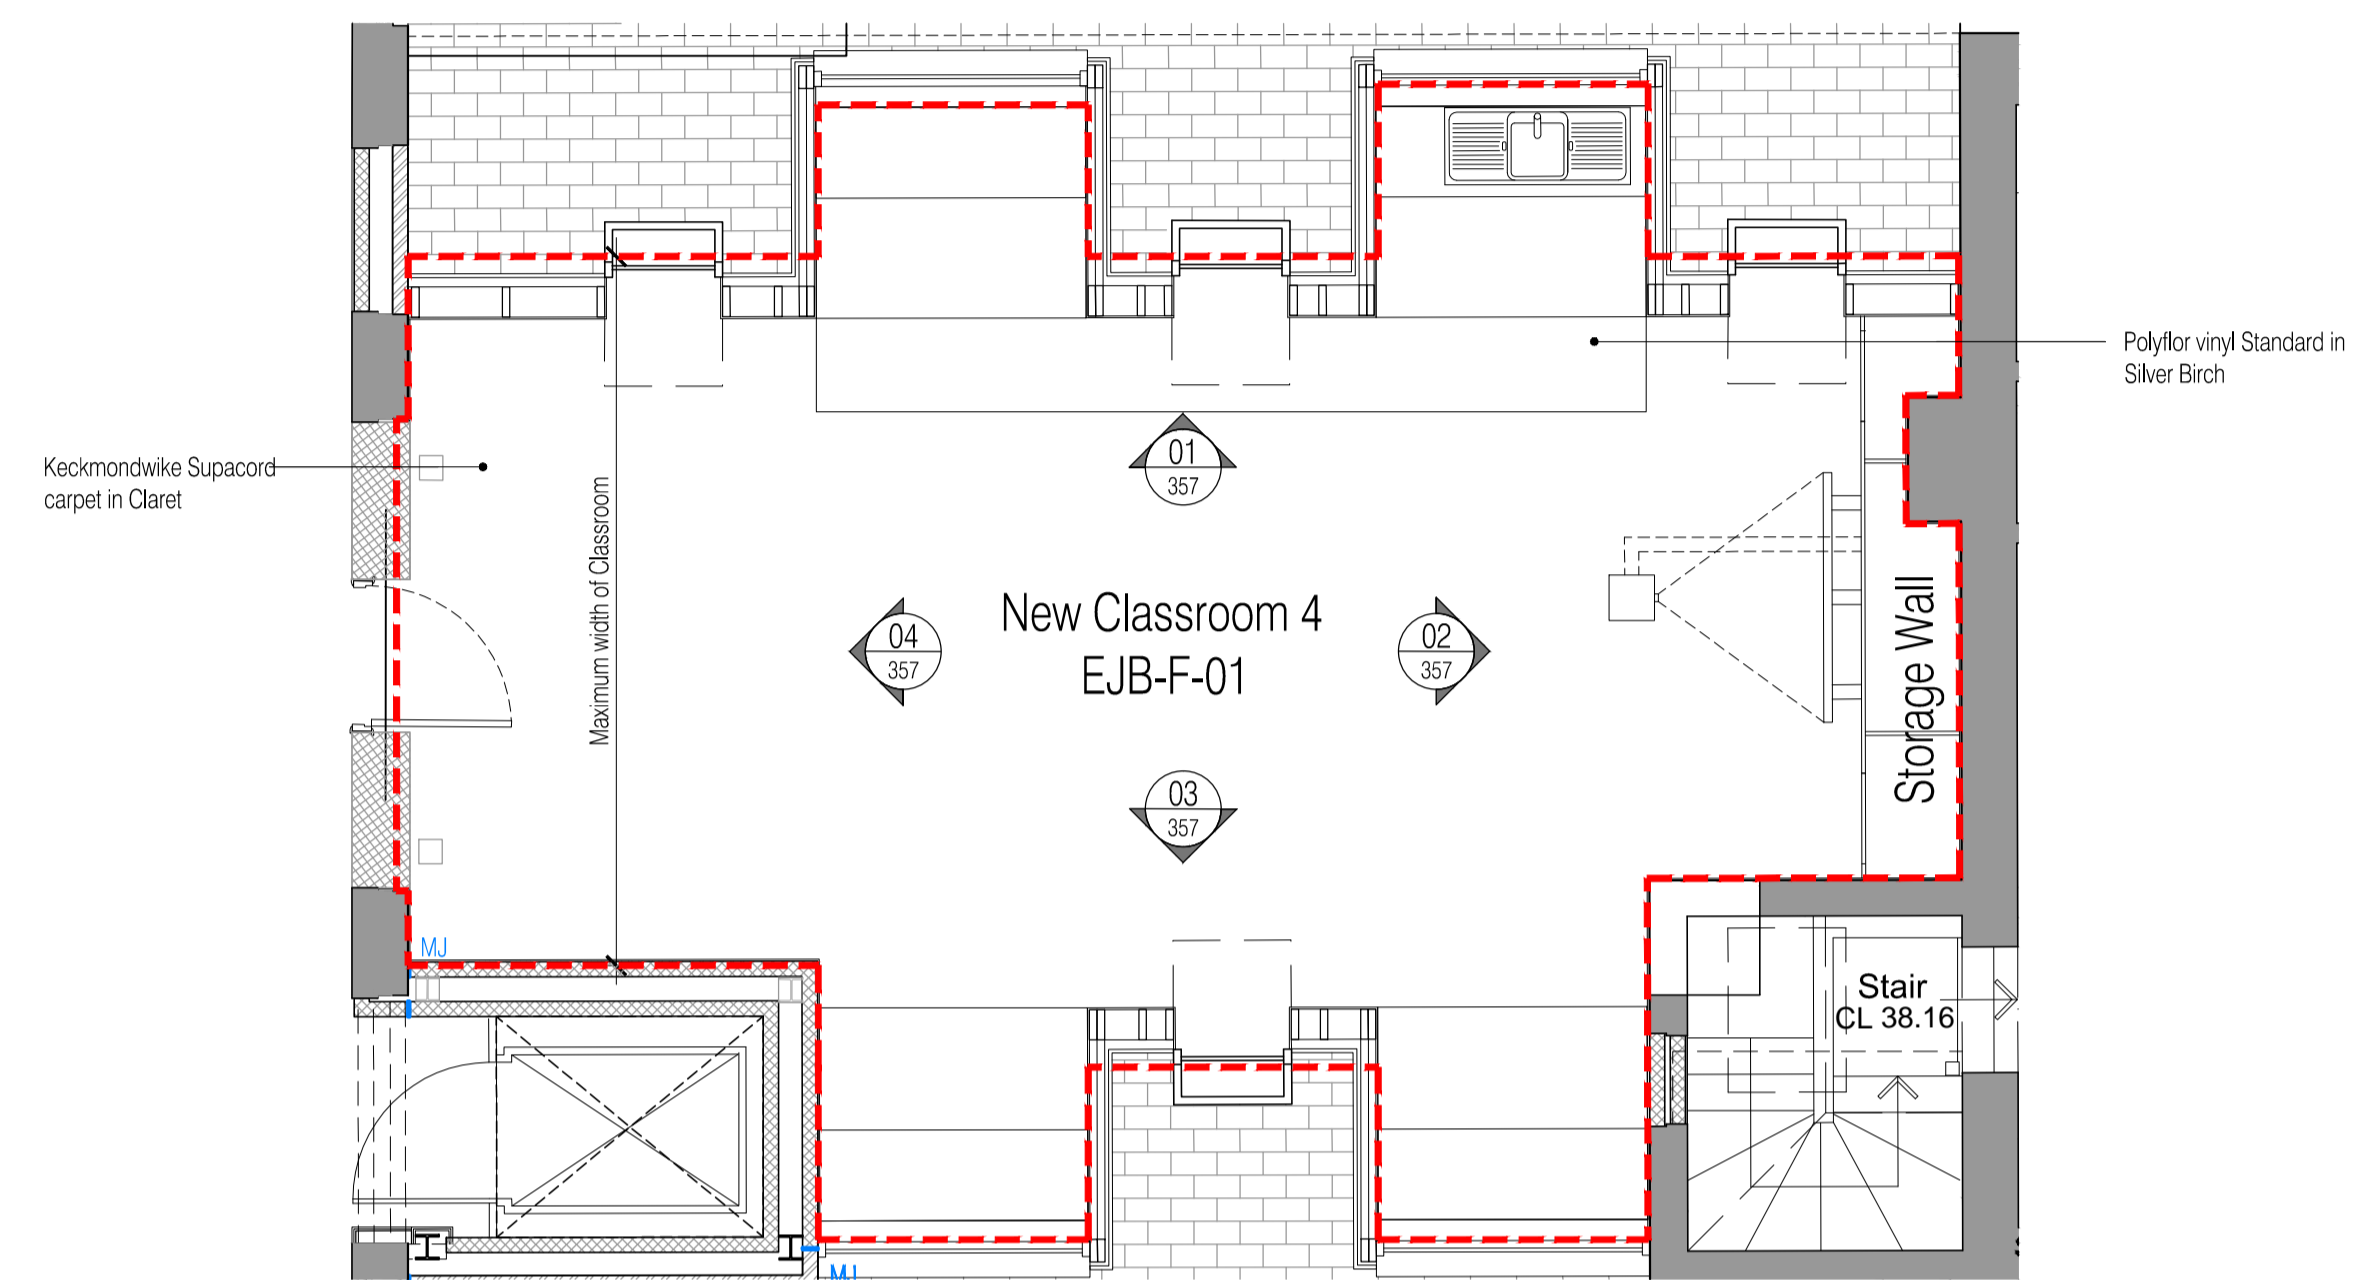

AS BUILT DRAWING

Rev	Date	By	Clk	Comment
AB1	17.04.14	FRK	AGC	DRAWING ISSUED - AS BUILT

25 YEARS OF BRINGING IDEAS TO LIFE

FRANKHAM

Frankham Consultancy Group Limited

Frankham House Wootton Business Park
Besselsleigh Road Wootton Abingdon
Oxfordshire OX13 6FD
T 01865 322500 F 01865 327393
E enquiry@frankham.com
www.frankham.com

Client: **Leadbitter CONSTRUCTION**

Project Title: Whitehall Junior & Infant School
Refurbishment, Extension and New Build
Cowley Road
London Borough of Hillingdon

Drawing Title: Existing Junior School WC Area
Room Elevations - New Classroom Infill
EJB-F-01

Drawn by: RKC	Scale: 1:50@A1	Date: 31.05.12
Designed by: FCG	Checked by: JAS	Approved by: AC
File Ref: J:\000081\881-1614\0001\00-COLS-1614\REV\REV2\DWG\001.dwg 14.04.24.10.46.20	Drawing No. 611869-A-357	
Rev. AB1		