




NOTES: Do not scale this drawing. All dimensions to be checked on site prior to commencement or manufacture.  
 NB: All information based on supplied third party survey information. All discrepancies to be reported to FCG immediately upon discovery.

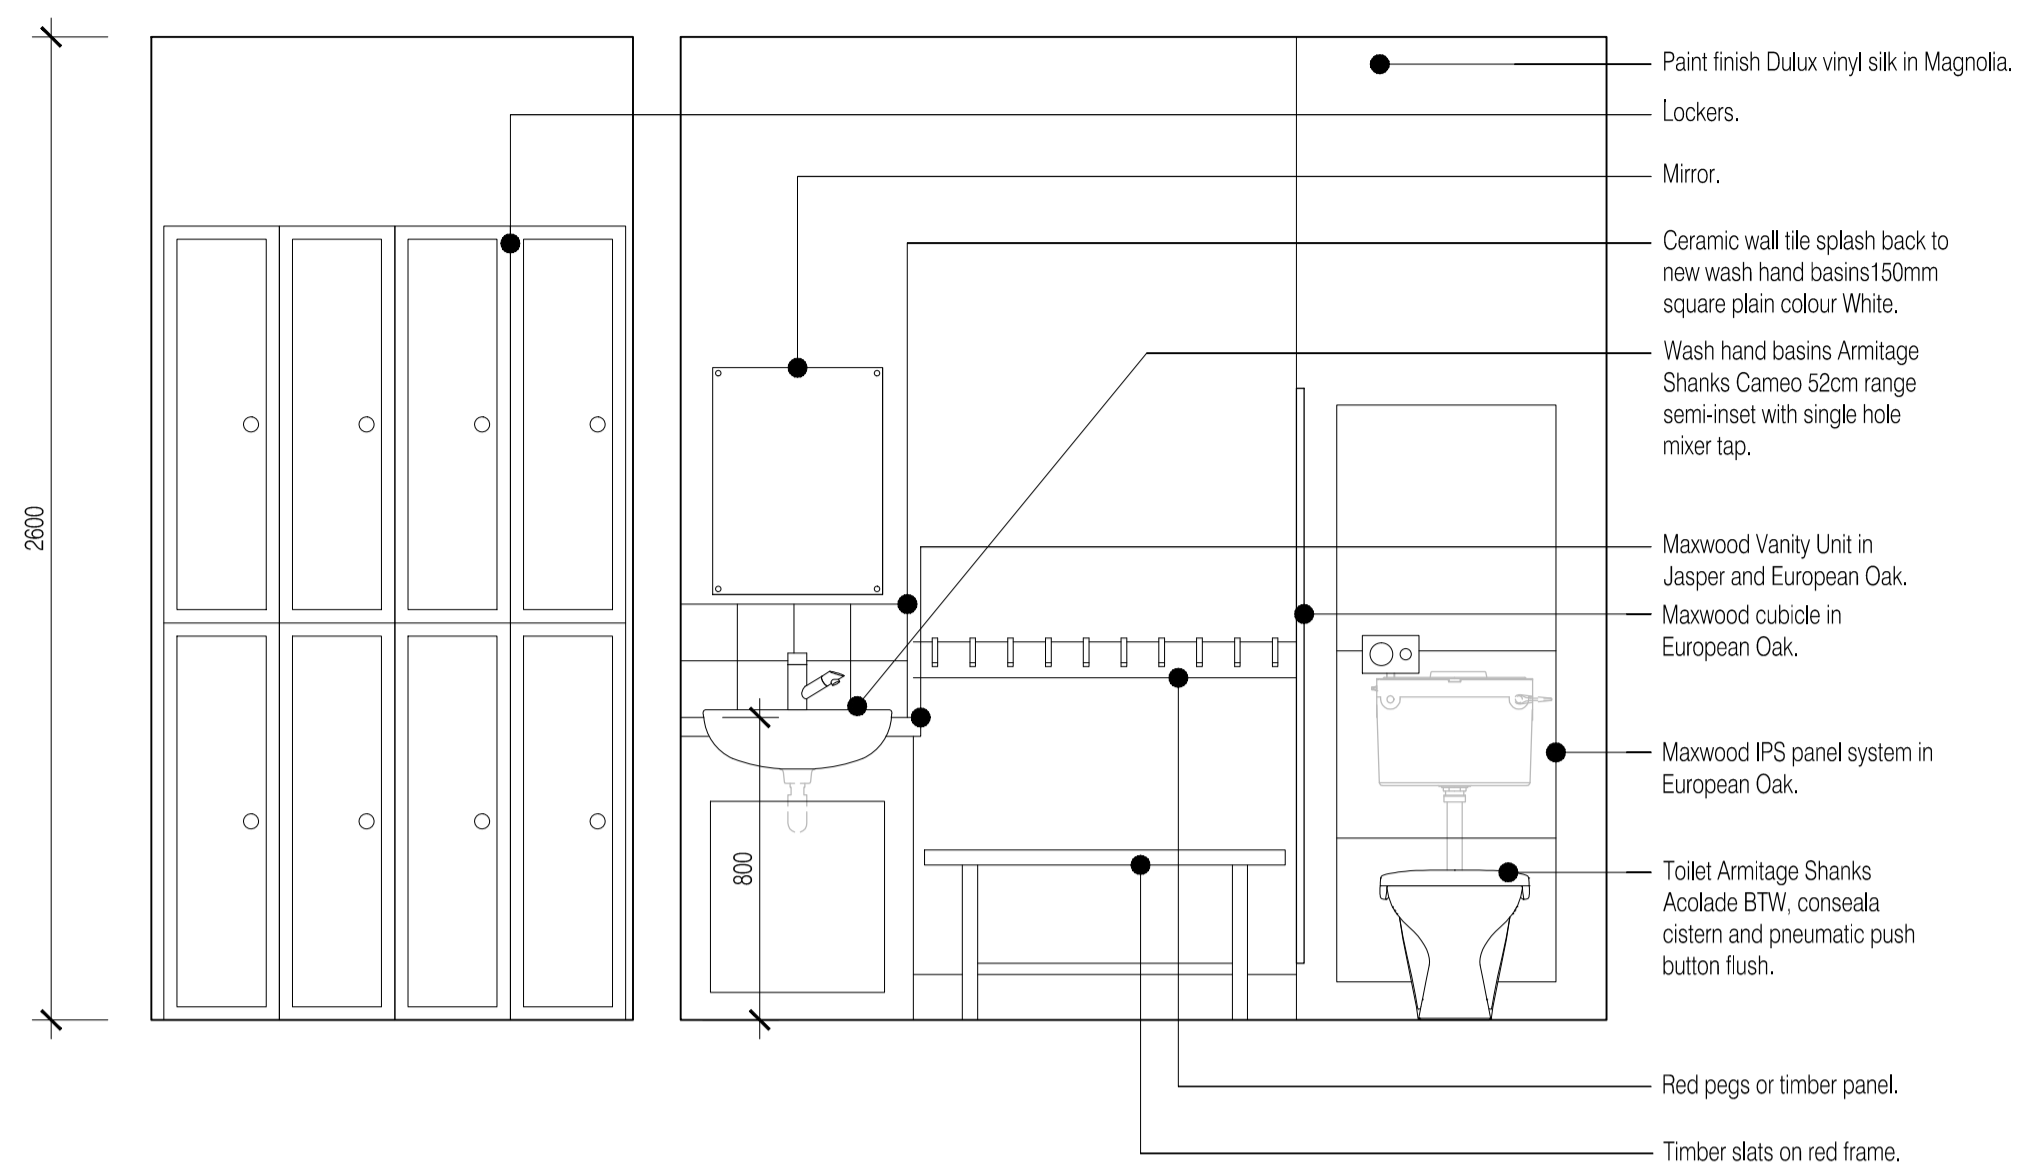


02 Elevation 01  
Scale: 1:20

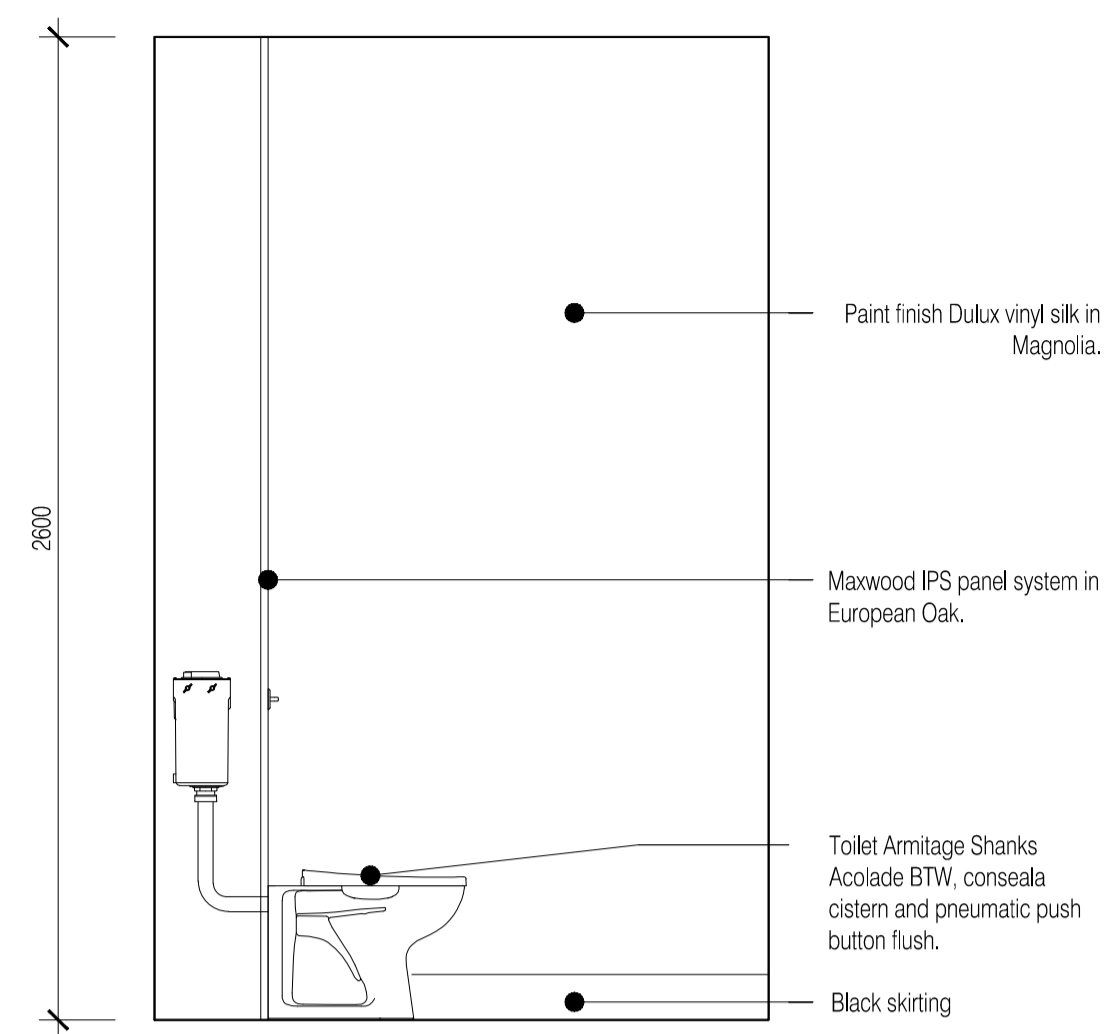


03 Elevation 02  
Scale: 1:20

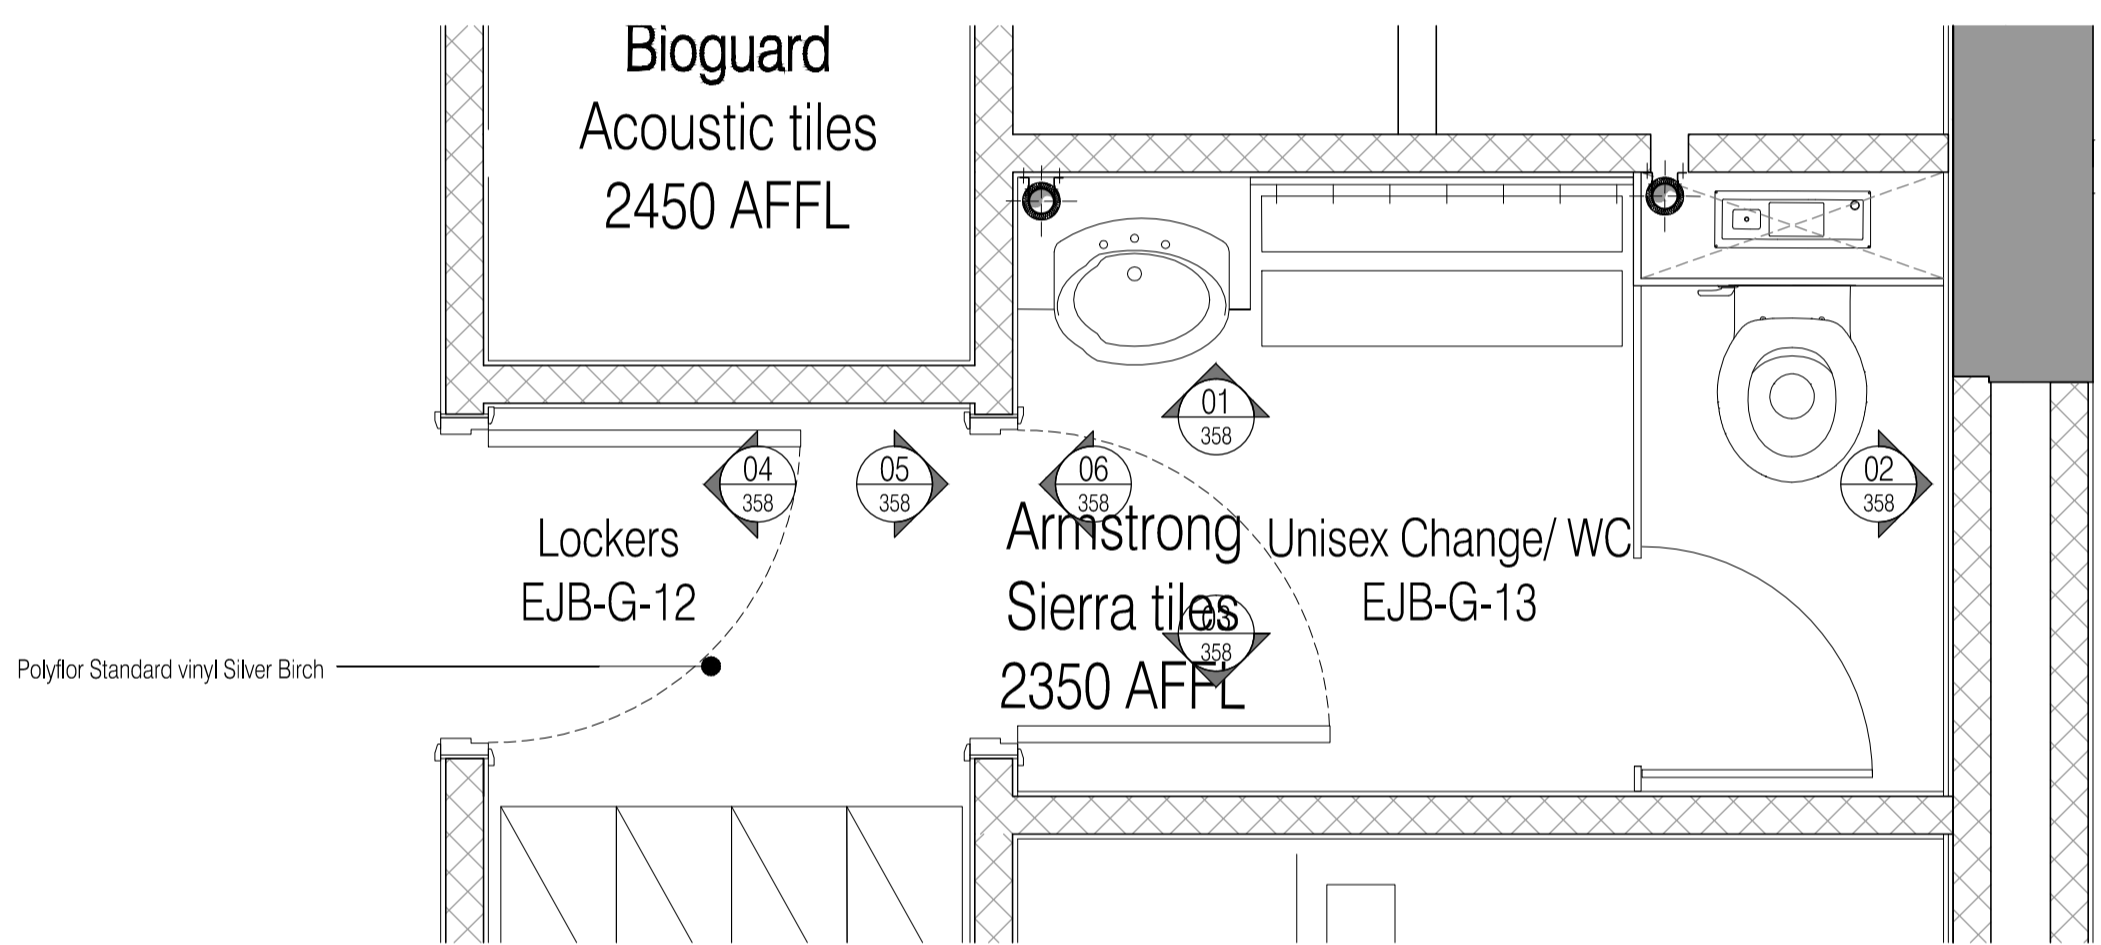


01 Floor Plan  
Scale: 1:20

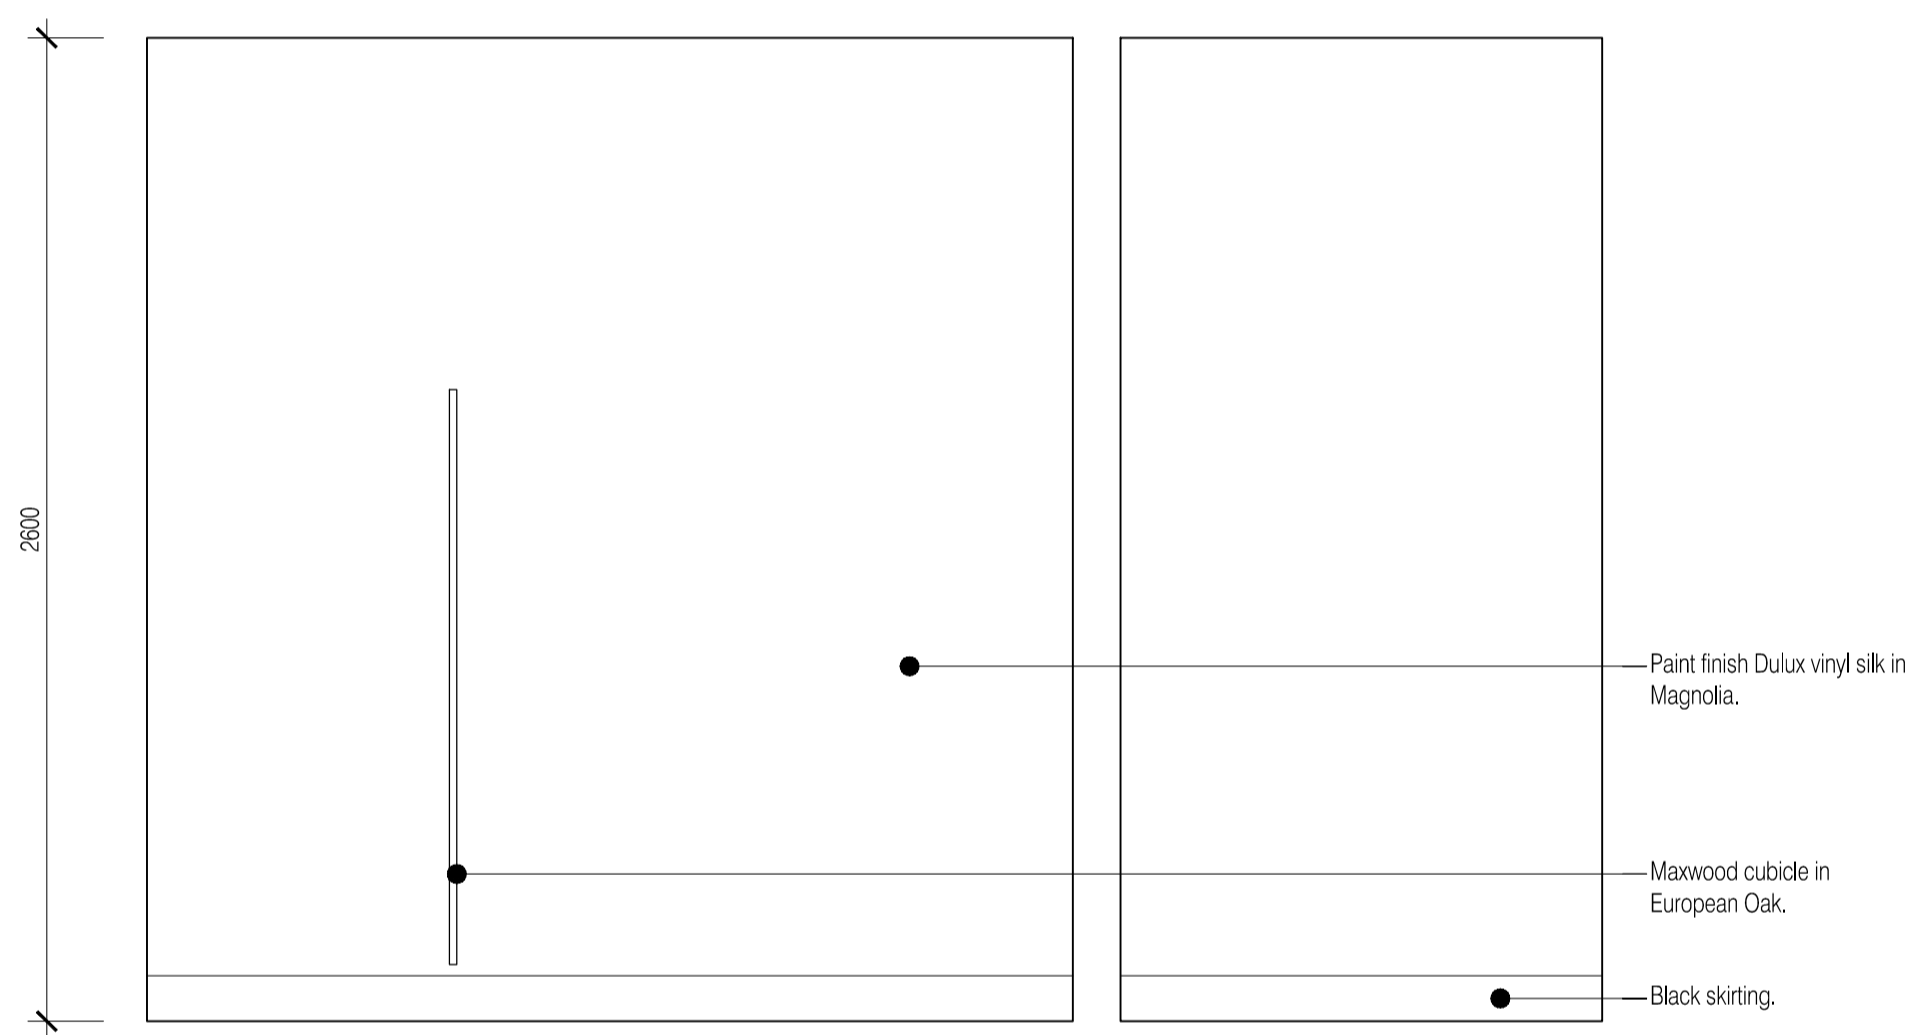


04 Elevation 03  
Scale: 1:20

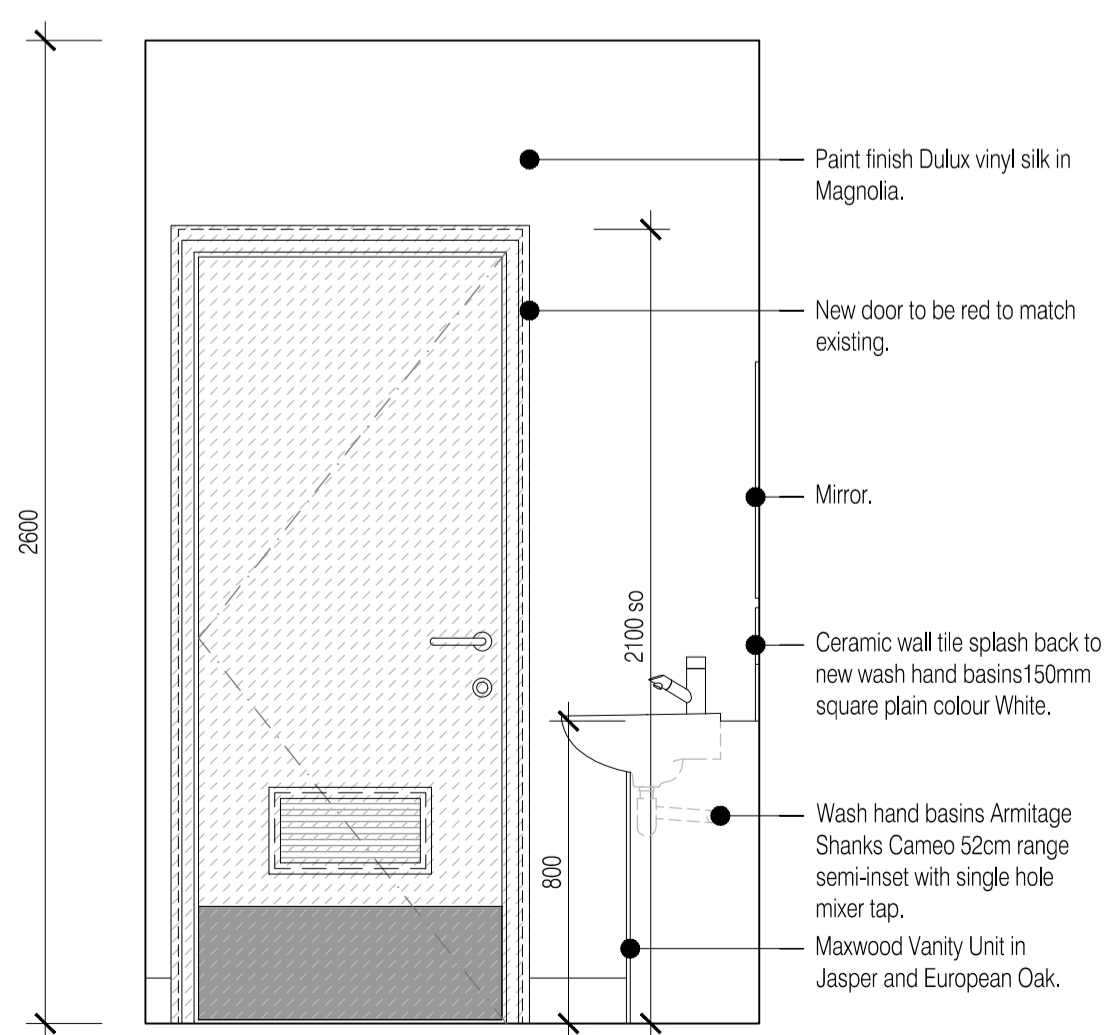

07 Elevation 06  
Scale: 1:20

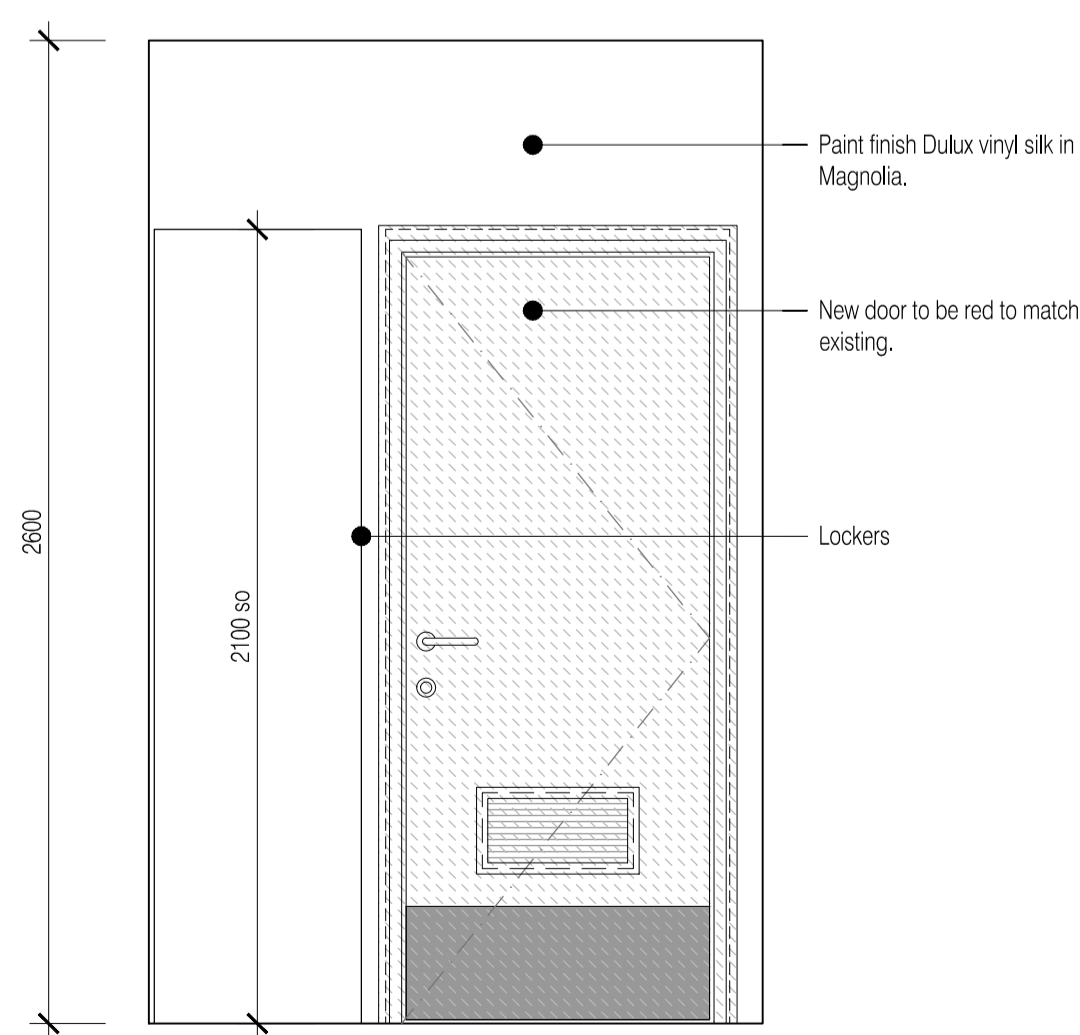

06 Elevation 05  
Scale: 1:20

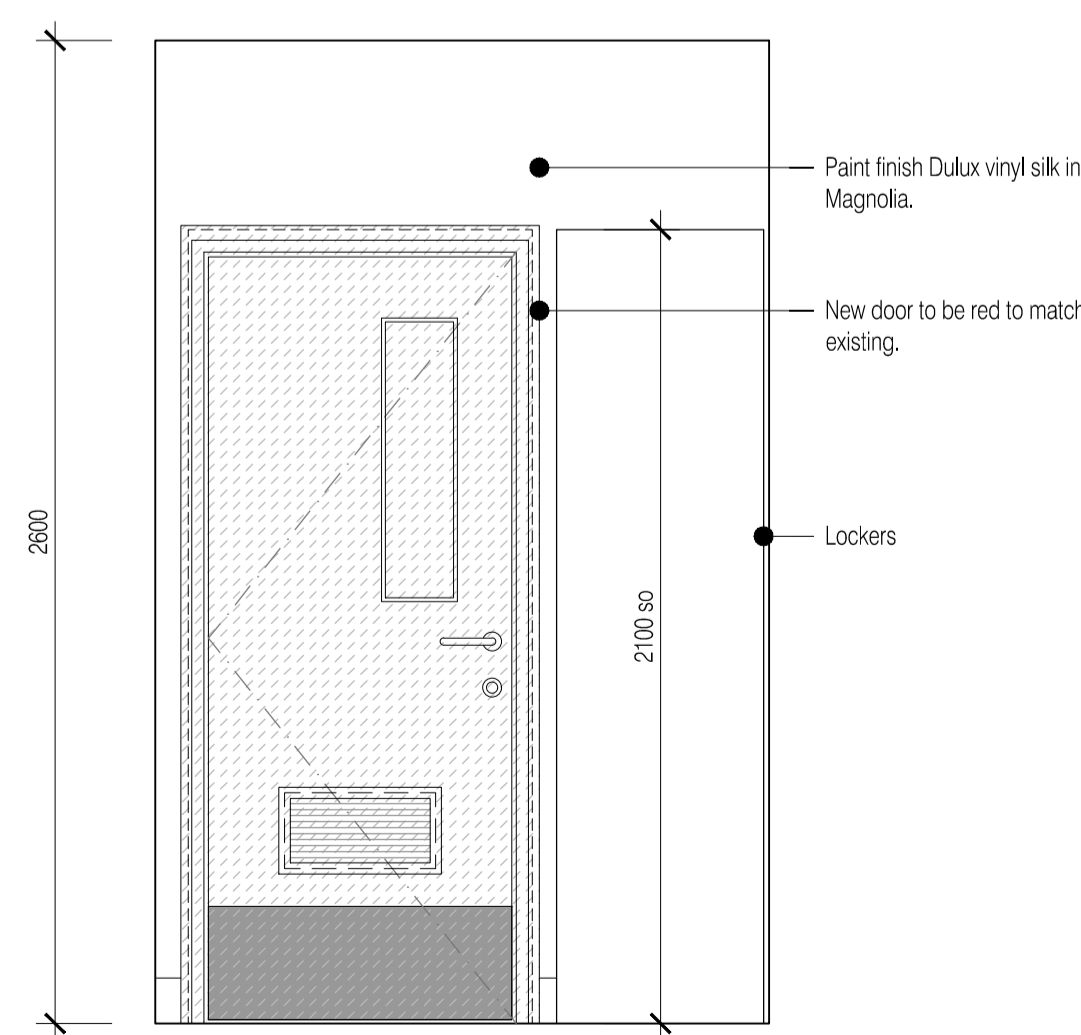

05 Elevation 04  
Scale: 1:20

AS BUILT  
DRAWING

Rev	Date	By	Clk	Comment
AB1	17.04.14	FRK	AGC	DRAWING ISSUED - AS BUILT

25 YEARS OF BRINGING IDEAS TO LIFE

**FRANKHAM**

Frankham Consultancy Group Limited  
 Frankham House Woolton Business Park  
 Besselsleigh Road Woolton Abingdon  
 Oxfordshire OX13 6FD  
 T 01865 322500 F 01865 327393  
 E enquiries@frankham.com www.frankham.com

Client: **Leadbitter CONSTRUCTION**

Project Title: Whitehall Junior & Infant School  
 Refurbishment, Extension and New Build  
 Cowley Road  
 London Borough of Hillingdon

Drawing Title: Existing Junior School WC Area  
 Room Elevations - Lockers & Unisex Change/WC  
 EJB-G-12 & EJB-G-13

Drawn by: RKC Scale: 1:20@A1 Date: 31.05.12  
 Designed by: FCG Checked by: JAS Approved by: AC

Drawing No. 611869-A-358 Rev. AB1