



NOTES: Do not scale this drawing. All dimensions to be checked on site prior to commencement or manufacture.  
 NB: All information based on supplied third party survey information. All discrepancies to be reported to FCG immediately upon discovery.

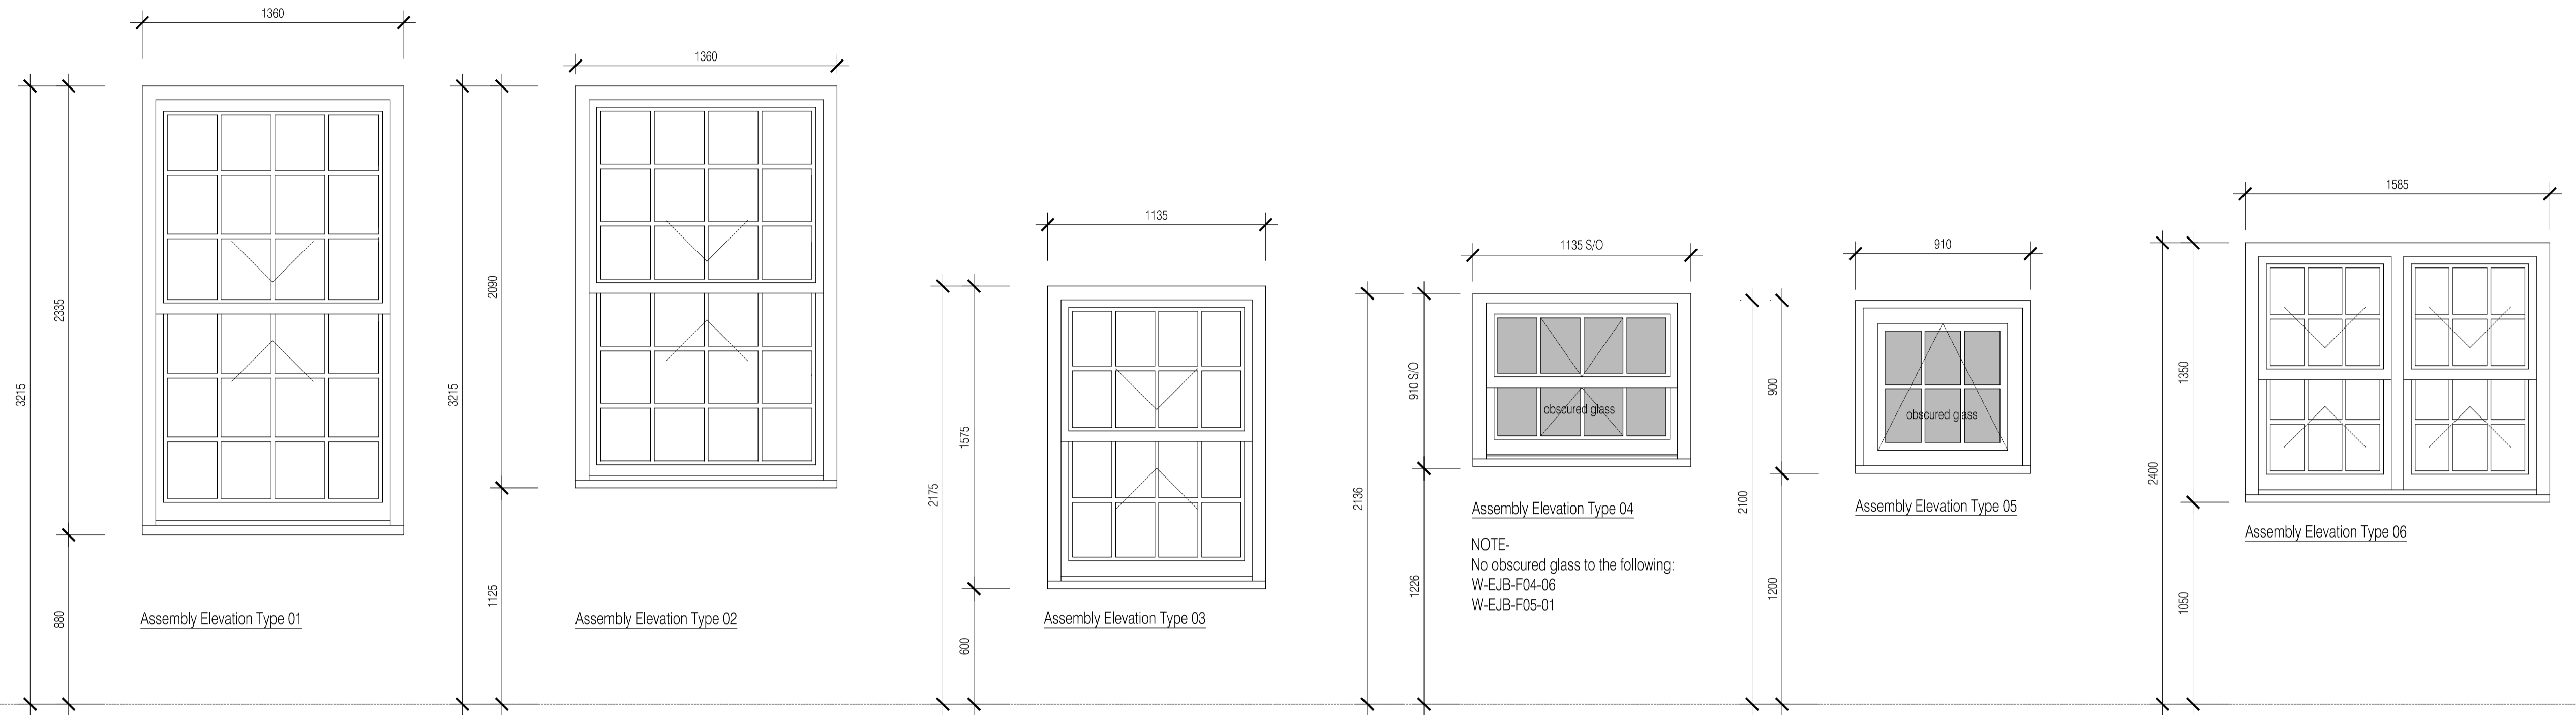

NOTE-  
 No obscured glass to the following:  
 W-EJB-F04-06  
 W-EJB-F05-01

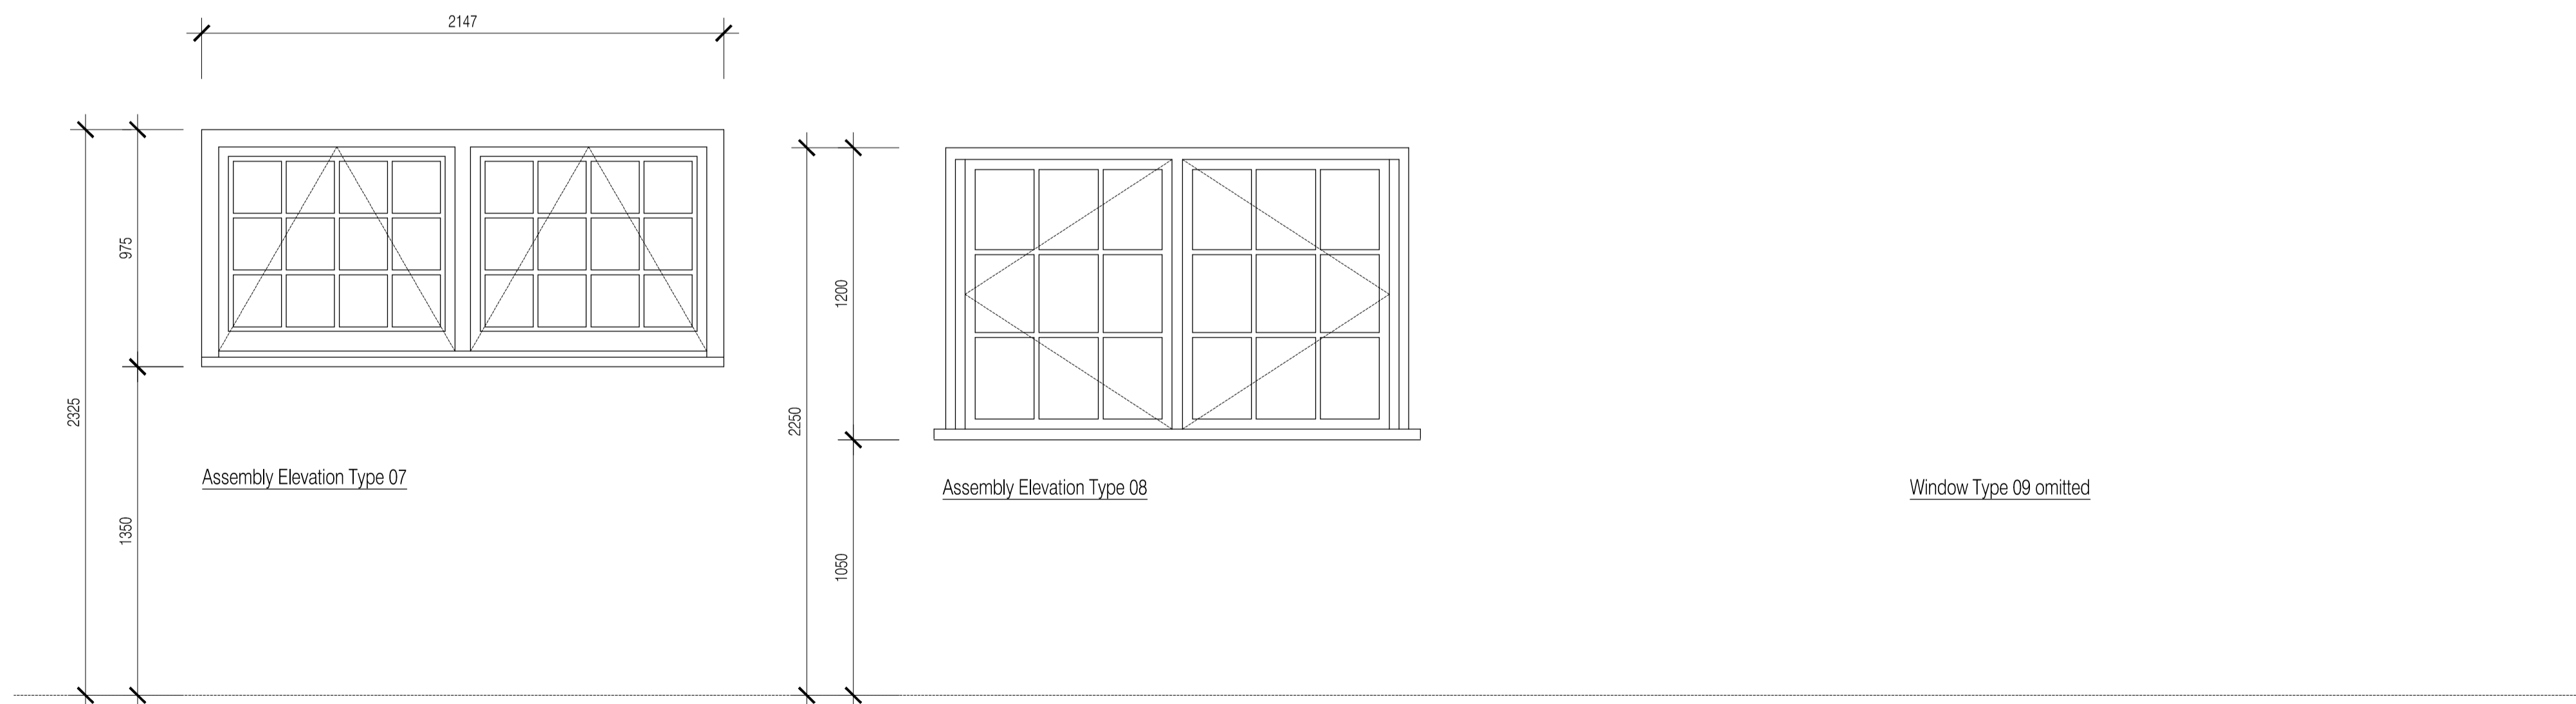

Window Type 09 omitted

AS BUILT  
 DRAWING

Rev	Date	By	Chk	Comment

AB1	17.04.14	RKC	AGC	DRAWING ISSUED - AS BUILT
-----	----------	-----	-----	---------------------------

25 YEARS OF BRINGING IDEAS TO LIFE

**FRANKHAM**

**Frankham Consultancy Group Limited**  
 Frankham House Wootton Business Park  
 Besselsleigh Road Wootton Abingdon  
 Oxfordshire OX13 6FD  
 T 01865 322500 F 01865 327393  
 E enquire@frankham.com www.frankham.com

Client  
**Leadbitter**  
 CONSTRUCTION

Project Title  
 Whitehall Junior & Infant School  
 Refurbishment, Extension and New Build  
 Cowley Road  
 London Borough of Hillingdon

Drawing Title  
 Junior Block  
 Window Elevations  
 Sheet 1 of 2

Drawn by: RKC	Scale: 1:20@A1	Date: 17.08.12
Designed by: JCS	Checked by: JAS	Approved by: AC

File Ref: J:\000041861-161869-A-380-01-REV17-170812\161869-A-380-01-REV17-170812.dwg  
 14.04.24.10.46.58

Drawing No. 611869-A-380	Rev. AB1
-----------------------------	-------------