




01 New Hall Extension Roof Ridge Gable Detail
Scale: 1:5

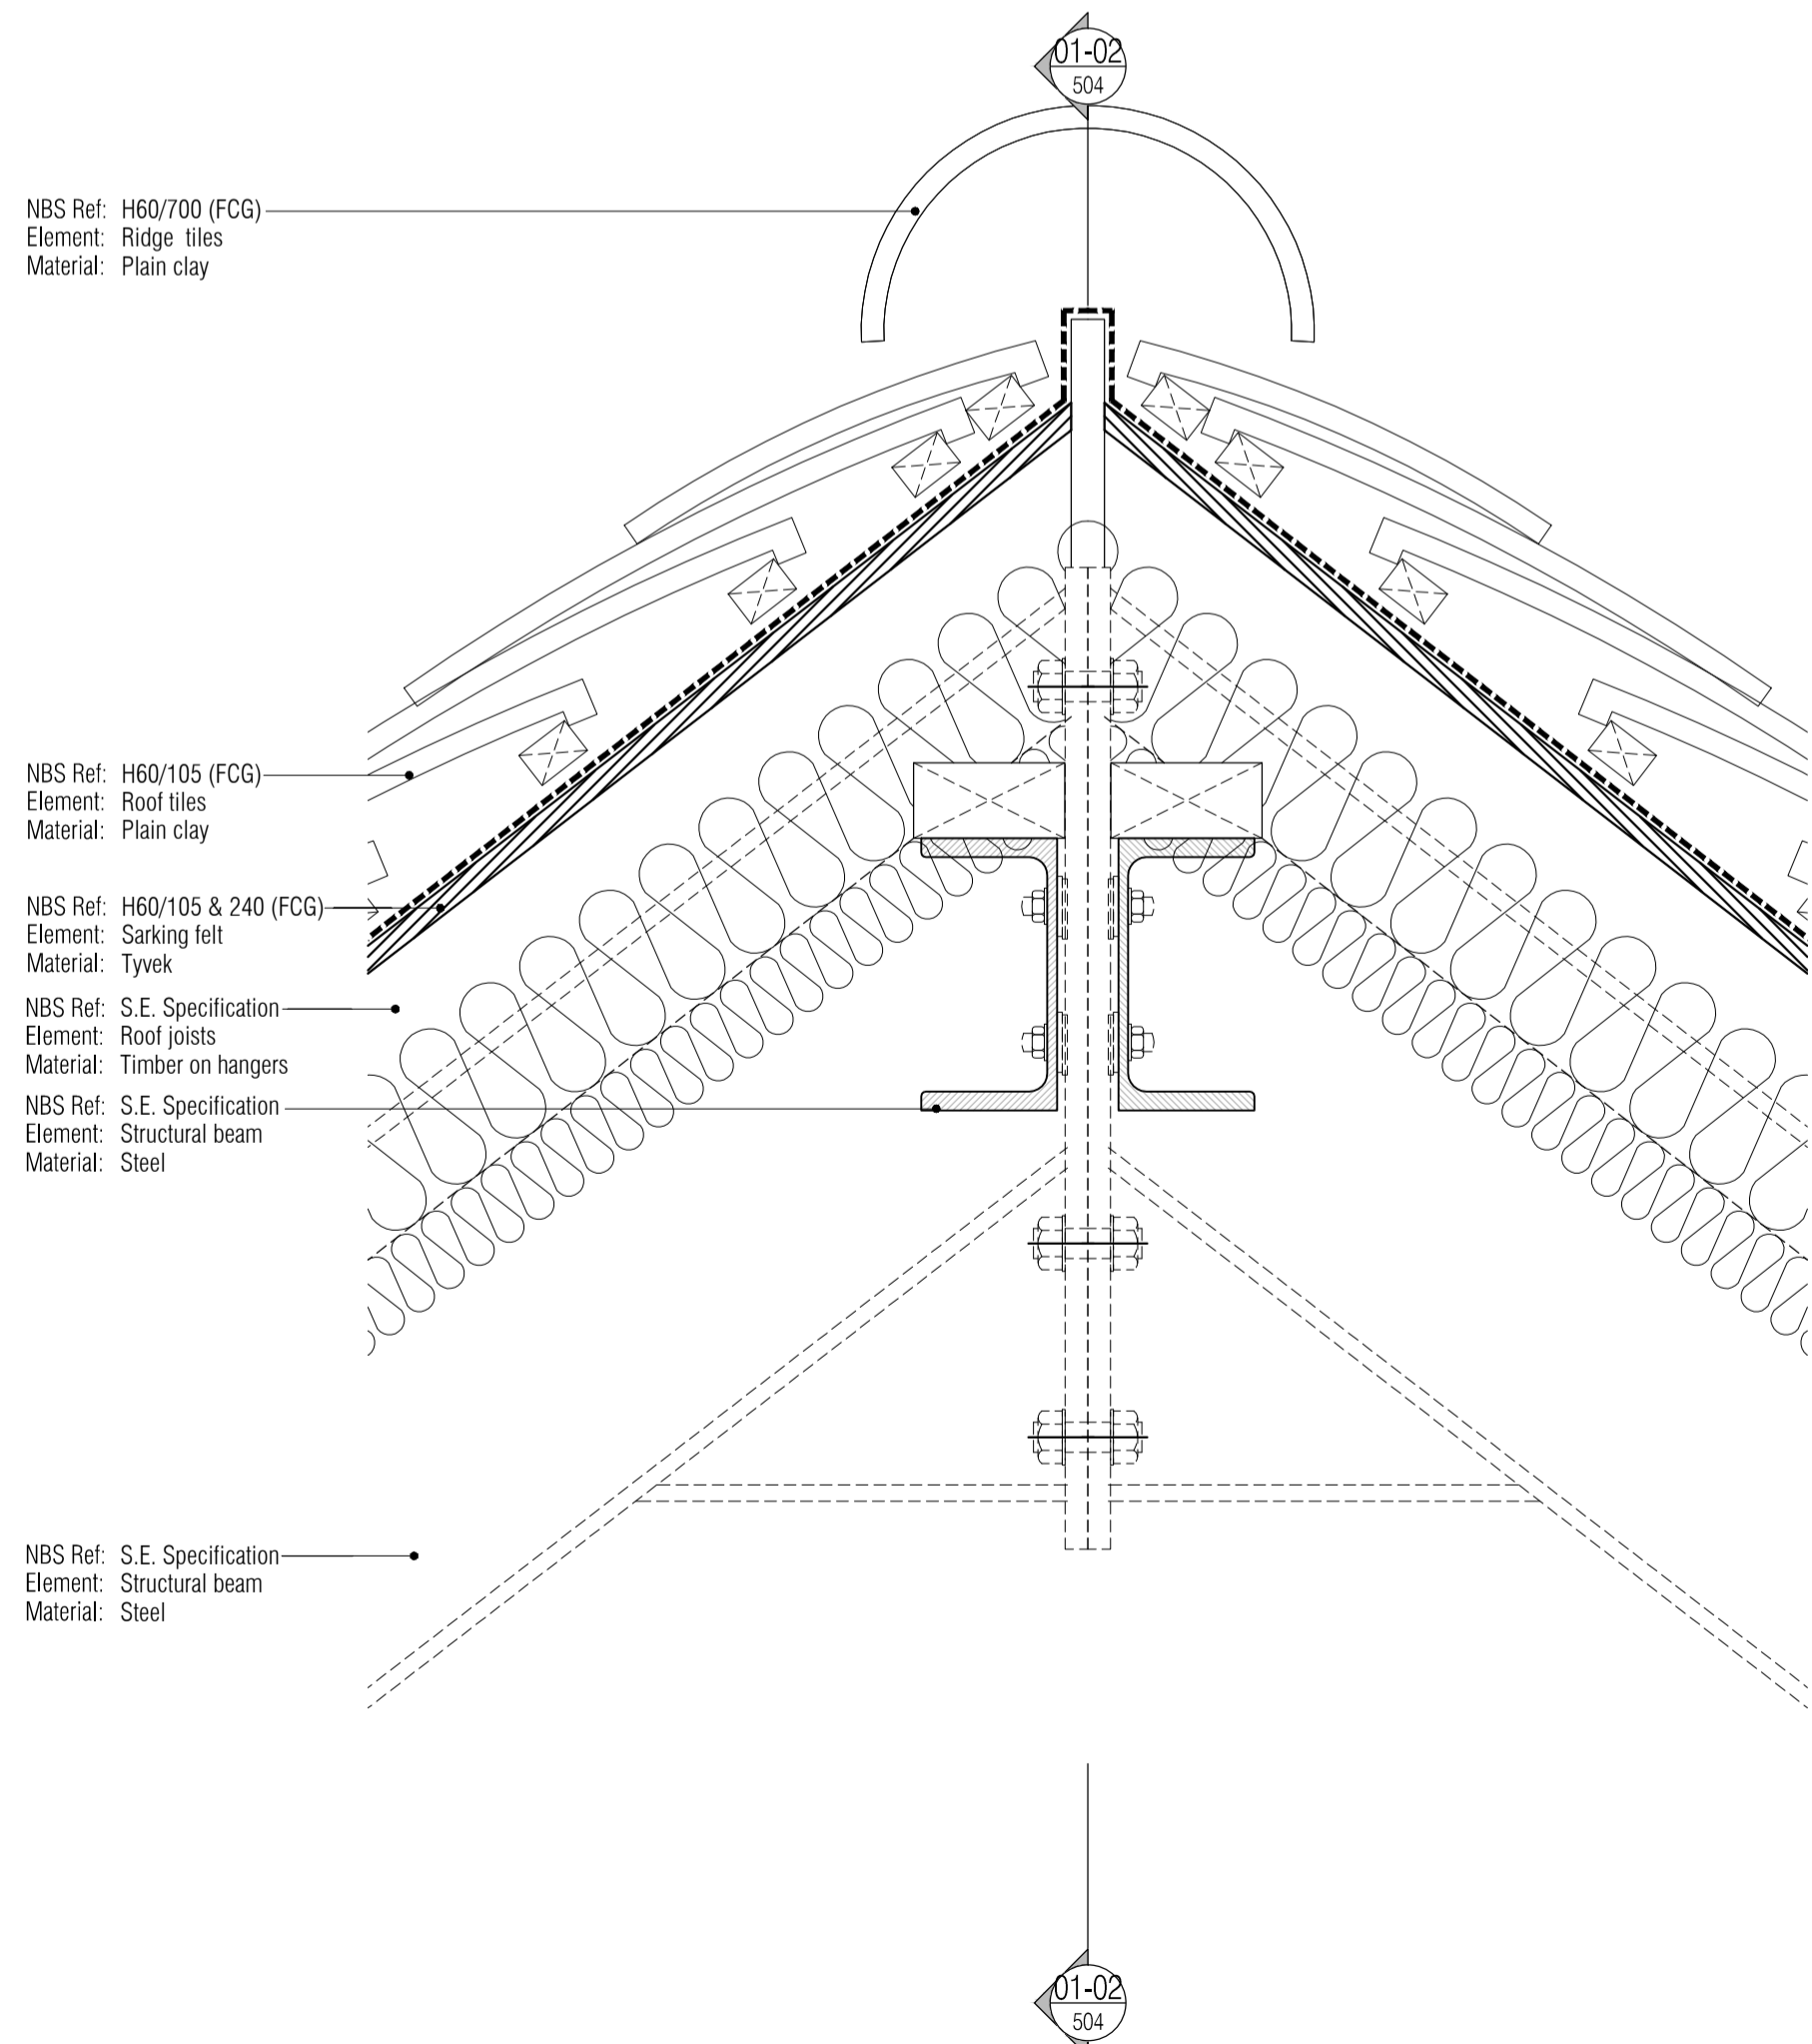


03 New Hall Extension Roof Ridge Detail
Scale: 1:5

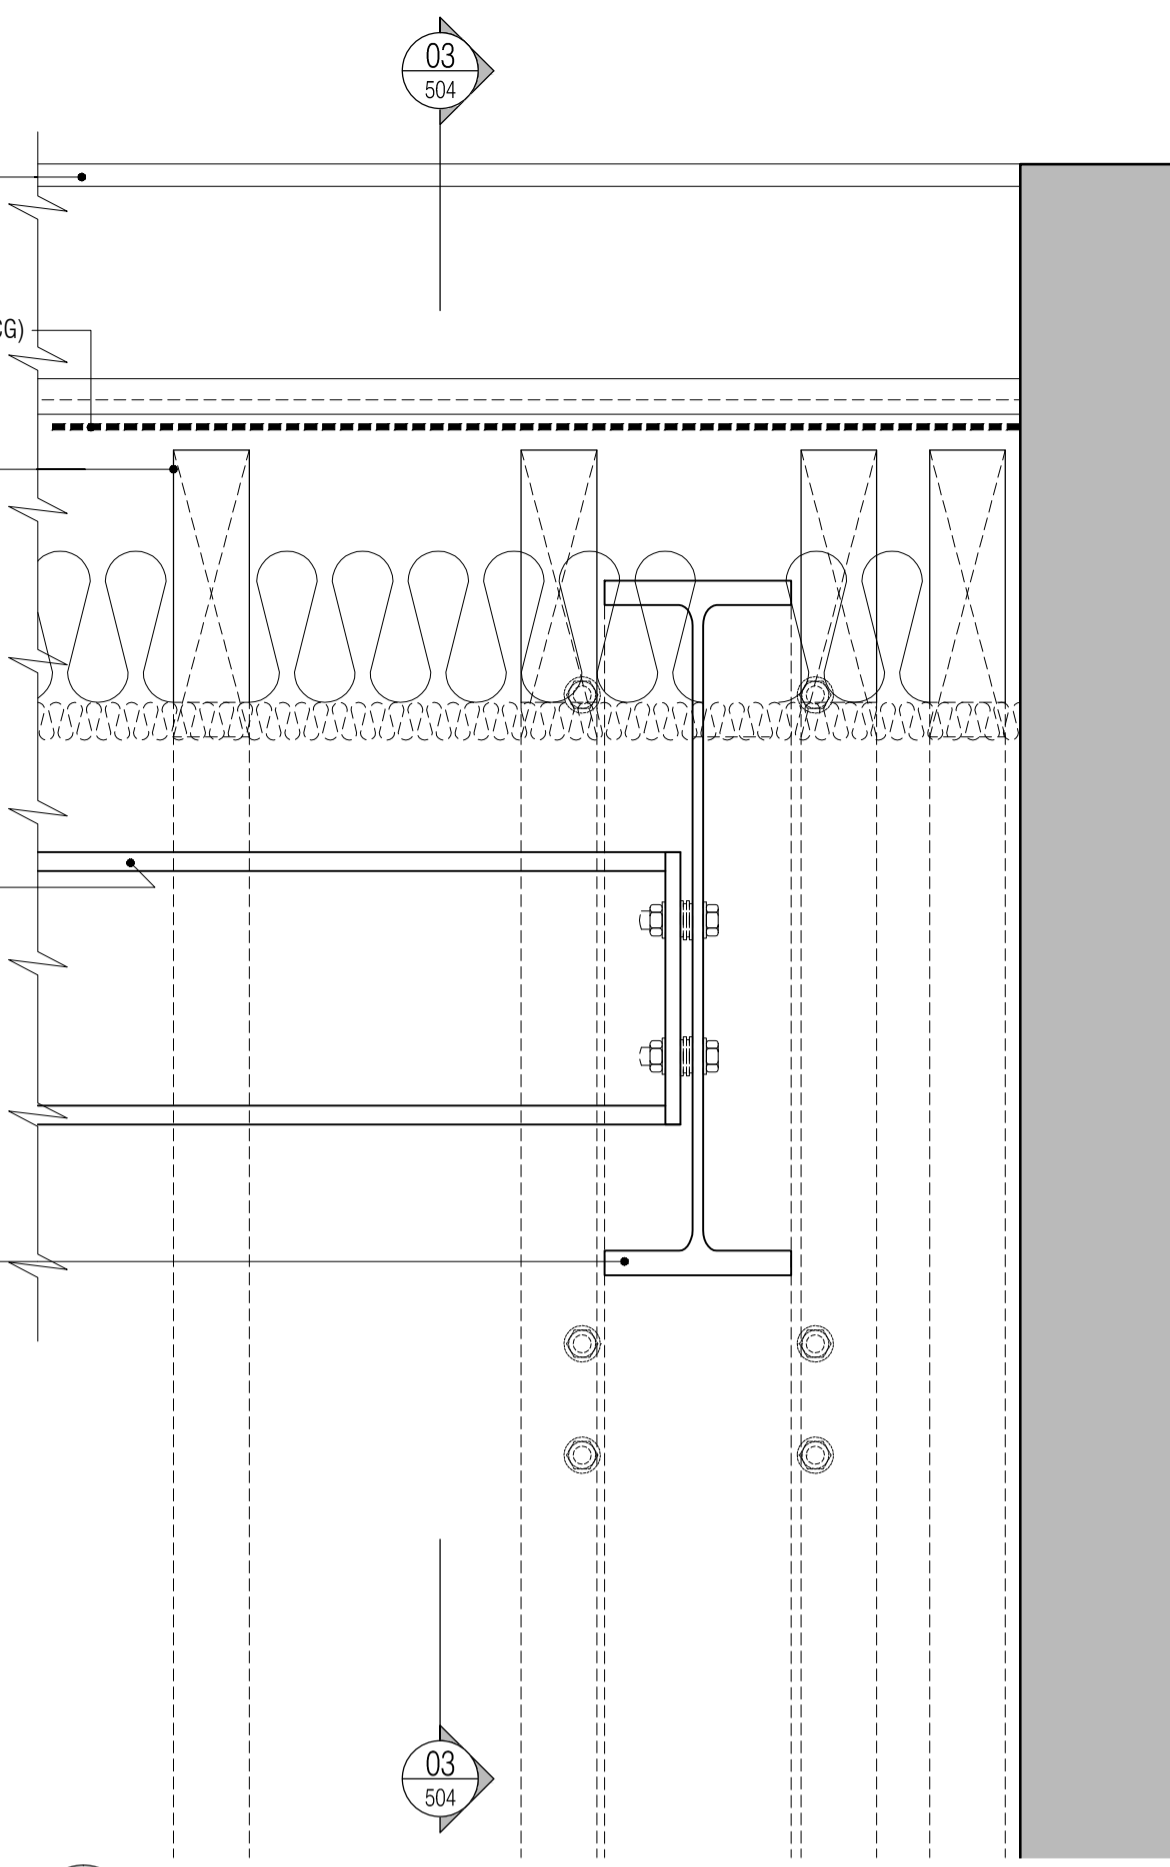

02 New Hall Extension Roof / Existing Roof Abutment Detail
Scale: 1:5

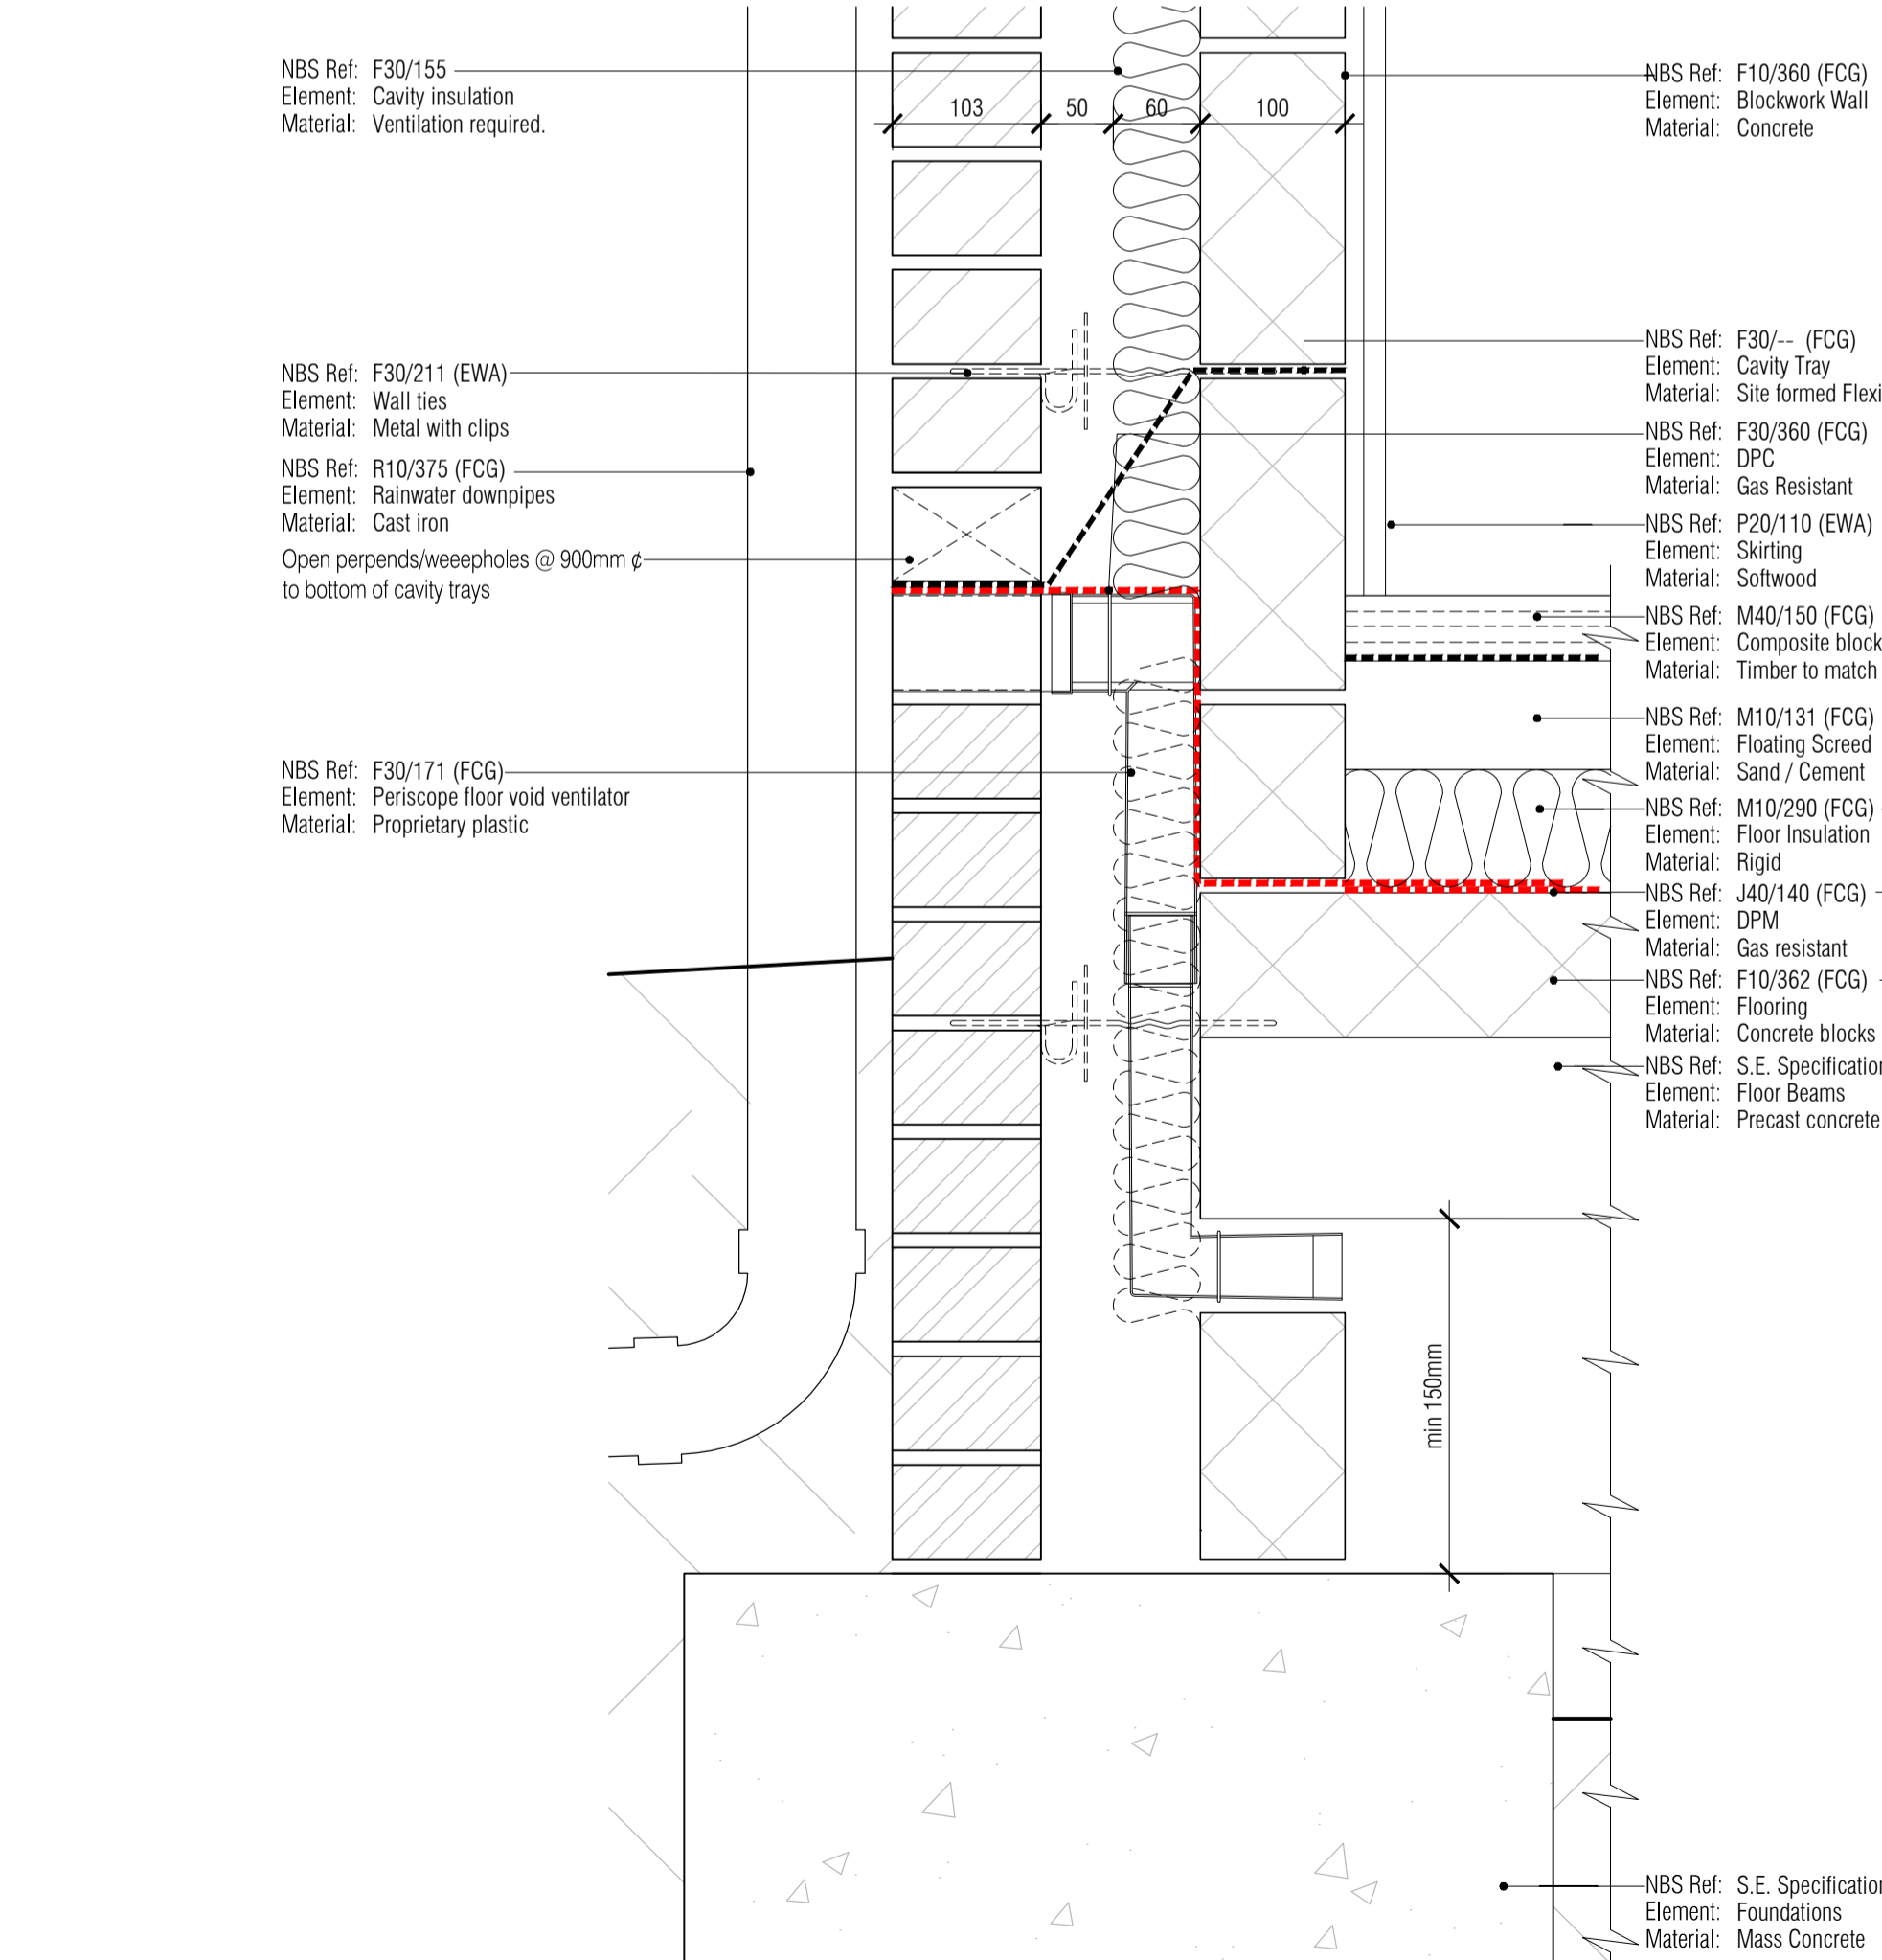

04 New Hall Extension Sprung Floor Ventilated Wall Detail
Scale: 1:5

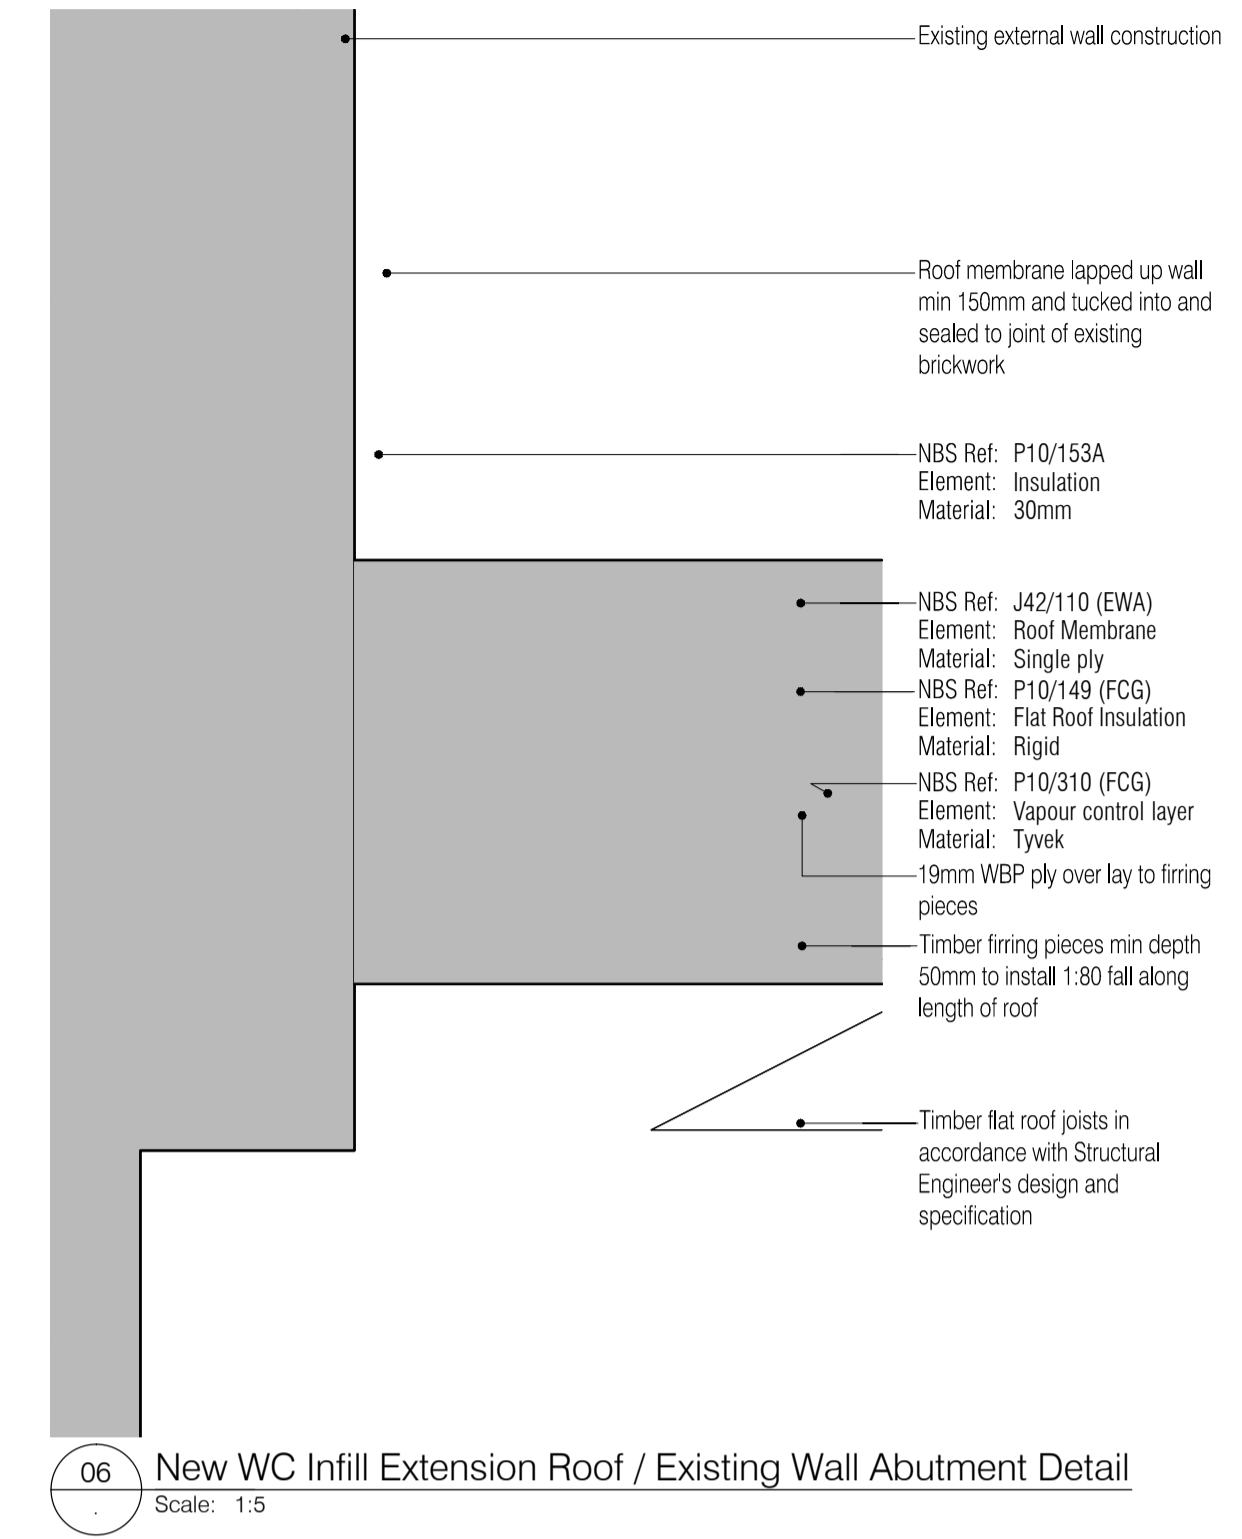

06 New WC Infill Extension Roof / Existing Wall Abutment Detail
Scale: 1:5

NOTES: Do not scale this drawing. All dimensions to be checked on site prior to commencement or manufacture.
NB: All information based on supplied third party survey information. All discrepancies to be reported to FCG immediately upon discovery.

Key Plan (n/s)

AS BUILT
DRAWING

Rev	Date	By	Clk	Comment
AB1	17.04.14	FRK	AGC	DRAWING ISSUED - AS BUILT

25 YEARS OF BRINGING IDEAS TO LIFE

ANNIVERSARY
25 YEARS
1982-2007

FRANKHAM

Frankham Consultancy Group Limited
Frankham House Wootton Business Park
Besselsleigh Road Wootton Abingdon
Oxfordshire OX13 6FD
T 01865 322500 F 01865 327393
E enquire@frankham.com
www.frankham.com

Client: **Leadbitter CONSTRUCTION**

Project Title: Whitehall Junior & Infant School
Refurbishment, Extension and New Build
Cowley Road
London Borough of Hillingdon

Drawing Title: Hall Extension
Section Details

Drawn by: RKC	Scale: 1:5@A1	Date: 03.10.12
Designed by: FCG	Checked by: JAS	Approved by: AC

File Ref: J:\000001\88-16182000\SCH001-1\NEW HALL REFURBISHMENT\06_SECTION DETAILS\AS BUILT
1:5@A1 (REV) 16.04.2014 09:08

Drawing No. 611869-A-504
Rev. AB1