



01 New Kitchen Roof Parapet Detail  
Scale: 1:5

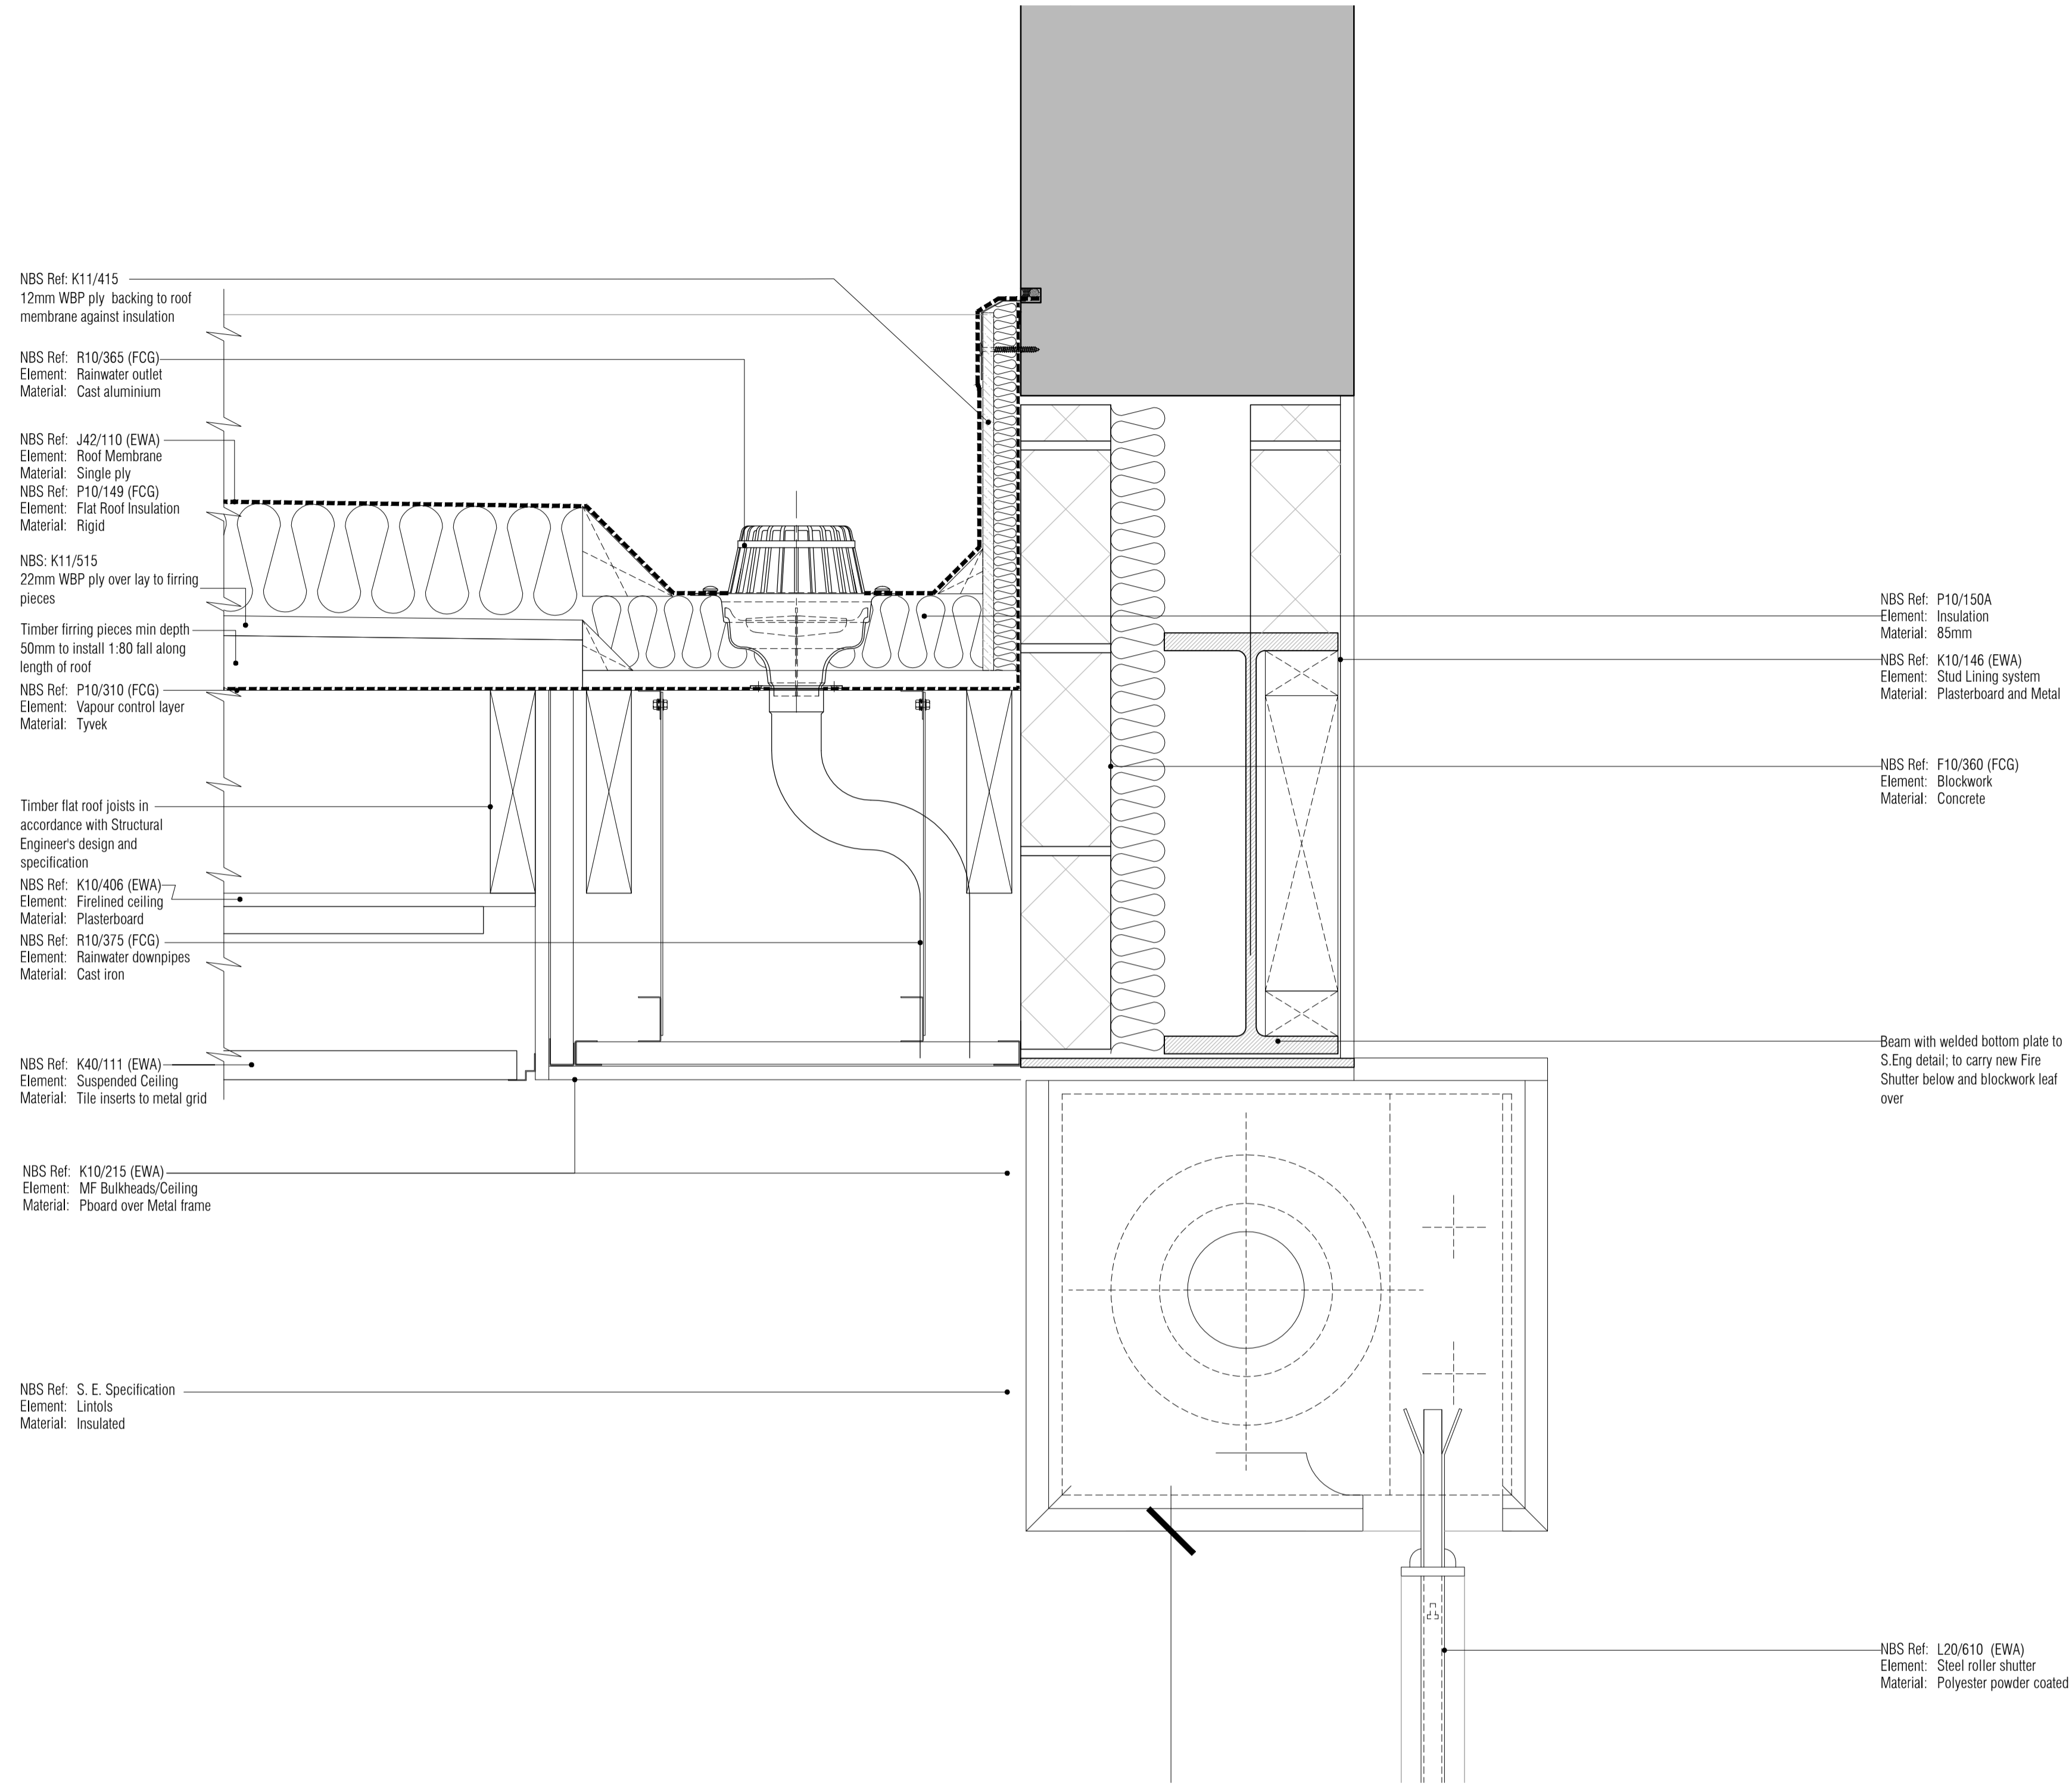

02 Existing Roof / New Kitchen Roof Abutment and Roller Shutter Detail  
Scale: 1:5

NOTES: Do not scale this drawing. All dimensions to be checked on site prior to commencement or manufacture.

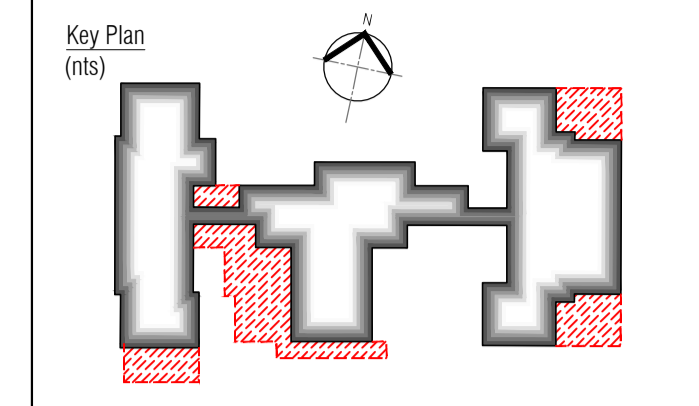

AS BUILT  
DRAWING

Rev	Date	By	Clk	Comment
AB1	17/04/14	RKC	AGC	DRAWING ISSUED - AS BUILT

25 YEARS OF BRINGING IDEAS TO LIFE

ANNIVERSARY 25 YEARS 1982-2007

**FRANKHAM**

Frankham Consultancy Group Limited

Frankham House Woolton Business Park  
Besselsleigh Road Woolton Abingdon  
Oxfordshire OX13 6FD

T 01865 322500 F 01865 327393  
E enquiry@frankham.com  
www.frankham.com

Client: **Leadbitter CONSTRUCTION**

Project Title: Whitehall Junior & Infant School  
Refurbishment, Extension and New Build  
Cowley Road  
London Borough of Hillingdon

Drawing Title: Kitchen Extension  
Roof Details

Drawn by: RKC Scale: 1:5@A1 Date: 03.10.12

Designed by: FCG Checked by: JAS Approved by: AGC

File Ref: J:\000001\88-16102001\SCHOOL-Whitehall\REFURB\ARCH\01\_01\_12\16102001\_01\_16102001.DWG - REV 01 - 00010101 14.04.24.10.49.16

Drawing No. 611869-A-505 Rev. AB1