


NOTES: Do not scale this drawing. All dimensions to be checked on site prior to commencement or manufacture.

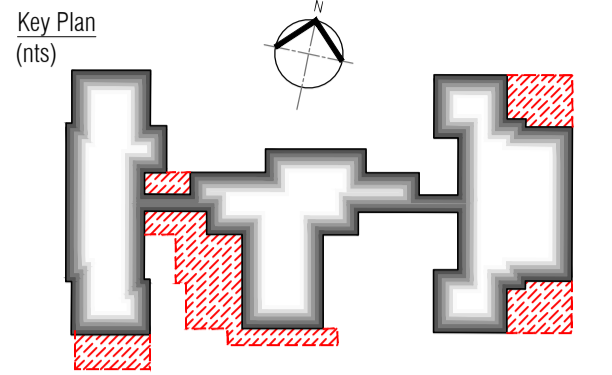

NBS Ref: B91/396A
Element: Plant enclosure
Material: Steel structure & timber
Falco Proprietary system

NBS Ref: M&E specification
Element: Ventilation turret
Material: Timber frame/louved

NBS Ref: B91/396A
Element: Plant enclosure
Material: Steel structure & timber
Falco Proprietary system

NBS Ref: L10/655 (EWA)
Element: Louvre panels
Material: PPC Aluminium

NBS Ref: M&E specification
Element: Proprietary flashing
Material: PPC aluminium

NBS Ref: L20/630A (FCG)
Element: Roof access hatch
Material: Steel

NBS Ref: S.E specification
Element: Upstands kerbs to hatch
Material: Timber

NBS Ref: J42/110 (EWA)
Element: Roof Membrane
Material: Single ply

NBS Ref: P10/149 (FCG)
Element: Flat Roof Insulation
Material: Rigid

NBS Ref: P10/310 (FCG)
Element: Vapour control layer
Material: Tyvek

NBS Ref: F10/360 (FCG)
Element: Blockwork Wall
Material: Concrete

NBS Ref: K10/406 (EWA)
Element: Firelined ceiling
Material: Plasterboard

NBS Ref: K10/215 (EWA)
Element: MF Bulkheads/Ceiling
Material: Pboard over Metal frame

NBS Ref: K40/111 (EWA)
Element: Suspended Ceiling
Material: Tile inserts to metal grid

NBS Ref: M20/210
Element: Wall covering
Material: Gypsum plaster

NBS Ref: L30/250 (EWA)
Element: Roof Access Ladder
Material: Galvanized steel

NBS Ref: L20/630A (FCG)
Element: Roof access hatch
Material: Steel

NBS Ref: S.E specification
Element: Upstands kerbs to hatch
Material: Timber

NBS Ref: J42/110 (EWA)
Element: Roof Membrane
Material: Single ply

NBS Ref: P10/149 (FCG)
Element: Flat Roof Insulation
Material: Rigid

19mm WBP ply over lay to furring pieces
Timber furring pieces min depth 50mm to install 1:80 fall along length of roof

NBS Ref: P10/310 (FCG)
Element: Vapour control layer
Material: Tyvek

Timber flat roof joists in accordance with Structural Engineer's design and specification

NBS Ref: K10/406 (EWA)
Element: Firelined ceiling
Material: Plasterboard

NBS Ref: K10/215 (EWA)
Element: MF Bulkheads/Ceiling
Material: Pboard over Metal frame

NBS Ref: K40/111 (EWA)
Element: Suspended Ceiling
Material: Tile inserts to metal grid

01 New Kitchen Roof Hatch Kerb Upstand Detail
Scale: 1:5

02 New Kitchen Roof Hatch Detail
Scale: 1:5

03 New Kitchen Roof Louvred Ventilation Turret Detail
Scale: 1:5

Rev	Date	By	Clk	Comment
AB1	17/04/14	RKC	AGC	DRAWING ISSUED - AS BUILT

25 YEARS OF BRINGING IDEAS TO LIFE

FRANKHAM

Frankham Consultancy Group Limited
Frankham House Woolton Business Park
Besselsleigh Road Woolton Abingdon
Oxfordshire OX13 6FD
T 01865 322500 E 01865 327393
enquire@frankham.com www.frankham.com

Client: **Leadbitter** CONSTRUCTION

Project Title: Whitehall Junior & Infant School
Refurbishment, Extension and New Build
Cowley Road
London Borough of Hillingdon

Drawing Title: Kitchen Extension
Roof Details

Drawn by: RKC	Scale: 1:5@A1	Date: 03.10.12
Designed by: JAS	Checked by: JAS	Approved by: AGC

File Ref: J:\000001\NBS-HILLINGDON\SCHOOL-NEW\KITCHEN\ROOFS\KITCHEN\01-01-17-18-19-2180-21
--