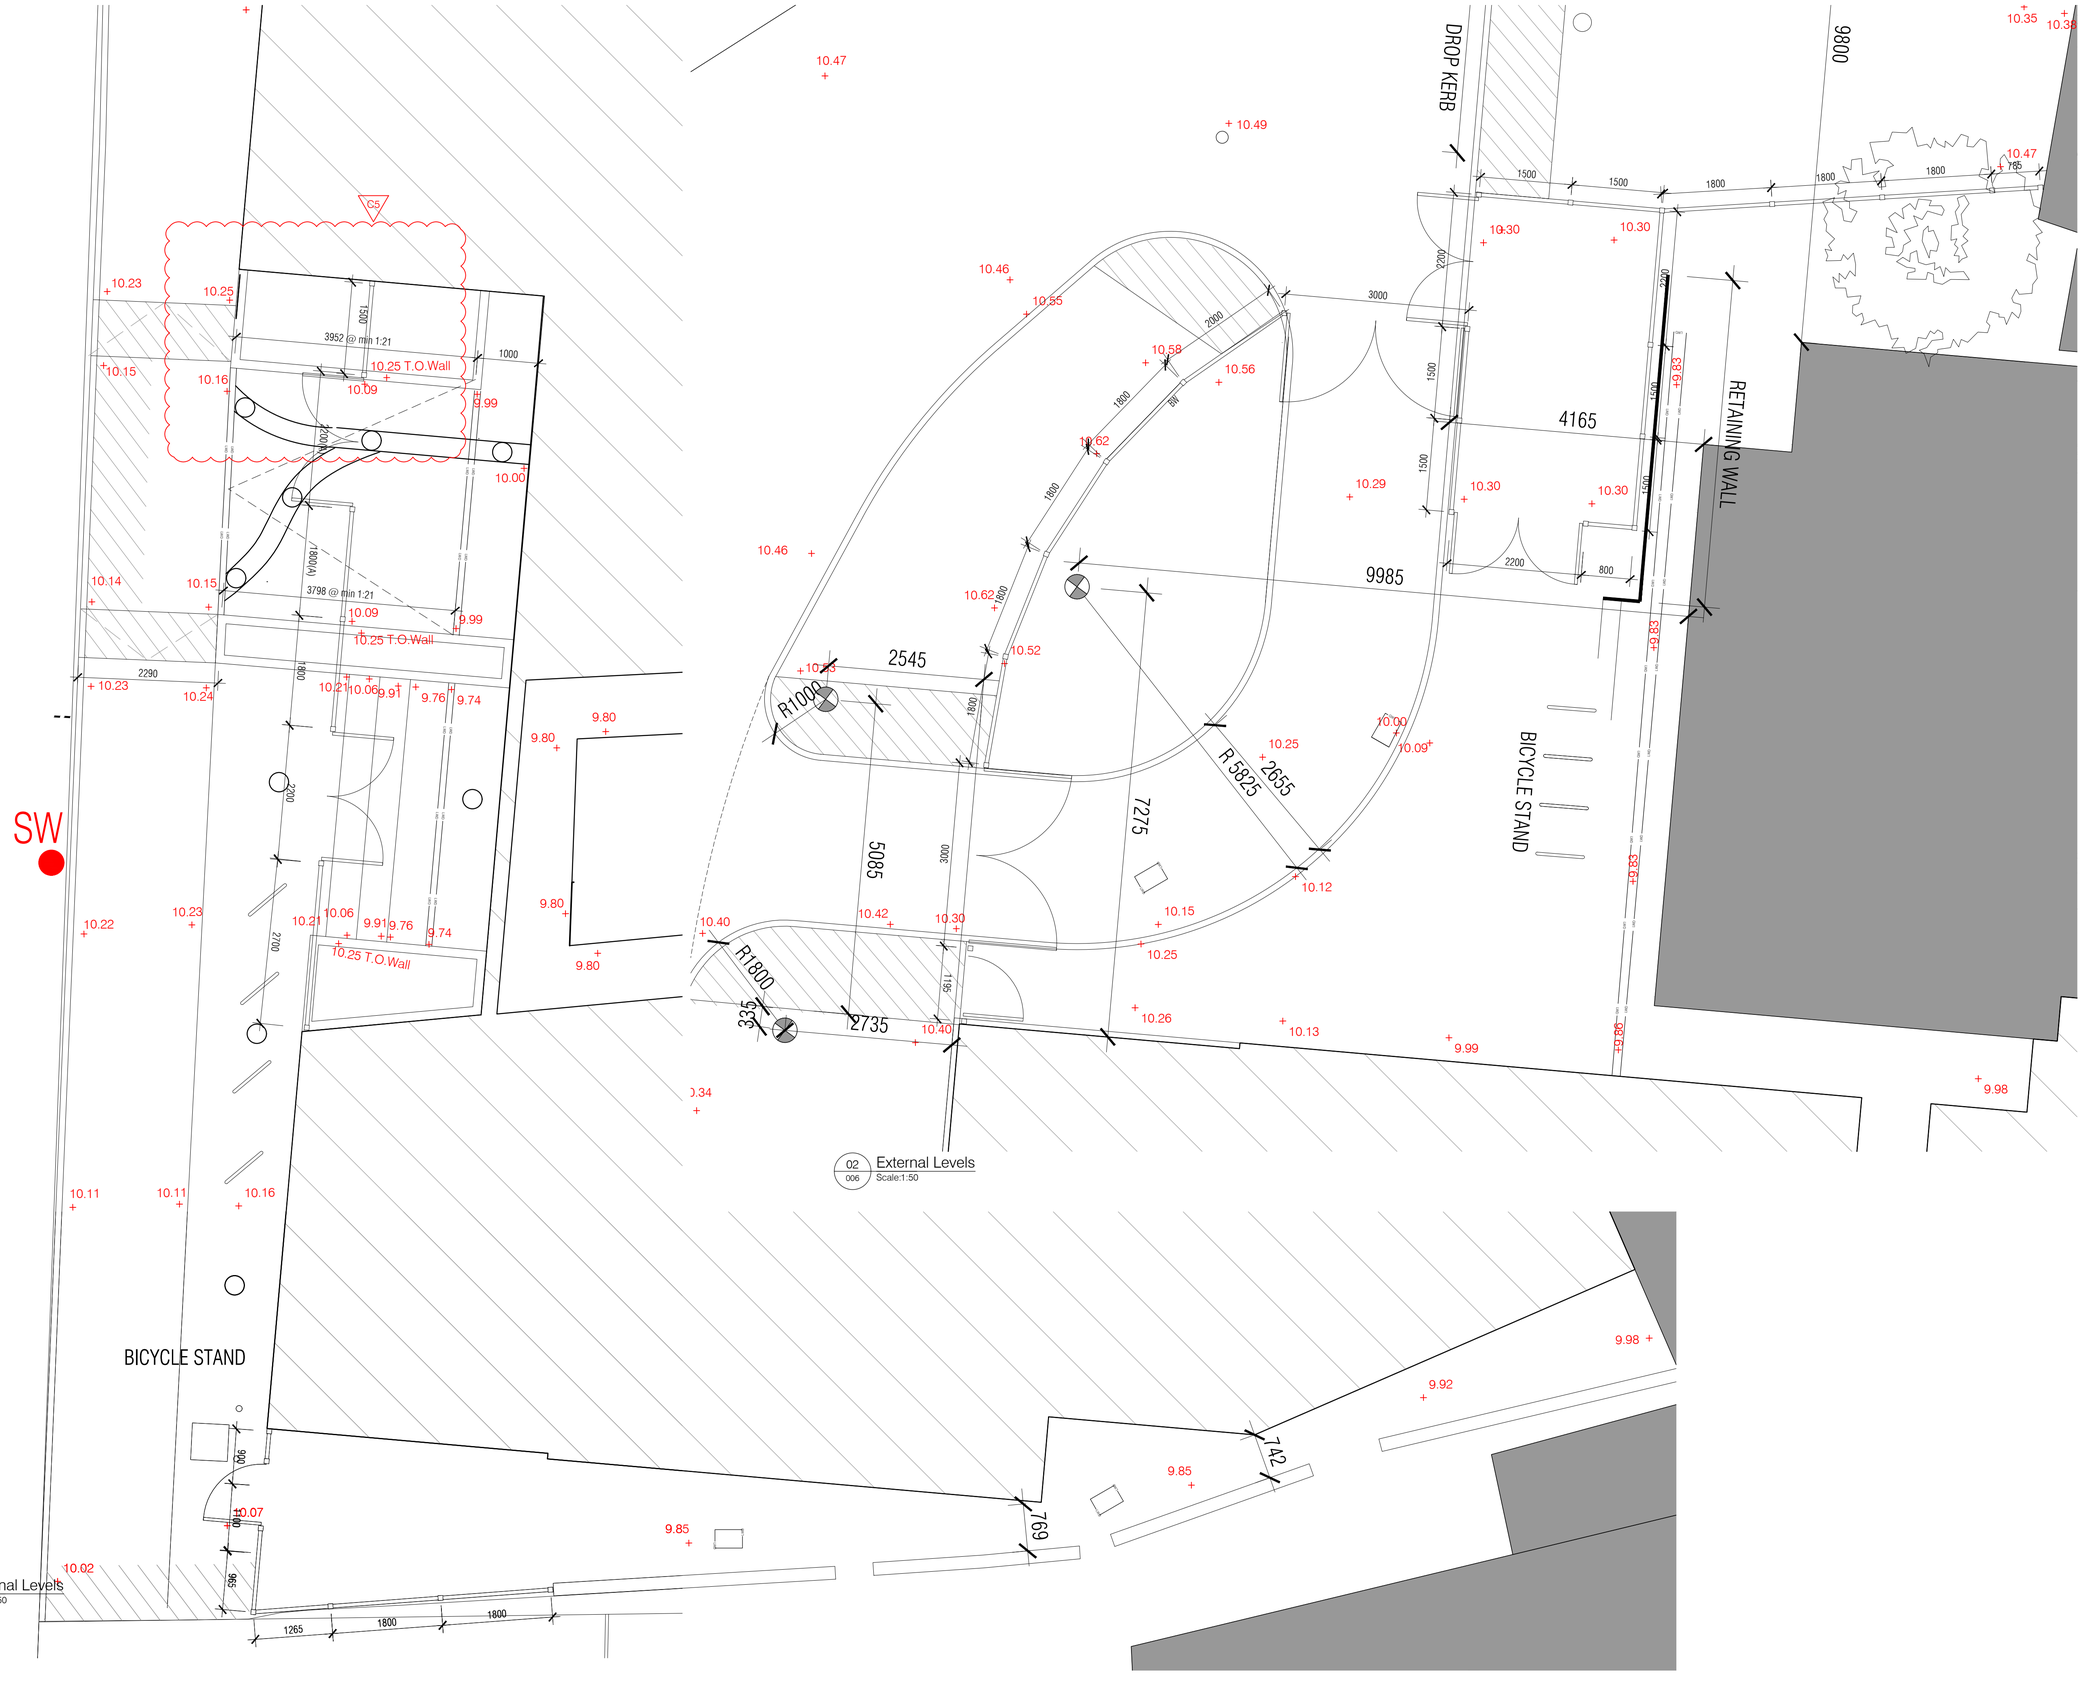

01 External Levels
006 Scale:1:50

02 External Levels
006 Scale:1:50

NOTES: Do not scale this drawing. All dimensions to be checked on site prior to commencement or manufacture.

Key Plan
(nts)

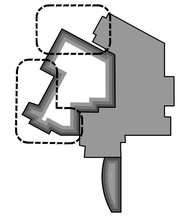

Site Legend

- Denotes new brick pavers
- Denotes grass
- Denotes highways paving slabs
- Denotes tarmac footpath
- Denotes new car park surfacing
- E Denotes Electrical car charging points. See Electrical Engineers specification
- Denotes tactile paving at vehicle crossing points
- Denotes gravel with terram underlay
- Denotes Electrical Car charging point
- Denotes lampost car park lighting

Scale Bar

0 2 4 6 1:100
0 2 4 6 8 10 12 1:200

ISSUED FOR CONSTRUCTION

Rev	Date	By	Chk	Comment
C5	29.04.29	CH	AC	Fence line adjusted
C4	24.04.14	CH	AC	Paving adjusted
C3	26.03.14	CH	AC	Bin store adjusted
C2	13.03.14	CH	AC	Binstore adjusted
C1	03.07.13	RKC	JAS	Issued for CONSTRUCTION

BRINGING IDEAS TO LIFE

FRANKHAM

Frankham Consultancy Group Limited
21 Perrymount Road
Haywards Heath RH16 3TP
t 01444 444900 f 01444 455642
enquire@frankham.com
www.frankham.com

Client
Ealing
www.ealing.gov.uk

Project Title
Dominion Arts Centre
Southall
London

Drawing Title
Proposed
External Works Plan
Levels

Drawn by:	Scale:	Date:
RKC	1:50@A1	24.04.13
Designed by:	Checked by:	Approved by:
FCG	-	-

File Ref.: X:\2008\2134\01 - LB EALING - DOMINION ARTS CENTRE\ARCHIVE_BIM_BLOCK AND SITE PLANS\ 20:06:11 13:28:26
2134\01-A-006.DWG - 2008112\2\01

Drawing No.	Rev.
224970-A-006	C5