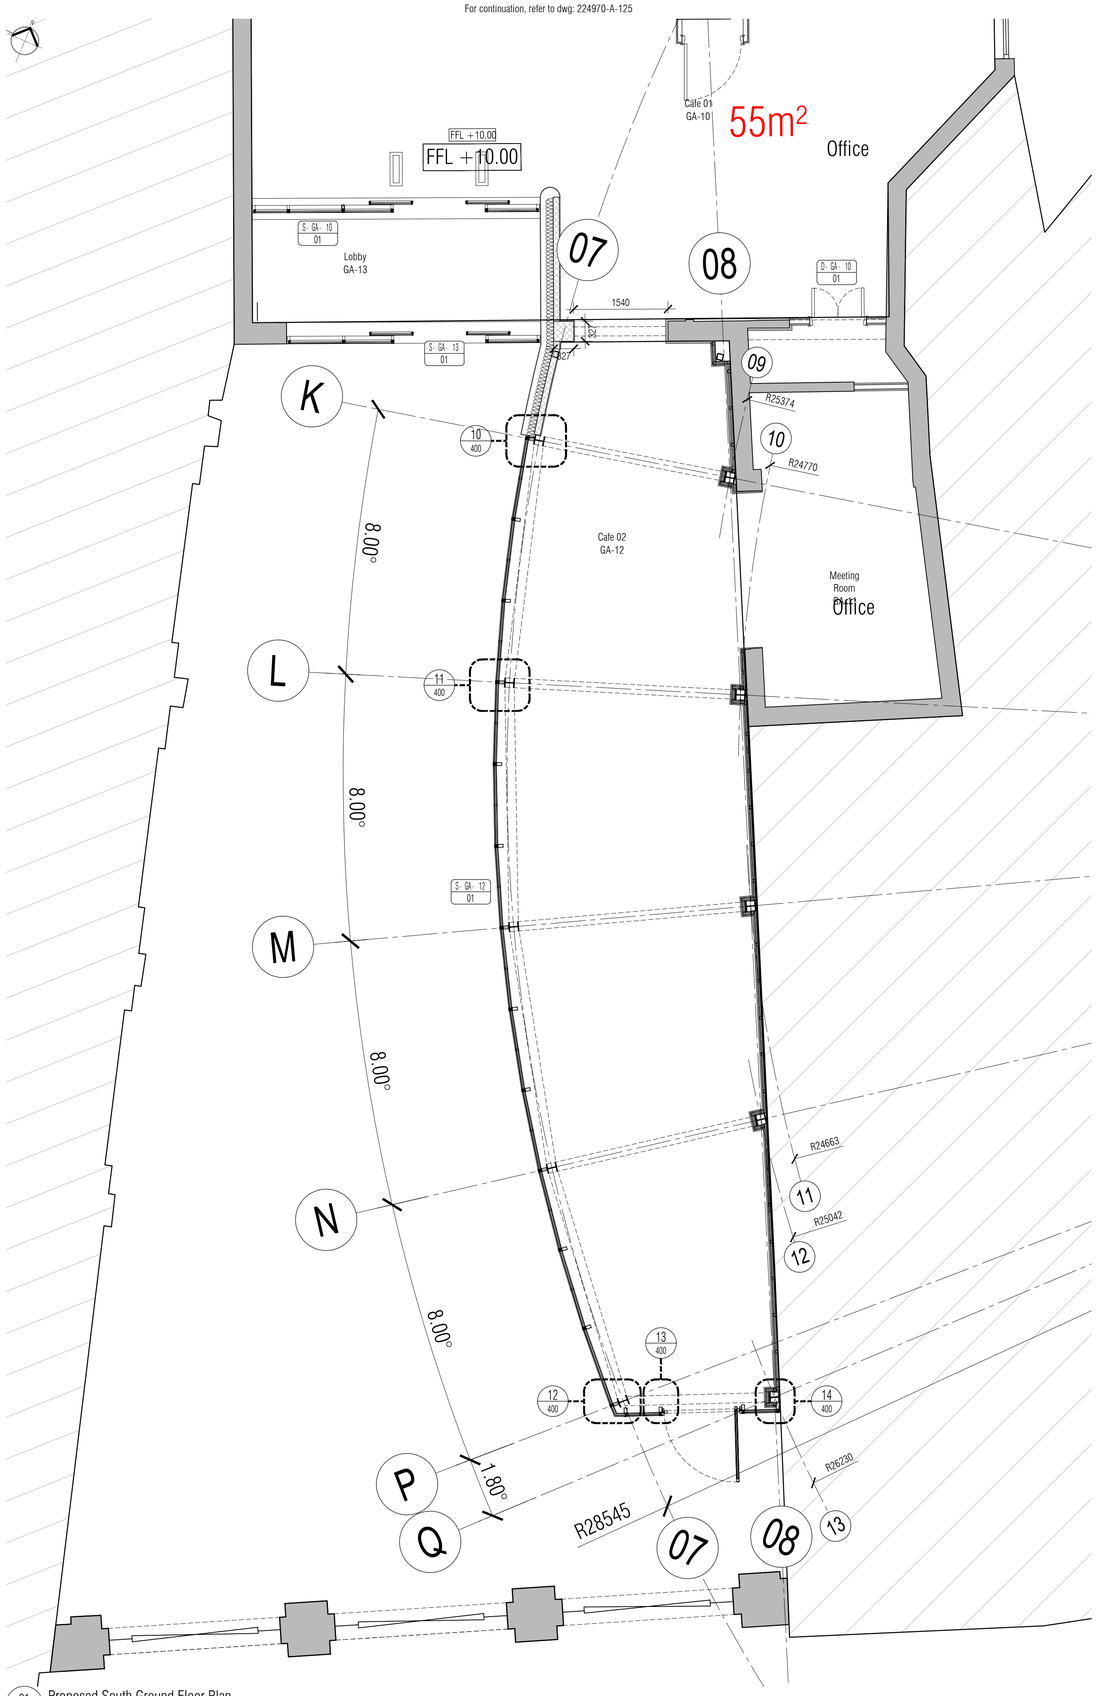

01 Proposed South Ground Floor Plan
Scale: 1:50

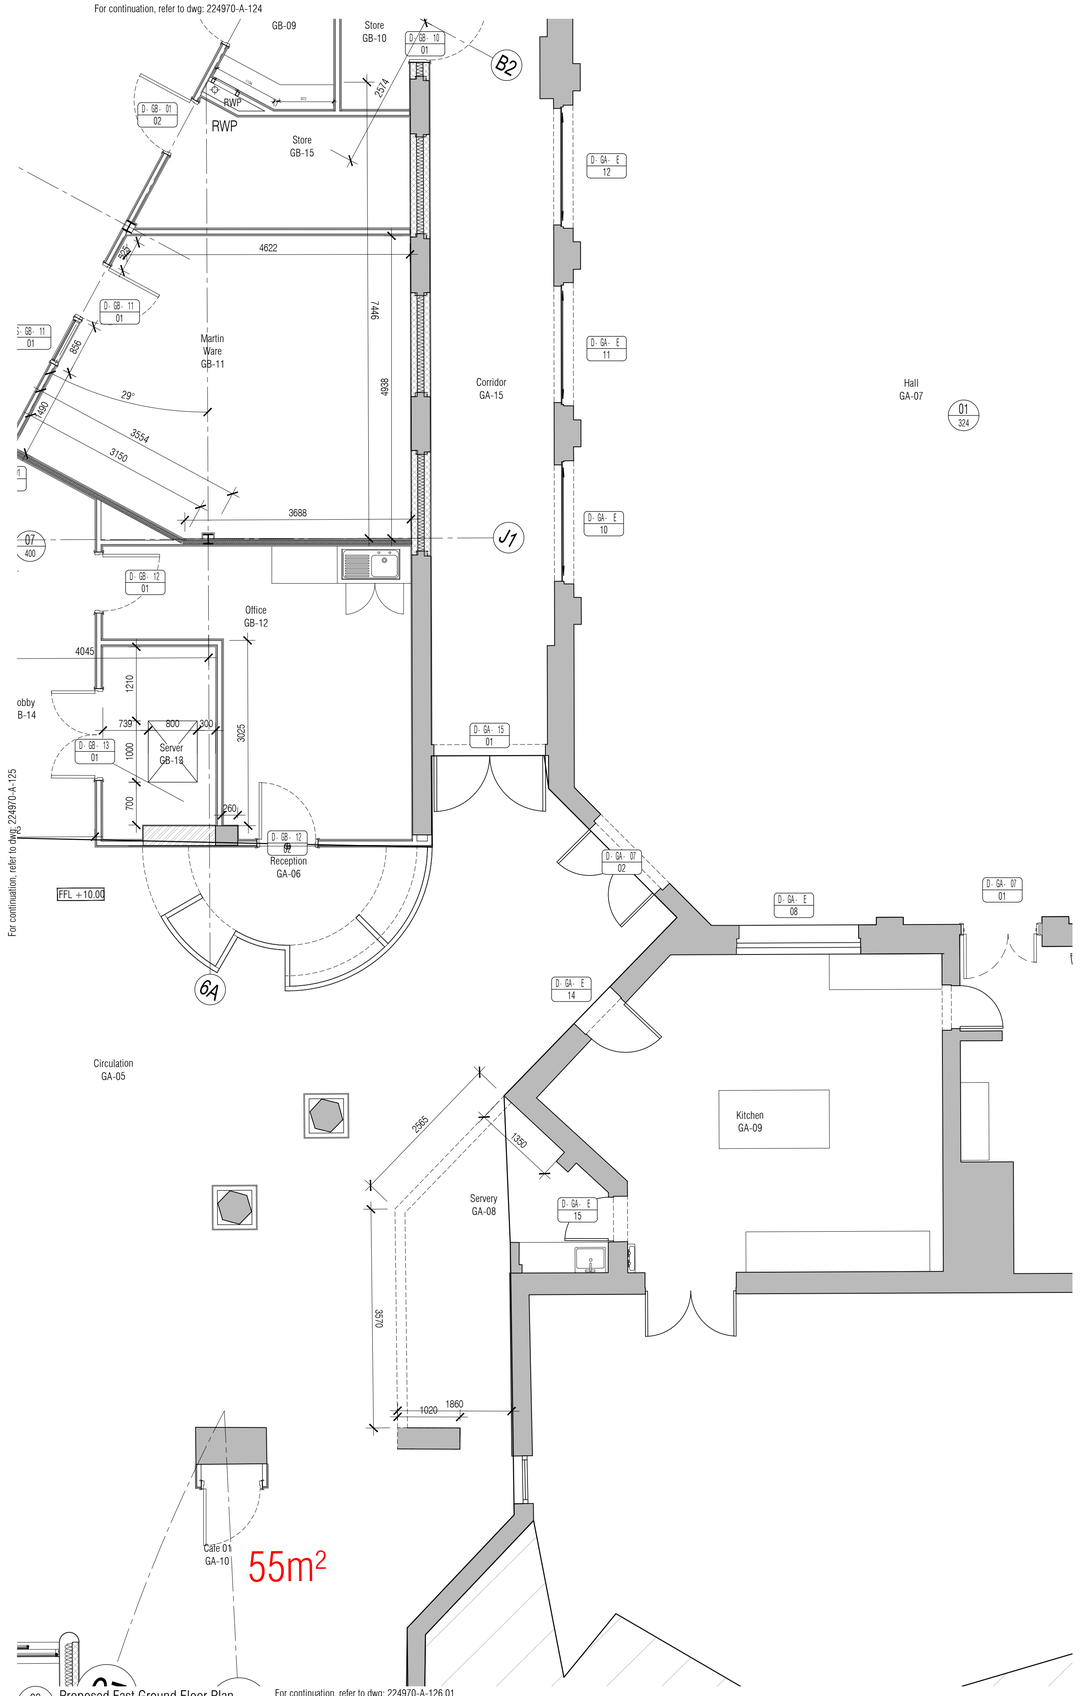

02 Proposed East Ground Floor Plan
Scale: 1:50

NOTES: Do not scale this drawing. All dimensions to be checked on site prior to commencement or manufacture.

Key Plan
(nts)

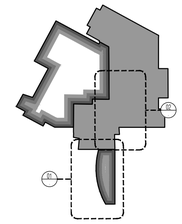

All steelwork to be erected in accordance with Structural Engineer's design and specification. For all steelwork information inc. bracing, refer to Structural Engineers drawings

Opening Reference Legend

Denotes floor level — Denotes room n°

Denotes opening type: Door, Window, Screen — D - F 13 01 — Denotes opening n°

ISSUED FOR CONSTRUCTION

Rev	Date	By	Chk	Comment
C1	03.07.13	RKC	JAS	Issued for CONSTRUCTION

BRINGING IDEAS TO LIFE

FRANKHAM

Frankham Consultancy Group Limited
21 Perrymount Road
Haywards Heath RH16 3TP
t 01444 444900 f 01444 455642
enquire@frankham.com
www.frankham.com

Client
Ealing
www.ealing.gov.uk

Project Title
Dominion Arts Centre
Southall
London

Drawing Title
Proposed
South & East Ground Floor
General Arrangement Plan
3 of 3

Drawn by:	Scale:	Date:
RKC	1:50@A1	25.04.13
Designed by:	Checked by:	Approved by:
FCG	CDH	AGC

File Ref.: X:\2009\03\224970 - EALING - DOMINION ARTS CENTRE\ARCH\DE_RB_LOCATION PLANS AND GA-\[224970-A-126.DWG - 25/06/13 13:01:52]

Drawing No. 224970-A-126
Rev. C1