



01 Ground Floor Setting Plan
Scale: 1:50

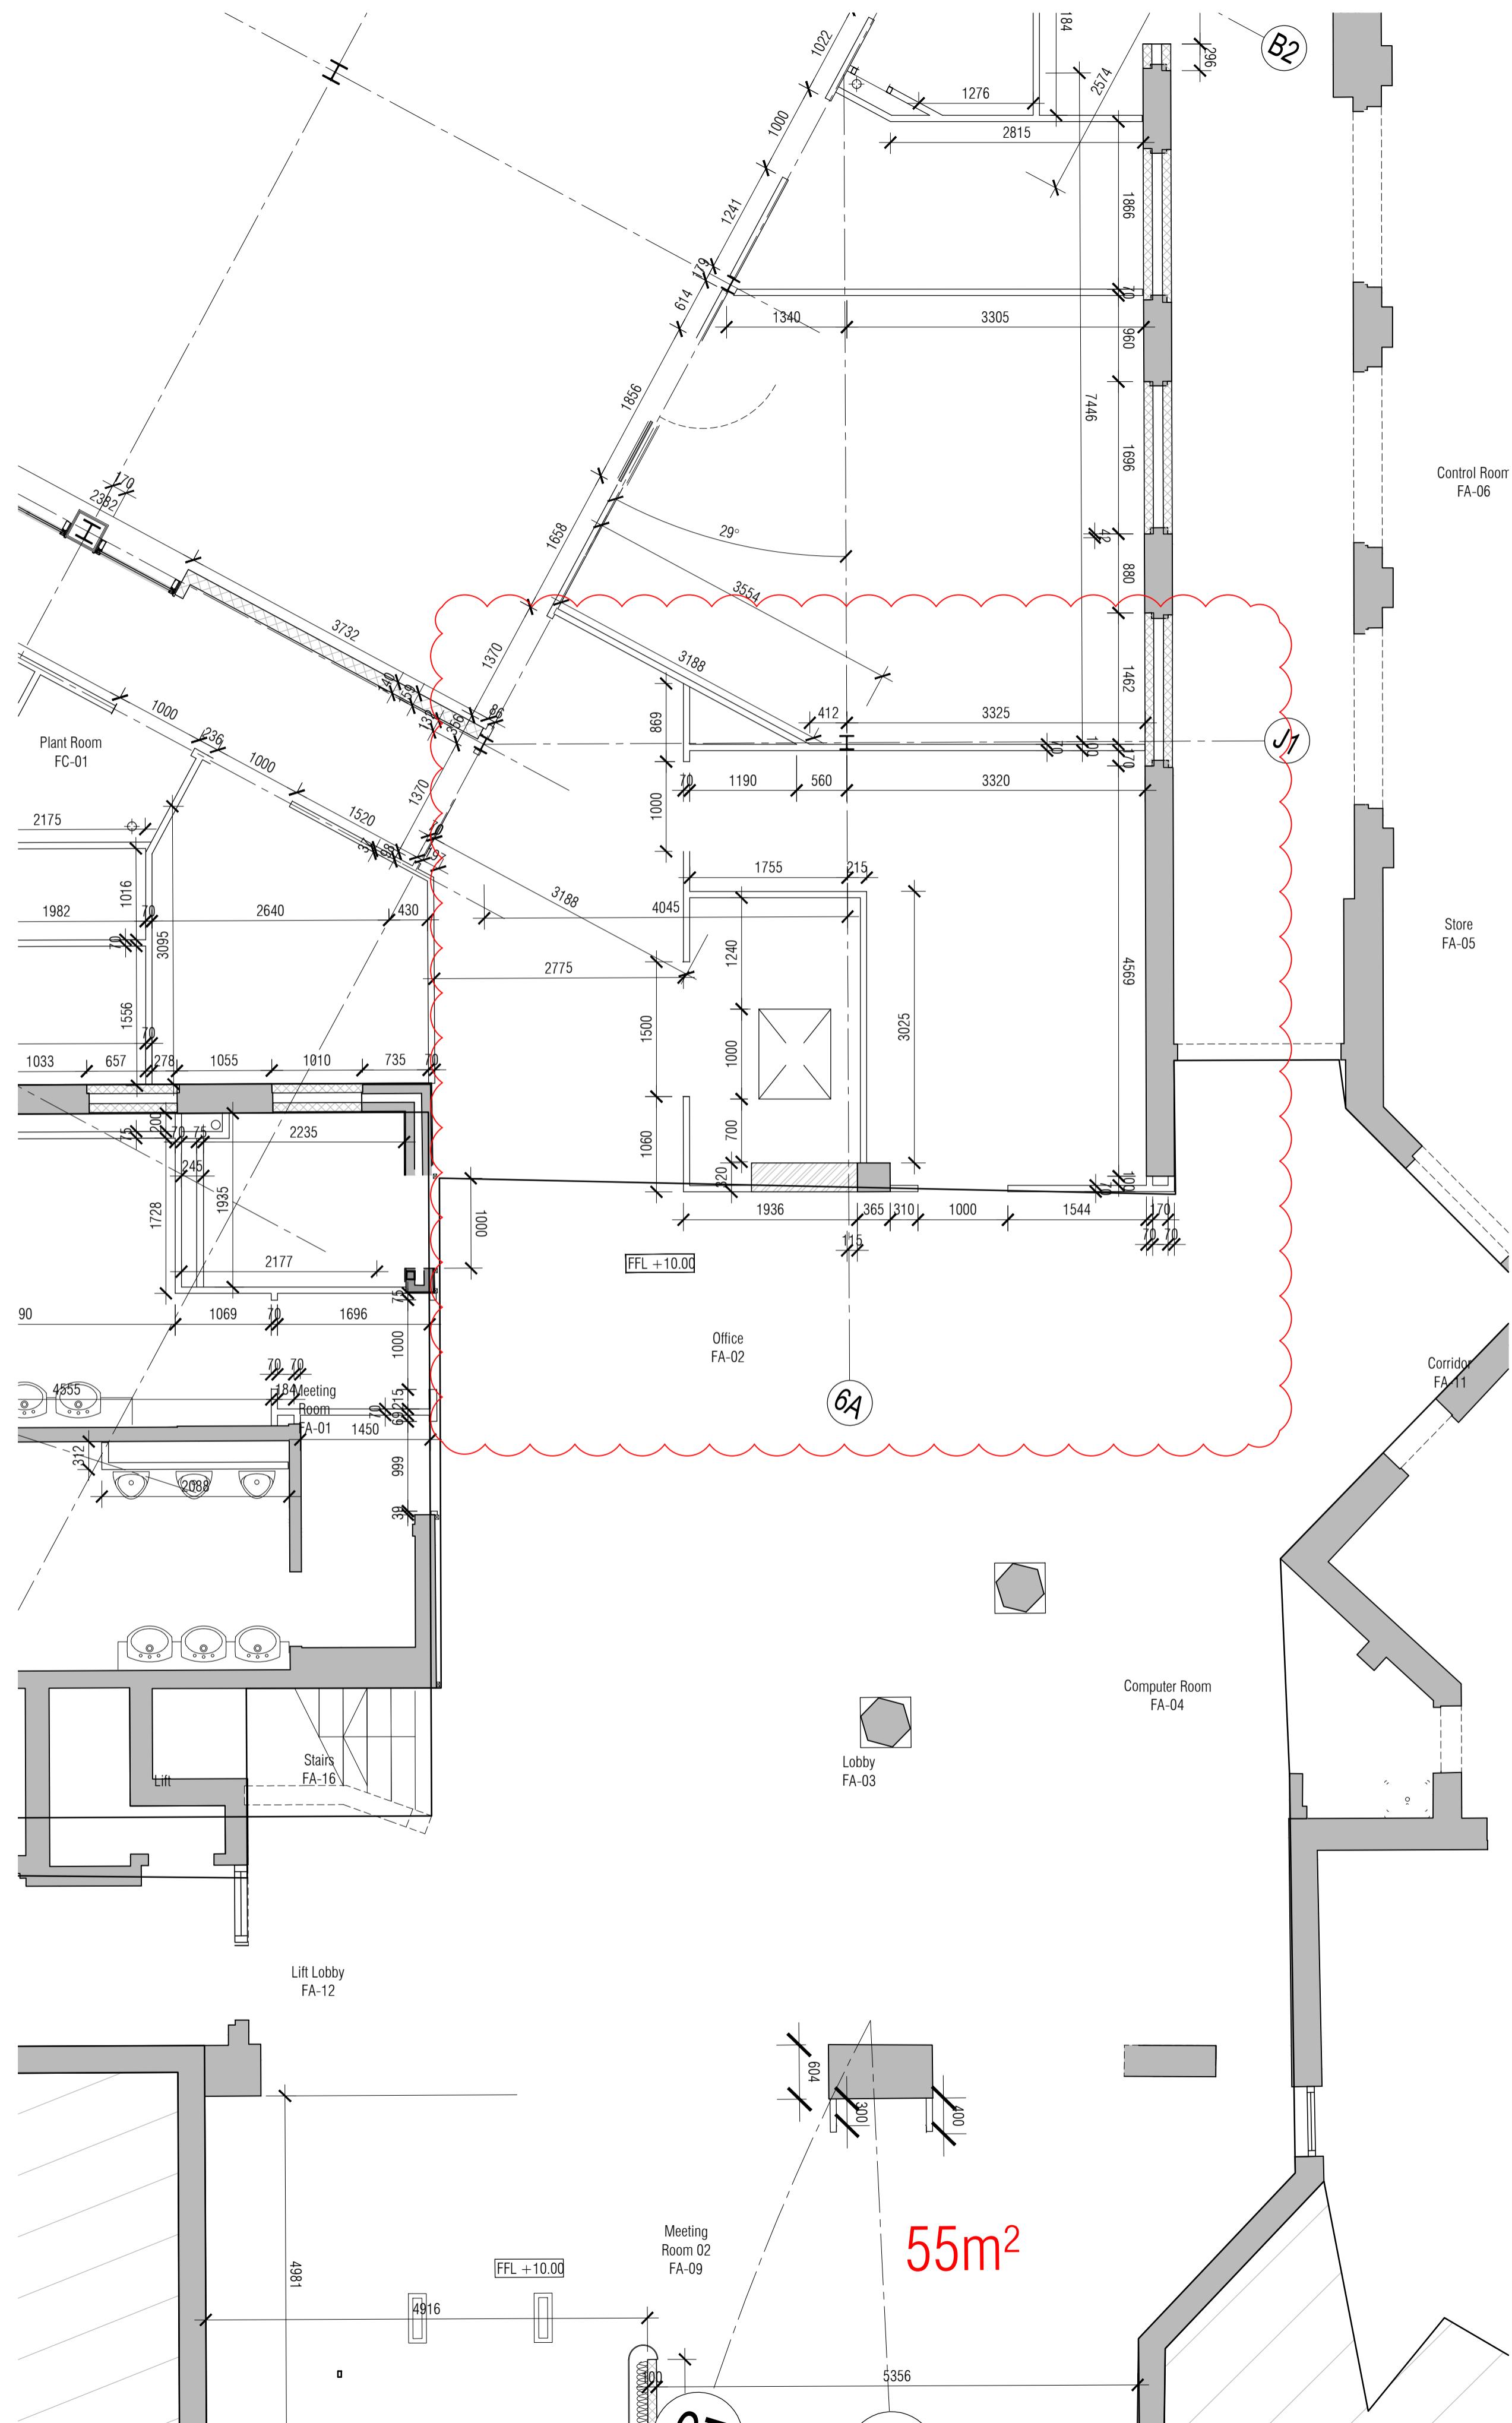

02 Ground Floor Setting Plan
Scale: 1:50

NOTES: Do not scale this drawing. All dimensions to be checked on site prior to commencement or manufacture.

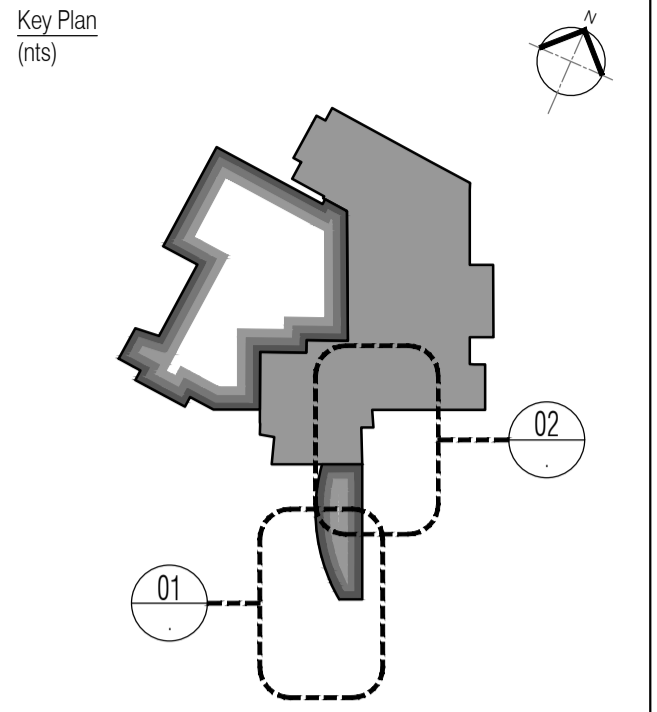

All steelwork to be erected in accordance with Structural Engineer's design and specification. For all steelwork information inc. bracing, refer to Structural Engineers drawings

ISSUED FOR CONSTRUCTION

Rev	Date	By	CHK	Comment
C4	24.01.14	CH	AC	Server Room adapted
C3	23.01.14	CH	AC	Server Room adapted
C2	23.01.14	CH	AC	Server Room adapted
C1	17.07.13	PR	AC	DRAWING ISSUED FOR CONSTRUCTION

BRINGING IDEAS TO LIFE

FRANKHAM

Frankham Consultancy Group Limited
21 Perrymount Road
Haywards Heath RH16 3TP
t 01444 444900 f 01444 455642
enquiries@frankham.com
www.frankham.com

Client

Ealing
www.ealing.gov.uk

Project Title

Dominion Arts Centre
Southall
London

Drawing Title

Proposed
Ground Floor Setting Out Plan
3 of 3

Drawn by: RKC	Scale: 1:50@A1	Date: 21.02.13
Designed by: FCG	Checked by:	Approved by:

File Ref.:	© COPYRIGHTED - UNLAWFUL TO REPRODUCE OR TRANSMIT IN ANY FORM OR BY ANY MEANS, ELECTRONIC OR MECHANICAL, INCLUDING PHOTOCOPYING, RECORDING, OR BY ANY INFORMATION STORAGE AND RETRIEVAL SYSTEM.	20.06.11 13:27:54
Drawing No. 224970-A-132	Rev. C4	