




For continuation, please refer to dwg: 224970-A-160

NOTES: Do not scale this drawing. All dimensions to be checked on site prior to commencement or manufacture.

Key Plan (n/s)

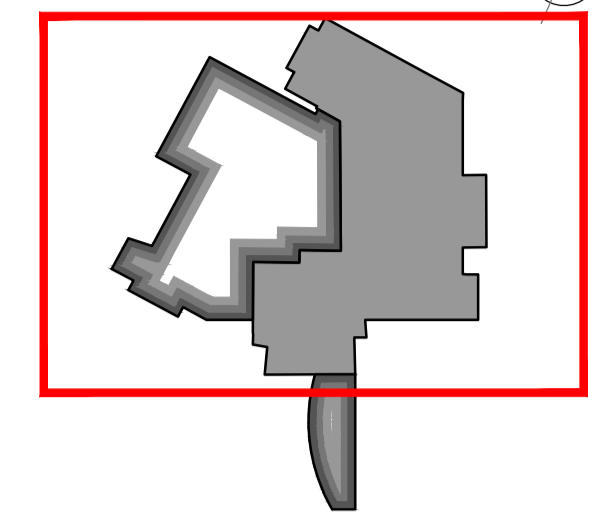

Fire Strategy Key

- FR 30 Denotes 30 minute fire rating partition
- FR 30 Denotes cavity barriers to edge floor voids
- FE Denotes Fire Exit. Refer to door schedule for fire rating of doors
- OCCUPANCY Denotes occupancy number for the room

Refer also to the following FCG drawings:  
 For GA Plans, refer to drawings A-100-Series;  
 For GA Sections, refer to drawings A-200-Series;  
 For GA Elevations, refer to drawings A-300-Series;  
 For Acoustic Strategy, refer to drawings A-150-Series;  
 For Internal Partition Strategy, refer to drawings A-170-Series;  
 For Builders Work, refer to drawings A-180-Series;  
 Refer also to detailed drawings generally - A-400-Series + NBS.

ISSUED FOR AS-BUILT

Rev	Date	By	CHK	Comment
AB	30.09.14	CH	AC	Issued for AS-BUILT

BRINGING IDEAS TO LIFE



**FRANKHAM**

Frankham Consultancy Group Limited  
 21 Perryman Road  
 Hayesville Heath, RH16 3TP  
 t 01444 444900 f 01444 455642  
 enquiry@frankham.com  
 www.frankham.com

Client



**Ealing**  
www.ealing.gov.uk

Project Title

Dominion Arts Centre  
 Southhall  
 London

Drawing Title

Proposed Ground Floor Plan  
 2 of 2  
 Fire Strategy Plan

Drawn by: RKC	Scale: 1:100@A1	Date: 21.03.13
Designed by: FCG	Checked by:	Approved by:

File Ref.:	224970-A-161	20.06.11.13.35.19
Drawing No.	224970-A-161	Rev.
		AB