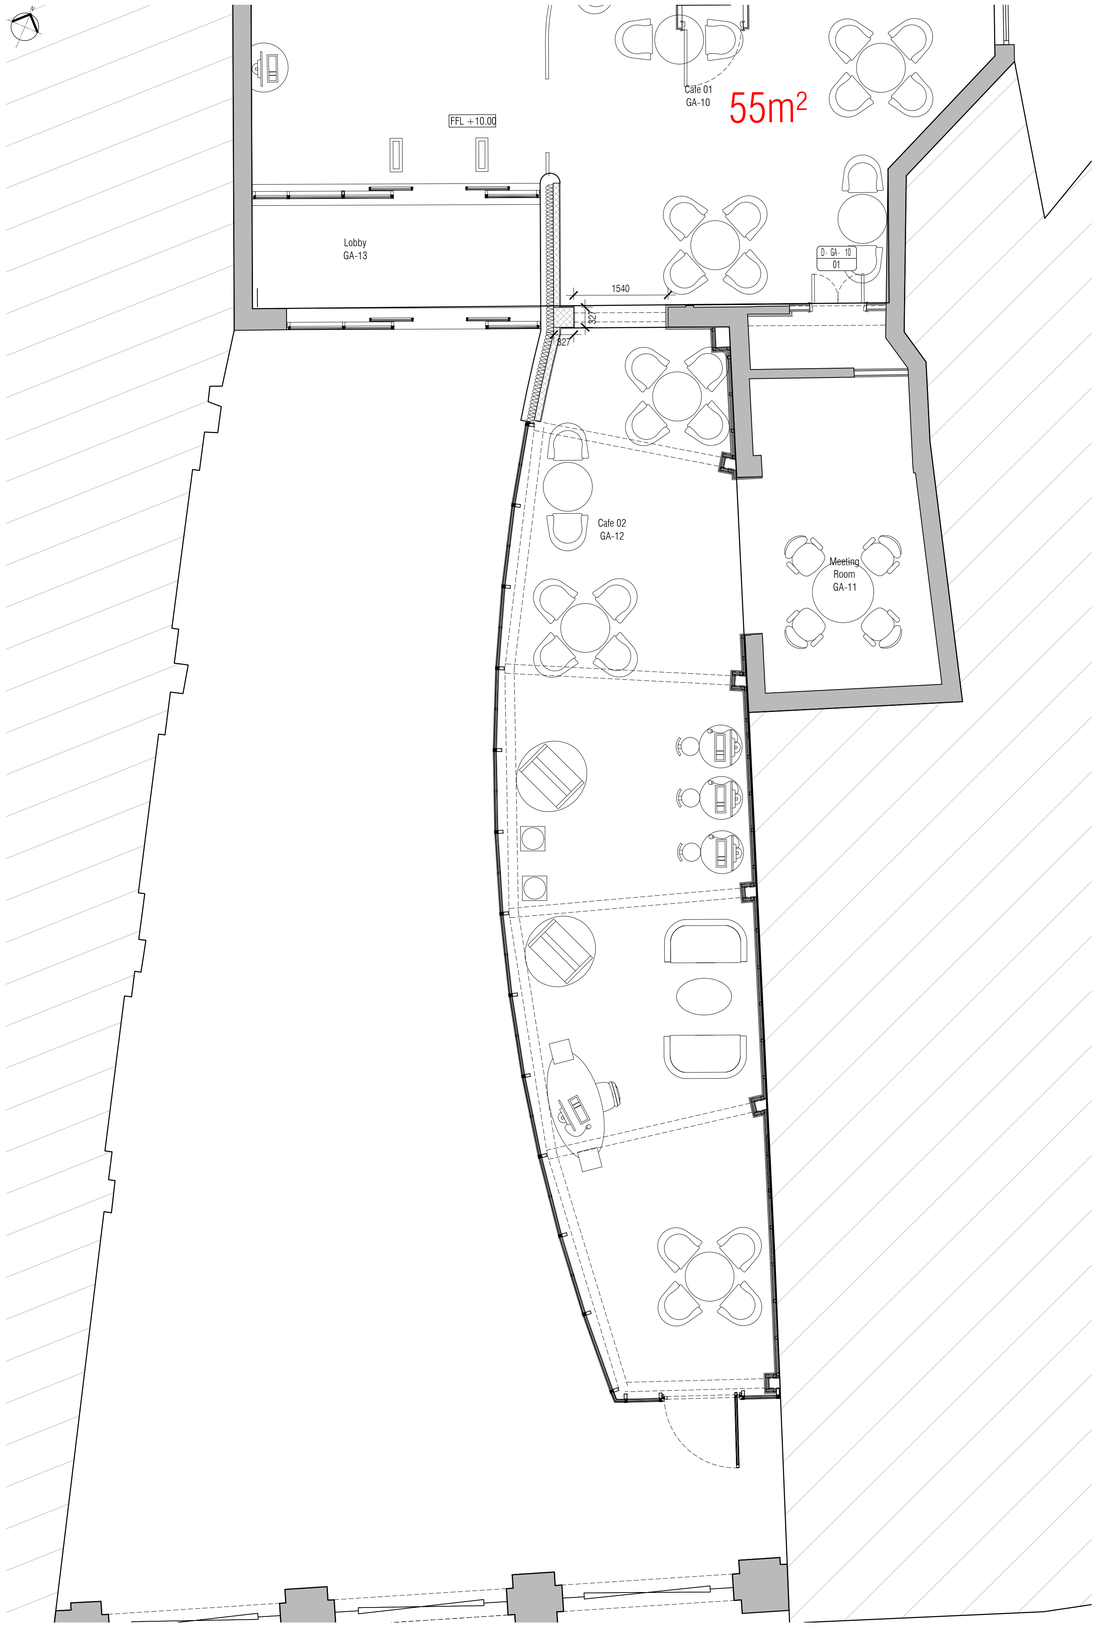

01 Ground Floor Fixed Furniture and Equipment Plan
Scale: 1:50

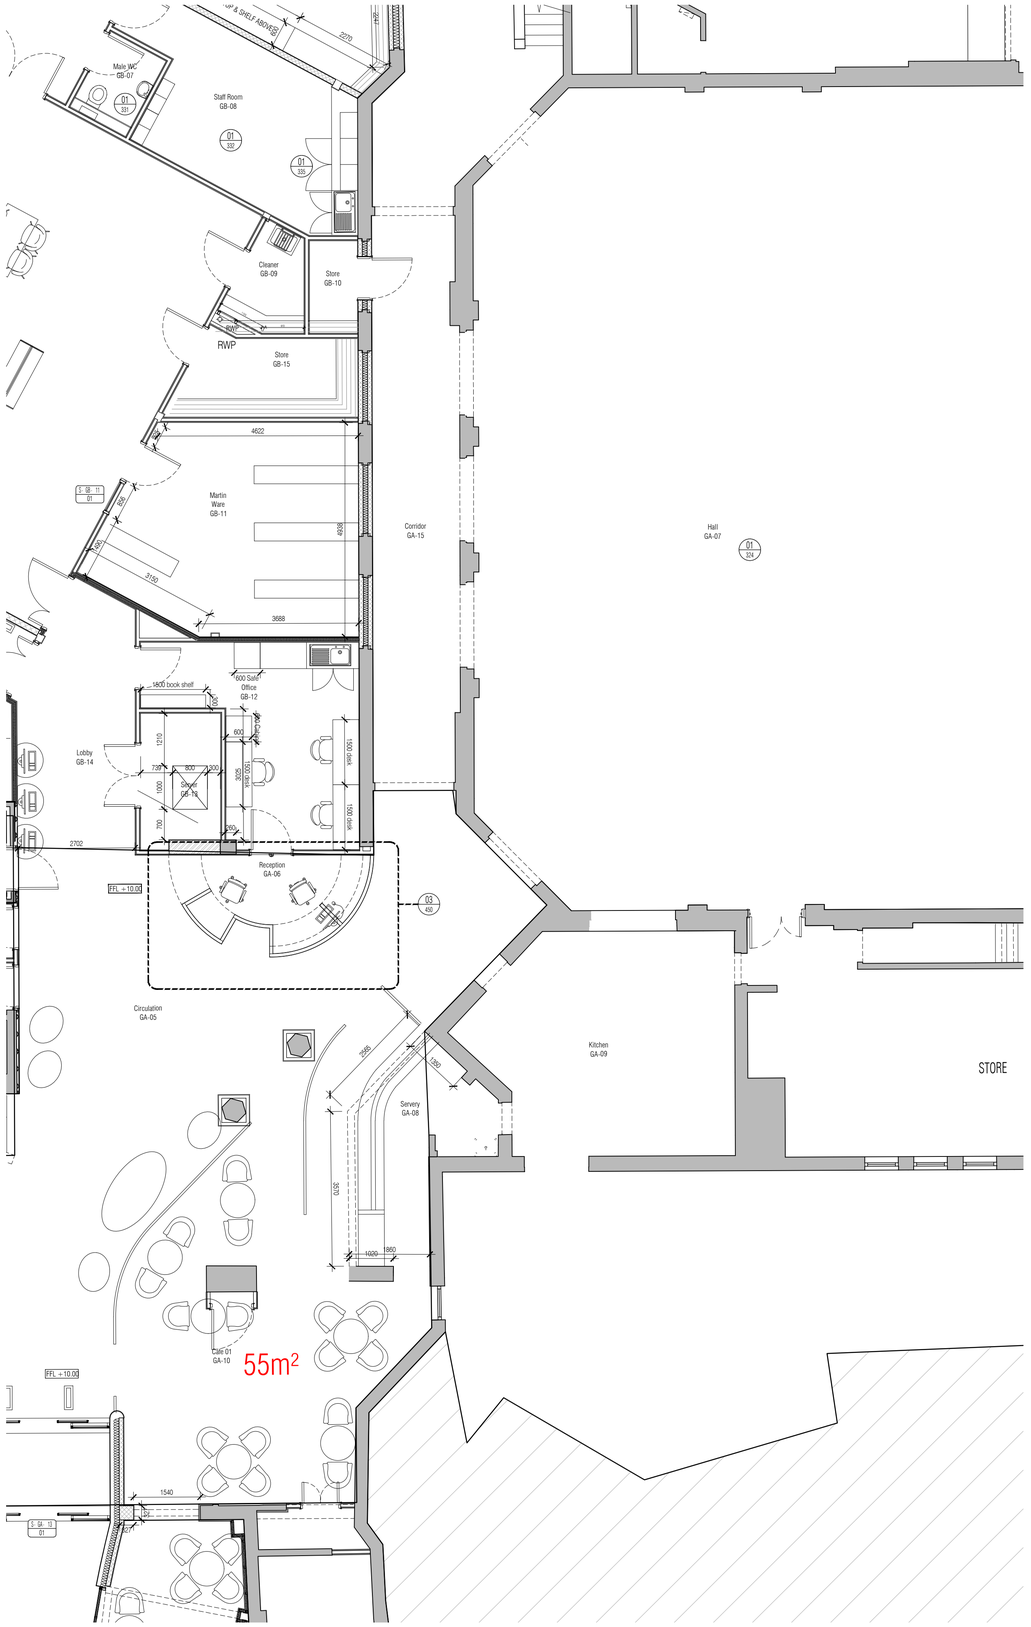

02 Ground Floor Fixed Furniture and Equipment Plan
Scale: 1:50

NOTES: Do not scale this drawing. All dimensions to be checked on site prior to commencement or manufacture.

Key Plan
(nts)

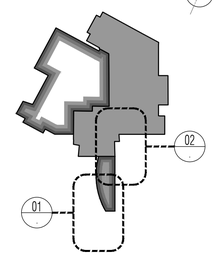

Scale Bar

0 1 2 3 1:50
0 2 4 6 1:100

ISSUED FOR TENDER

Rev	Date	By	Chk	Comment
T1	26.04.13	RKC	JAS	DRAWING ISSUED FOR TENDER

BRINGING IDEAS TO LIFE

FRANKHAM

Frankham Consultancy Group Limited
21 Perrymount Road
Haywards Heath RH16 3TP
t 01444 444900 f 01444 455642
enquire@frankham.com
www.frankham.com

Client
Ealing
www.ealing.gov.uk

Project Title
Dominion Arts Centre
Southall
London

Drawing Title
Proposed
Ground Floor
Fixed Furniture and Equipment Plan
3 of 3

Drawn by:	Scale:	Date:
RKC	1:50@A1	21.02.13
Designed by:	Checked by:	Approved by:
FCG	-	-

File Ref.: X:\2008\0224970 - LB EALING - DOMINION ARTS CENTRE\ARCH\SS_18B_LOCATION PLANS AND GA\224970-A-182.DWG - 2008/11/2803 20:06:11 13:36:30

Drawing No. 224970-A-182
Rev. T1