



01 Minimum Escape Route Widths Strip Section  
Scale: 1:10

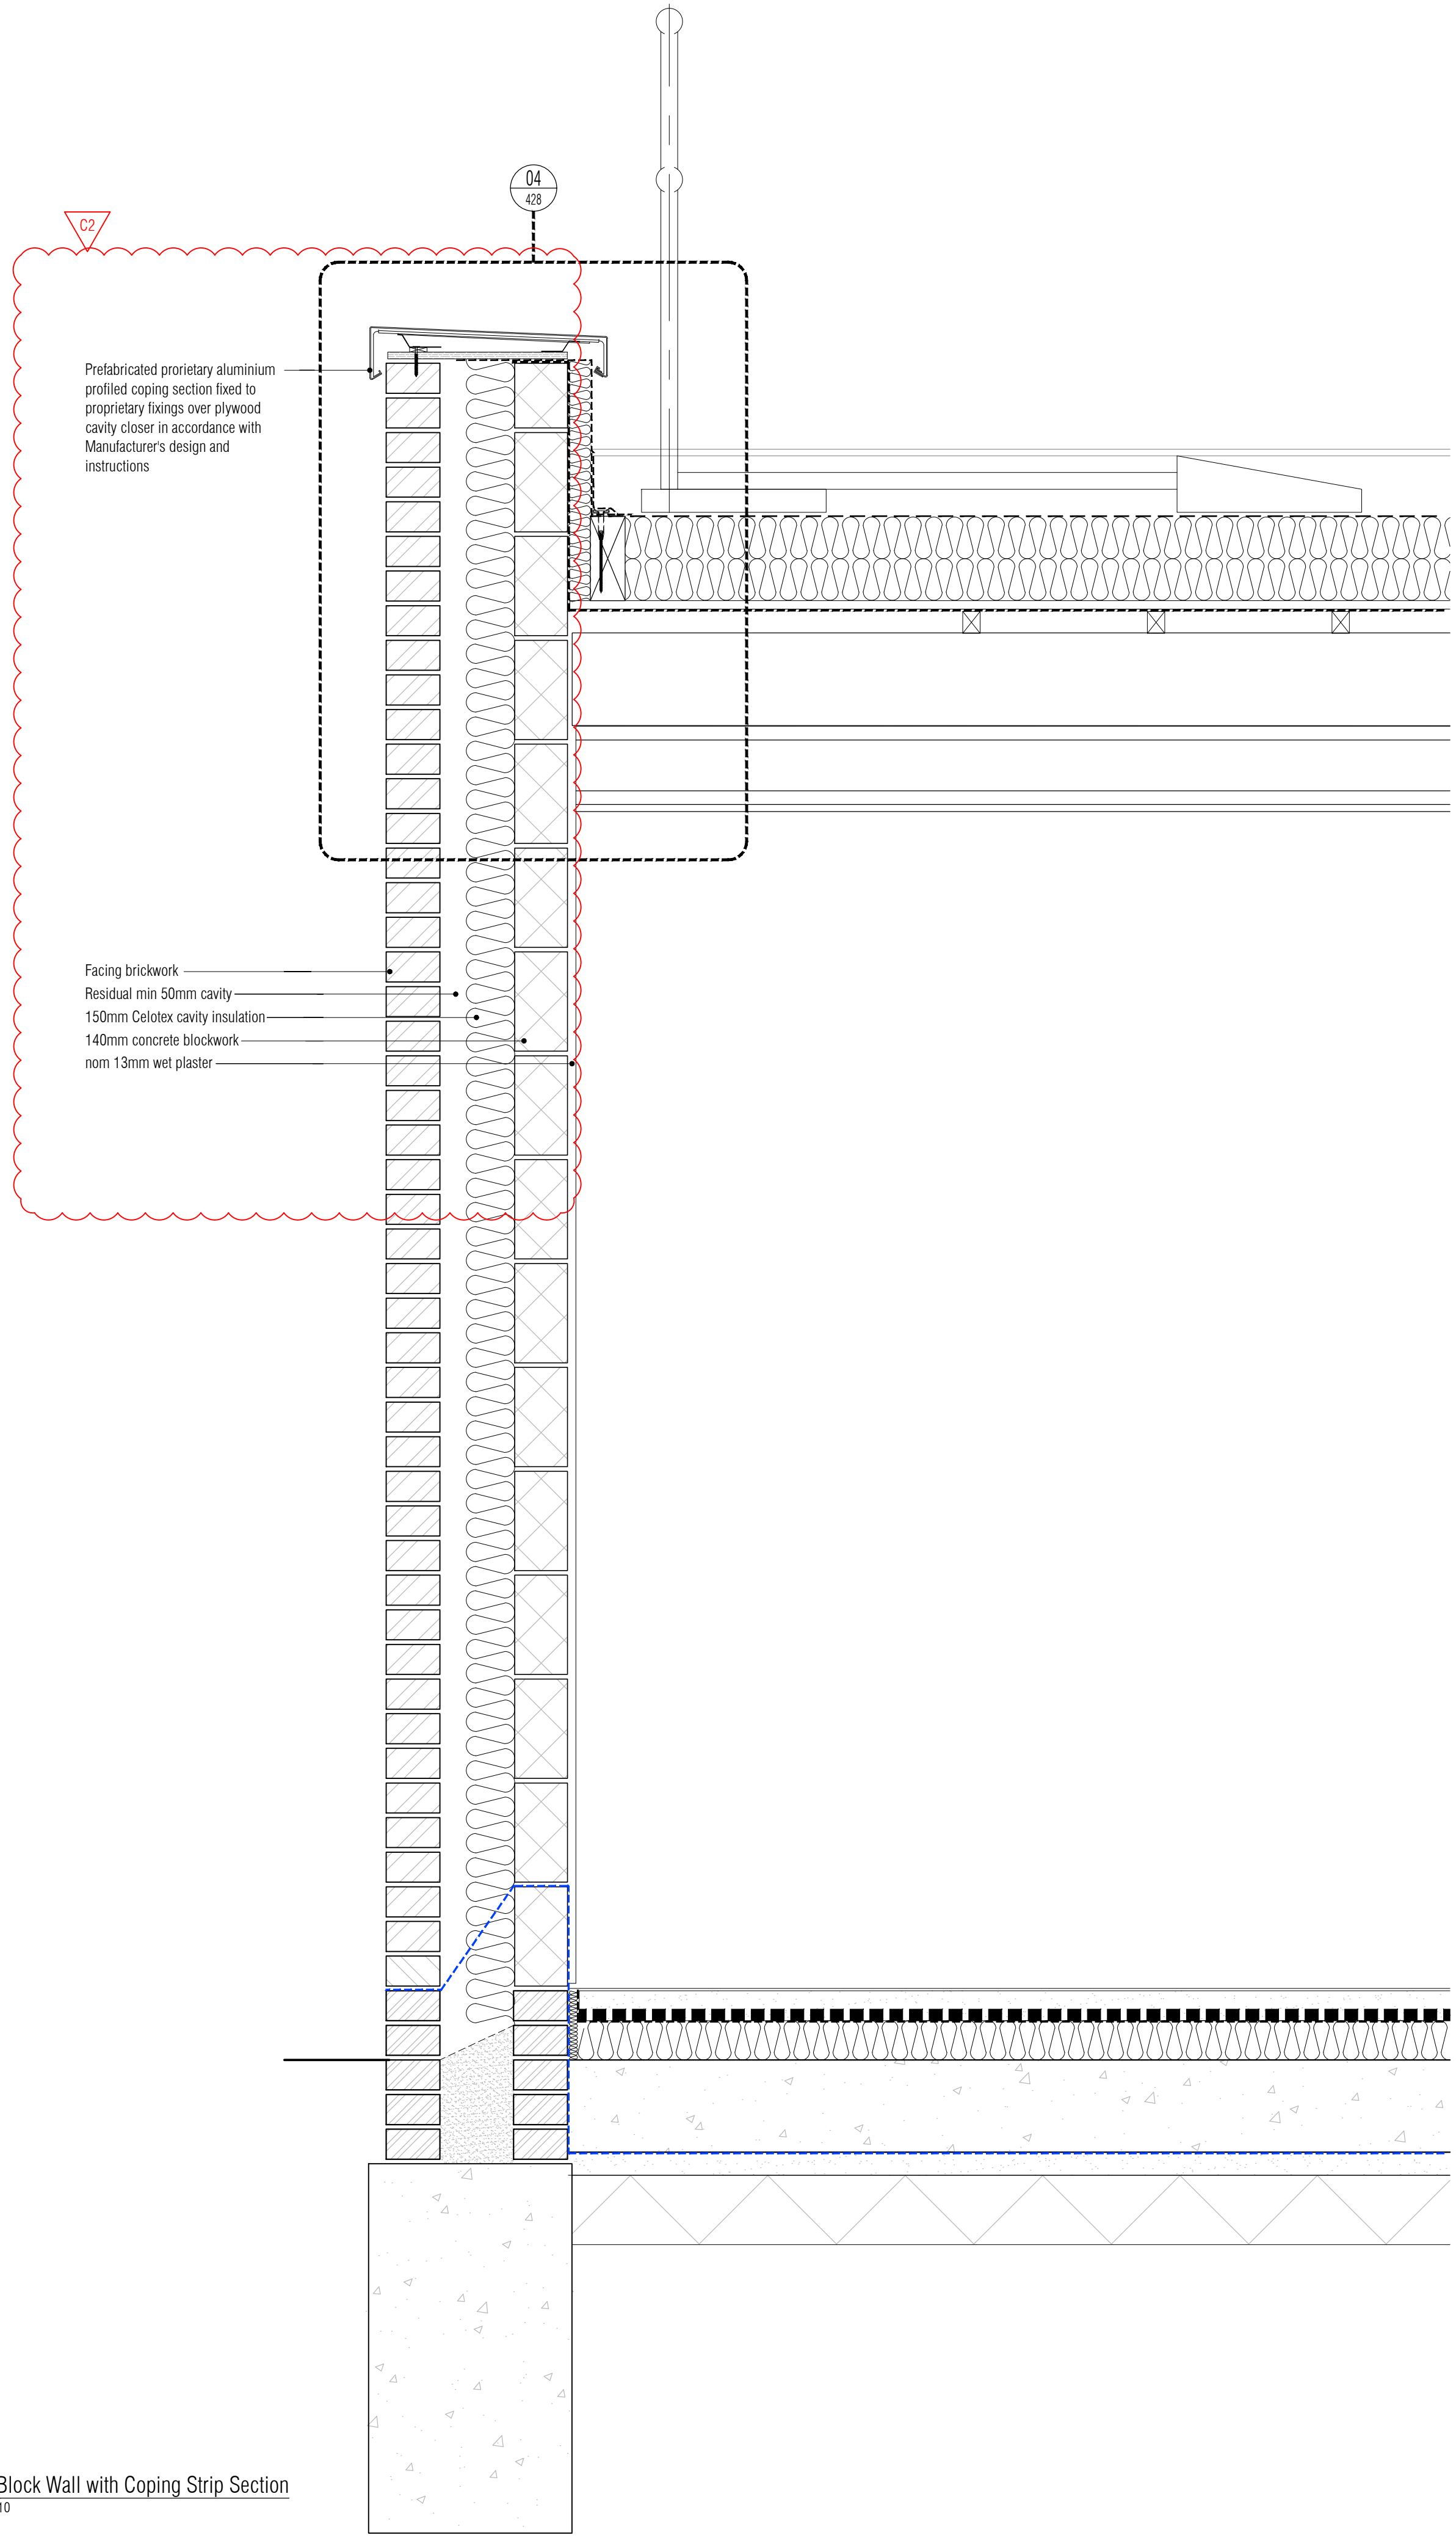

02 Brick / Block Wall with Coping Strip Section  
Scale: 1:10

NOTES: Do not scale this drawing. All dimensions to be checked on site prior to commencement or manufacture.

Key Plan (n/s)

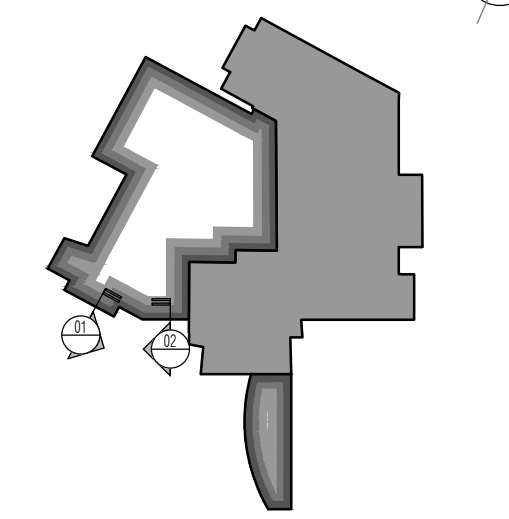

ISSUED FOR CONSTRUCTION

Rev	Date	By	Chk	Comment
C2	07.10.13	CH	AC	Annotation added
C1	03.07.13	FRK	JAS	Issued for CONSTRUCTION

BRINGING IDEAS TO LIFE

**FRANKHAM**

Frankham Consultancy Group Limited  
21 Parnmount Road  
Haywards Heath RH16 3TP  
t 01444 444900 f 01444 455642  
enquire@frankham.com  
www.frankham.com

Client

**Ealing**  
www.ealing.gov.uk

Project Title

Dominion Arts Centre  
Southall  
London

Drawing Title

Strip Sections  
Details

Drawn by: RKC	Scale: 1:50@A1	Date: 06.02.13
Designed by: FCG	Checked by: JAS	Approved by: AGC

File Ref.: E:\2008\04\01 - EALING - DOMINION ARTS CENTRE\0401 - 01 STRIP SECTIONS\2008-04-01-01-01.dwg	Date: 20.06.11 13:44:57
Drawing No. 224970-A-410	Rev. C2