




01 Eaves Overhang / Truss / Curtain Walling Interface Detail
Scale: 1:5

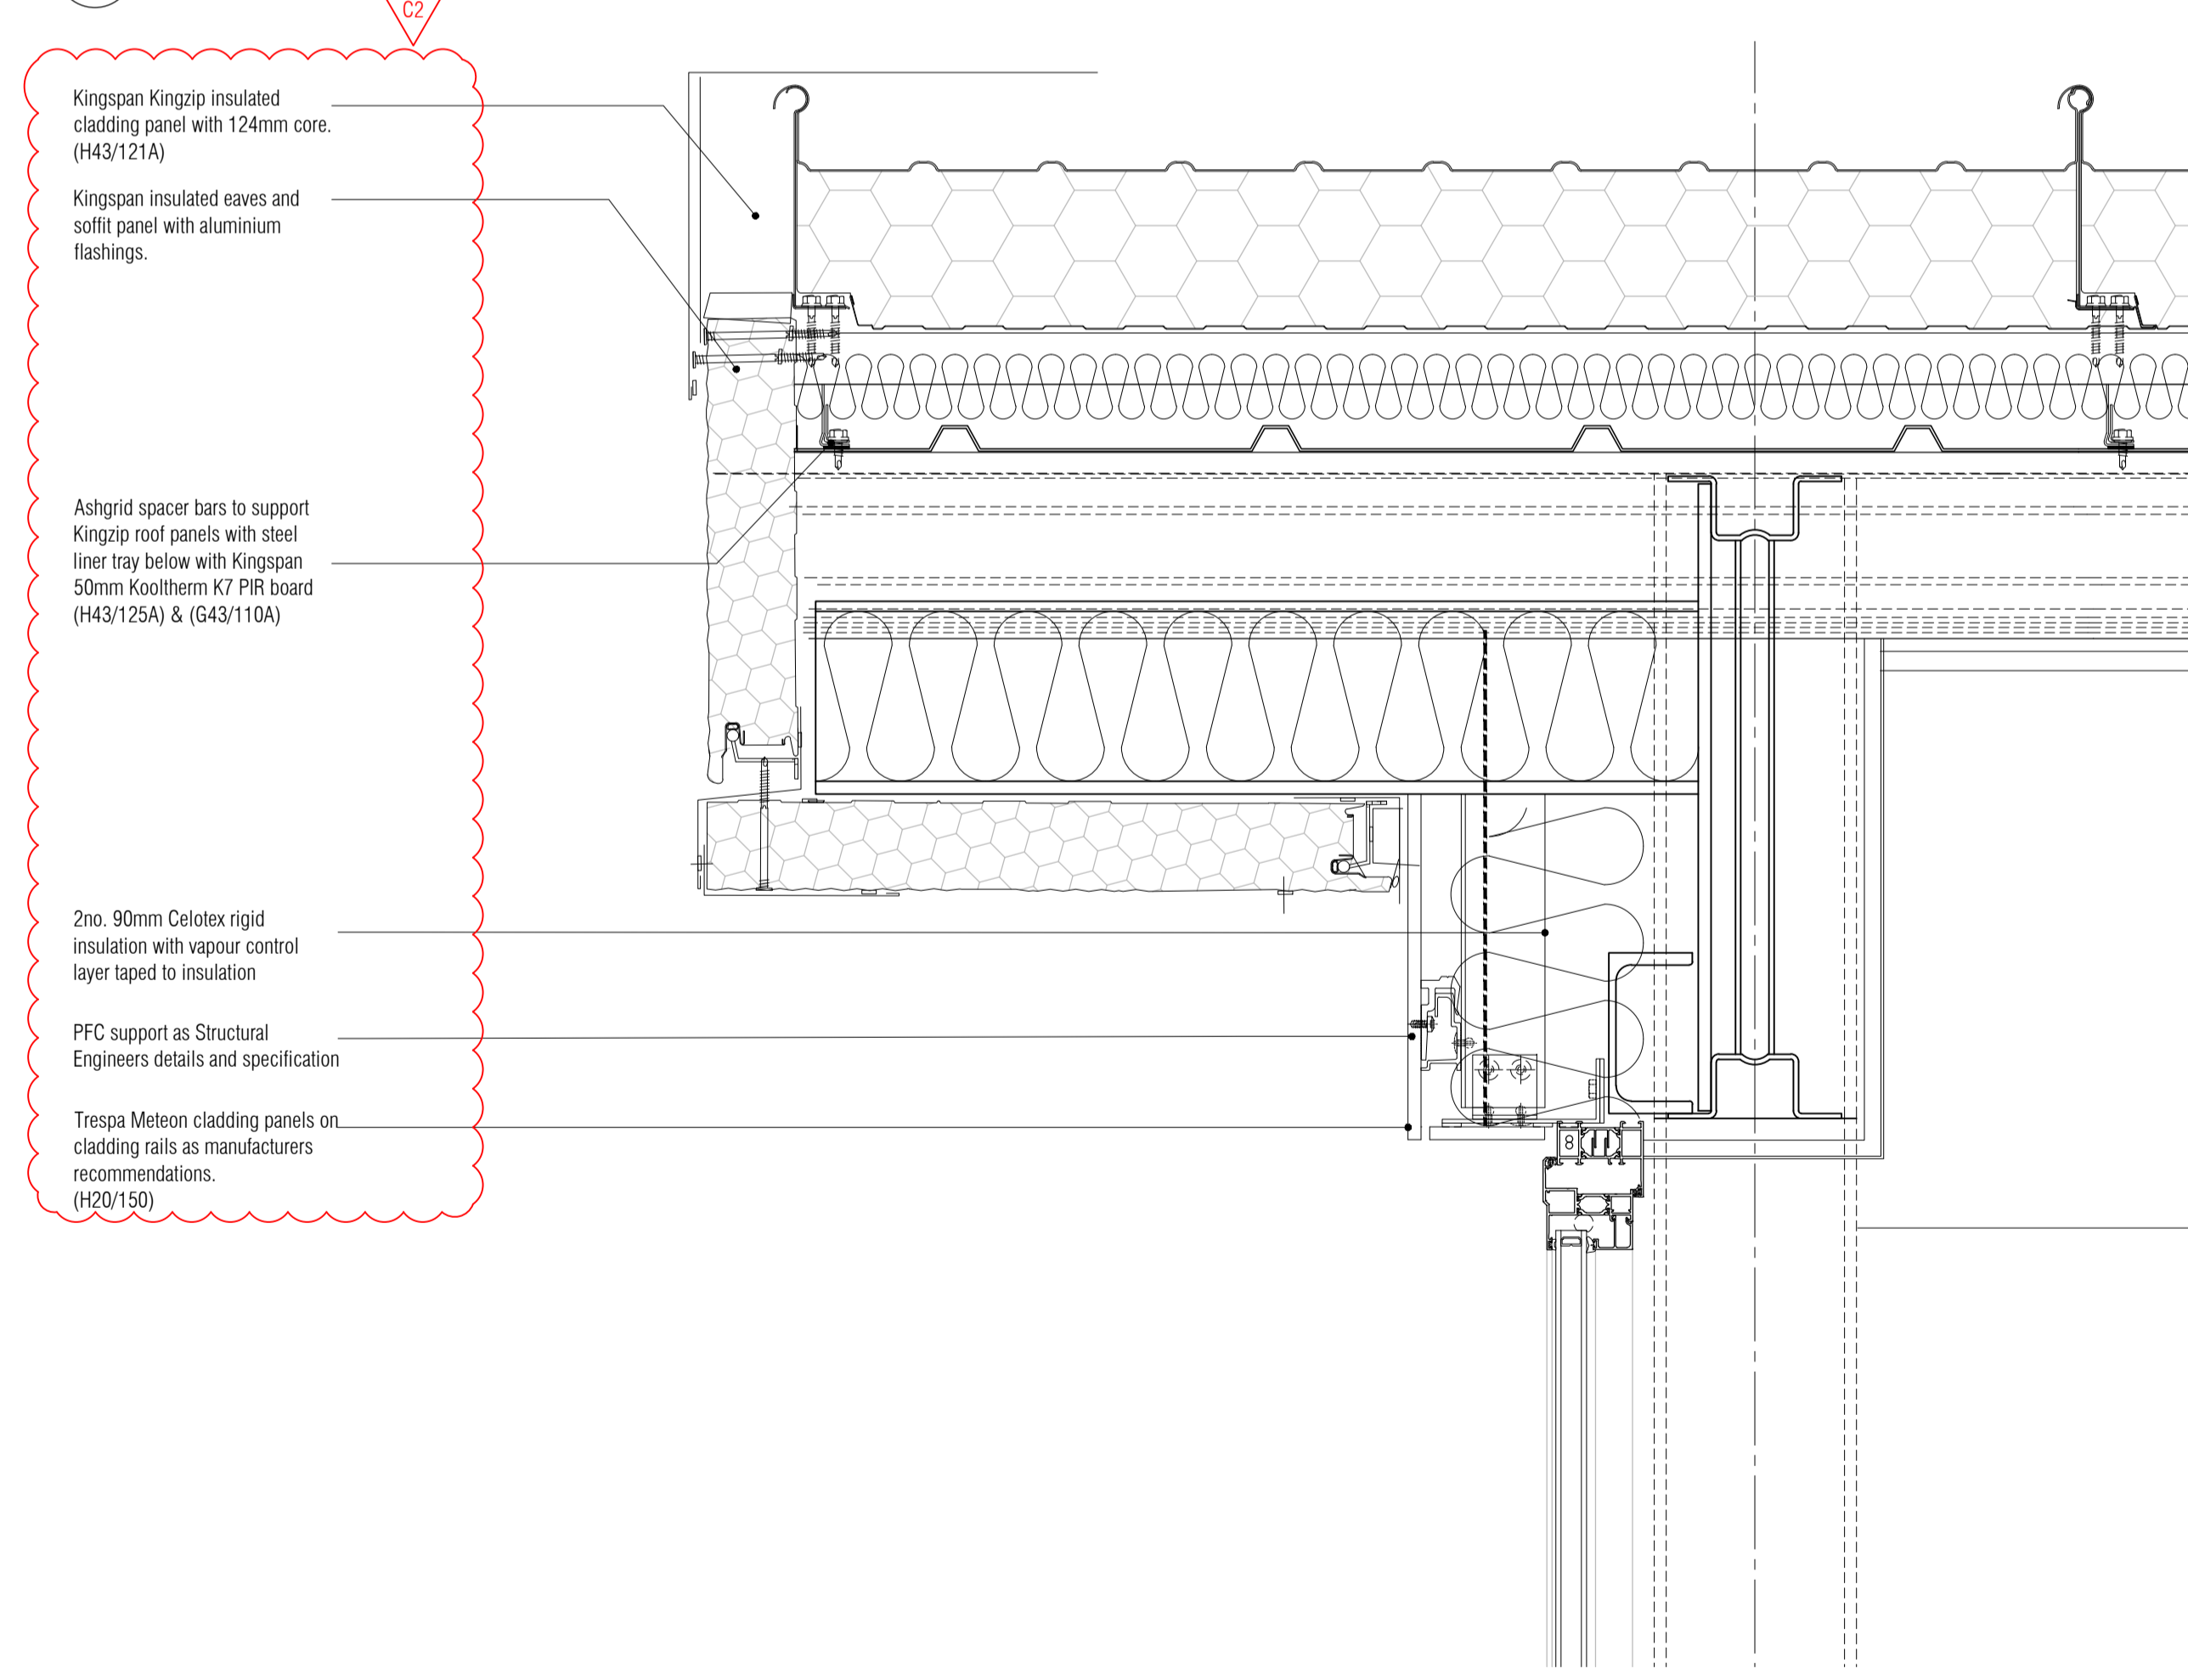

03 Eaves Overhang / Brick Block Wall Along GL1 Interface Detail
Scale: 1:5

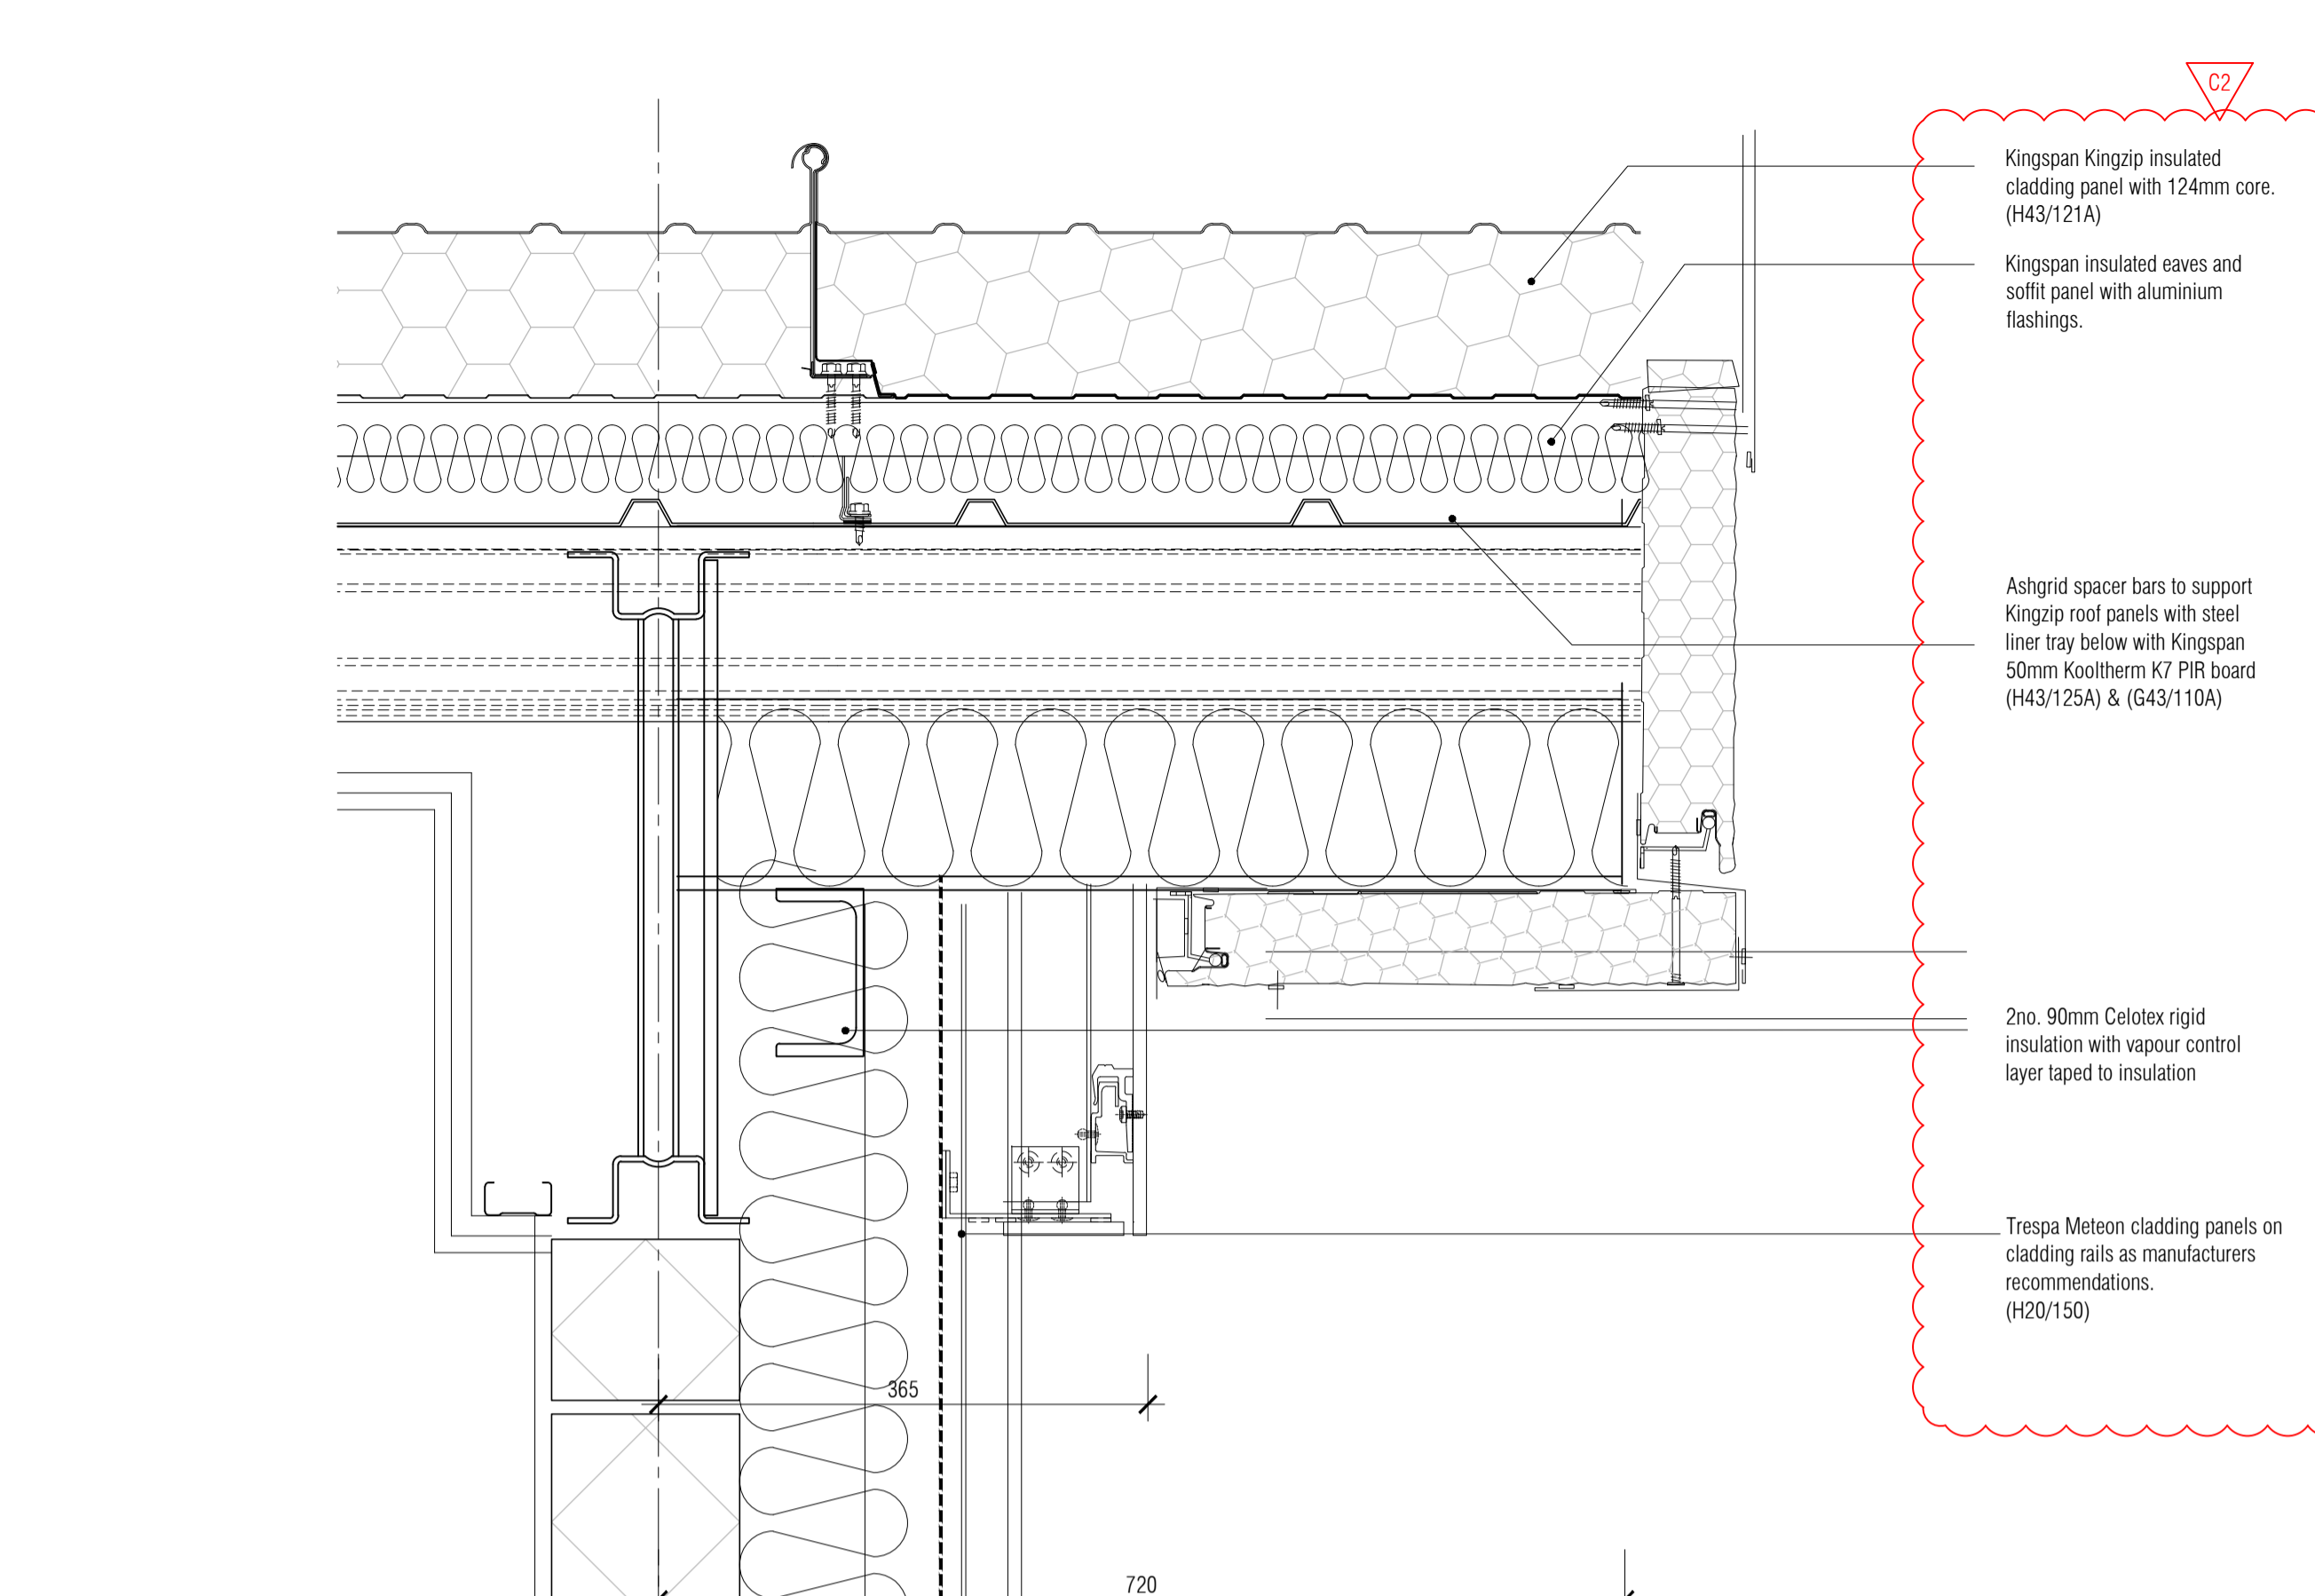


02 Eaves Overhang / Truss / Blockwork & Trespa Cladding Wall Interface Detail
Scale: 1:5

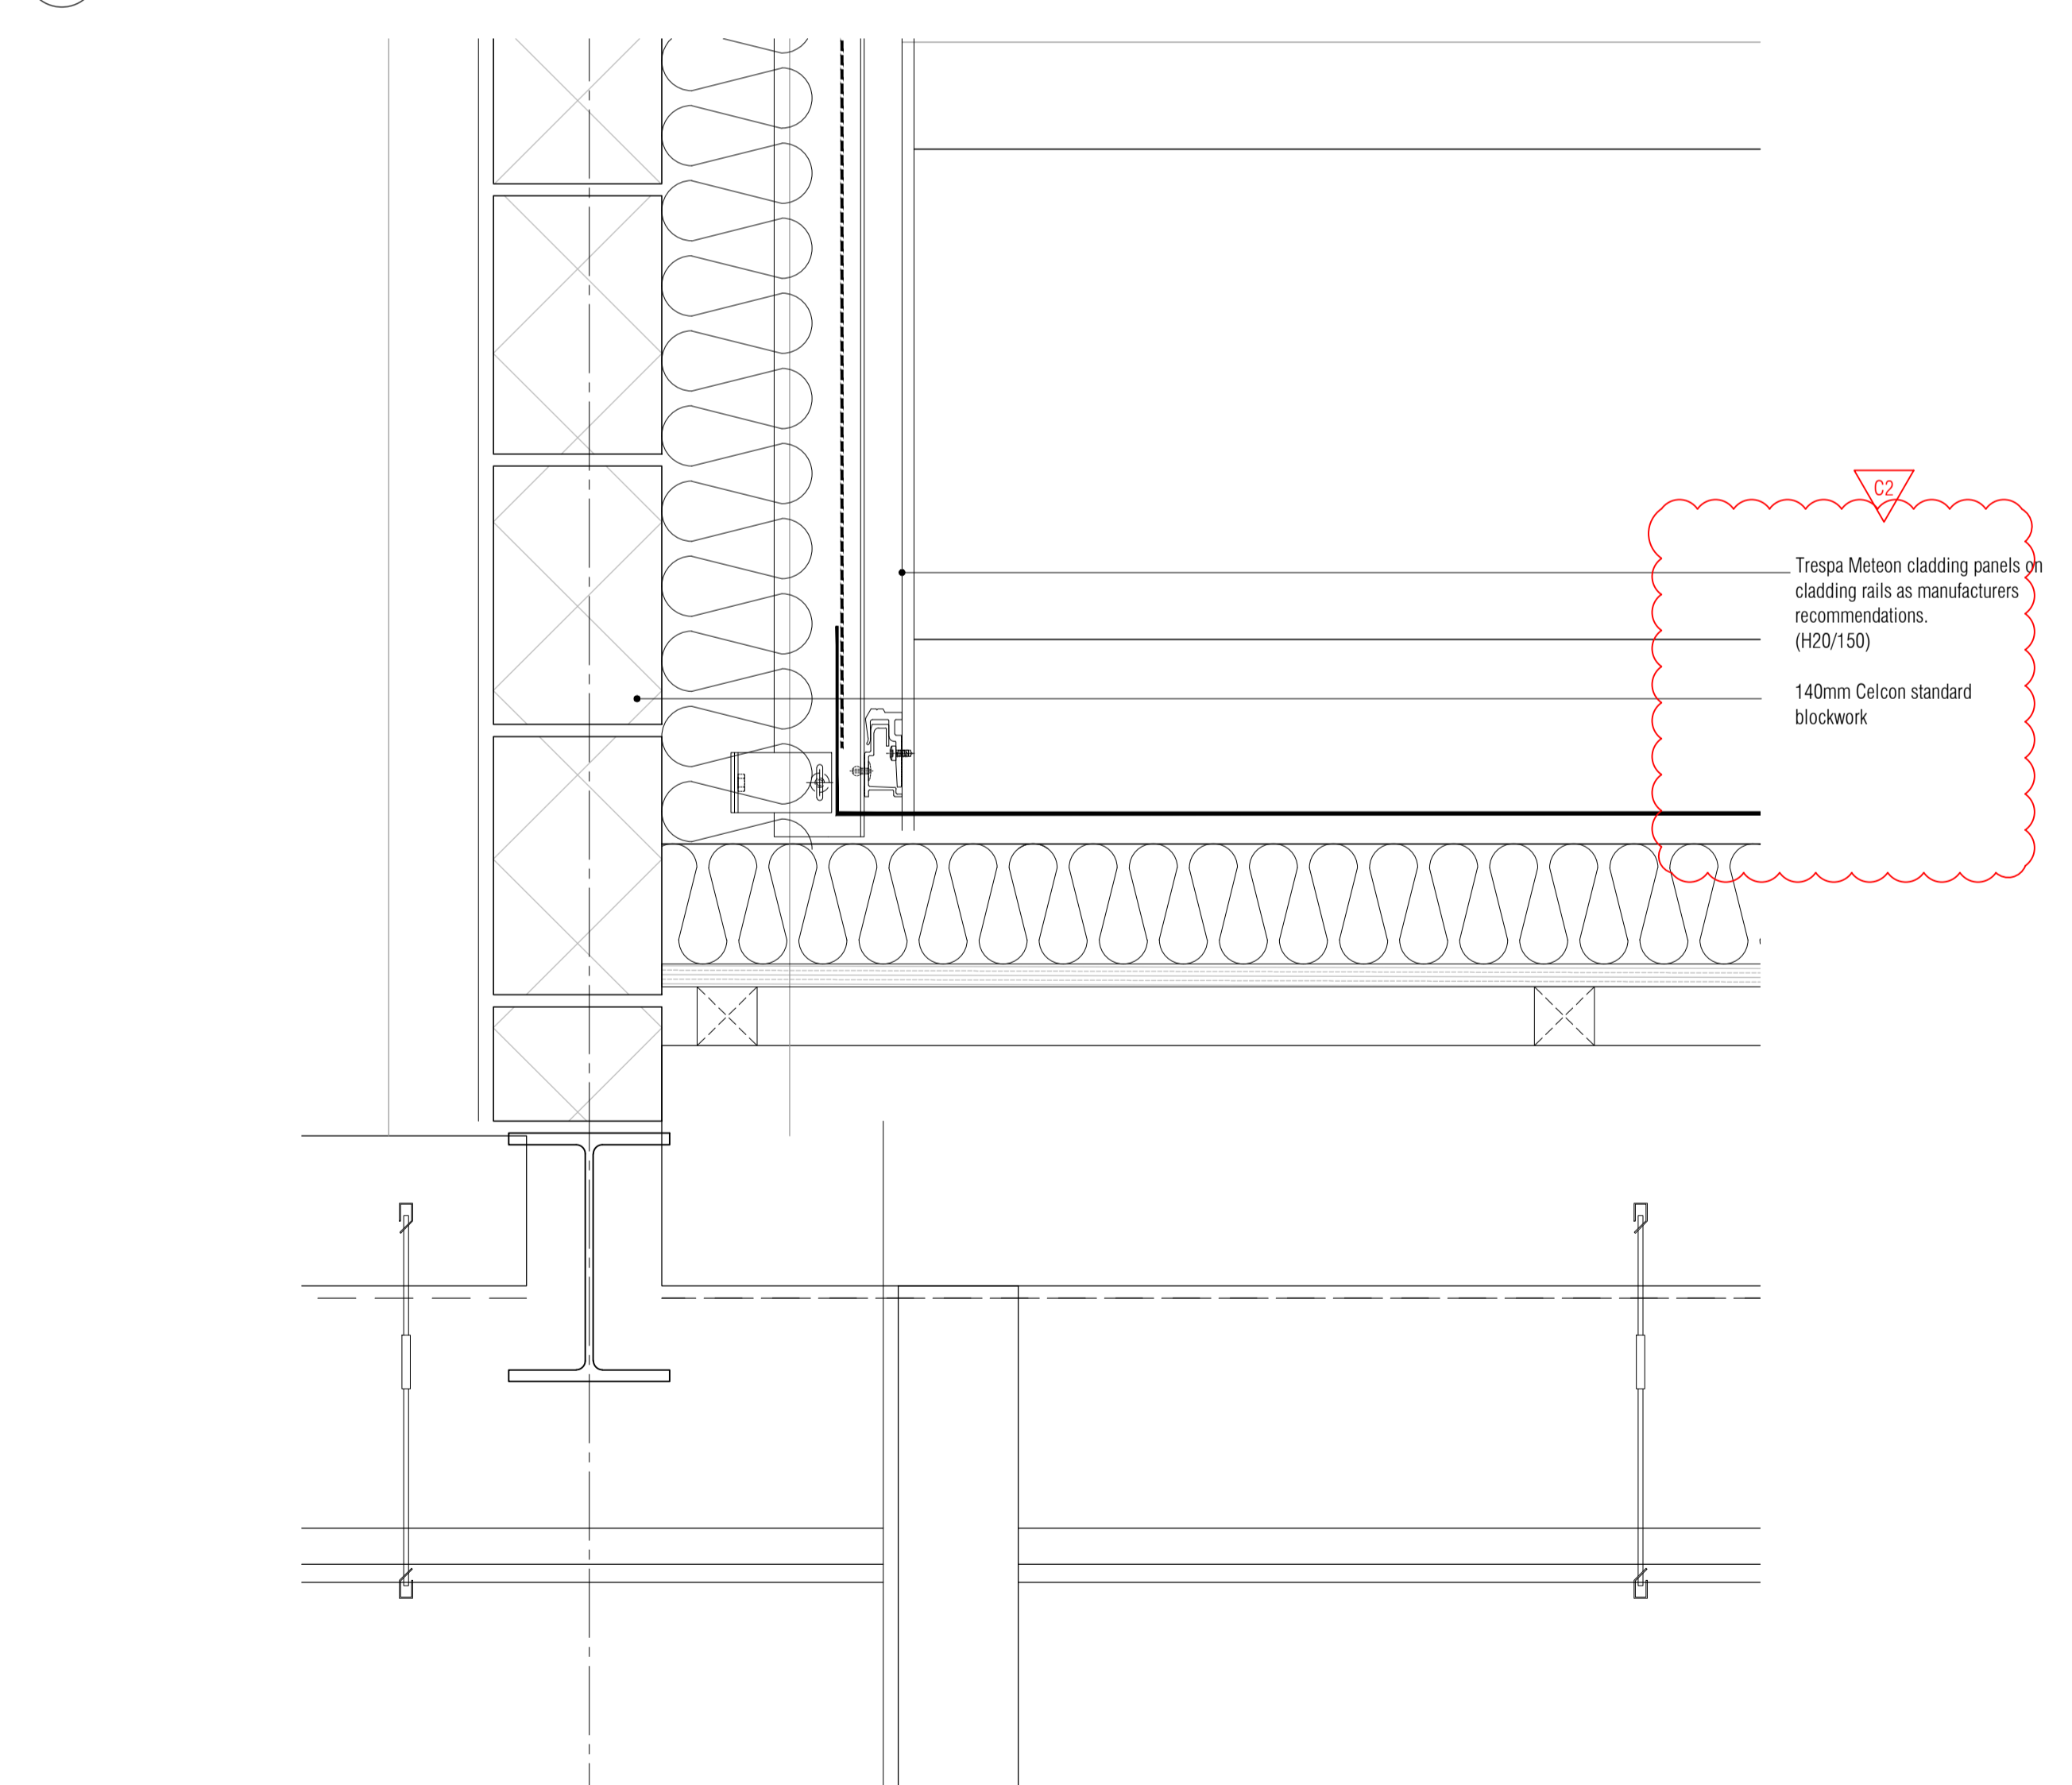

04 Blockwork & Trespa Cladding / Flat Roof Interface Detail
Scale: 1:5

NOTES: Do not scale this drawing. All dimensions to be checked on site prior to commencement or manufacture.

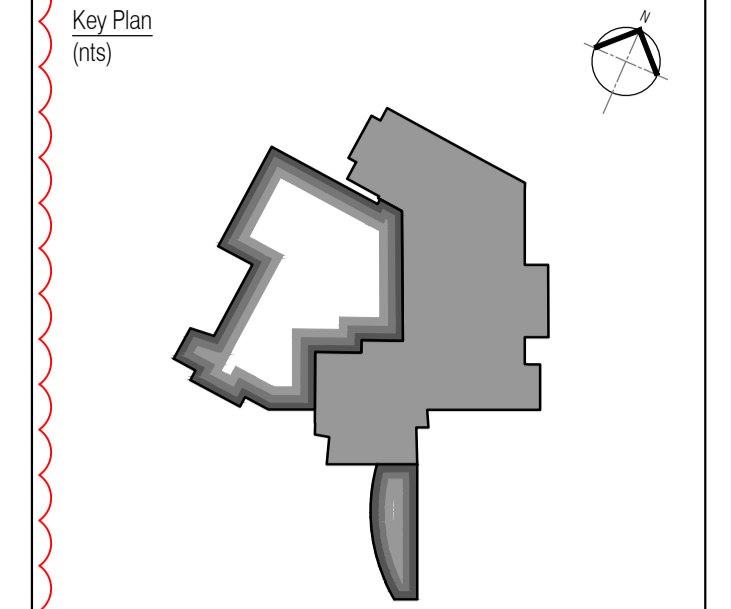

Rev	Date	By	CHK	Comment
C2	07.10.13	CH	AC	Annotation added
C1	03.07.13	RKC	JAS	Issued for CONSTRUCTION


ISSUED FOR CONSTRUCTION

BRINGING IDEAS TO LIFE



FRANKHAM

Frankham Consultancy Group Limited
21 Perrymount Road
Haywards Heath RH16 3TP
t 01444 444900 f 01444 455642
enquire@frankham.com
www.frankham.com

Client:  **Ealing**
www.ealing.gov.uk

Project Title: Dominion Arts Centre
Southall
London

Drawing Title: General
Roof Interface
Arrangement
Details

Drawn by: RKC	Scale: 1:5@A1	Date: 06.02.13
Designed by: FCG	Checked by: JAS	Approved by: AGC
File Ref.: C:\BIBB\2013-13\1416 - DOMINION ARTS CENTRE\4048 - 06.02.13\DWG\2013-13-1416-06.dwg		20.06.11 13:46:01
Drawing No. 224970-A-421		Rev. C2