




01 Truss Roof / Clad Masonry Interface Detail
Scale: 1:5

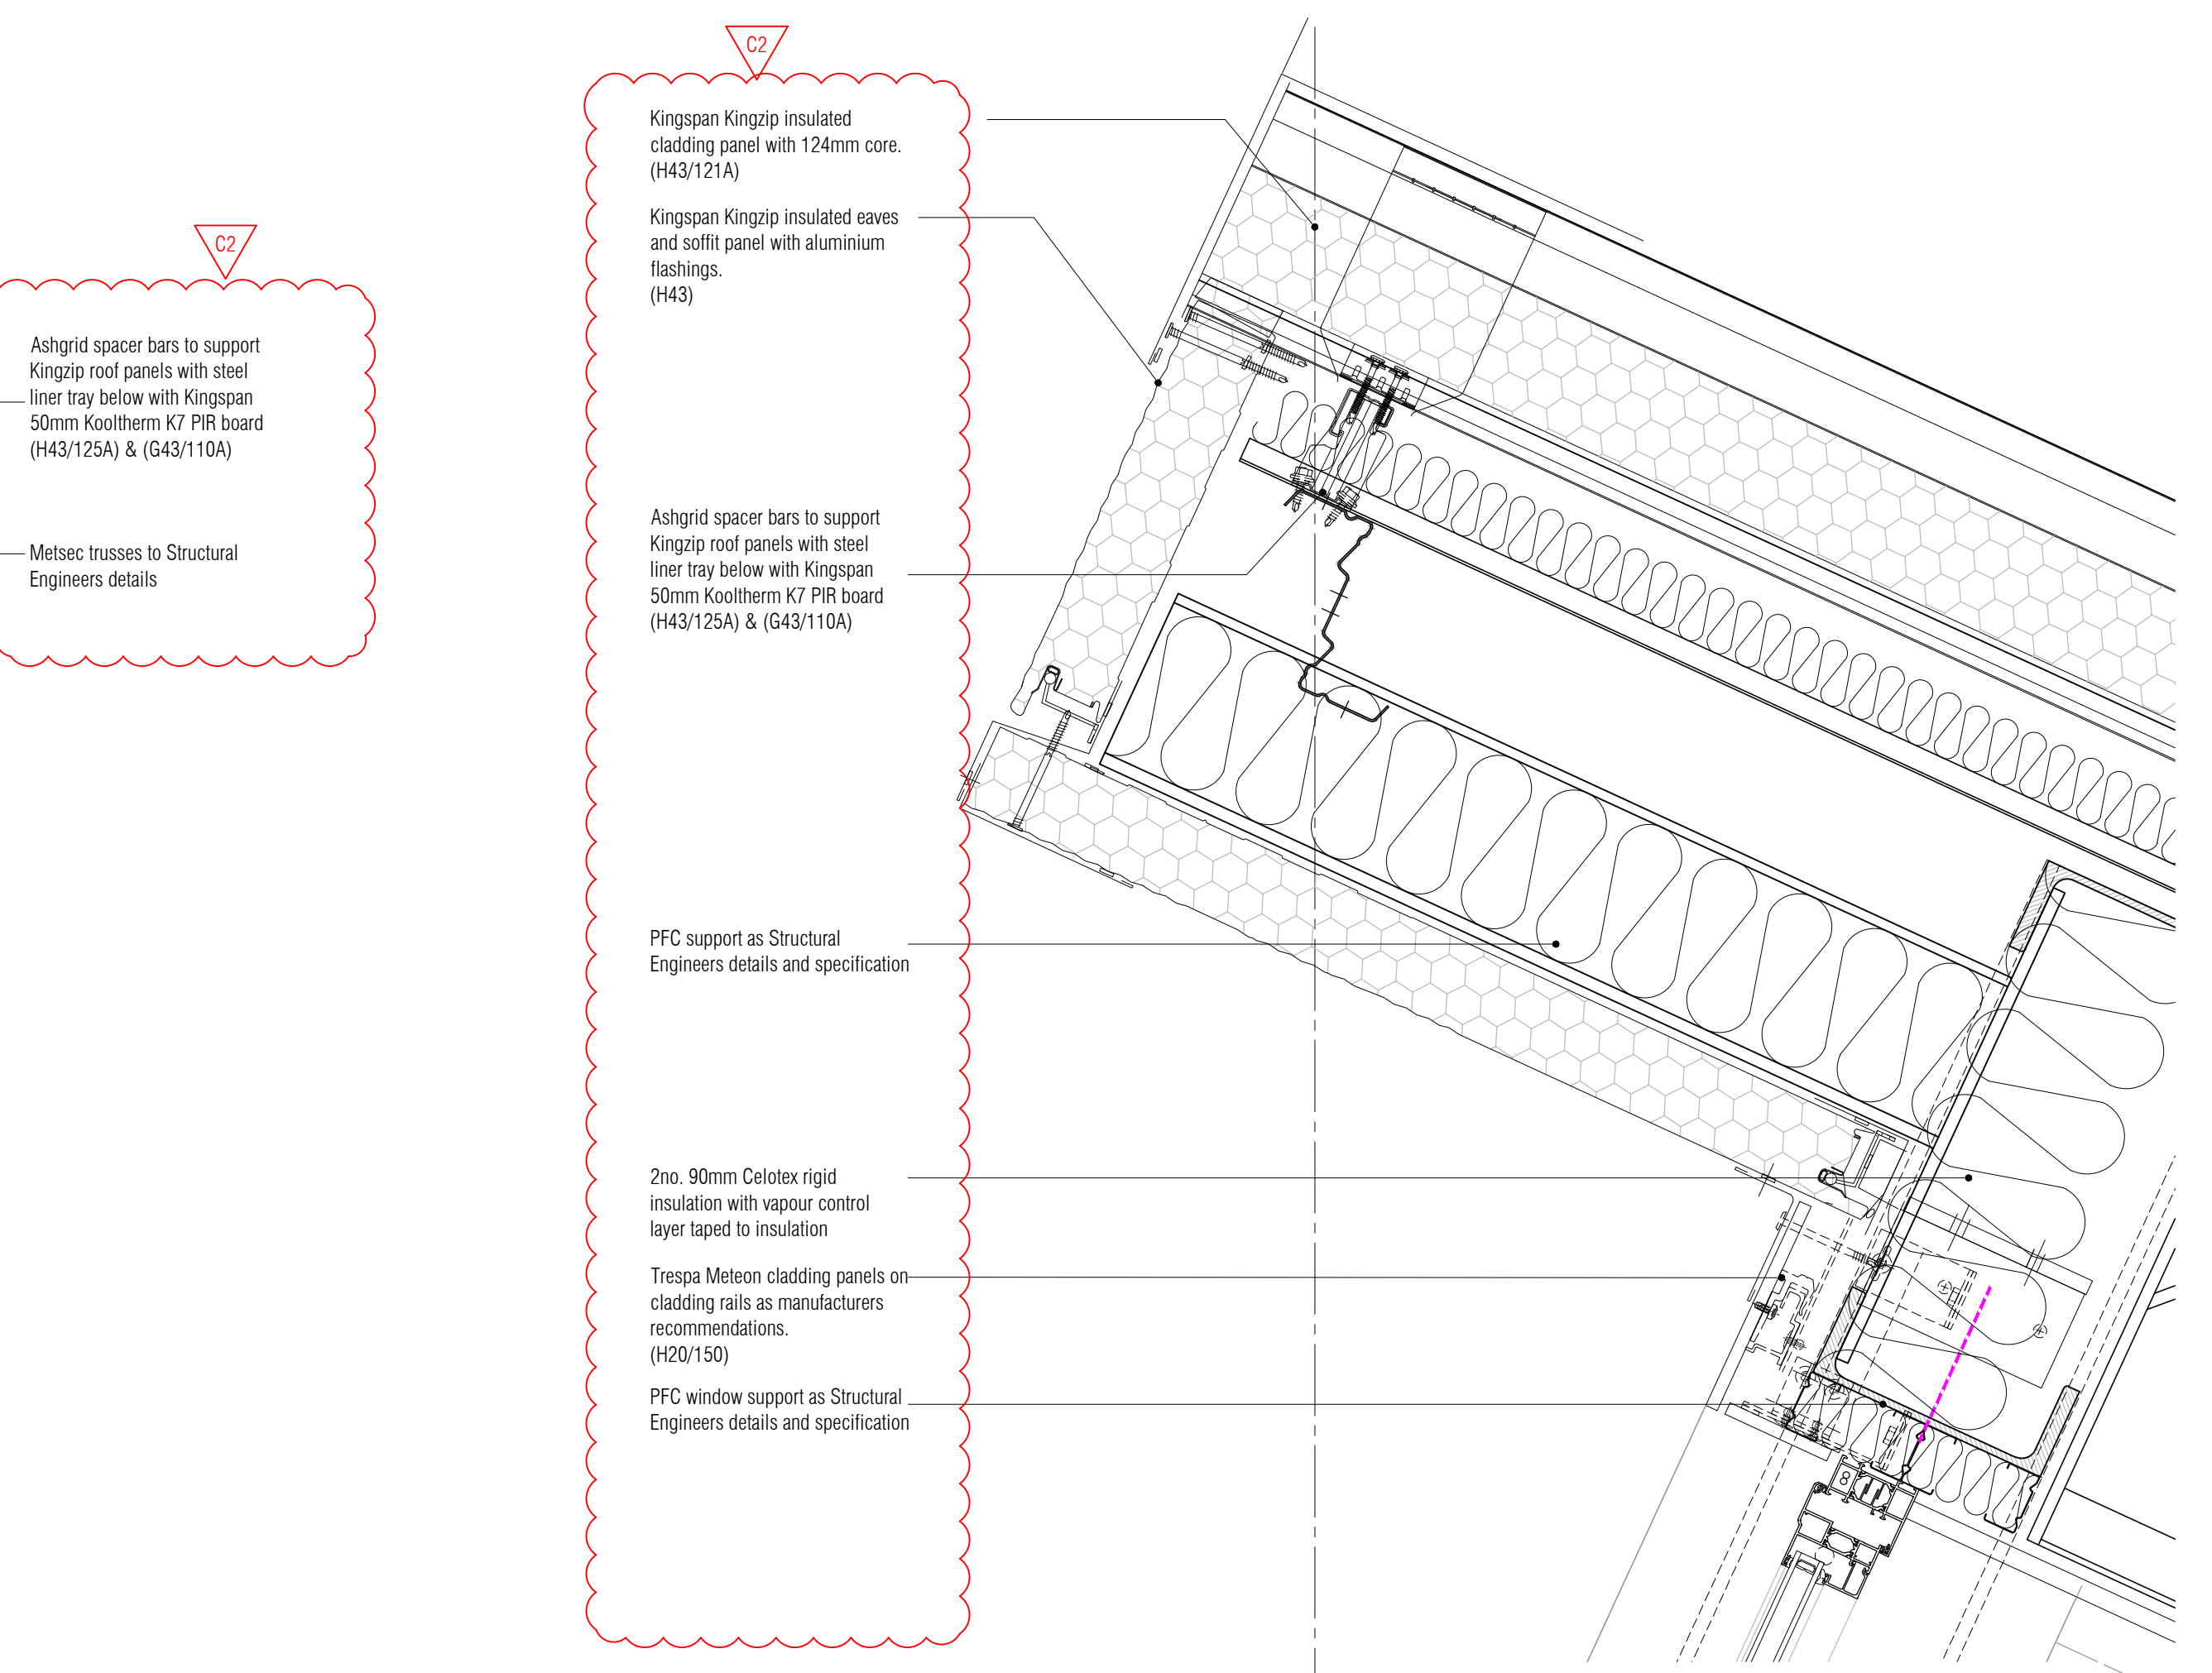

04 Butterfly Truss Roof / Robbin Window Interface Detail
Scale: 1:5

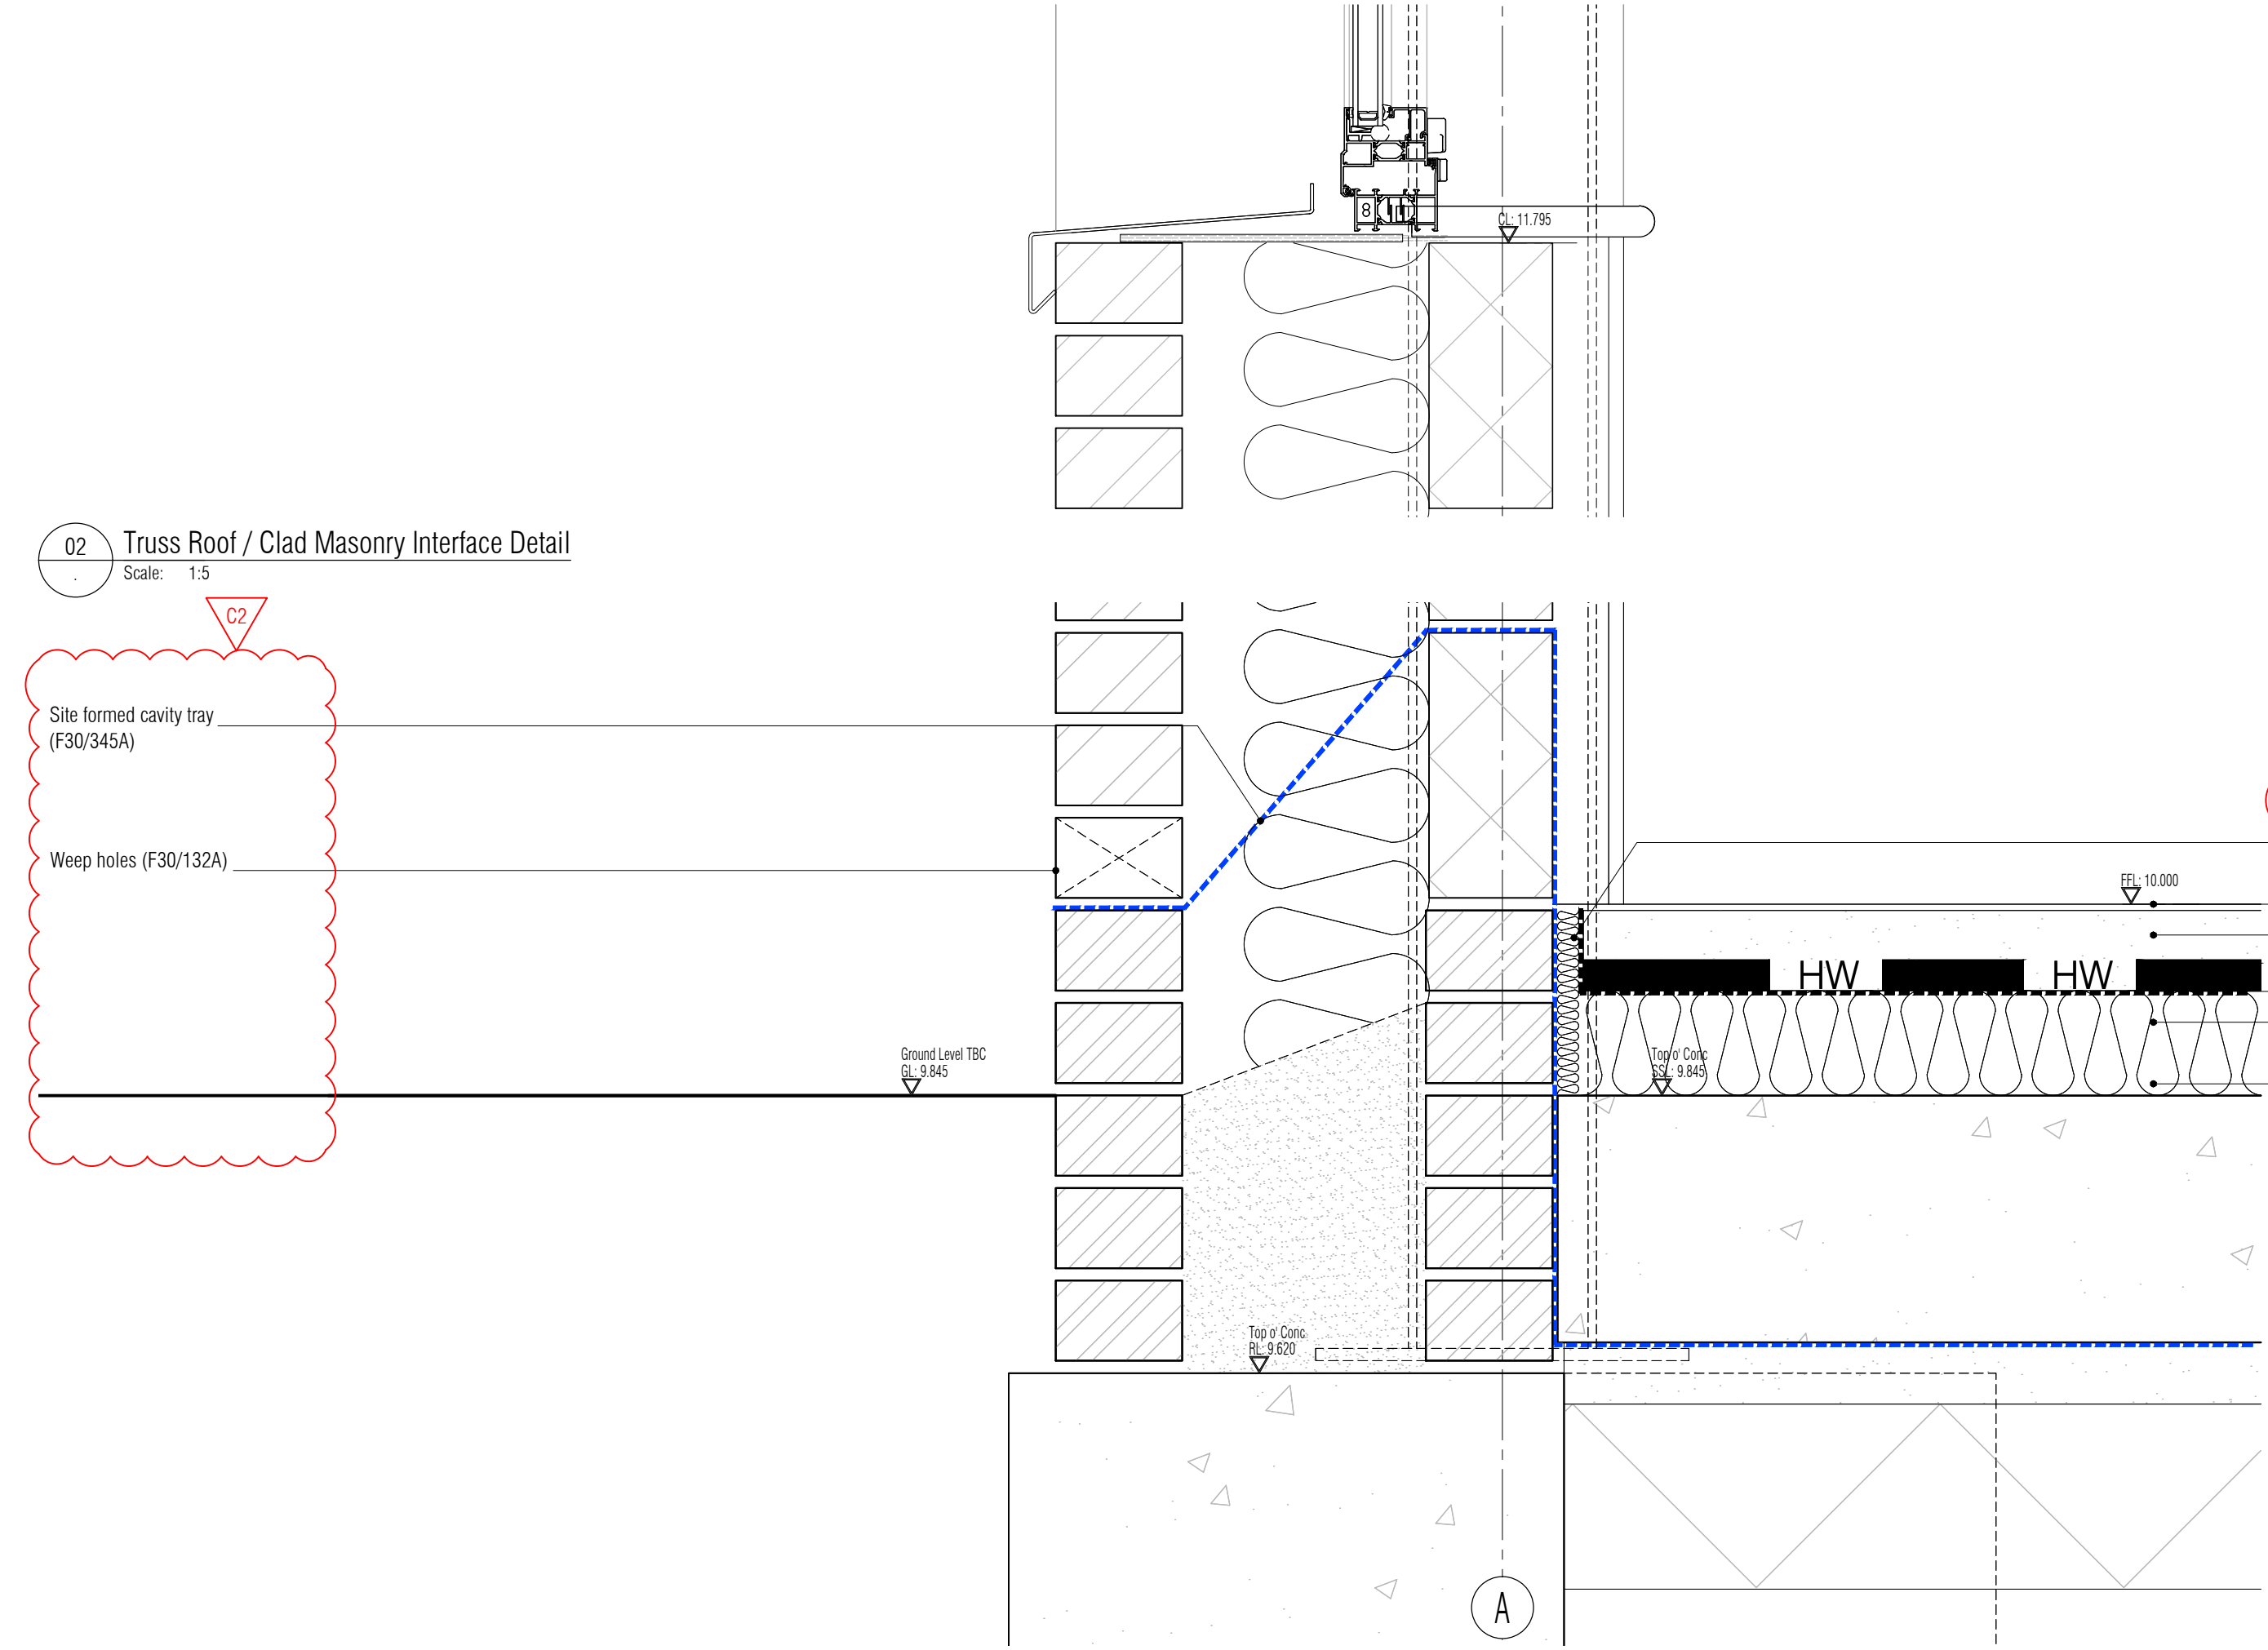


02 Truss Roof / Clad Masonry Interface Detail
Scale: 1:5

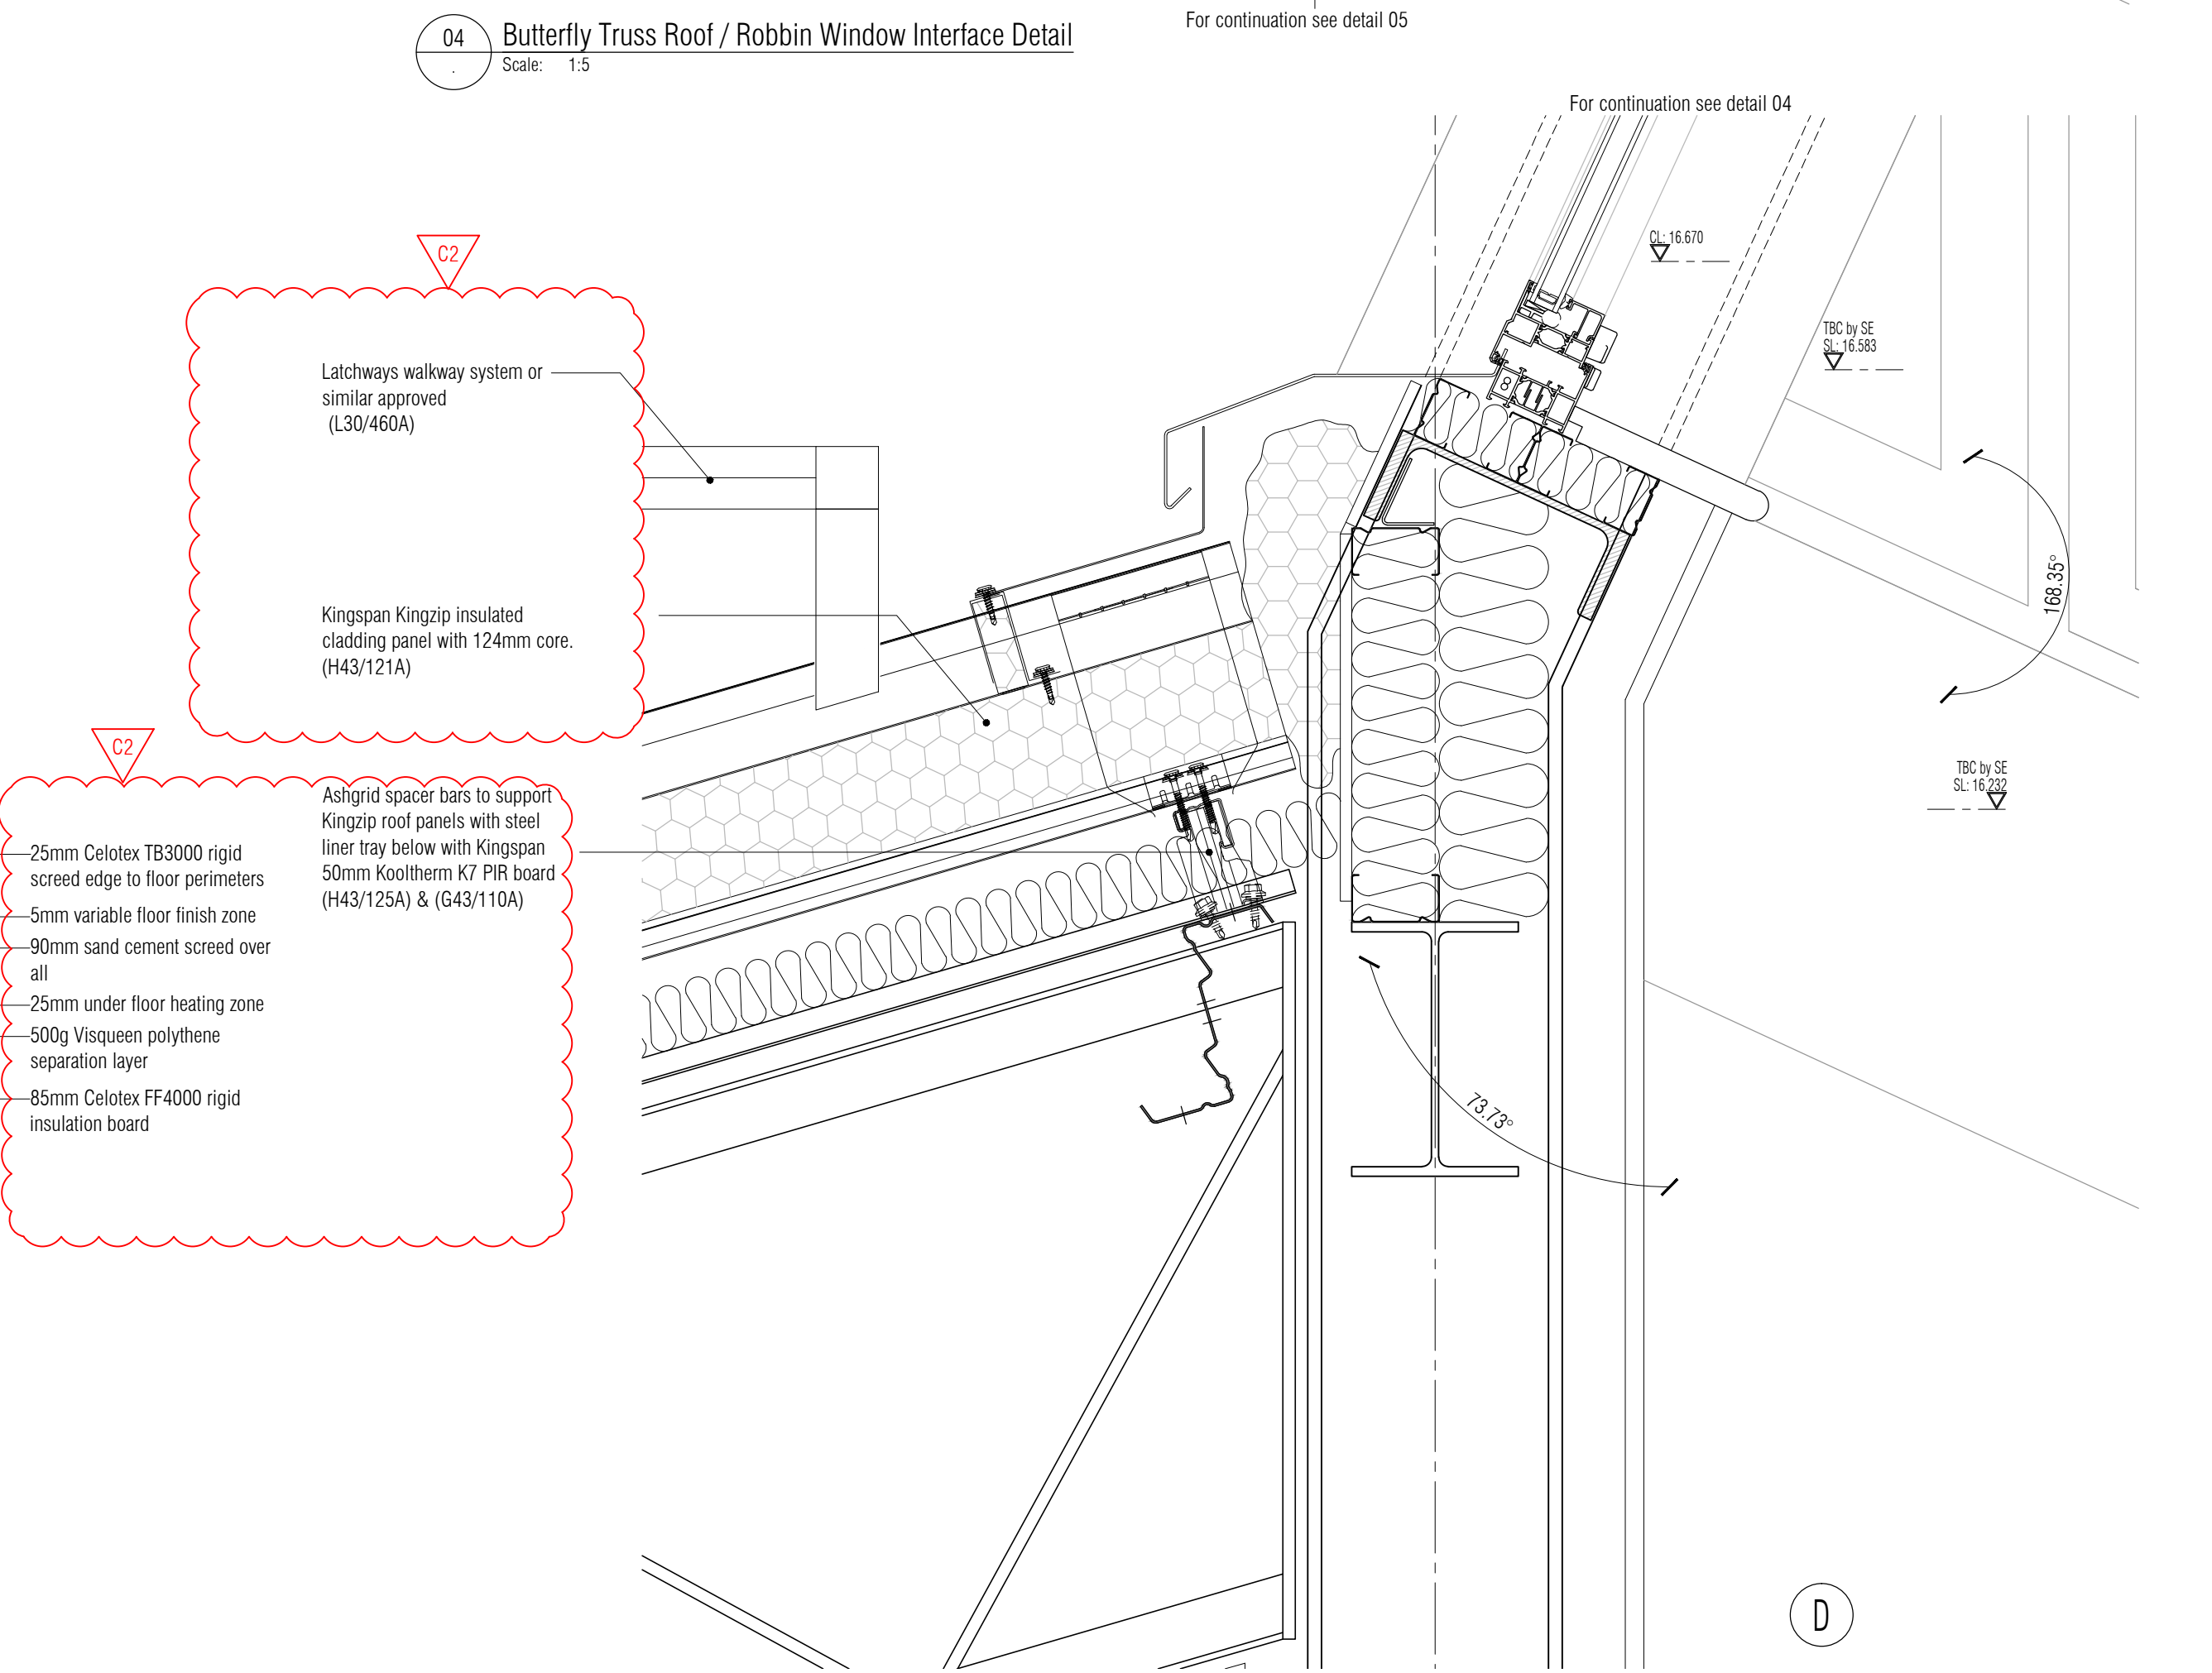

05 Truss Roof / Ribbon Window Interface Detail
Scale: 1:5

03 Masonry Wall / Floor Interface Detail
Scale: 1:5

NOTES: Do not scale this drawing. All dimensions to be checked on site prior to commencement or manufacture.

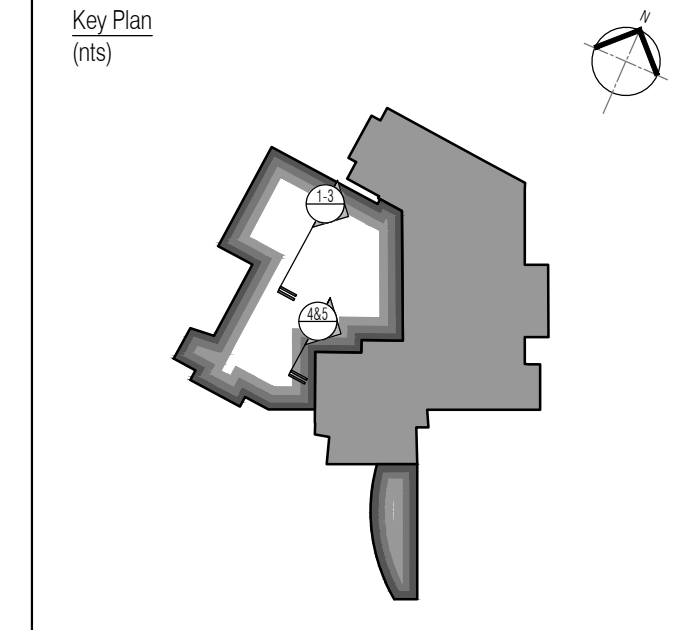

ISSUED FOR CONSTRUCTION

Rev	Date	By	CHK	Comment
C2	07.10.13	CH	AC	Annotation added
C1	03.07.13	RKC	JAS	Issued for CONSTRUCTION

BRINGING IDEAS TO LIFE

FRANKHAM

Frankham Consultancy Group Limited
21 Perrymount Road
Haywards Heath RH16 3TP
t 01444 444000 f 01444 455642
enquire@frankham.com
www.frankham.com

Client

Ealing
www.ealing.gov.uk

Project Title

Dominion Arts Centre
Southall
London

Drawing Title

Truss Roof Eaves,
High Level Ribbon Window and
Masonry and Floor
Details

Drawn by: RKC	Scale: 1:5@A1	Date: 04.03.13
Designed by: FCG	Checked by: JAS	Approved by: AGC

File Ref.: C:\PROJECTS\131416 - DOMINION ARTS CENTRE\131416_01.dwg 2013-03-04 11:13:46	Drawing No. 224970-A-422	Rev. C2
--	-----------------------------	------------