



NOTES: Do not scale this drawing. All dimensions to be checked on site prior to commencement or manufacture.

Key Plan (nts)

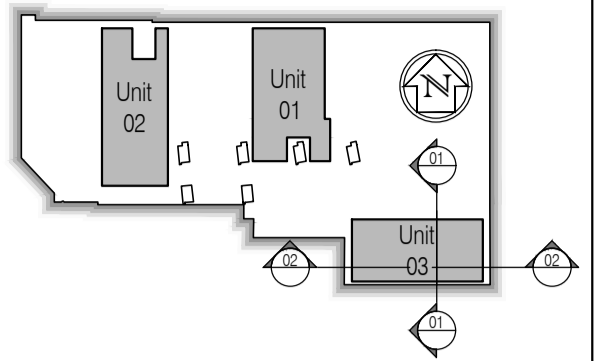

All existing building fabric, services, structural steelwork, etc. shown indicative only acquired from McDL Surveys Ltd information

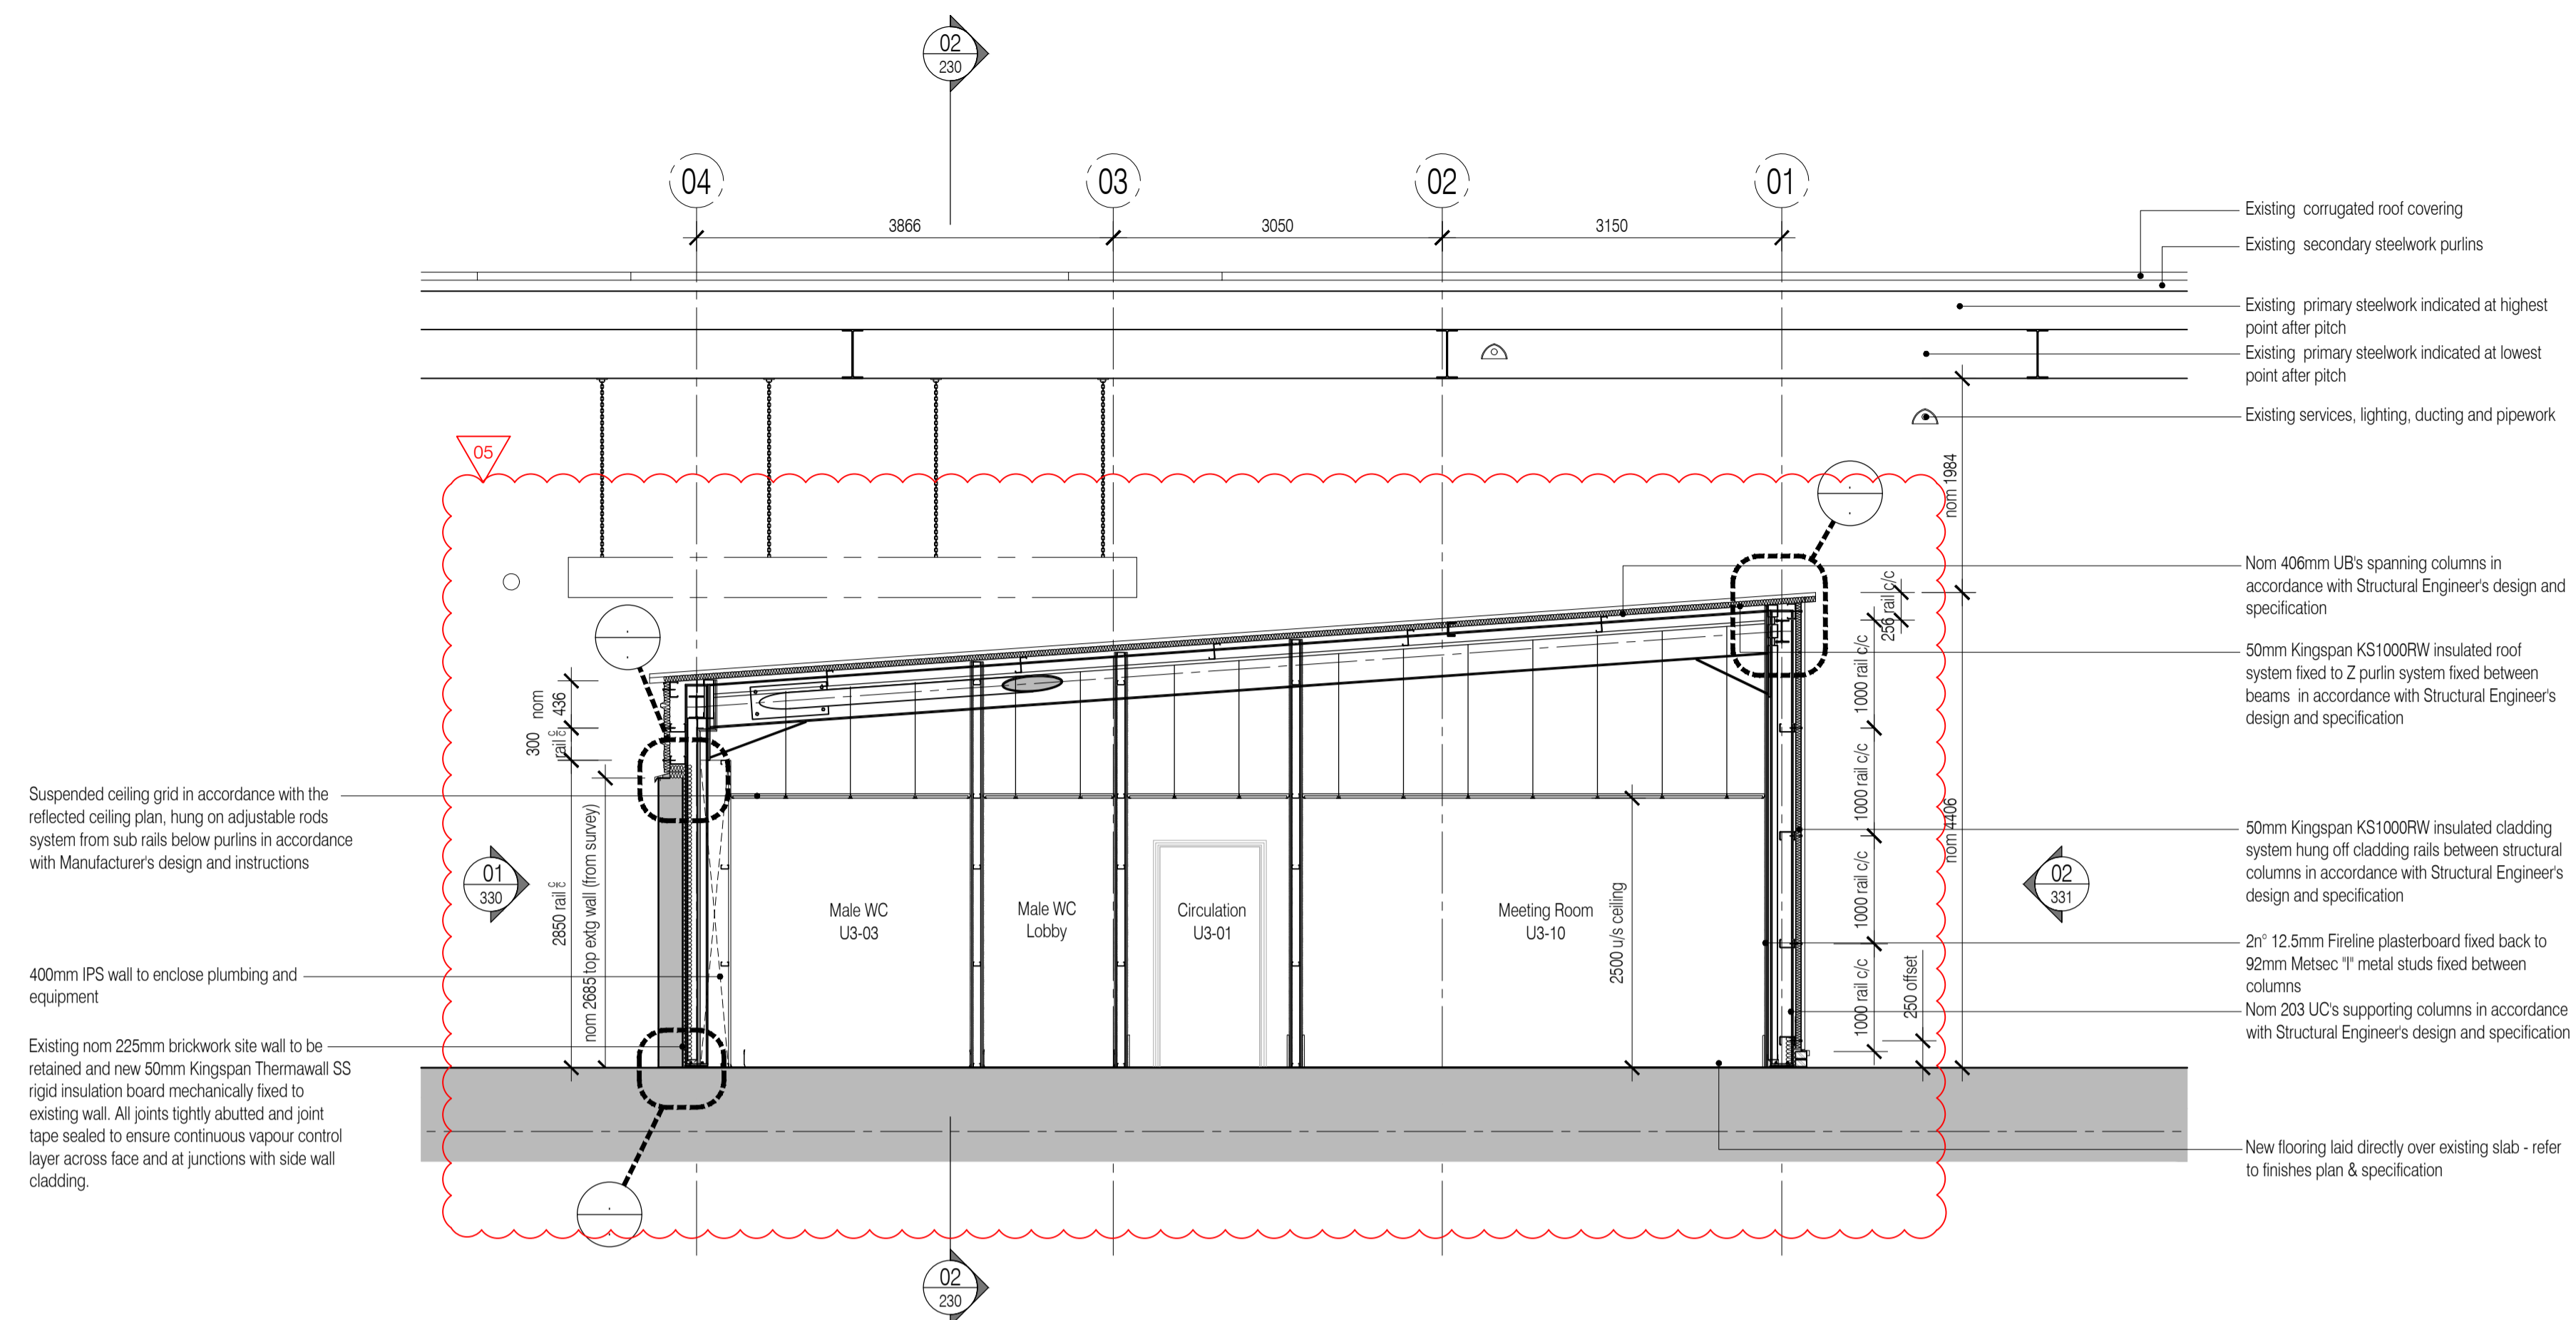

01 Unit 3 Section 01
Scale: 1:50

CONSTRUCTION ISSUE

Rev	Date	By	Chk	Comment
05	01.03.11	RKC	JAS	Revised to suit structural redesign
04	22.11.10	JAS	AC	Issued for Construction
03	08.10.10	RKC	JAS	Issued for Tender
02	05.10.10	RKC	JAS	General revisions
01	30.09.10	RKC	JAS	Refs & Sec 02 added

BRINGING IDEAS TO LIFE



FRANKHAM

Frankham Consultancy Group Limited
21 Perrywood Road
Haywards Heath RH16 3TP
t 01444 444900 f 01444 455642
enquire@frankham.com
www.frankham.com

Client


Project Title
Euston Station
Parcel Deck
Rail Gourmet Facility

Drawing Title
General Arrangement
Sections 01 & 02
Unit 3

Drawn by: RKC	Scale: 1:50@A1	Date: 23.09.10
Designed by: FCG	Checked by: JAS	Approved by: AC

File Ref.: X:\FRANKHAM\CG\440272-A-230\ARCH\230_296_SECTION01.dwg
440272-A-230-296 - 23/09/10 11:02:01

Drawing No. 440272-A-230 Rev. 05

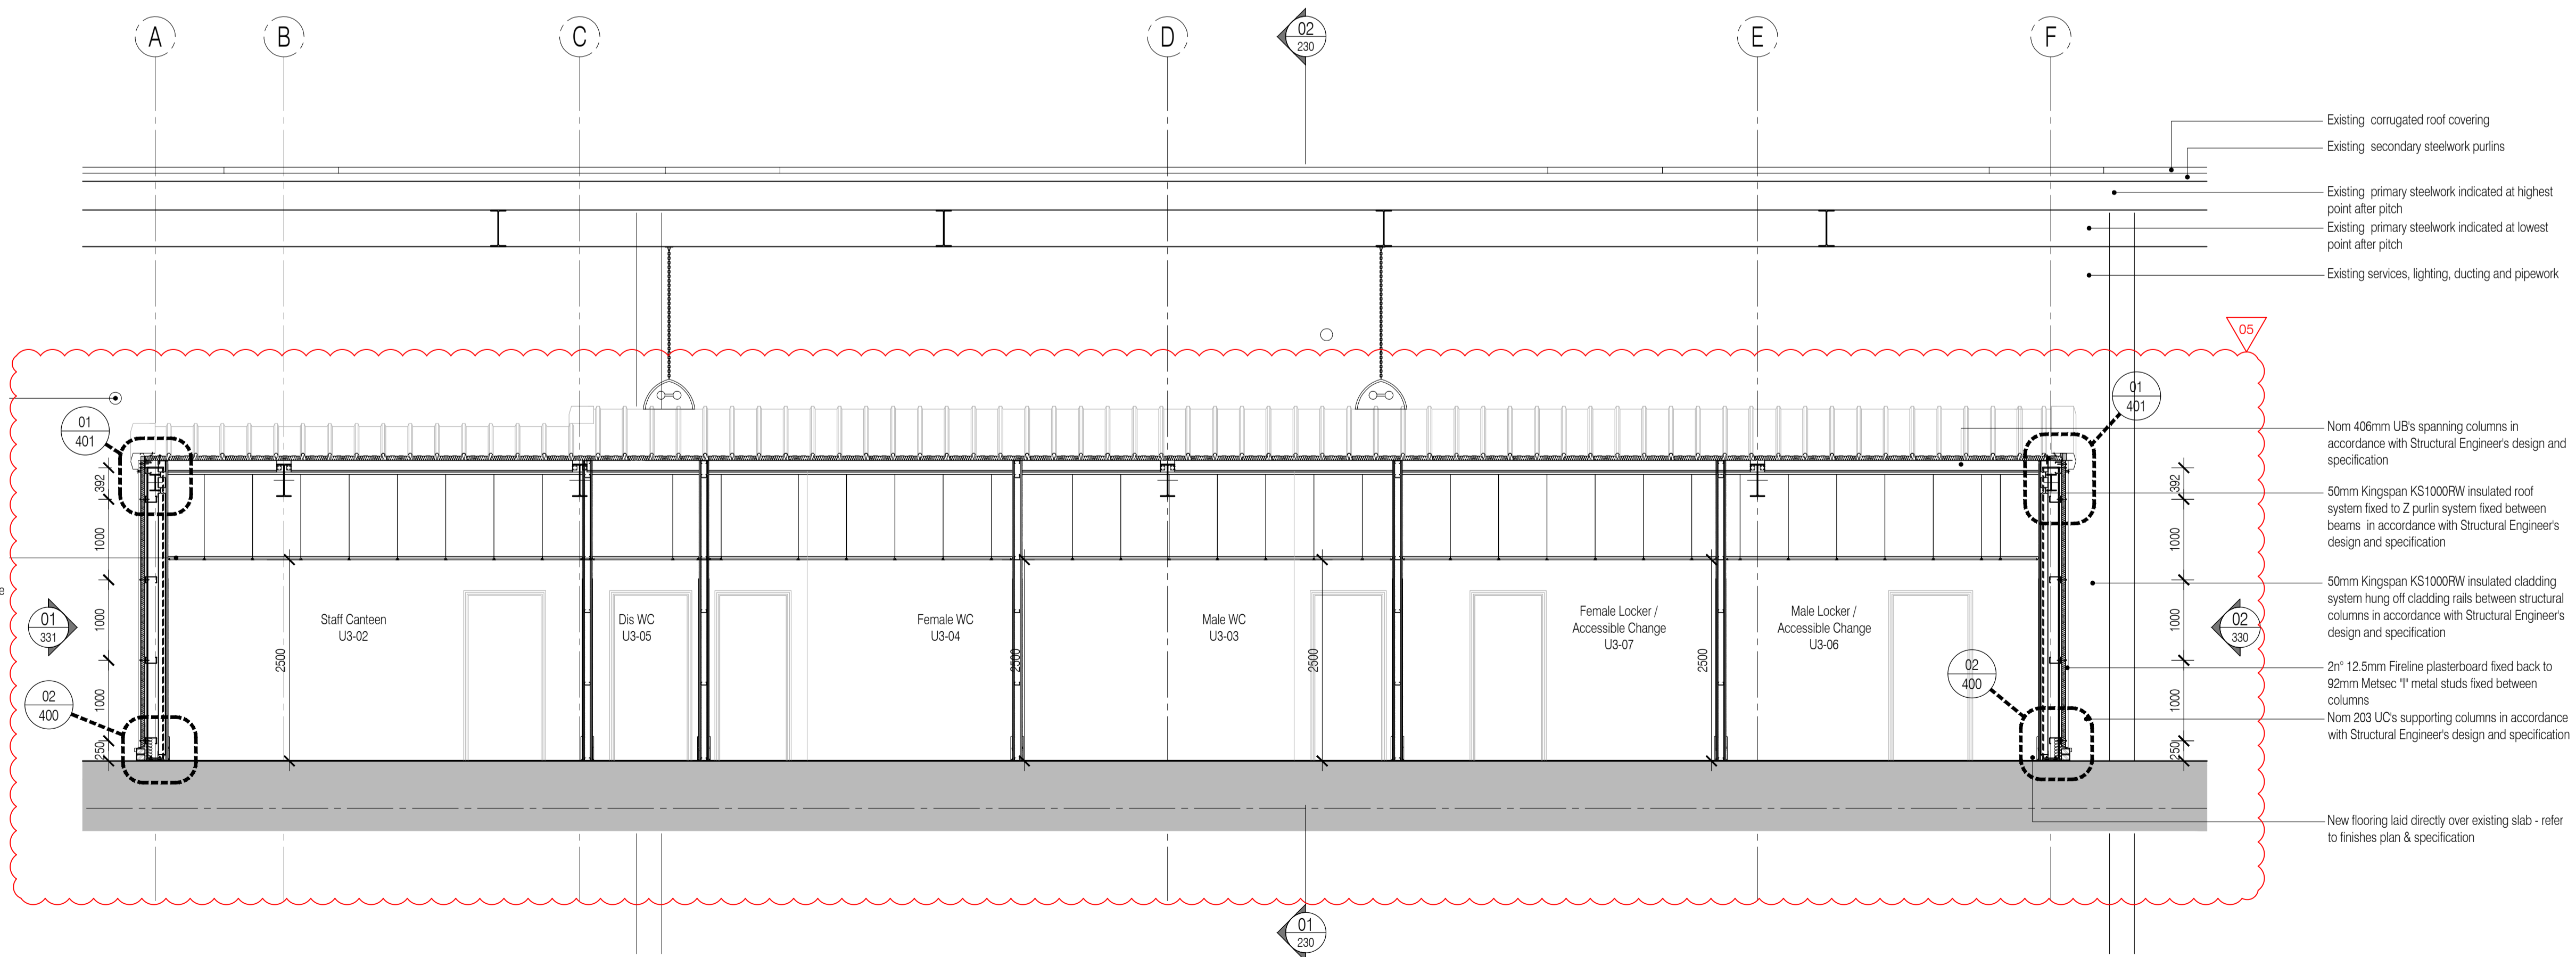

02 Unit 3 Section 02
Scale: 1:50