
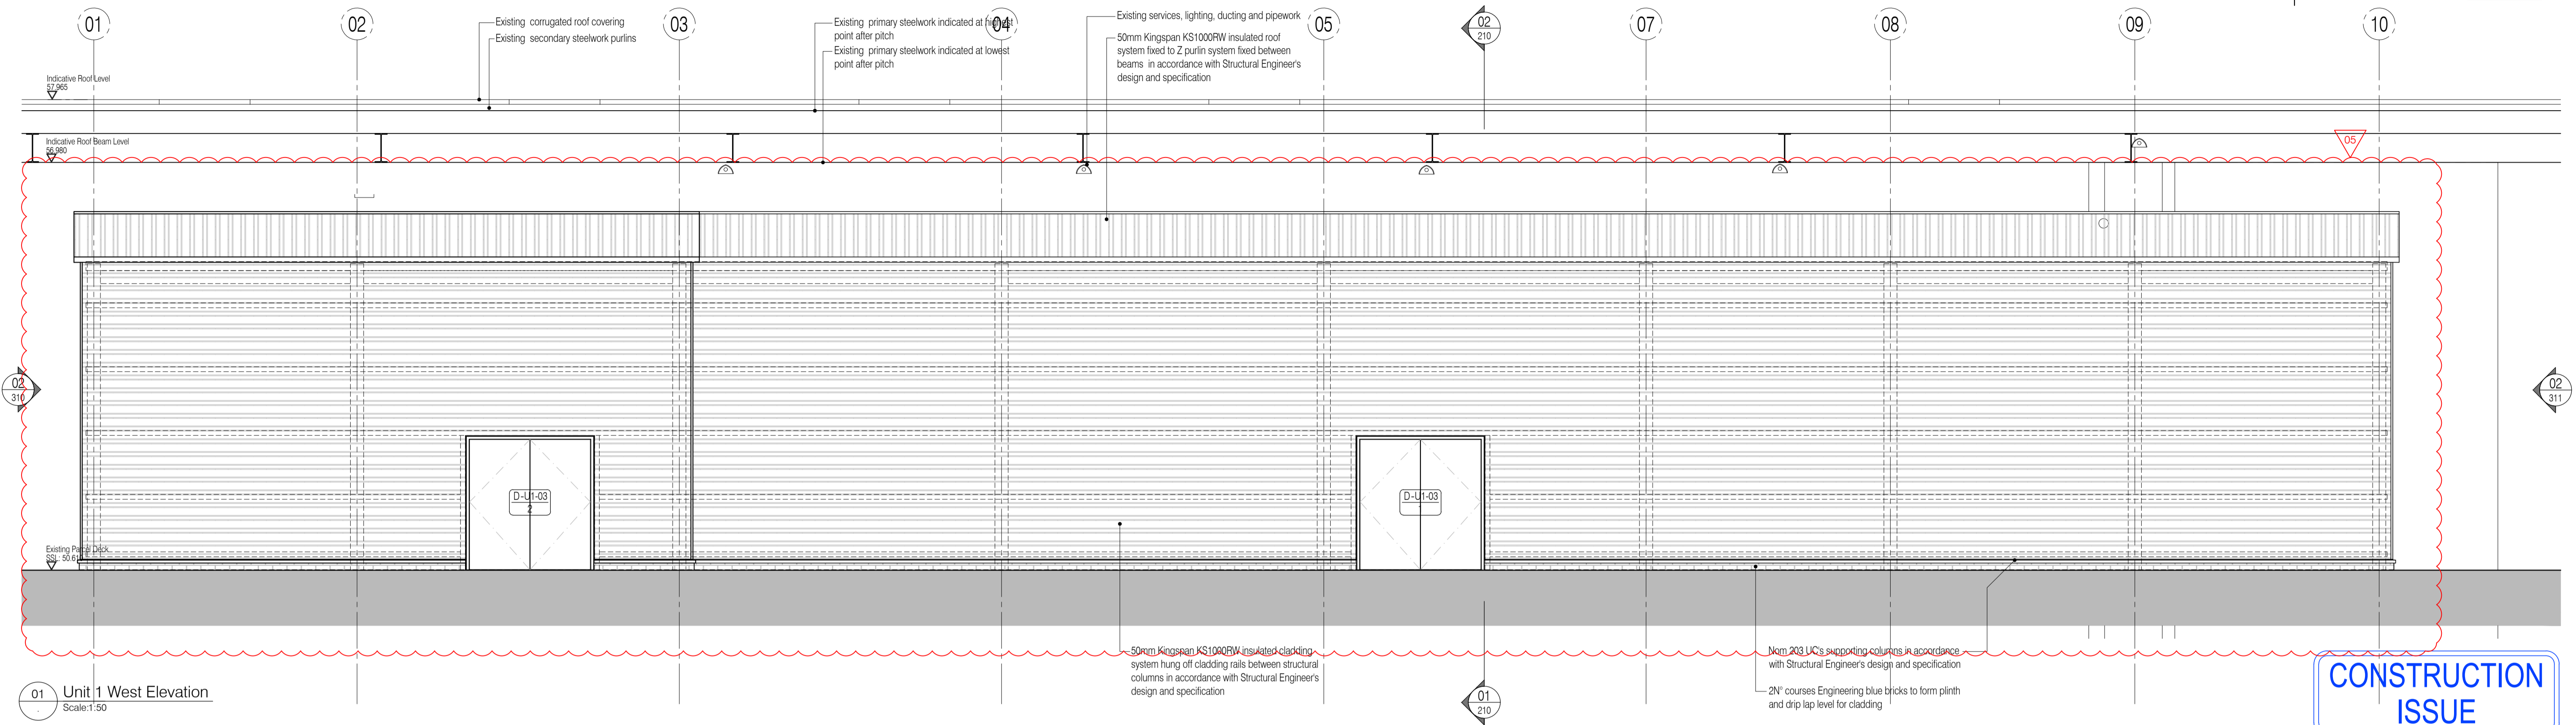


All existing building fabric, services, structural steelwork, etc. shown indicative only acquired from McD L Surveys Ltd information

NOTES: Do not scale this drawing. All dimensions to be checked on site prior to commencement or manufacture.


Key Plan (mts)

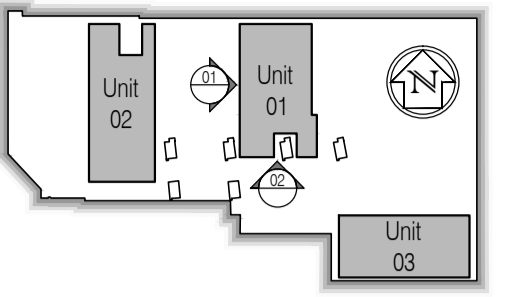

01 Unit 1 West Elevation
Scale: 1:50

CONSTRUCTION ISSUE

Rev	Date	By	Chk	Comment
05	08.03.11	RKC	JAS	Revised to suit structural redesign
04	22.11.10	JAS	AC	Issued for Construction
03	08.10.10	RKC	JAS	Issued for Tender
02	05.10.10	RKC	JAS	General revisions
01	29.09.10	RKC	JAS	Refs added. Issued for approval.

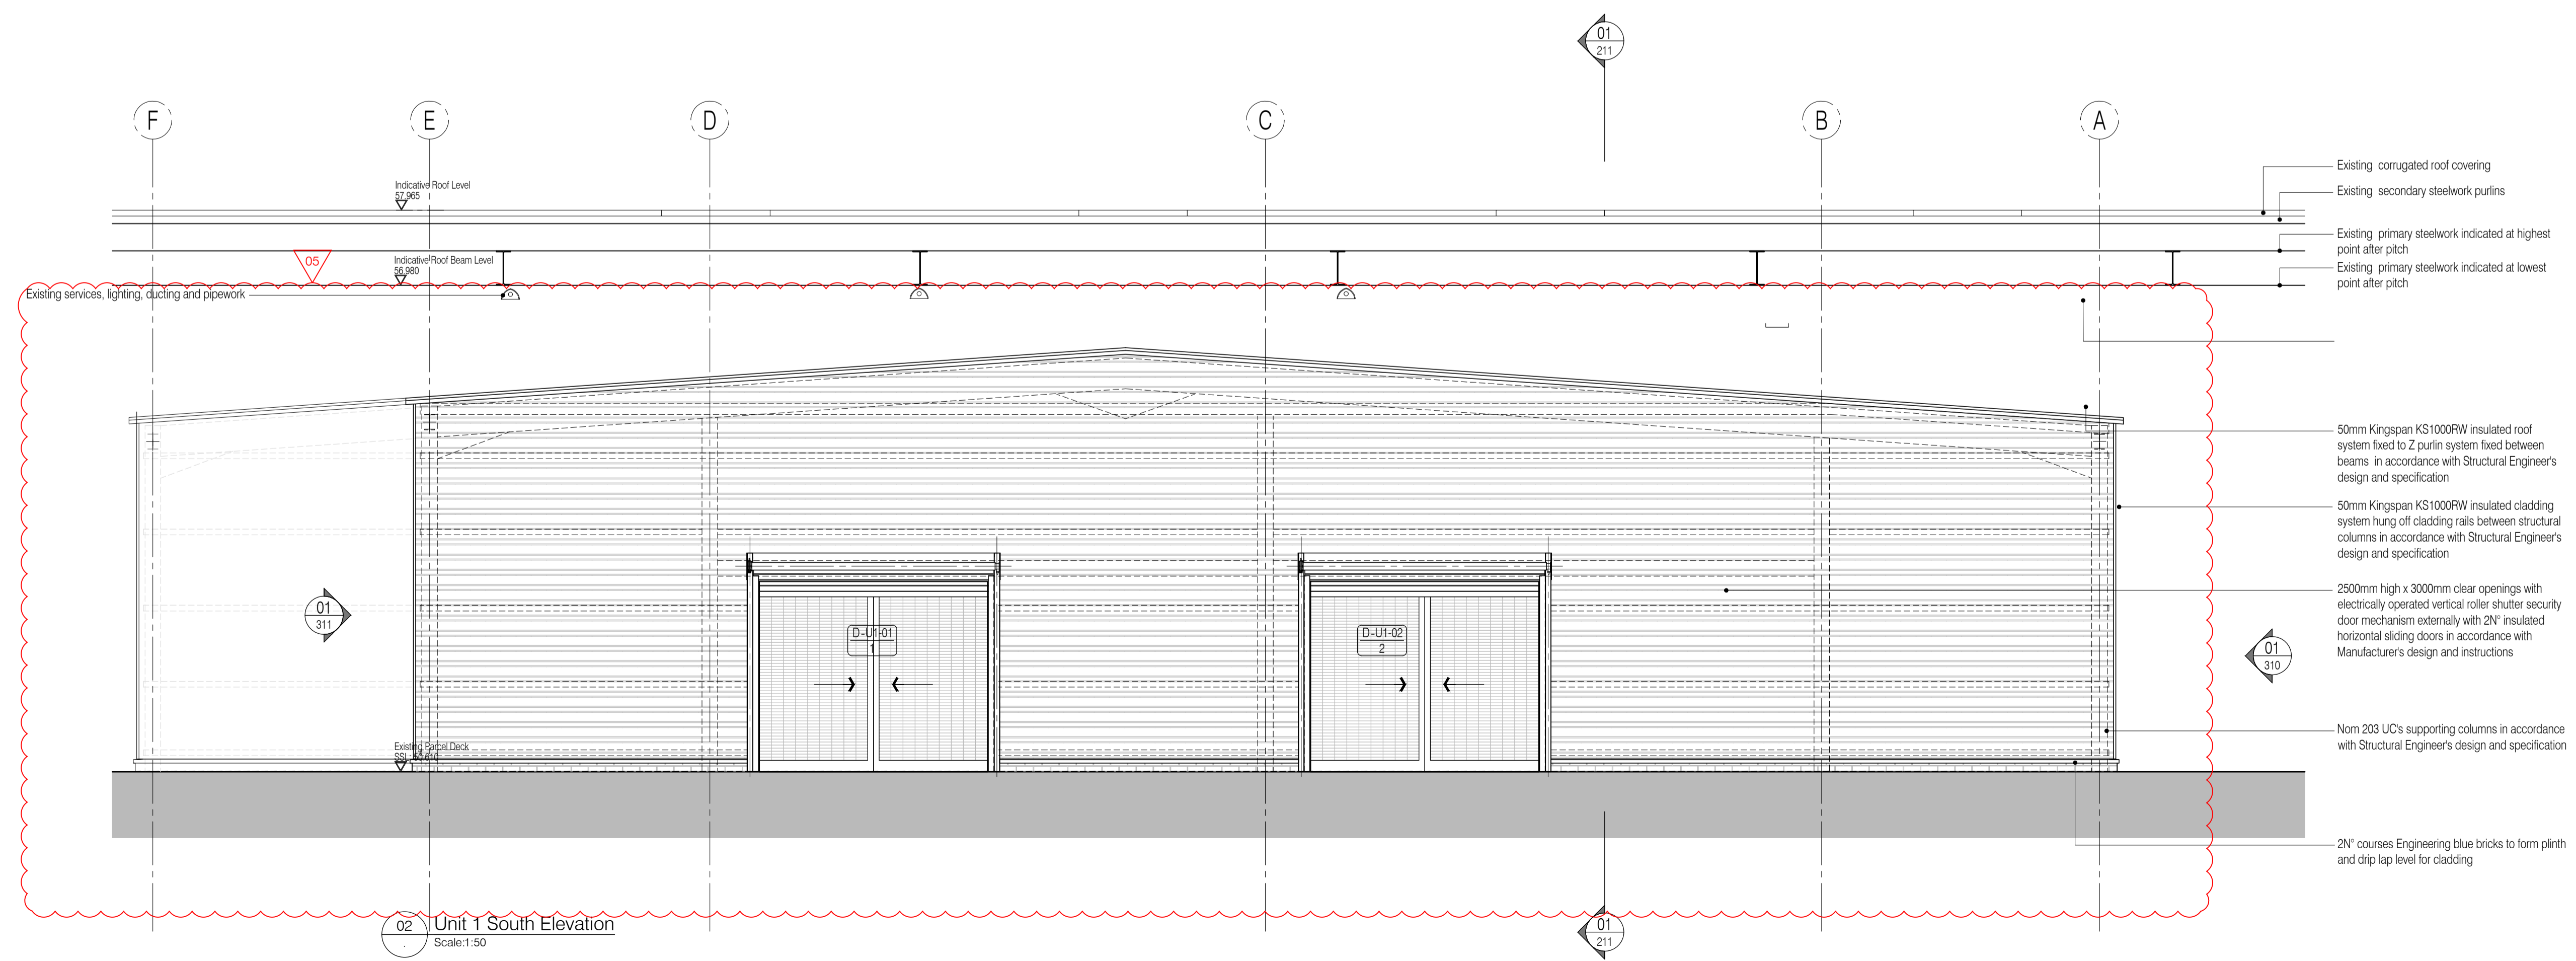

02 Unit 1 South Elevation
Scale: 1:50

BRINGING IDEAS TO LIFE

FRANKHAM

Frankham Consultancy Group Limited
21 Perrymount Road
Haywards Heath RH16 3TP
t 01444 444900 f 01444 455642
enquiry@frankham.com
www.frankham.com

Client:

Project Title: Euston Station Parcel Deck Rail Gourmet Facility

Drawing Title: General Arrangements East & South Elevations Unit 1

Drawn by: RKC	Scale: 1:50@A1	Date: 23.09.10
Designed by: FCG	Checked by: JAS	Approved by: AC
File Ref.: 444272-A-310	20.06.11:14.25.35	
Drawing No. 440272-A-310	Rev. 05	